


Bickerton Search And Rescue Station Nova Scotia
Docking Panel Shop Drawing (R2)

	Public Works and Government Services Canada	Travaux Publics et Services Gouvernementaux Canada
SHOP DRAWING		DESIGN D'ATELIER
Reviewed <input type="checkbox"/> Revu		
Reviewed with Annotation <input checked="" type="checkbox"/> Revu avec Annotation		
Revise and Resubmit <input type="checkbox"/> Reviser et Resoumettre		
By: Name	Hamdi Battikh	Par: Nom
Title	Professional Electrical Engineer	Poste
Signature	<i>Hamdi Battikh</i>	Date 17 Jan 2018
In accordance with Section 01 33 00 of the Specifications		En conformité avec la section 01 33 00 du devis
Project No.:	R.089636.002 Bickerton SAR	No. du Projet:

PSPC:

- Advice Departmental Representative 5 working days before shipping to site.

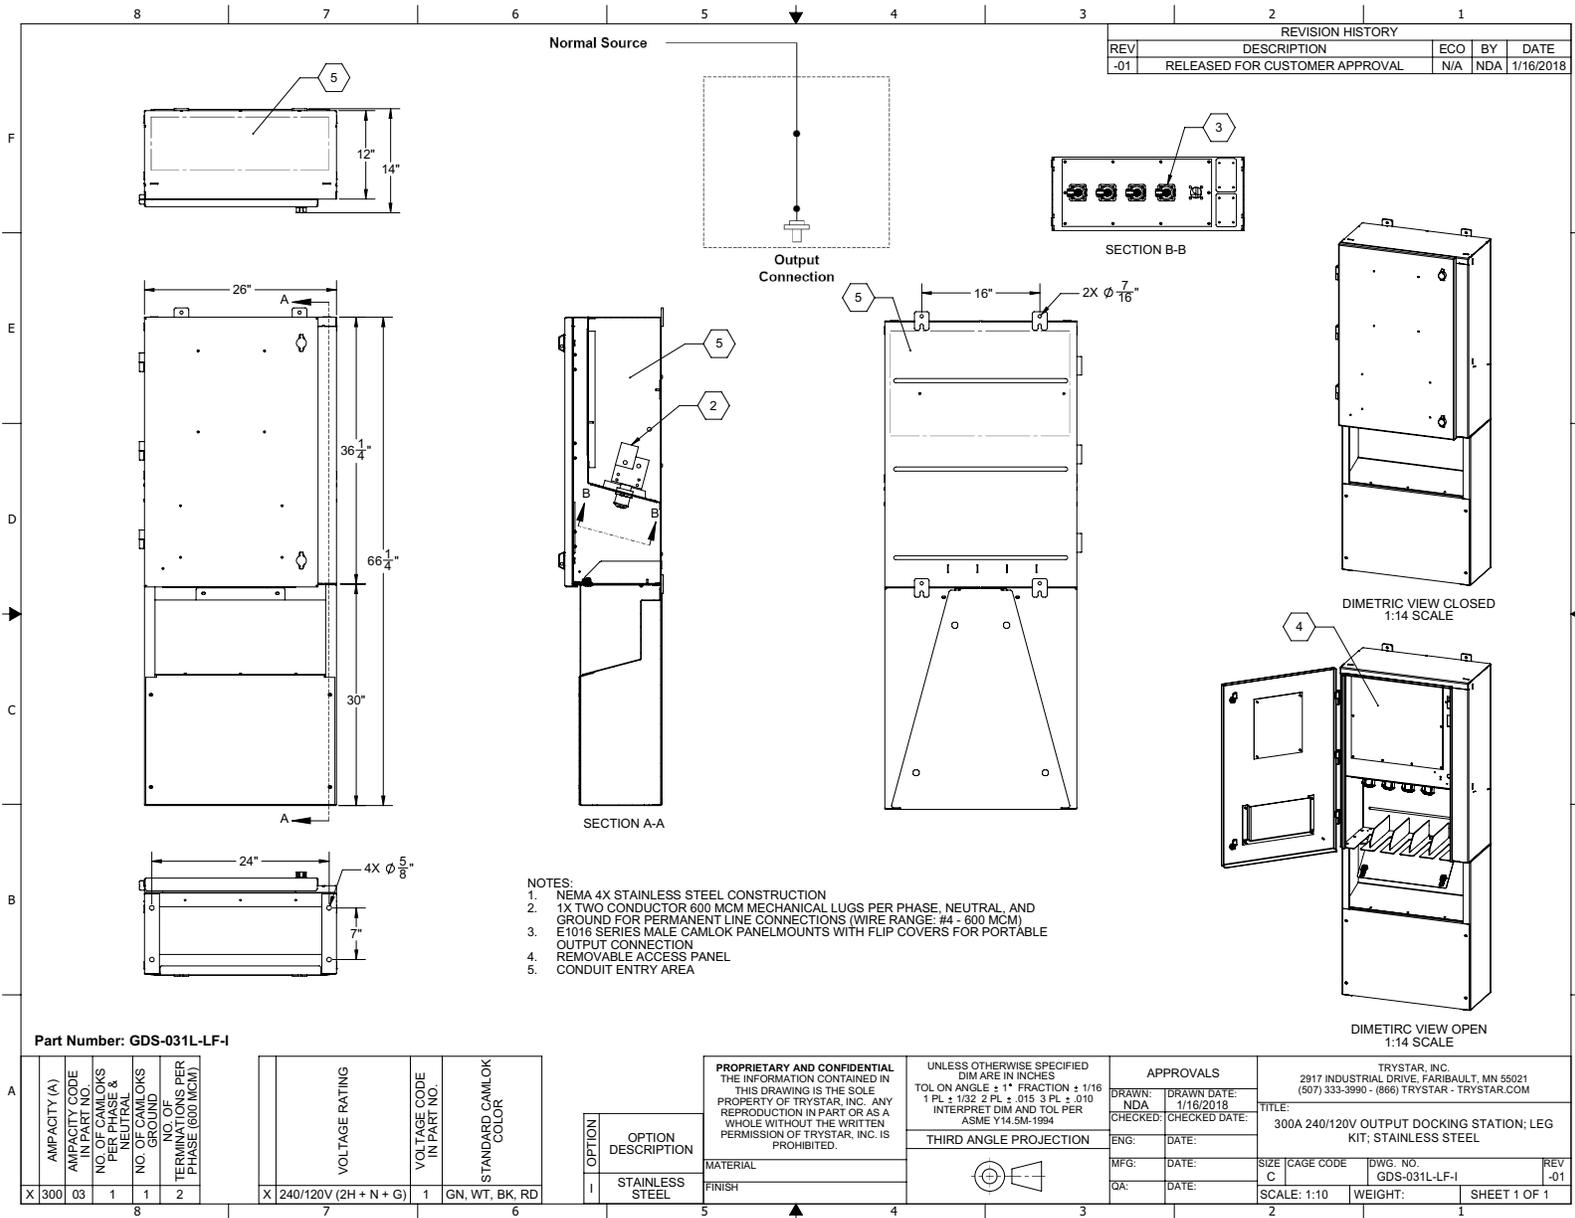

REVISION HISTORY				
REV	DESCRIPTION	ECO	BY	DATE
-01	RELEASED FOR CUSTOMER APPROVAL	N/A	NDA	1/16/2018

- NOTES:
1. NEMA 4X STAINLESS STEEL CONSTRUCTION
 2. 1X TWO CONDUCTOR 600 MCM MECHANICAL LUGS PER PHASE, NEUTRAL, AND GROUND FOR PERMANENT LINE CONNECTIONS (WIRE RANGE: #4 - 600 MCM)
 3. E1016 SERIES MALE CAMLOK PANELMOUNTS WITH FLIP COVERS FOR PORTABLE OUTPUT CONNECTION
 4. REMOVABLE ACCESS PANEL
 5. CONDUIT ENTRY AREA

Part Number: GDS-031L-LF-I

AMPACITY (A)	AMPACITY CODE IN PART NO.	NO. OF CAMLOKS PER PHASE & NEUTRAL	NO. OF CAMLOKS GROUND	NO. OF TERMINATIONS PER PHASE (600 MCM)	VOLTAGE RATING	VOLTAGE CODE IN PART NO.	STANDARD CAMLOK COLOR
X 300	03	1	1	2	X 240/120V (2H + N + G)	1	GN, WT, BK, RD

OPTION	OPTION DESCRIPTION
1	STAINLESS STEEL

PROPRIETARY AND CONFIDENTIAL THE INFORMATION CONTAINED IN THIS DRAWING IS THE SOLE PROPERTY OF TRYSTAR, INC. ANY REPRODUCTION IN PART OR AS A WHOLE WITHOUT THE WRITTEN PERMISSION OF TRYSTAR, INC. IS PROHIBITED.

UNLESS OTHERWISE SPECIFIED DIM ARE IN INCHES
 TOL ON ANGLE ± 1° FRACTION ± 1/16
 1 PL ± 1/32 2 PL ± .015 3 PL ± .010
 INTERPRET DIM AND TOL PER ASME Y14.5M-1994

THIRD ANGLE PROJECTION

APPROVALS	
DRAWN: NDA	DRAWN DATE: 1/16/2018
CHECKED:	CHECKED DATE:
ENG:	DATE:
MFG:	DATE:
QA:	DATE:

TRYSTAR, INC.			
2917 INDUSTRIAL DRIVE, FARIBAULT, MN 55021 (507) 333-3990 - (866) TRYSTAR - TRYSTAR.COM			
TITLE: 300A 240/120V OUTPUT DOCKING STATION; LEG KIT; STAINLESS STEEL			
SIZE: C	CAGE CODE	DWG. NO. GDS-031L-LF-I	REV -01
SCALE: 1:10	WEIGHT:	SHEET 1 OF 1	