

Appendix B

As-built Structural microfiche drawings

THIRD FLOOR PLAN
SCALE 1/8" = 1'-0"

SECOND FLOOR PLAN
SCALE 1/8" = 1'-0"

FIRST FLOOR PLAN
SCALE 1/8" = 1'-0"

LOCATION OF MACHINES.

- | | |
|--------------------|-------------------------|
| 1 DRILL PRESS | 10 LARGE LATHE |
| 2 JOINTER | 11 SMALL LATHE |
| 3 THICKNESS PLANER | 12 PIPE & BOLT THREADER |
| 4 TABLE SAW | 13 PEDESTAL GRINDER |
| 5 RADIAL SAW | 14 FORGE |
| 6 BAND SAW | 15 METAL HACKSAW |
| 7 METAL BAND SAW | 16 LEVELLING BLOCK |
| 8 DRILL PRESS | 17 DRILL |
| 9 SHAPER | 18 AIR HAMMER |

LEGEND

- D.C. DRY CHEMICAL
P.T. PUMP TANK
R.W.L. RAINWATER LEADER

BOUND BY TO ELEVATOR SHAFTS.
2 1/2" x 4" x 1/2" DEEP GUM PIT
WITH 1/2" CHICKEN PLATE. FRAME AND
LIFTING RING, PROVIDE FOOT ROOMS
IN WALL TO 2'0" FROM BOTTOM
SEE DETAIL DNG NO. S 1.


NOTE: LOUVERED AS DETAIL ON HIGH DWGS.
WITH SCREEN EXCEPT THAT WHITE FAN
DECKS SCREEN TO BE REPLACED WITH 3/4"
PINEWOOD WITH 12" x 12" HOLE FOR FAN.

A-DETAIL NUMBER
B-LOCATION SHEET
C-DETAIL SHEET


A
B
C

REVISIONS		DEPARTMENT OF PUBLIC WORKS OF CANADA	
DATE	RECORD	BUILDING CONSTRUCTION BRANCH	
		E. A. GARDNER CHIEF ARCHITECT	
		ST. JOHN'S WFLD:	
		SHOPS, STORES & ADMINISTRATION BLDG: (D.O.T.)	
		FLOOR PLANS 1 ST , 2 ND & 3 RD	
DRAWN BY:	CHECKED BY:	APPROVED BY:	SCALE:
F.S.	J. J. O.	J. J. O.	1/8" = 1'-0"
DATE: JULY 1962	DATE: 10-7-62	DATE: 2-9-62	PLAN FILE NO.
JOB NO. CA 61.113			
		DRWG. NO. A1	
		OF 21	

G-CA-61-1-13/3 MICROFILMED

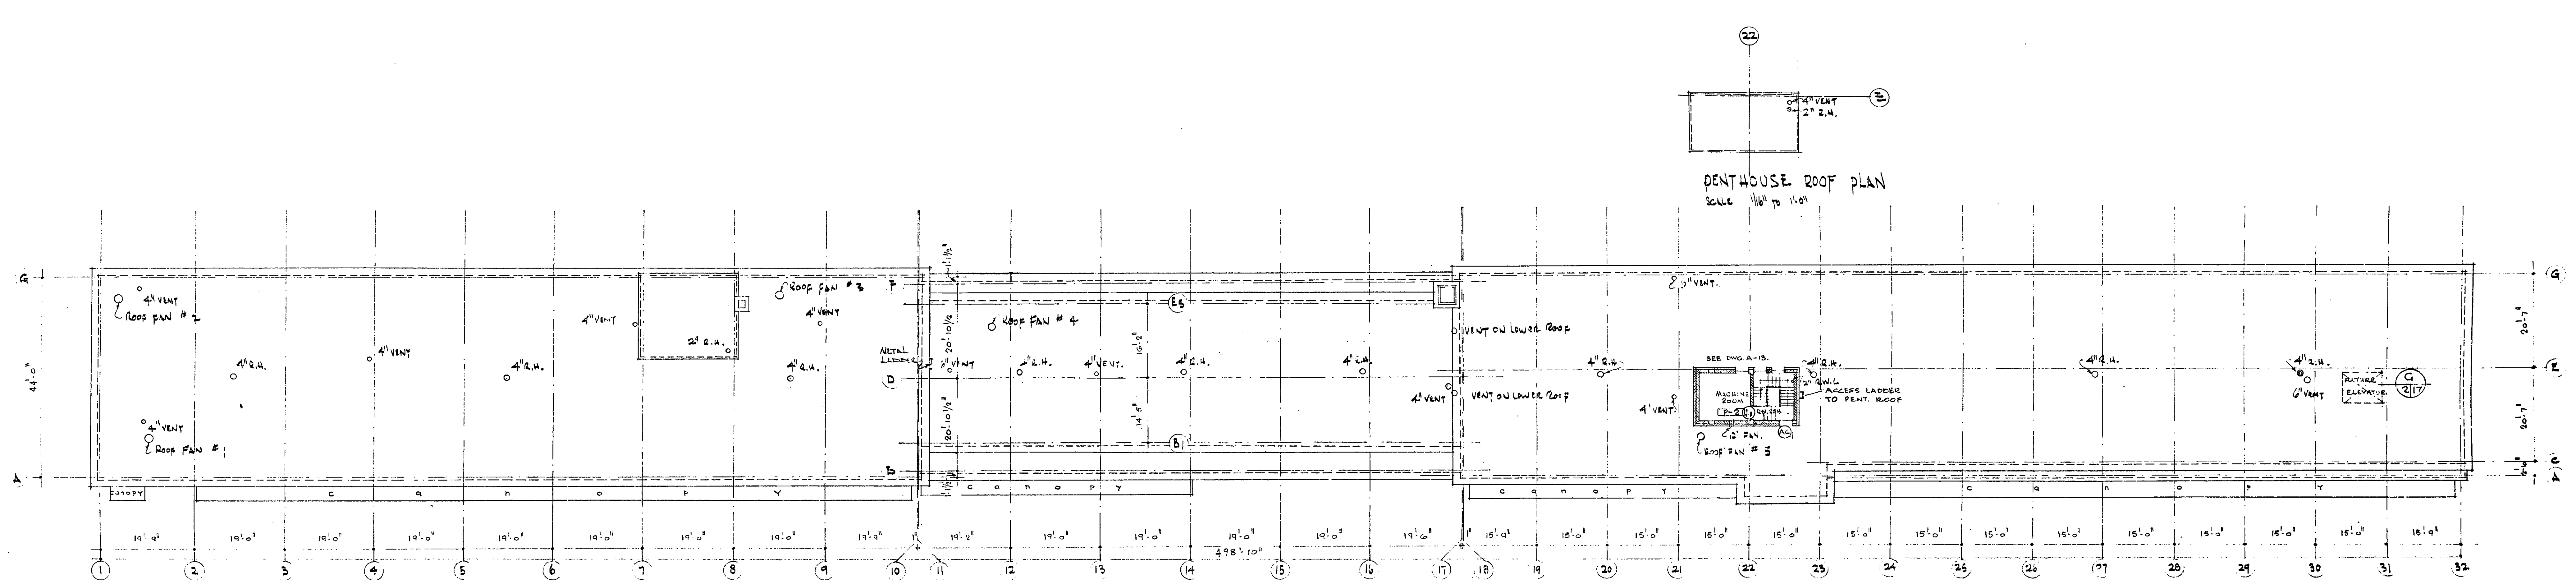

ROOF PLAN . scale 1/16" = 1'-0"

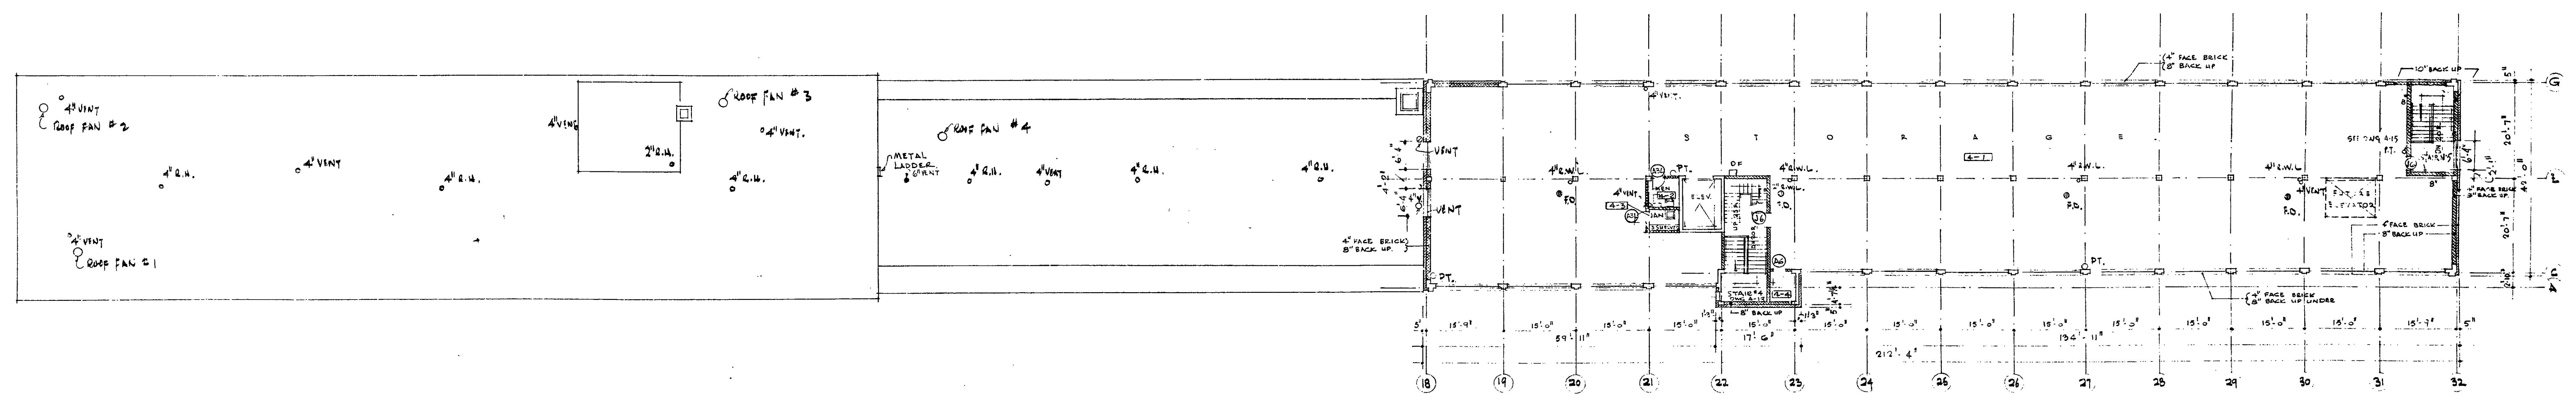

FOURTH FLOOR PLAN . scale 1/16" = 1'-0"


A - DETAIL NUMBER
B - LOCATION SHEET
C - DETAIL SHEET

REVISIONS	
DATE	RECORD

DEPARTMENT OF PUBLIC WORKS OF CANADA			
BUILDING CONSTRUCTION BRANCH		E. A. GARDNER CHIEF ARCHITECT	
ST. JOHN'S WFLD: SHOPS, STORES & ADMINISTRATION BLDG. (D.O.T.)			
FLOOR AND ROOF PLANS - 4 th FL.			
DRAWN BY: E.S.	CHECKED BY: J.J.O.	APPROVED BY: J.J.O.	SCALE: 1/16" = 1'-0"
DATE: JULY 1962		DATE: JULY 1962	
JOB NO. CA 61.1.13.		PLAN FILE NO.	


A2
OF 21

G-CA-61-1-13/4 MICROFILMED.

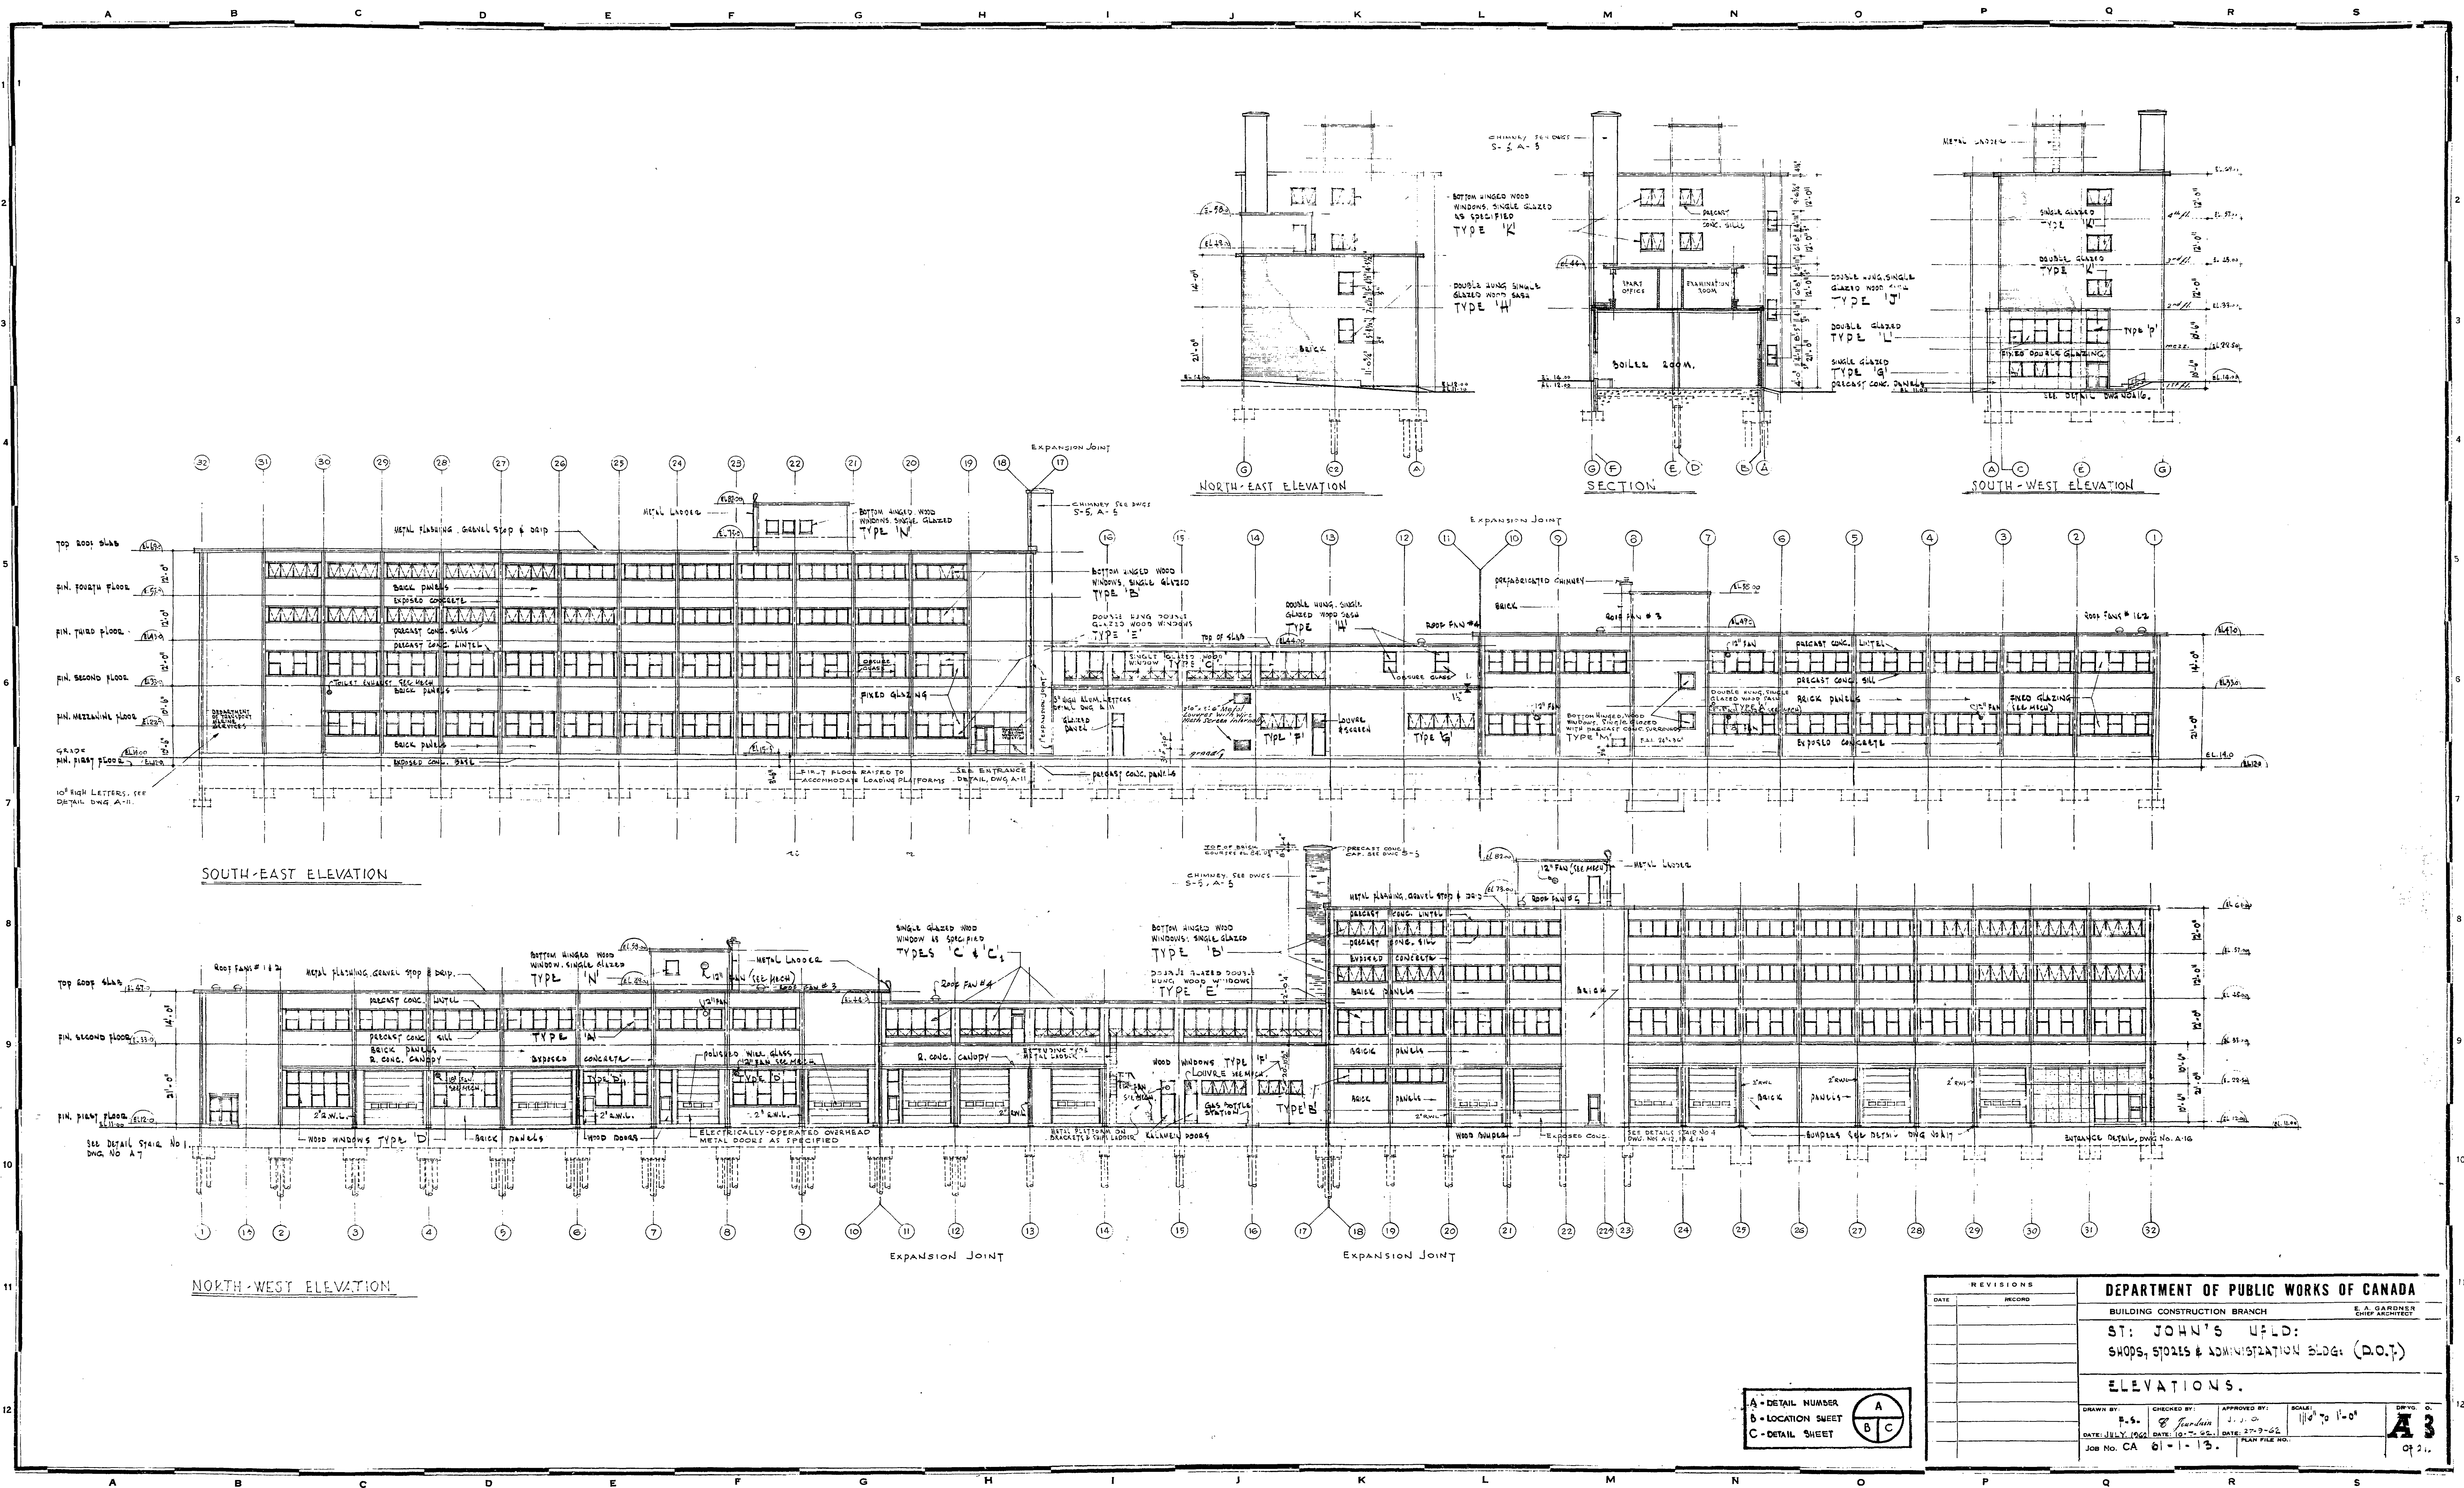

REVISIONS		DEPARTMENT OF PUBLIC WORKS OF CANADA			
DATE	RECORD	BUILDING CONSTRUCTION BRANCH		S. A. GARDNER CHIEF ARCHITECT	
		ST: JOHN'S UPFD: SHOPS, STORES & ADMINISTRATION BLDG: (D.O.T.)			
		ELEVATIONS.			
DRAWN BY: P.S.		CHECKED BY: S. Gardner	APPROVED BY: J. J. O.	SCALE: 1/4" = 1'-0"	DRWG. NO. A3
DATE: JULY 1962		DATE: 10-7-62	DATE: 27-9-62		
JOB NO. CA 61-1-13		PLAN FILE NO. 21.			

9-CA-01-1-13-D MICROFILMED

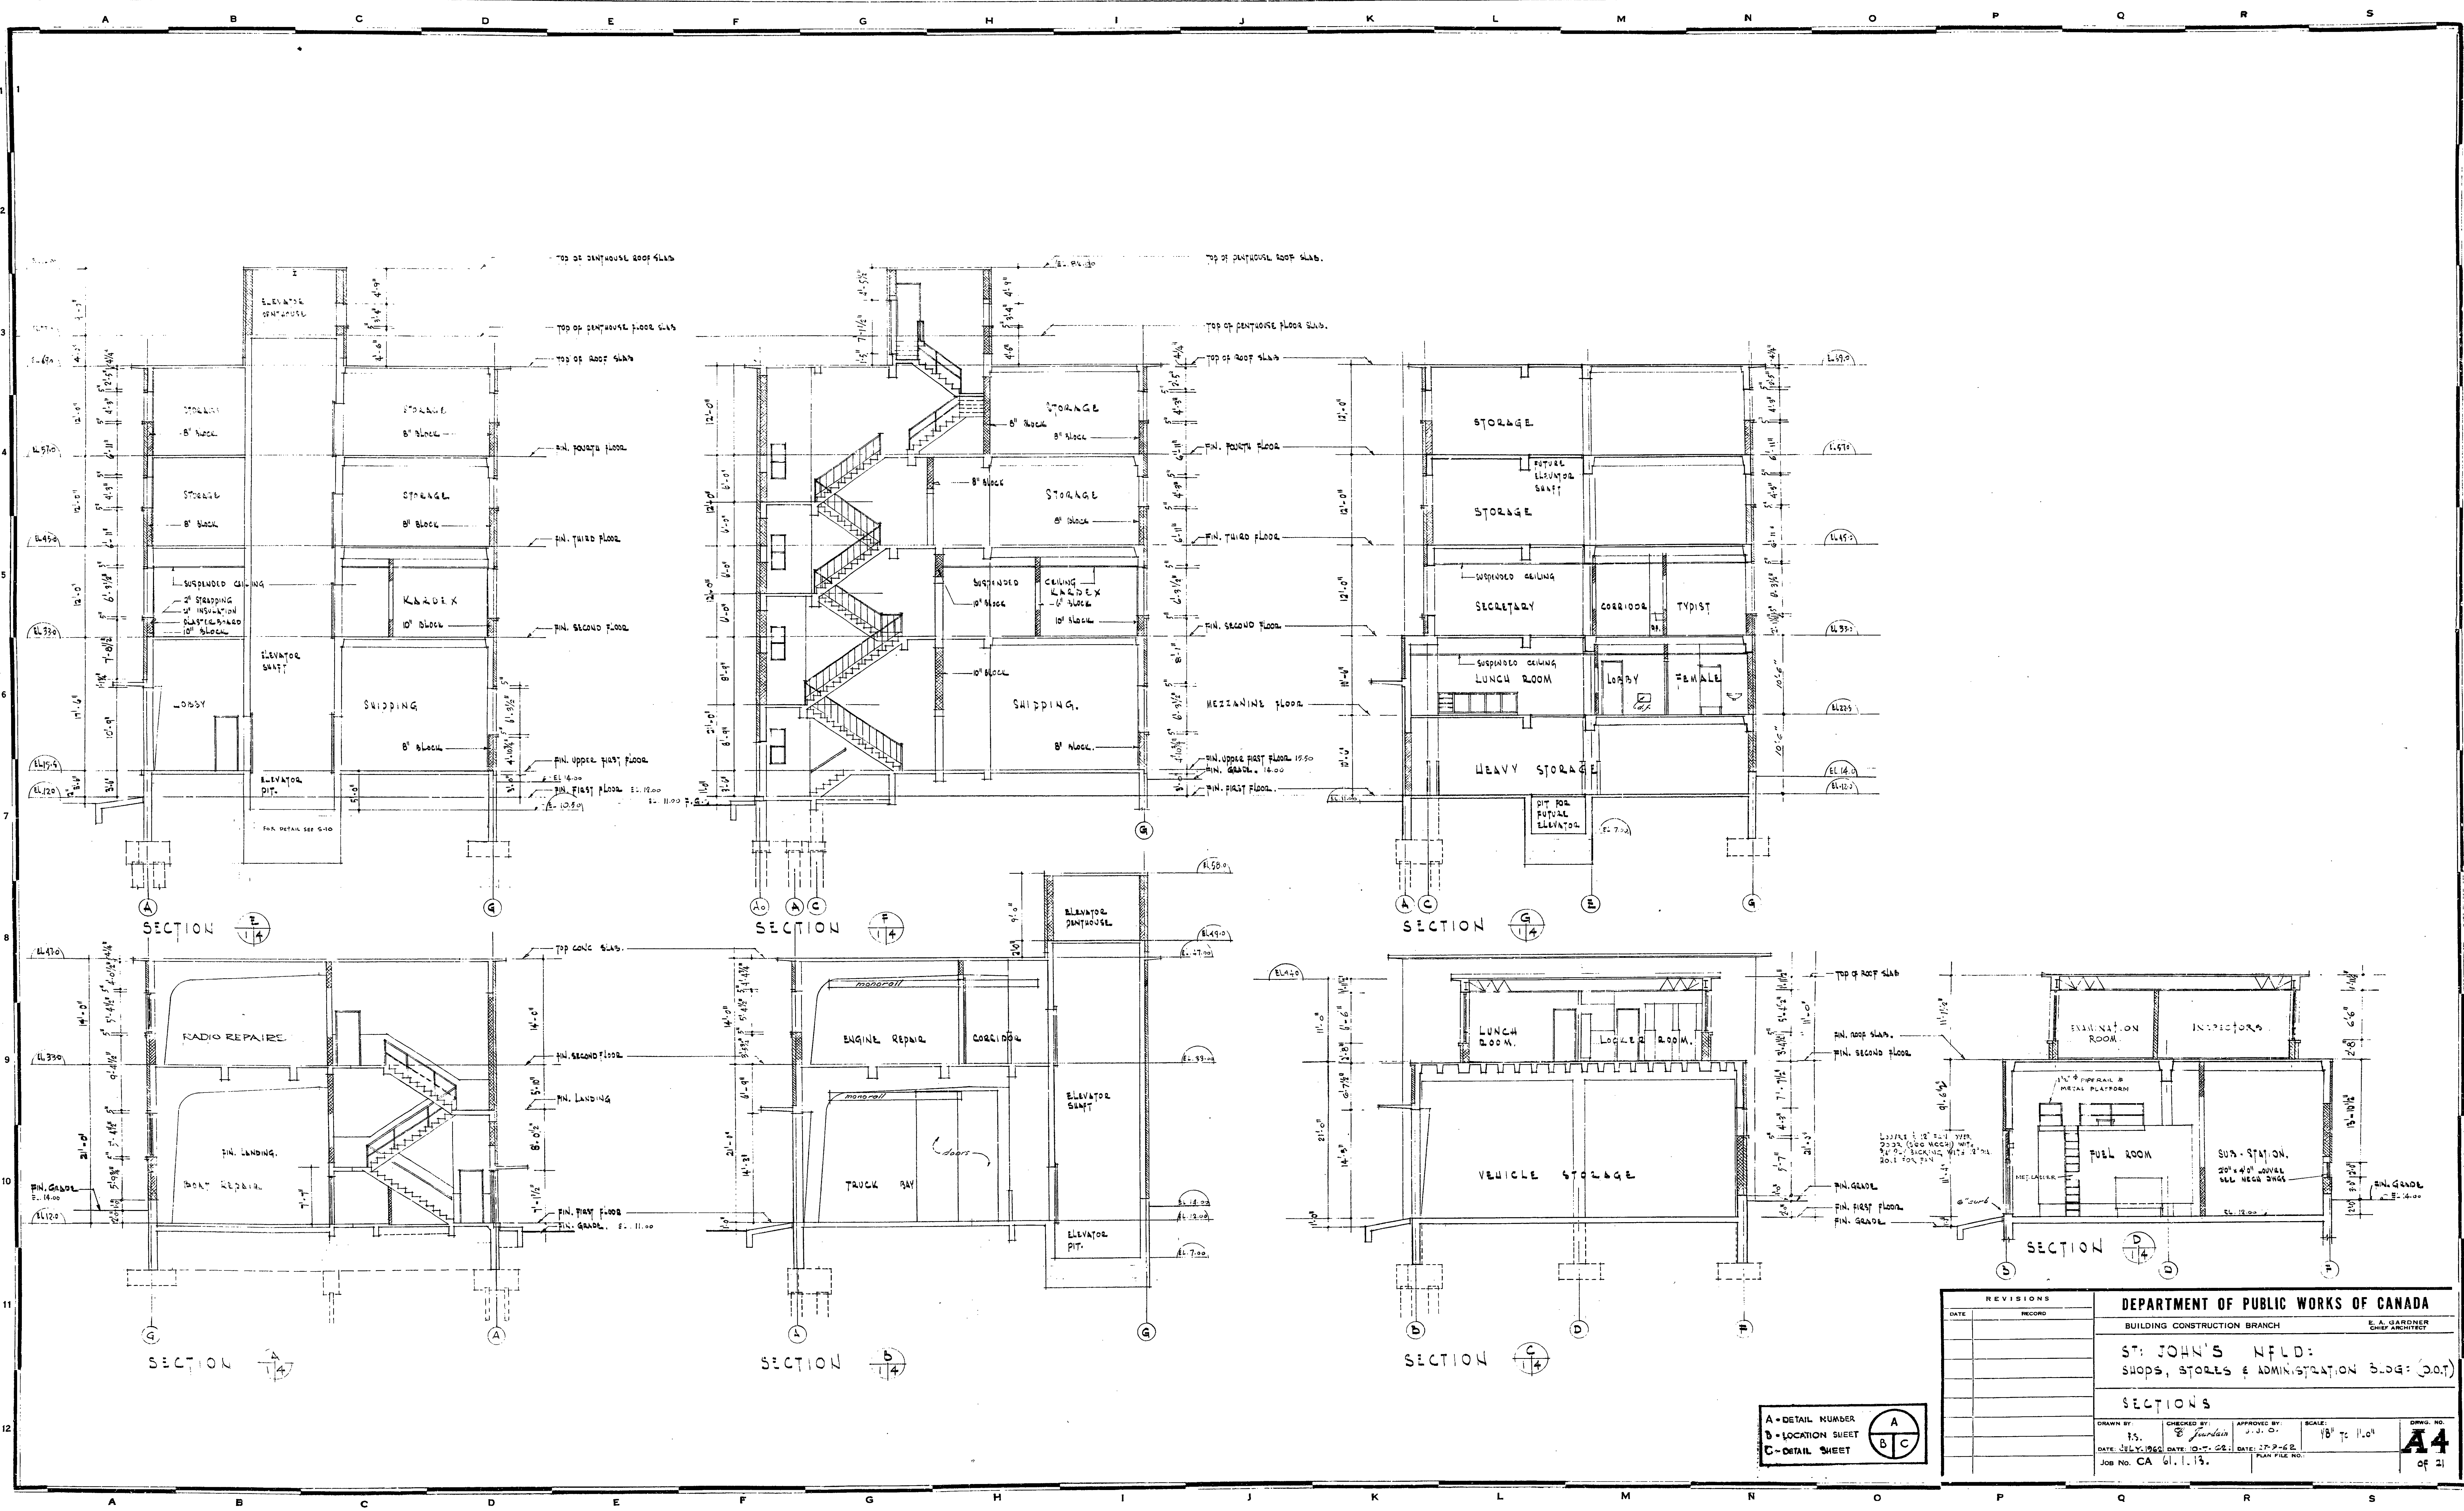


REVISIONS		DEPARTMENT OF PUBLIC WORKS OF CANADA			
DATE	RECORD	BUILDING CONSTRUCTION BRANCH		E. A. GARDNER CHIEF ARCHITECT	
		ST. JOHN'S Nfld: shops, stores & administration block (cont)			
		SECTIONS			
DRAWN BY: 13.		CHECKED BY: E. Gardner		APPROVED BY: E. A. GARDNER	
DATE: JULY 1962		DATE: OCT. 22, 1962		DATE: JAN. 11, 1963	
JOB NO. CA 01.1.13.		PLAN FILE NO.		SCALE: 1/8" = 1'-0"	
				DWG. NO. A4	
				of 21	

A - DETAIL NUMBER
B - LOCATION SHEET
C - DETAIL SHEET


A
B
C

G-CA-61-1-13/6 MICROFILMED

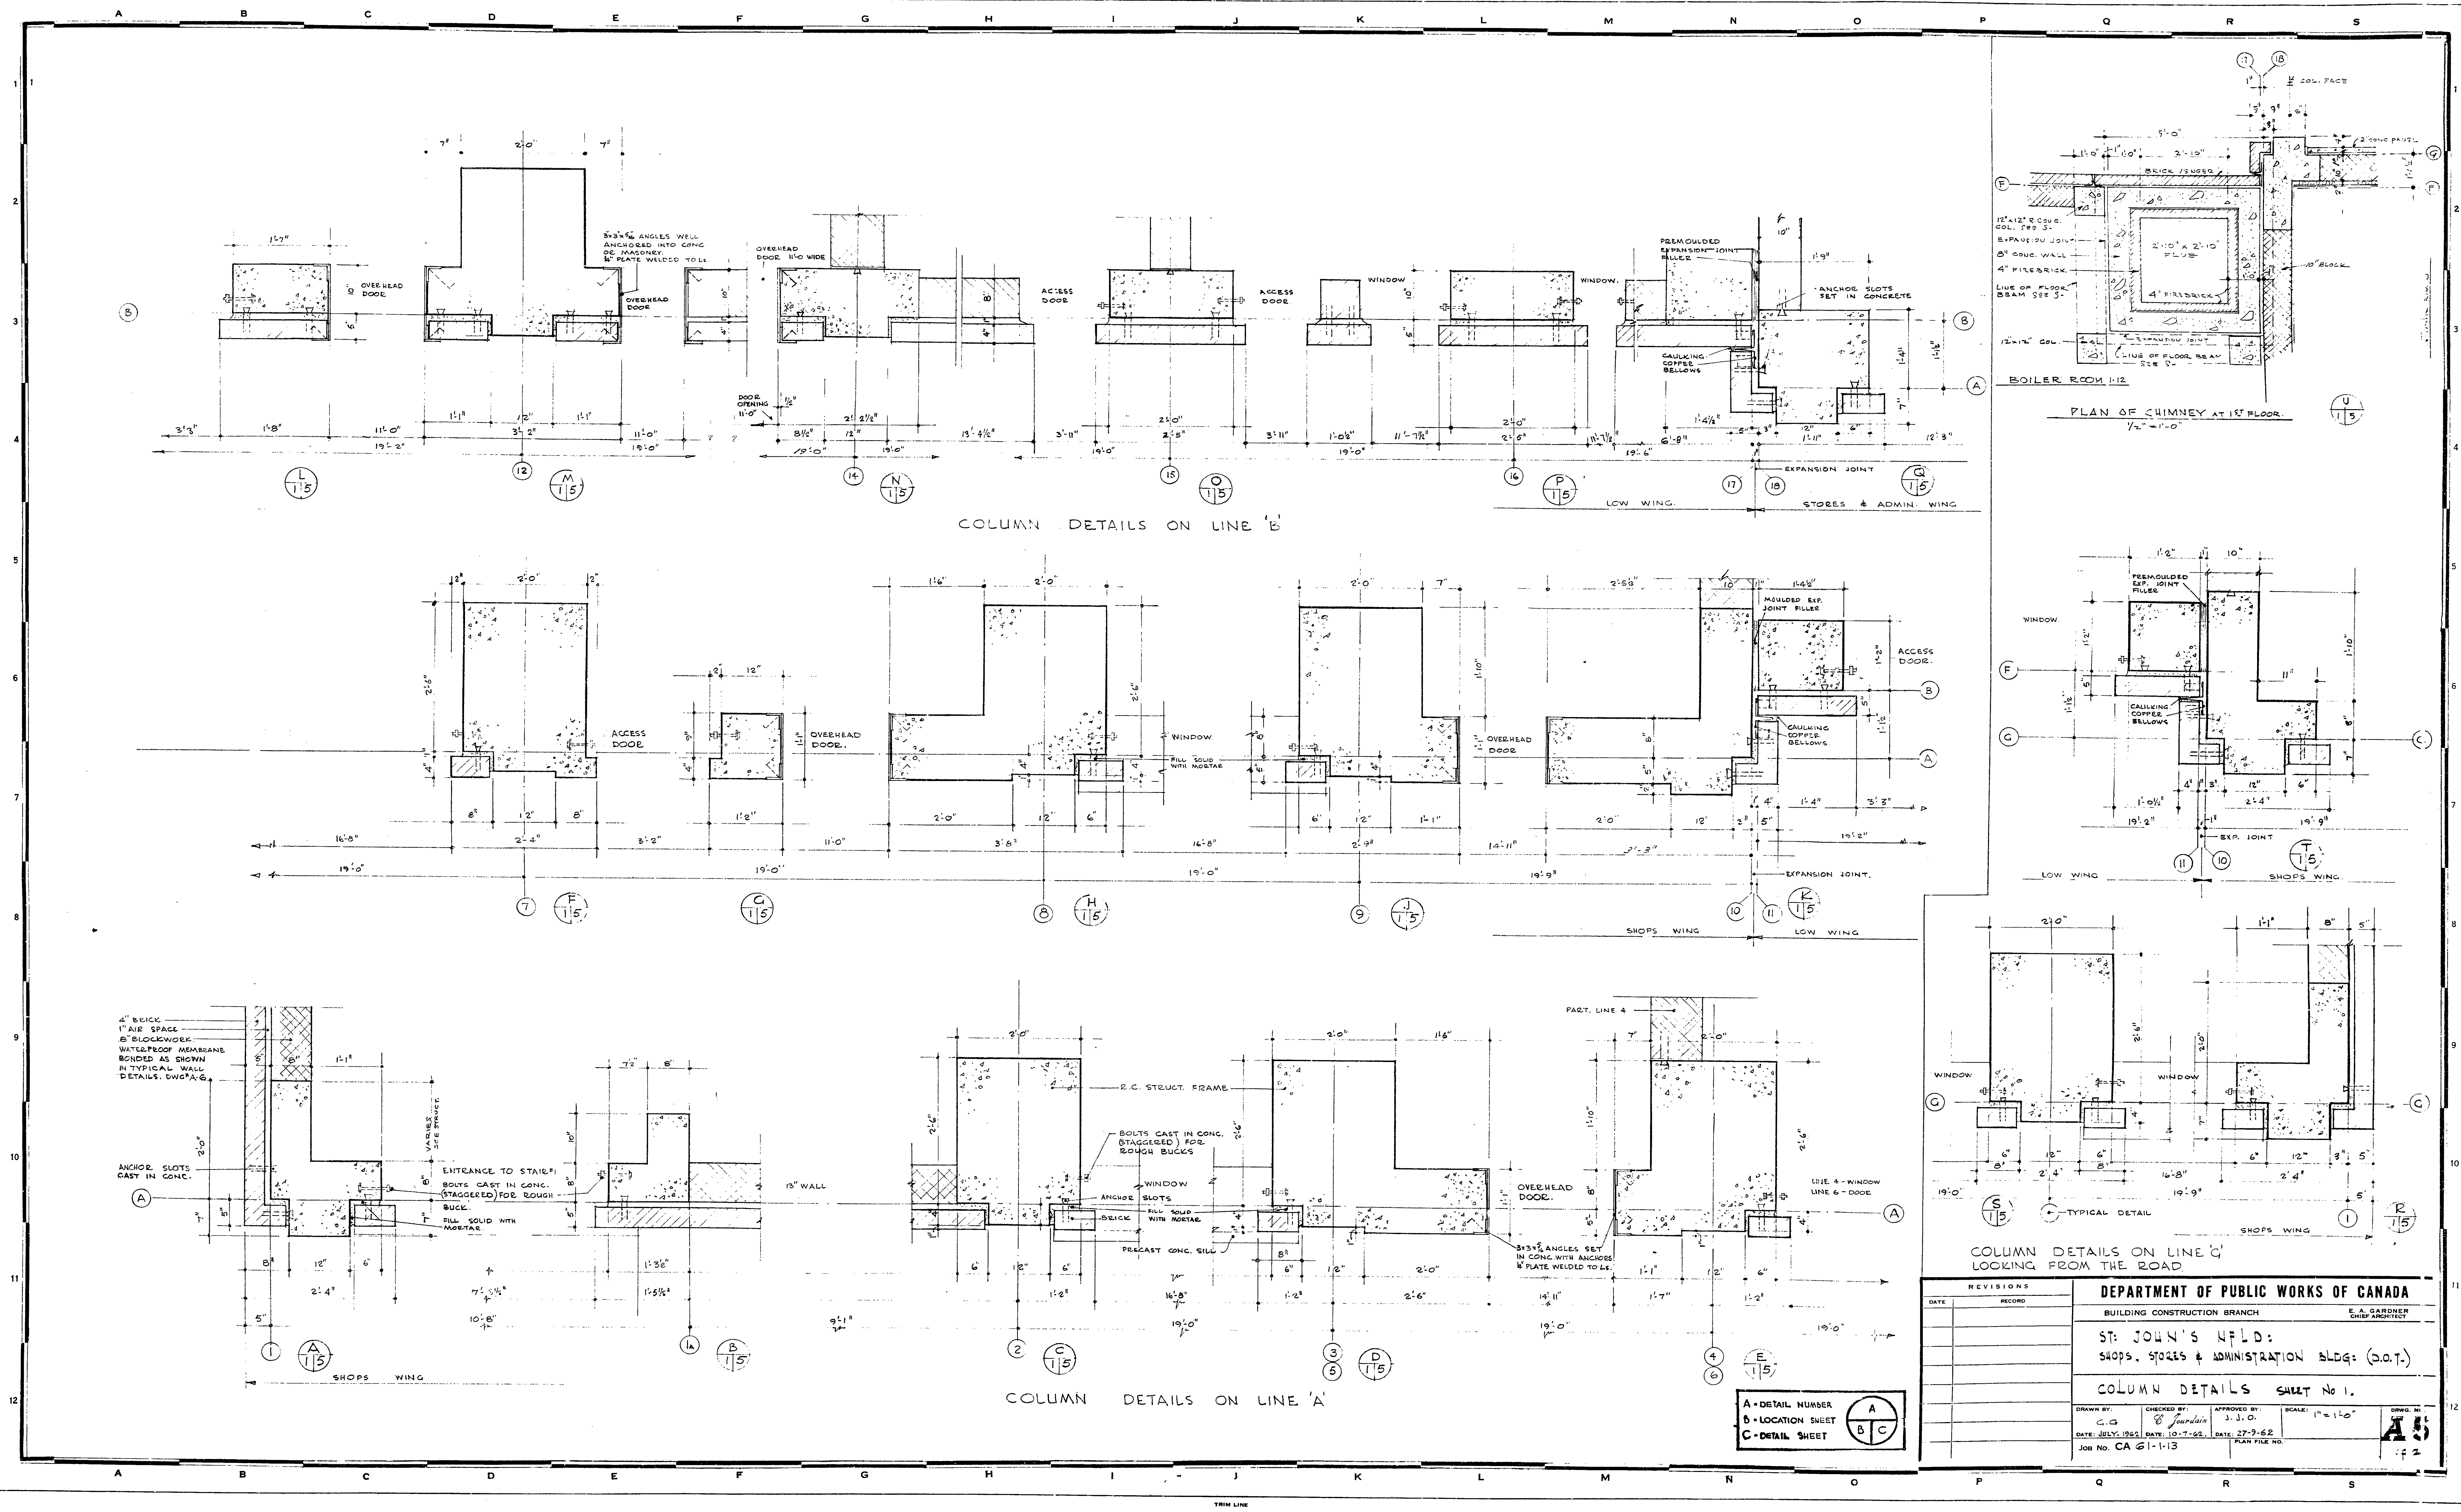

REVISIONS		DEPARTMENT OF PUBLIC WORKS OF CANADA			
DATE	RECORD	BUILDING CONSTRUCTION BRANCH		E. A. GARDNER CHIEF ARCHITECT	
		ST: JOHN'S HFLD: SHOPS, STORES & ADMINISTRATION BLDG: (S.O.T.)			
		COLUMN DETAILS SHEET No. 1.			
DRAWN BY: C.G.		CHECKED BY: E. A. Gardner		APPROVED BY: J.J.O.	
DATE: JULY 1962		DATE: 10-7-62		DATE: 27-9-62	
		JOB NO. CA 61-1-13		PLAN FILE NO.	
				SCALE: 1" = 1'-0"	
				DWG. NO. 1	

67CA-61-1-13/7 MICROFILMED

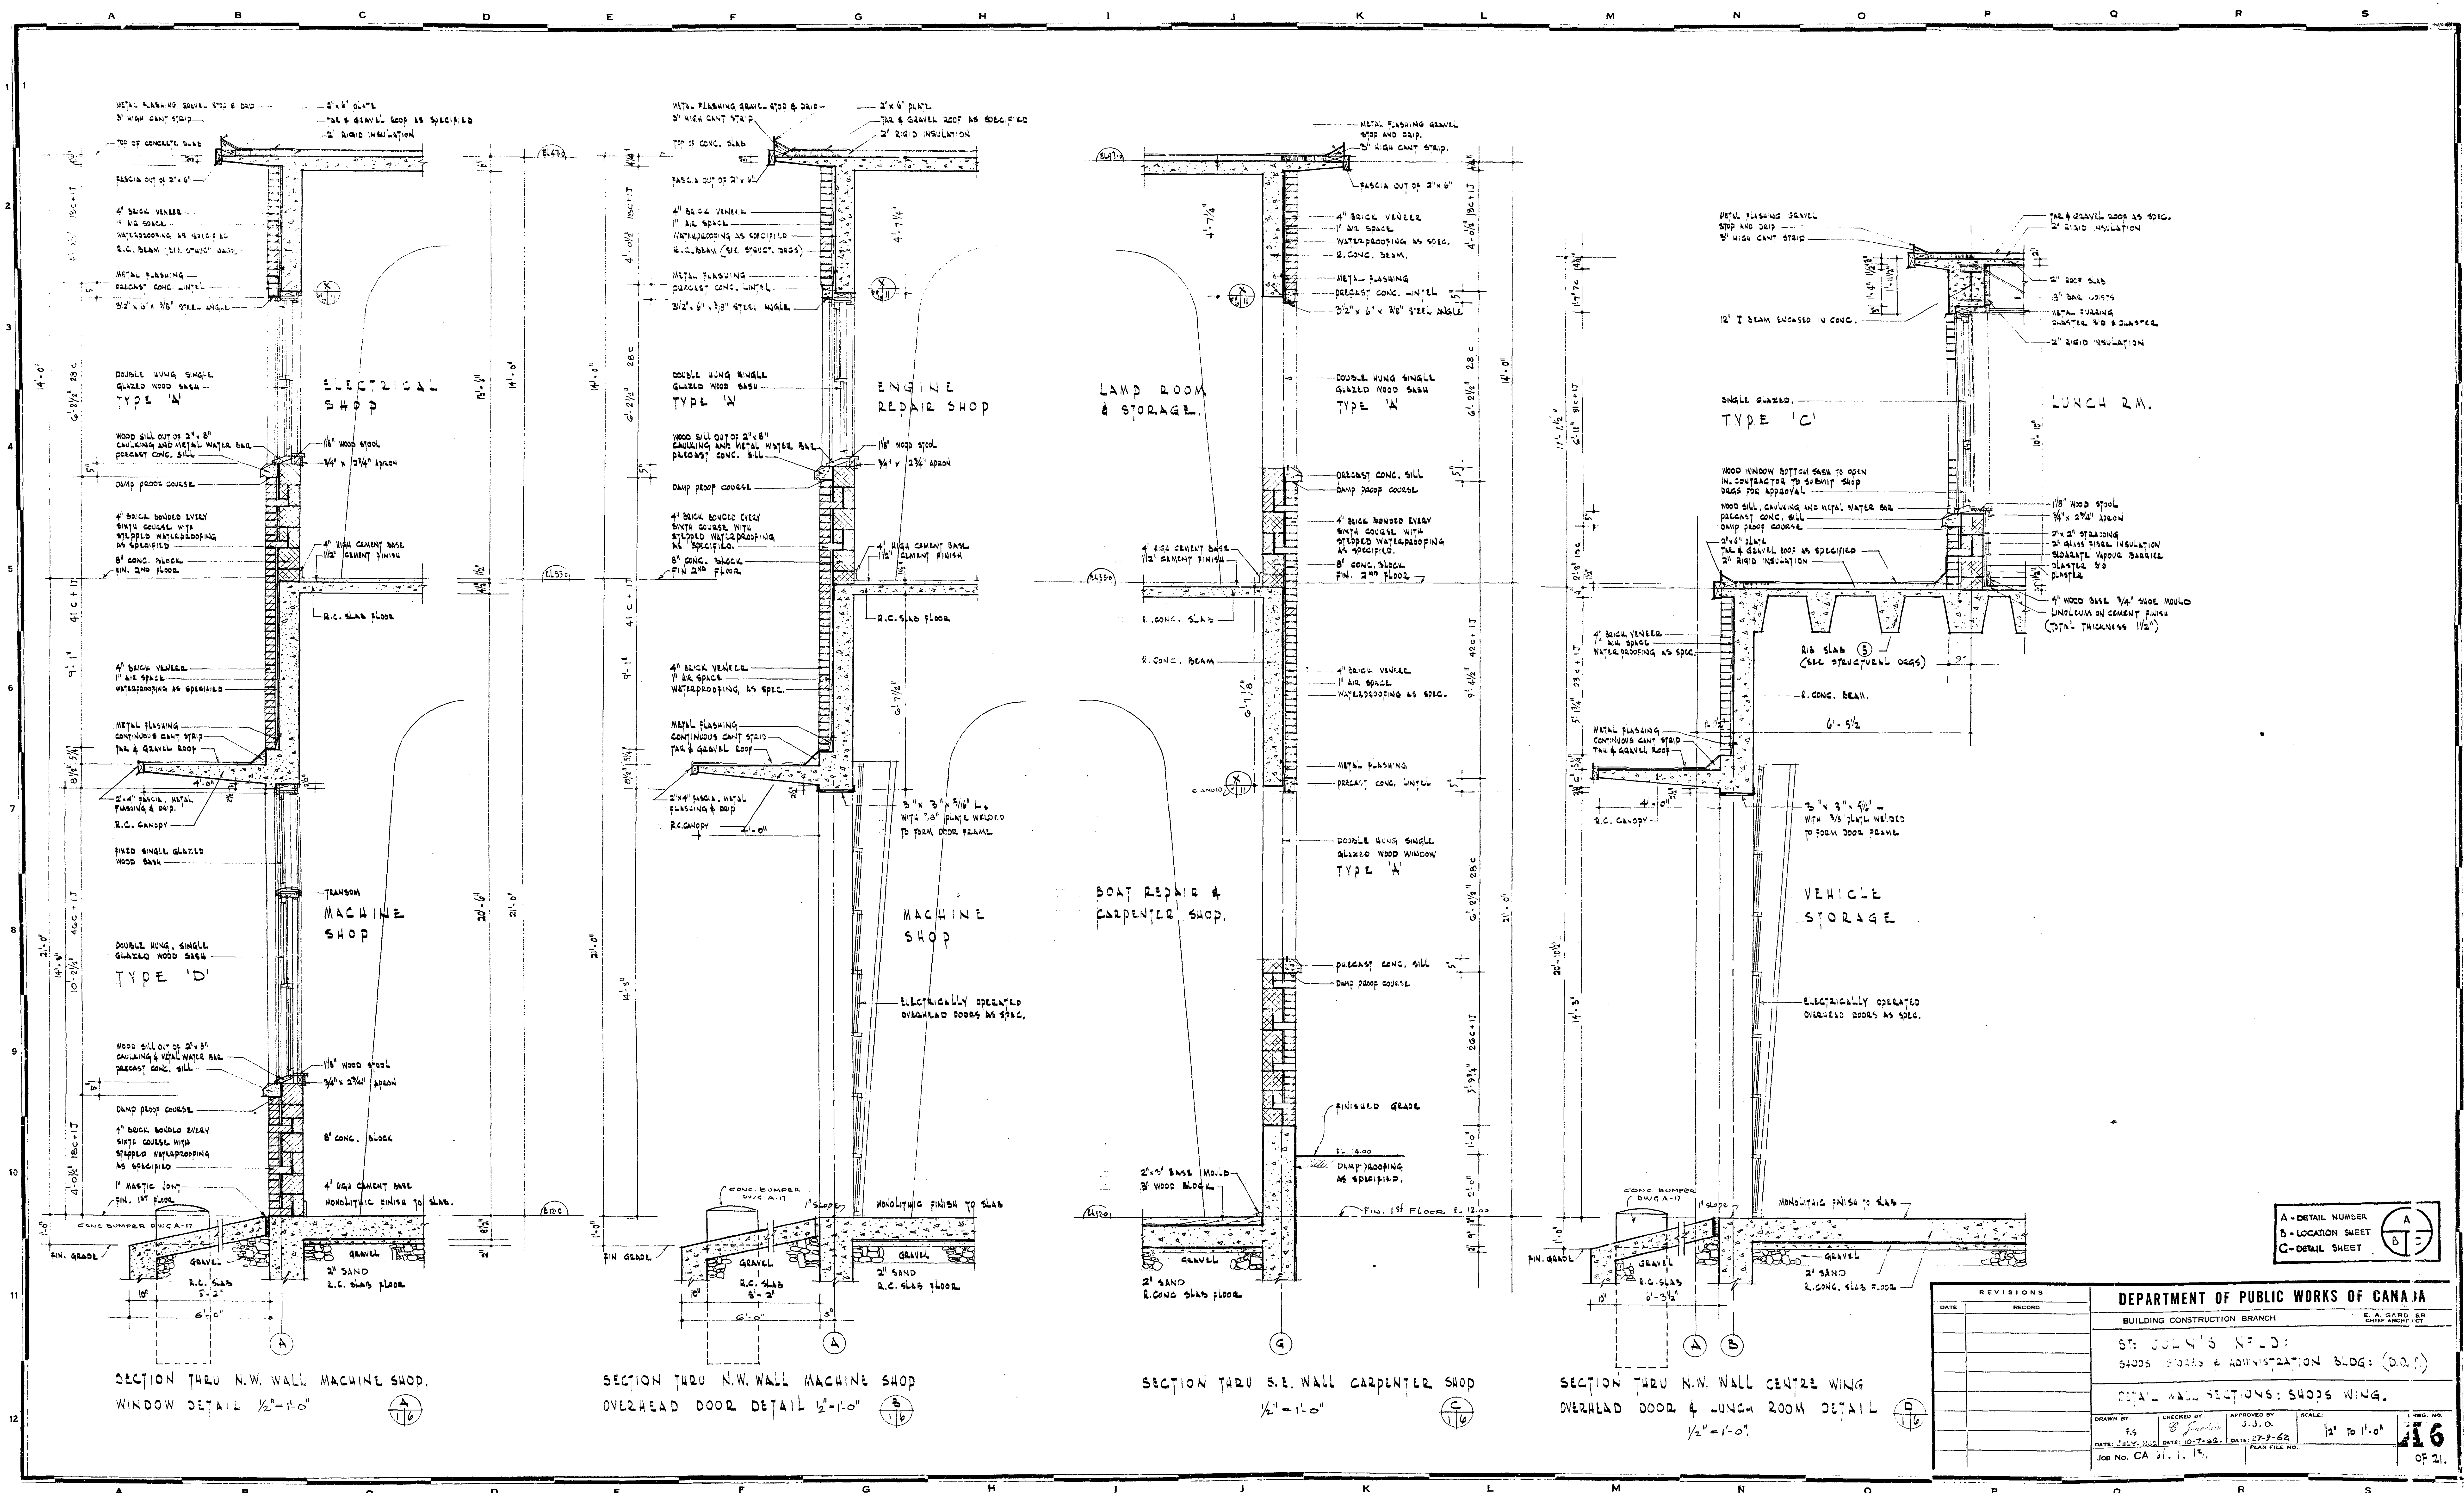

A-DETAIL NUMBER	A
B-LOCATION SHEET	B
C-DETAIL SHEET	C

REVISIONS

DATE RECORD

DEPARTMENT OF PUBLIC WORKS OF CANADA

BUILDING CONSTRUCTION BRANCH

E. A. GARDNER
CHIEF ARCHT. ET

ST. JOHN'S N.S.:

SHOPS, STORES & ADMINISTRATION BLDG. (D.O.)

DETAIL WALL SECTIONS: SHOPS WING.

DRAWN BY:

CHECKED BY:

APPROVED BY:

SCALE:

JOB NO.

P.S.

B. J. GARDNER

J. J. G.

1/2" To 1'-0"

DATE: JULY 1962

DATE: JULY 1962


DATE: JULY 1962

PLAN FILE NO.

JOB NO. CA 61-1-13/7


116

OF 21.

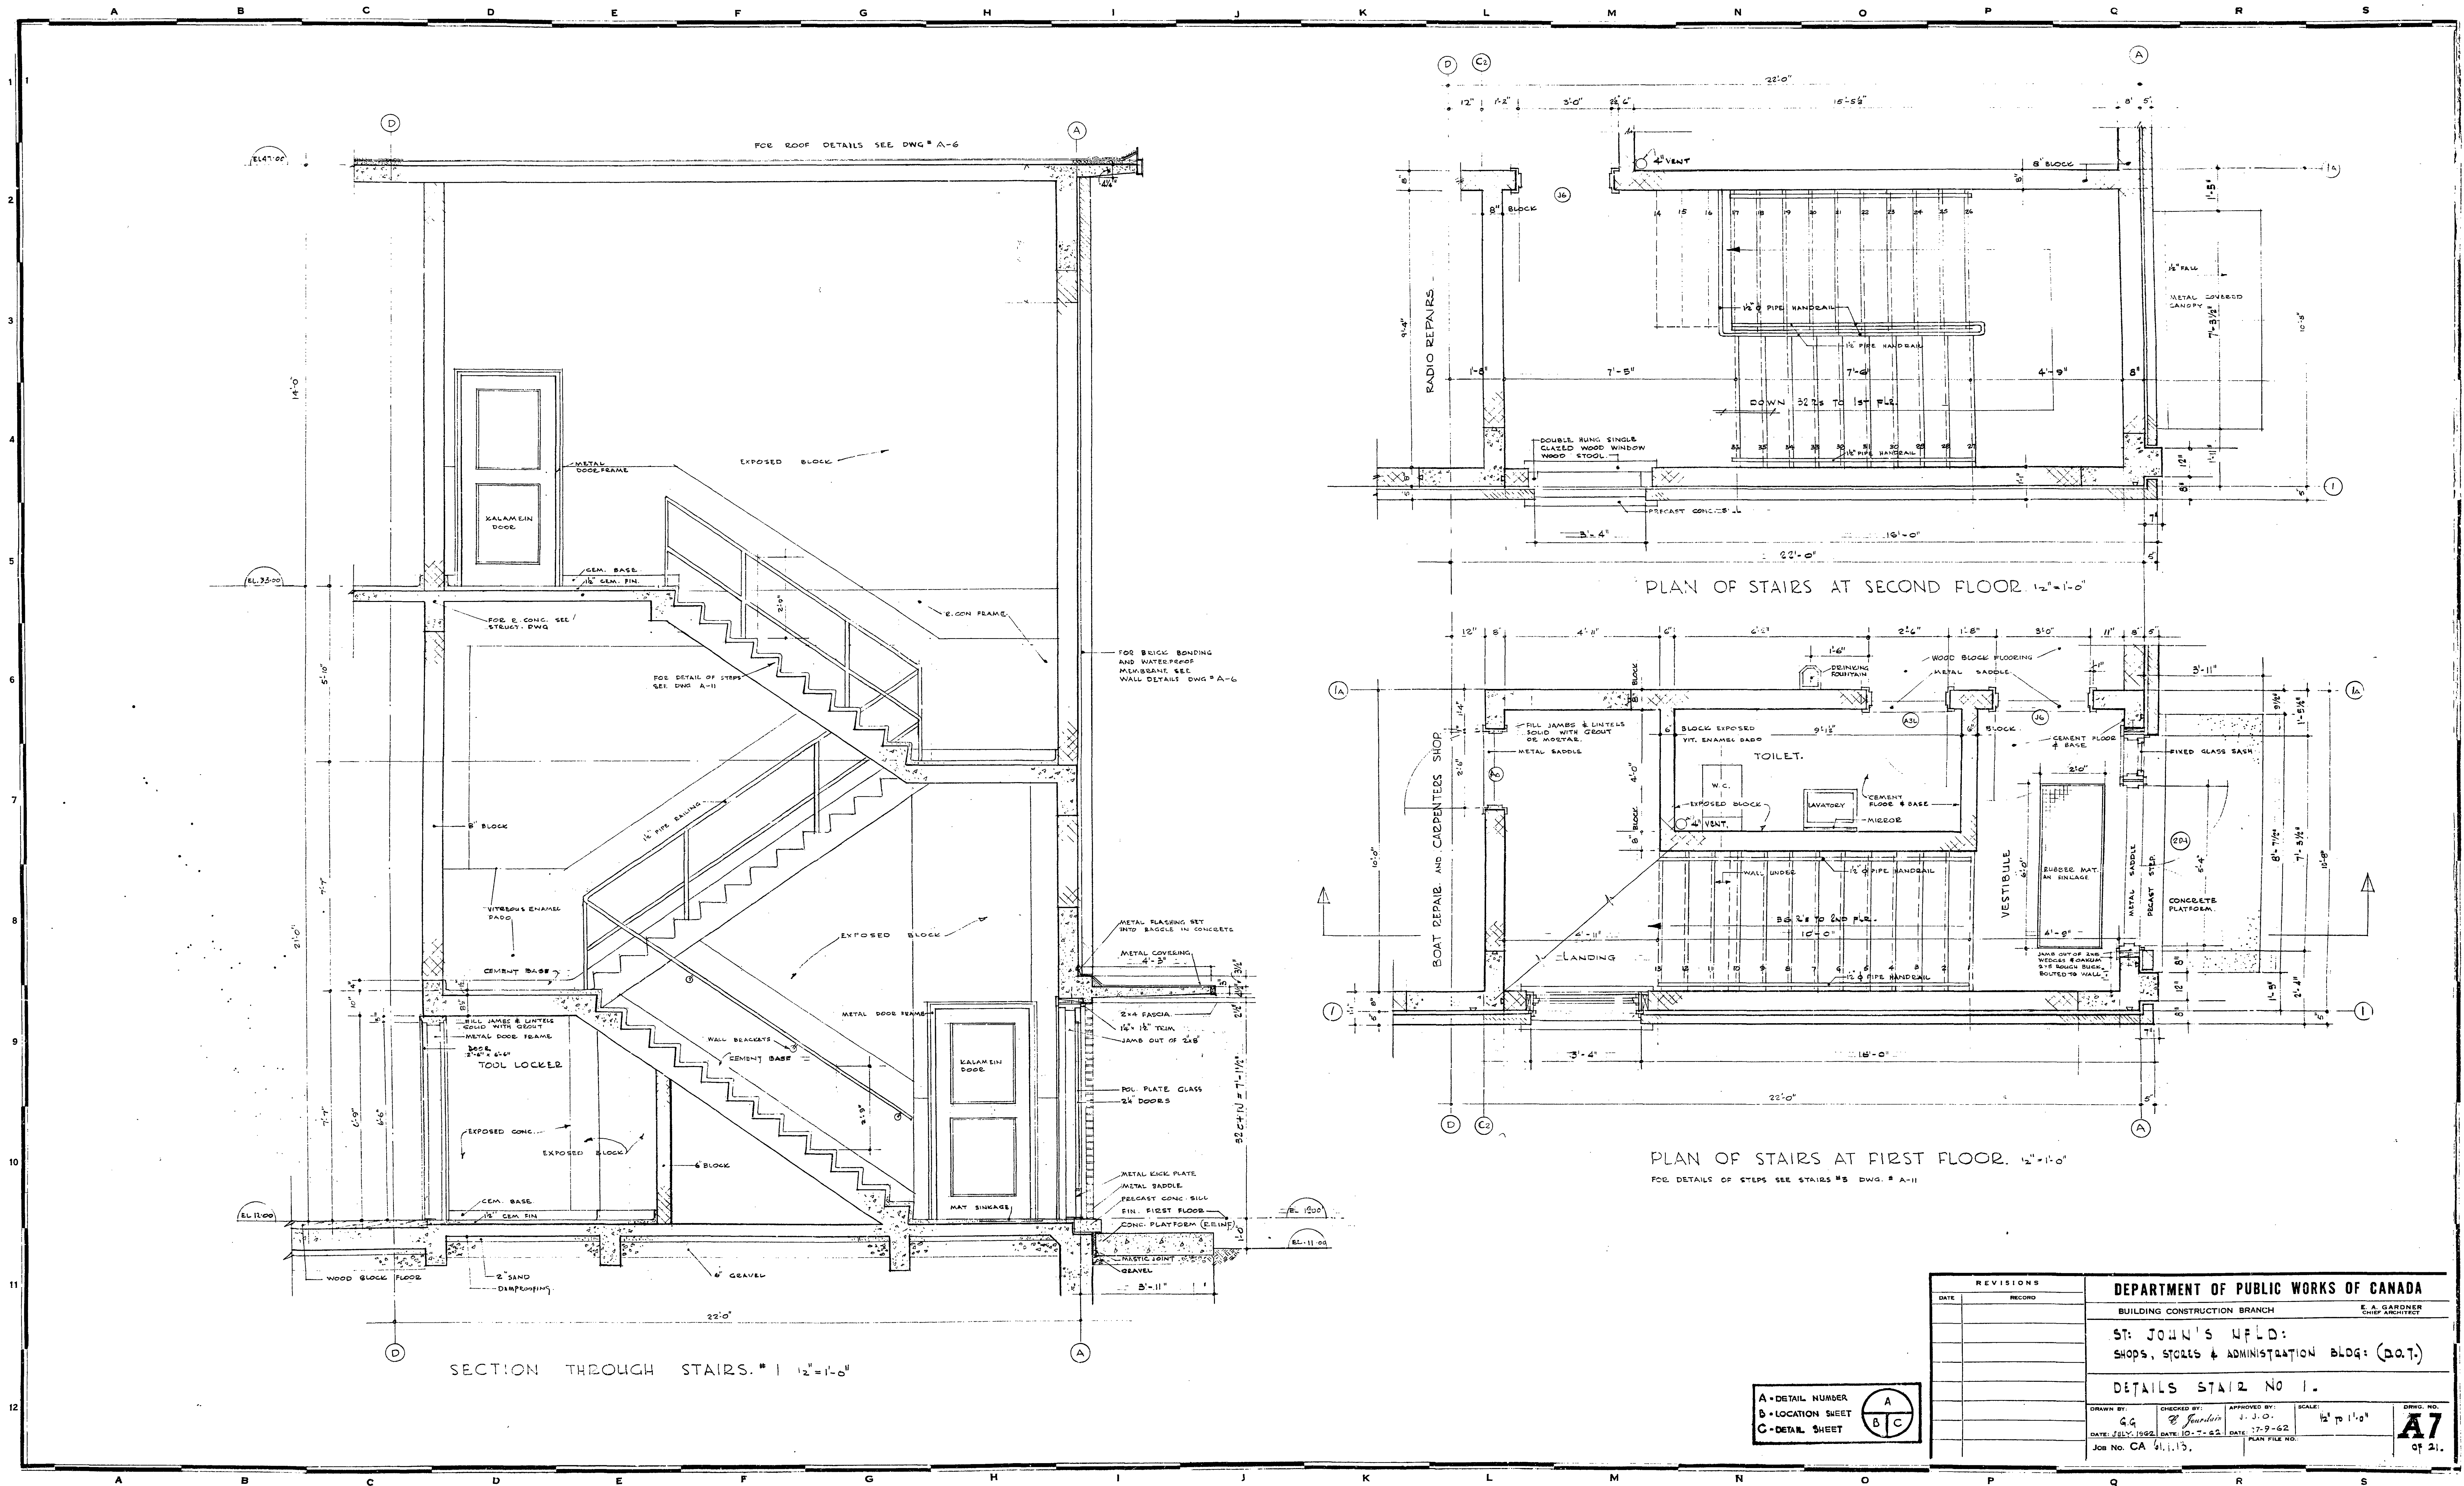


REVISIONS		DEPARTMENT OF PUBLIC WORKS OF CANADA			
DATE	RECORD	BUILDING CONSTRUCTION BRANCH		E. A. GARDNER CHIEF ARCHITECT	
		ST. JOHN'S WFLD:			
		SHOPS, STORES & ADMINISTRATION BLDG: (D.O.T.)			
		DETAILS STAIR NO 1.			
DRAWN BY: C.G.		CHECKED BY: E. Gardner	APPROVED BY: J. J. O.	SCALE: 1/2" = 1'-0"	DWG. NO. A7
DATE: JULY 1962		DATE: 10-7-62	DATE: 17-9-62	PLAN FILE NO.	OF 21.
JOB NO. CA 61.13.					

G-CA-61-1-13/9 MICROFILMET.

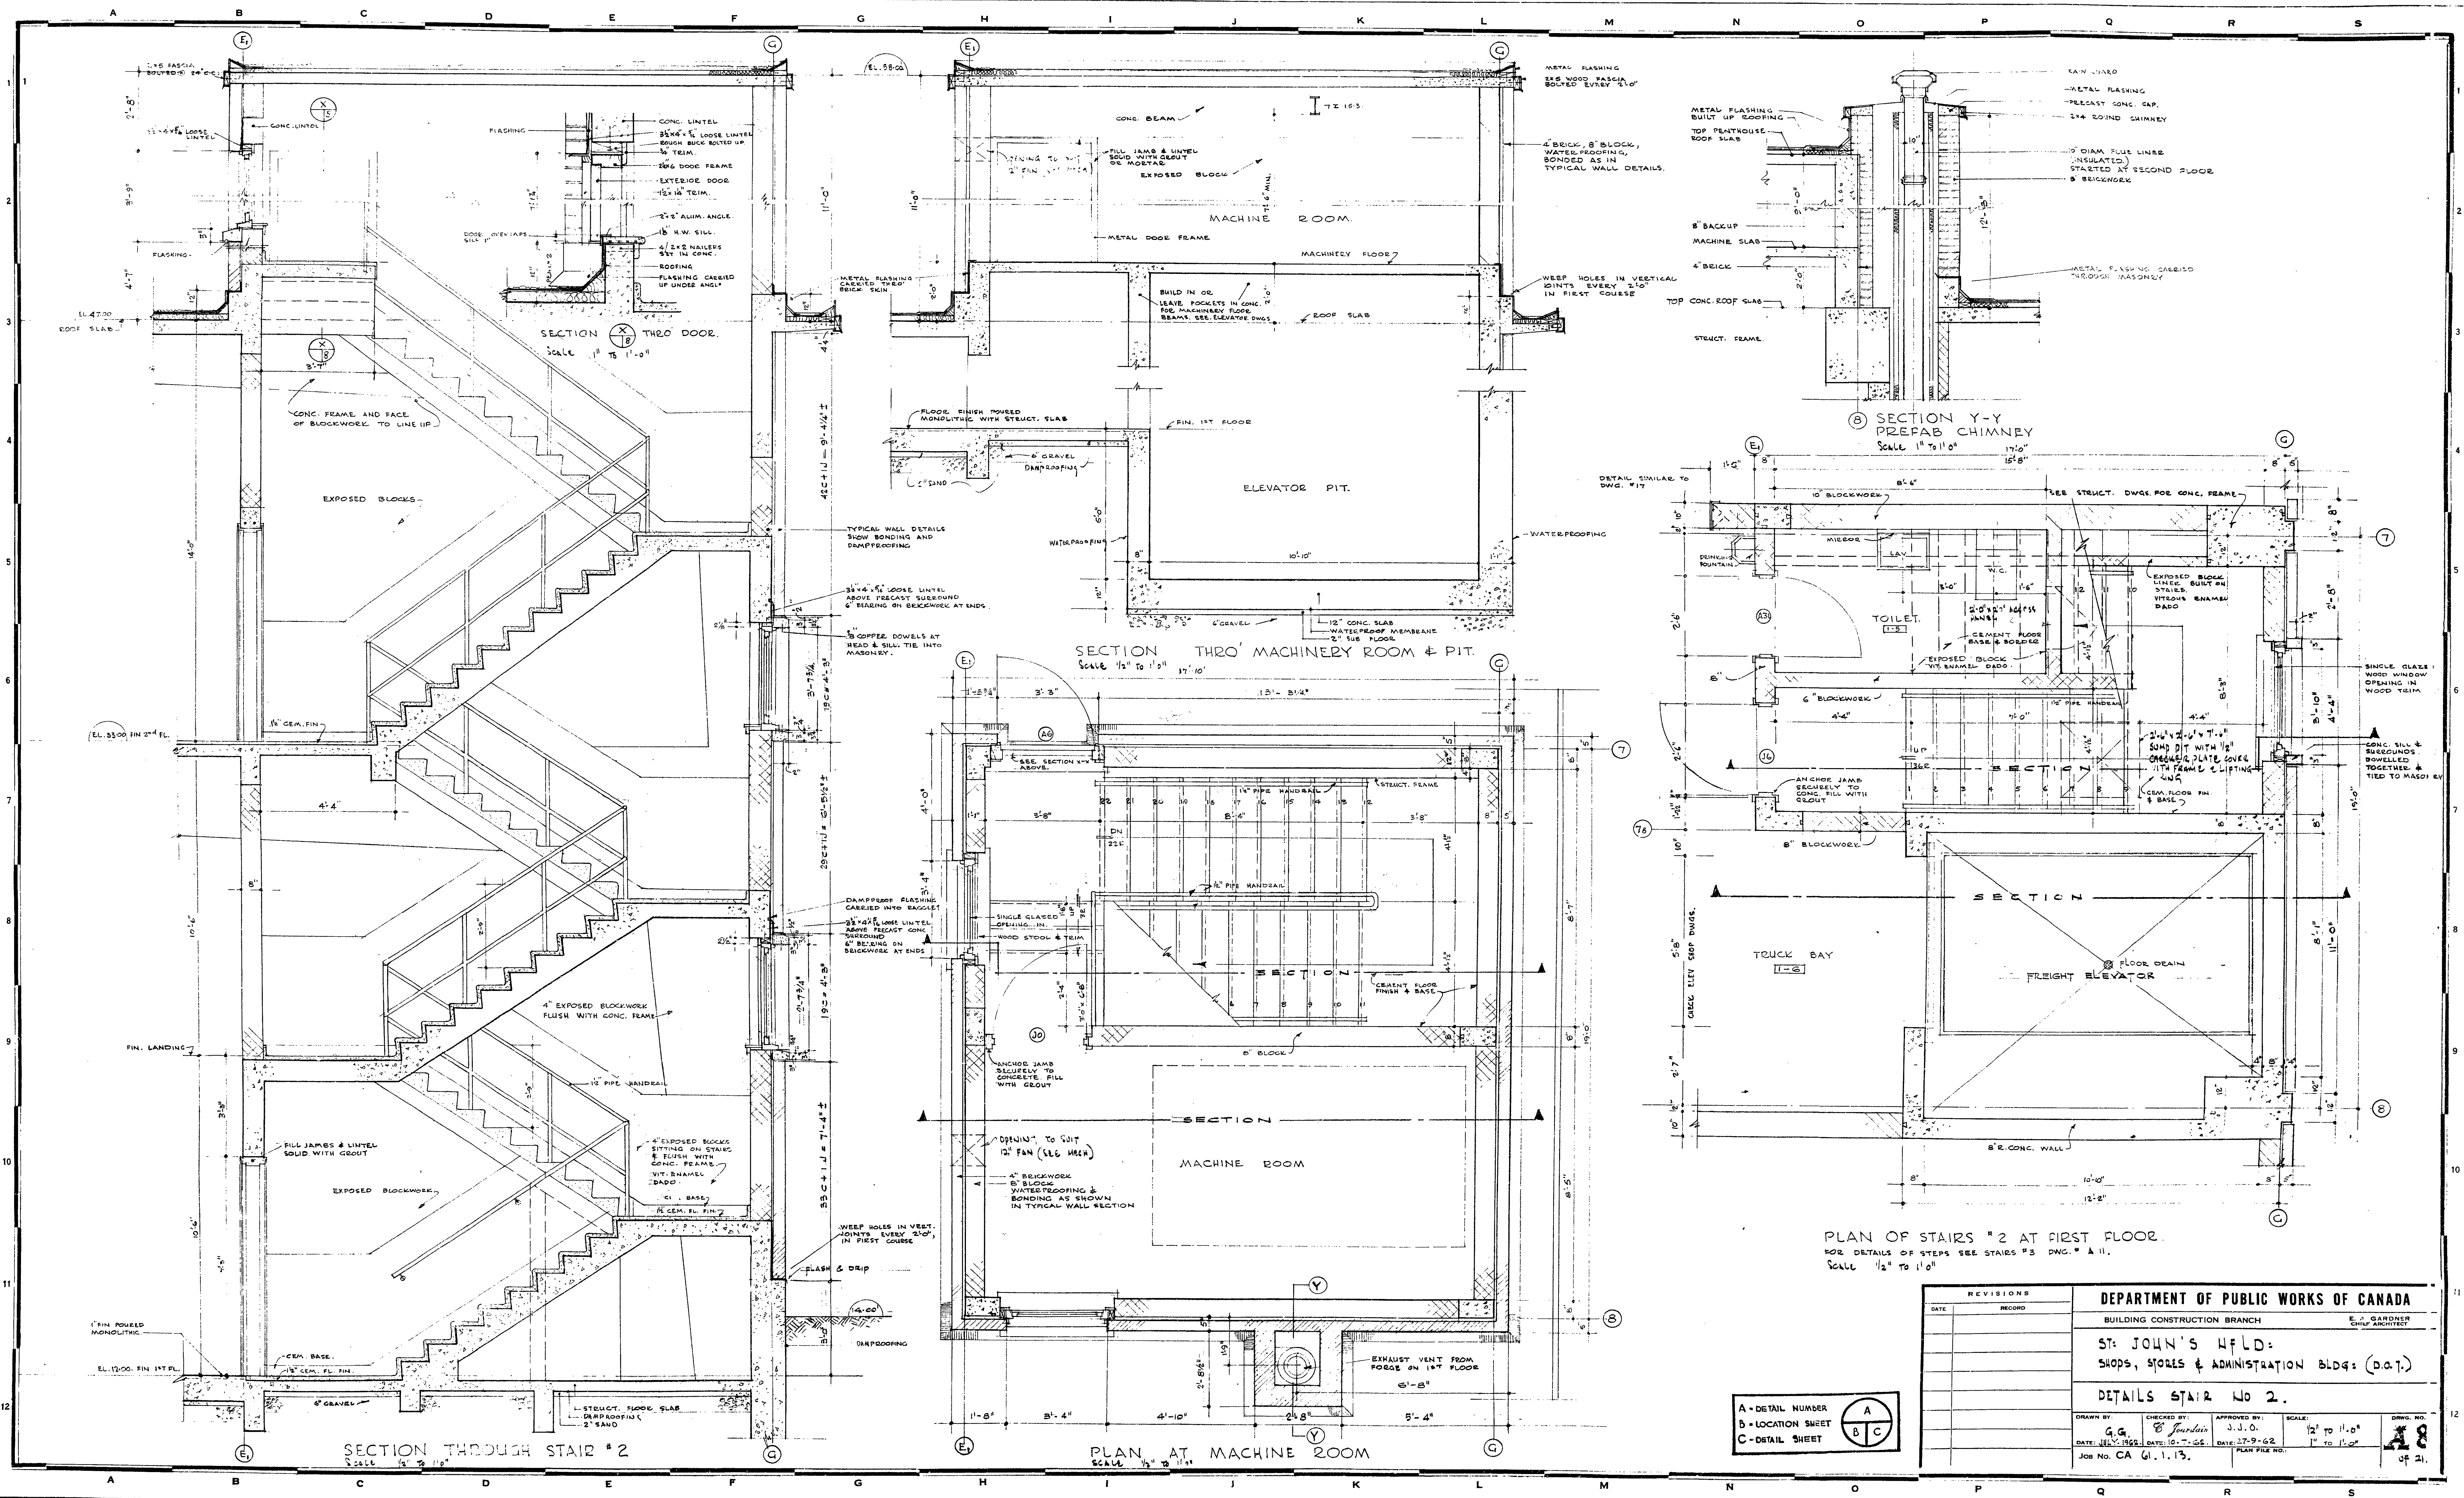


REVISIONS		DEPARTMENT OF PUBLIC WORKS OF CANADA	
DATE	RECORD	BUILDING CONSTRUCTION BRANCH	E. J. GARDNER CHIEF ARCHITECT
		ST. JOHN'S WFLD: SHOPS, STORES & ADMINISTRATION BLDG. (D.A.T.)	
		DETAILS STAIR No 2.	
DRAWN BY G. G.	CHECKED BY J. J. O.	APPROVED BY J. J. O.	SCALE 1/2" TO 11'-0"
DATE JULY 1962	DATE JULY 1962	DATE JULY 1962	DATE JULY 1962
JOB NO. CA 61.1.13.		PLAN FILE NO.	
		OF 21.	


G-CA-61-1-13/10 MICROFILMED

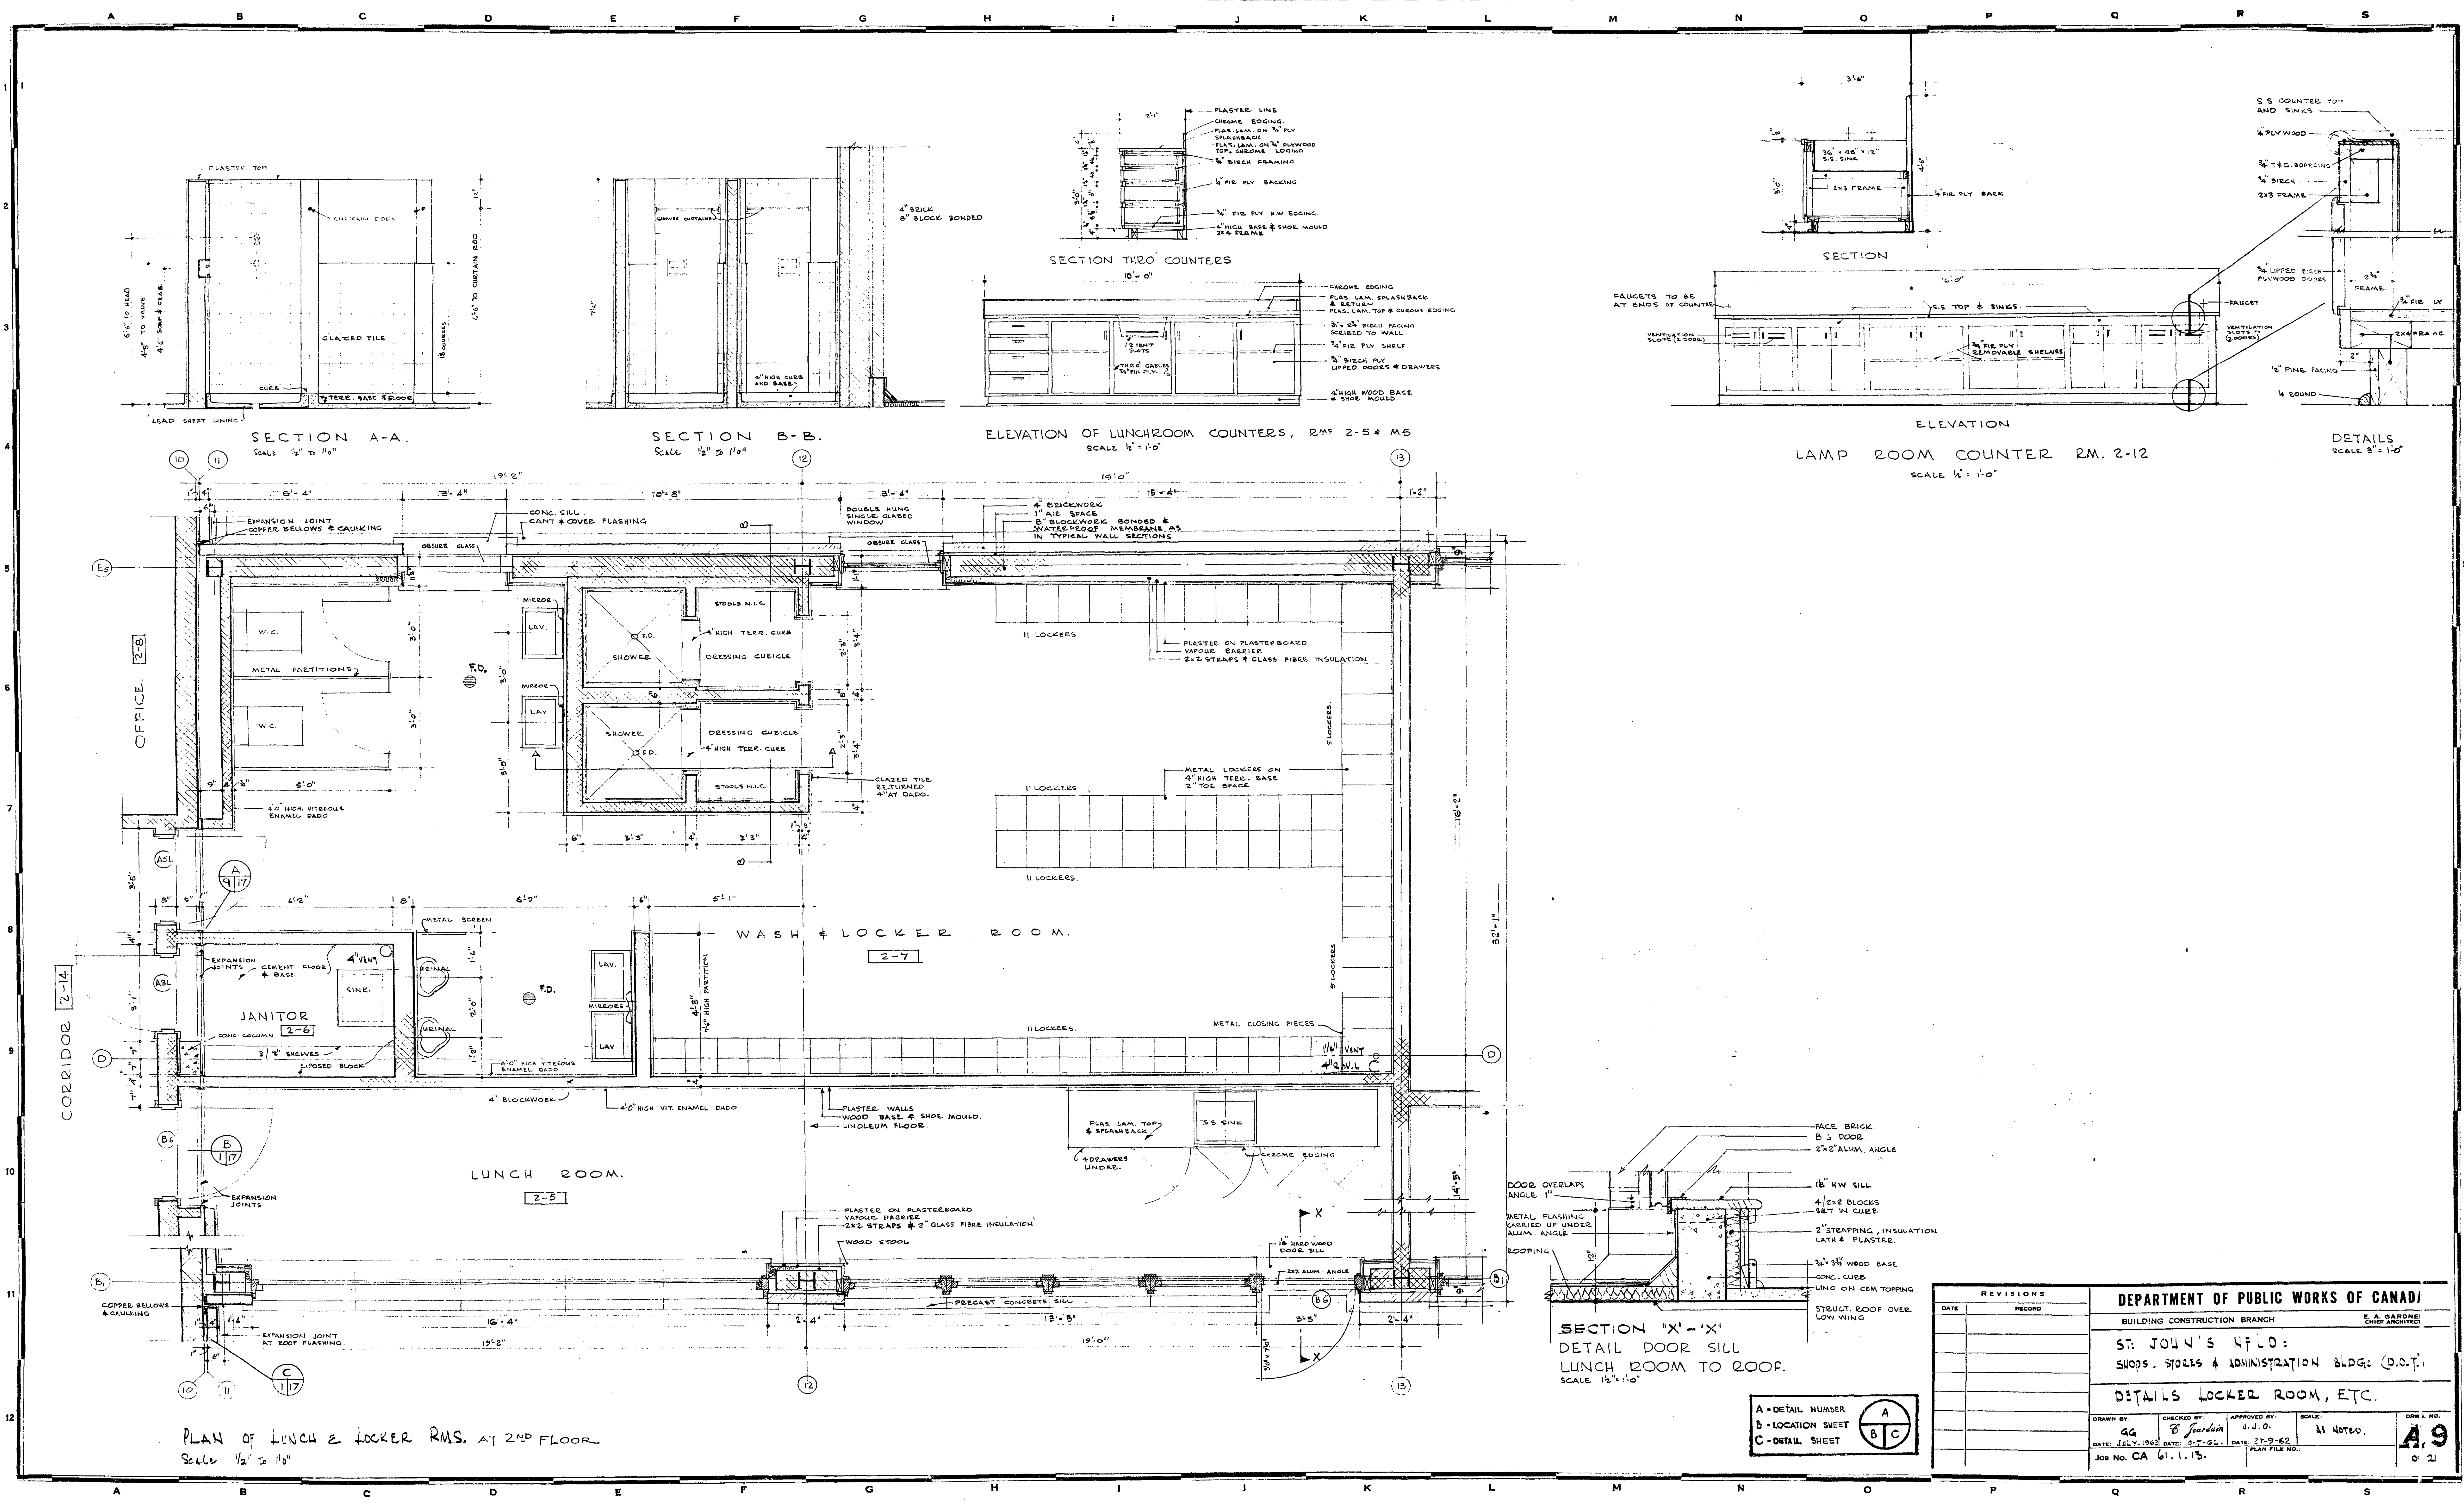

REVISIONS		DEPARTMENT OF PUBLIC WORKS OF CANADA			
DATE	RECORD	BUILDING CONSTRUCTION BRANCH		E. A. GARDNER CHIEF ARCHITECT	
		ST. JOHN'S N.F.D.: SHOPS, STALLS & ADMINISTRATION BLDG. (D.O.T.)			
		DETAILS LOCKER ROOM, ETC.			
DRAWN BY: 44		CHECKED BY: E. Gardiner	APPROVED BY: J. J. O.	SCALE: AS NOTED.	DWN. NO. A.9
DATE: JULY 1962		DATE: 12-7-62	DATE: 27-9-62	JOB NO. CA 61-1-13.	
		PLAN FILE NO.		0 21	

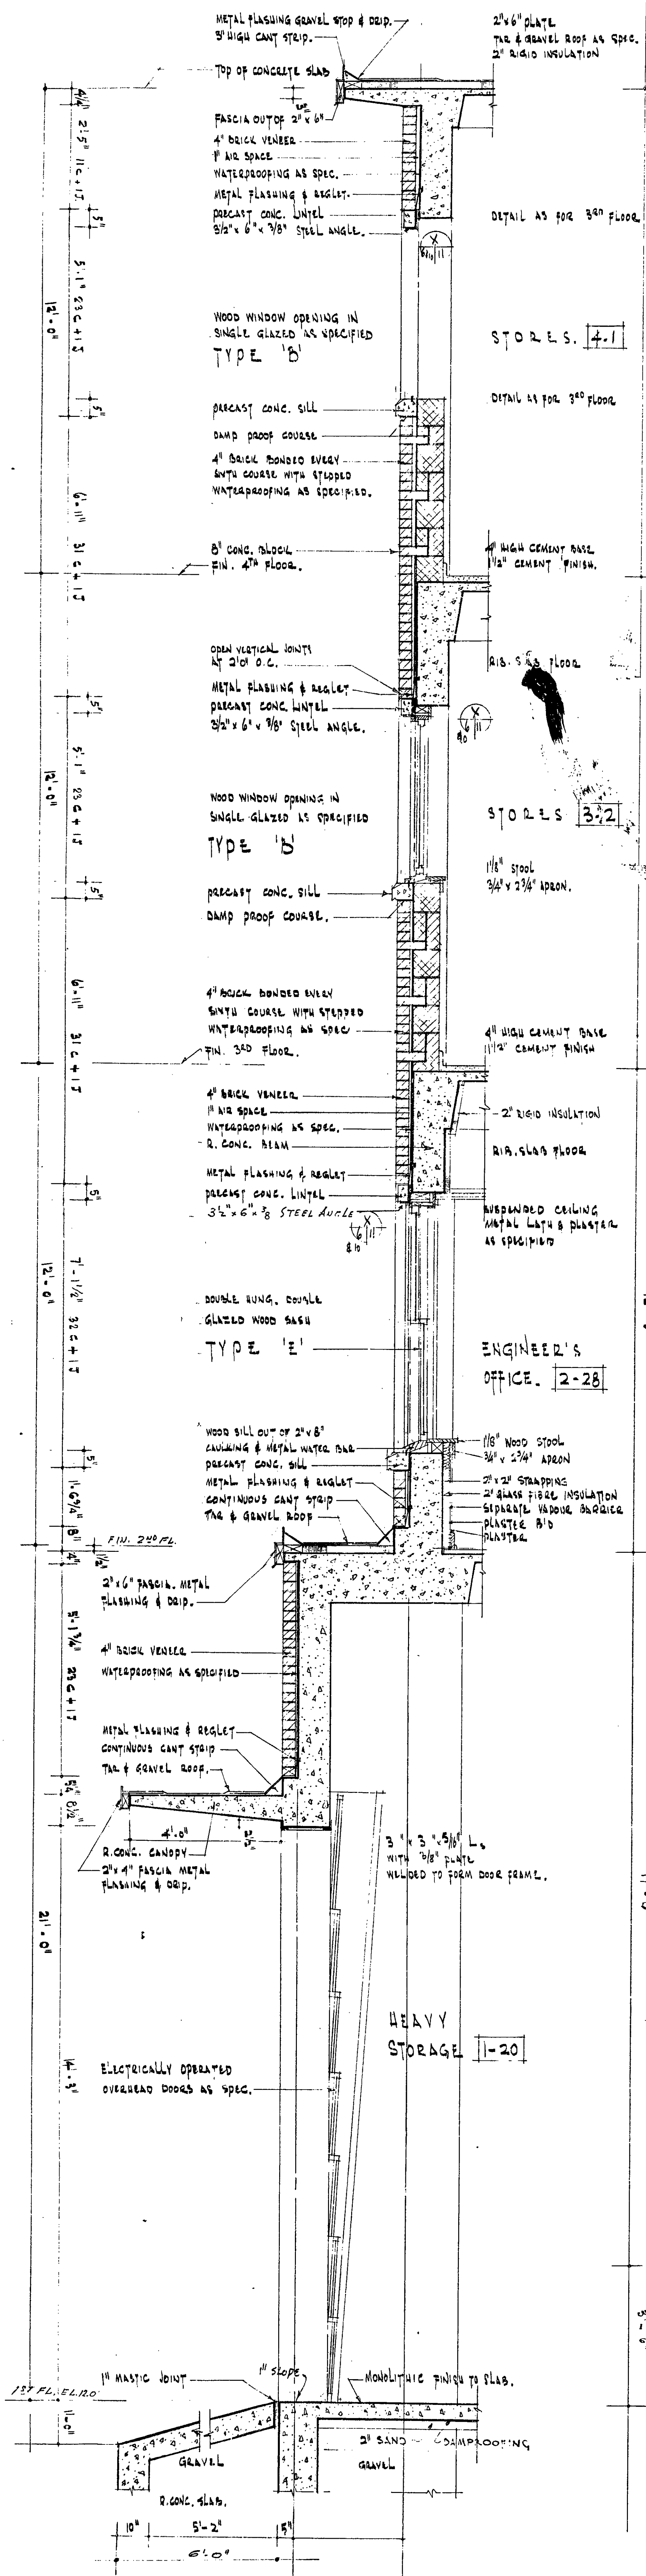

SECTION THRU N.W. WALL ADMINISTRATION WING
OVERHEAD DOOR DETAIL 1/2"=1'-0"

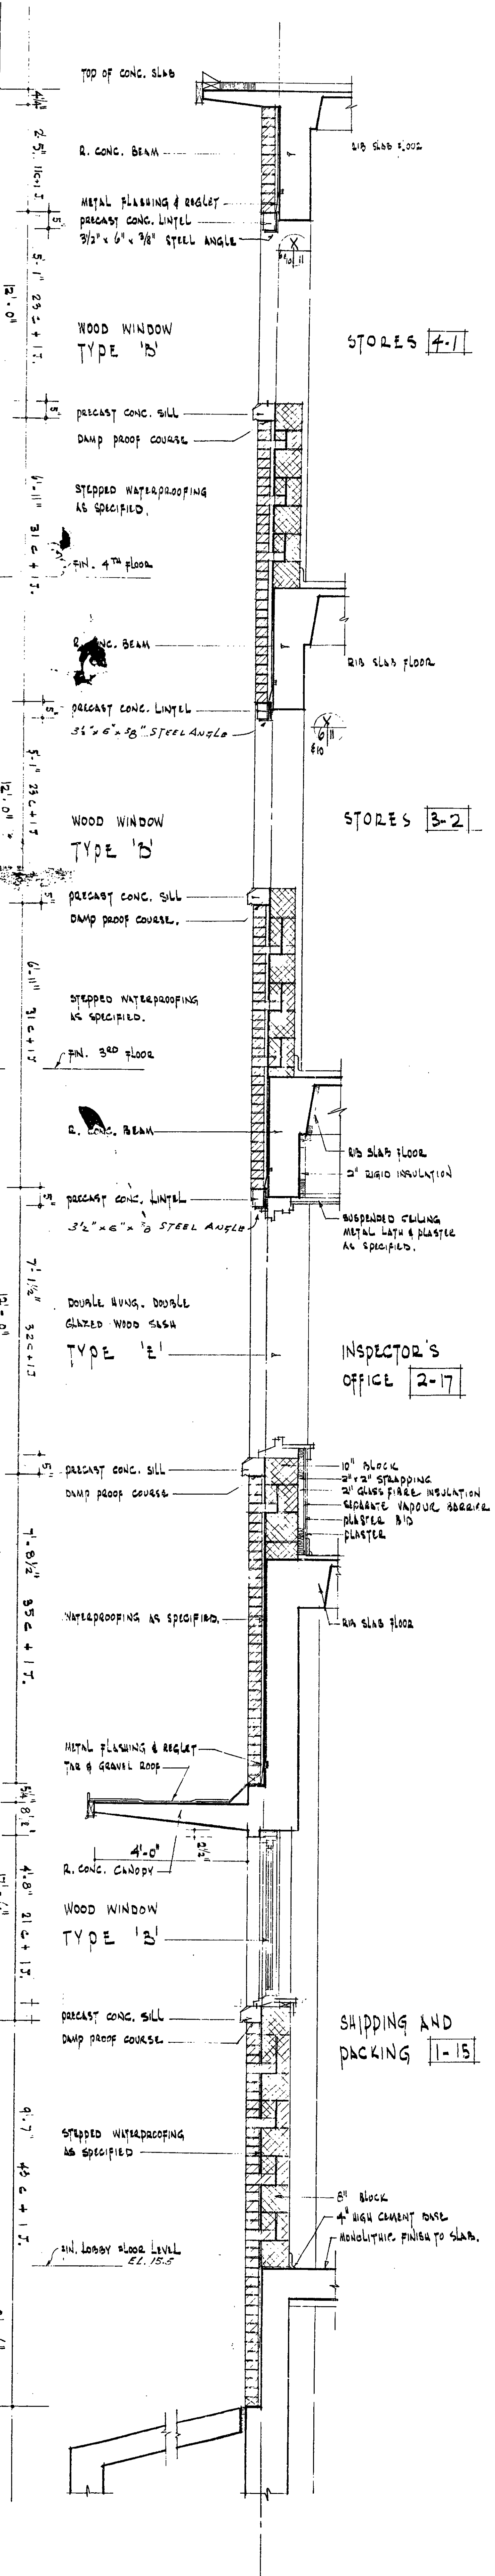


SECTION THRU N.W. WALL ADMINISTRATION WING
WINDOW DETAIL 1/2"=1'-0"

A - DETAIL NUMBER
B - LOCATION SHEET
C - DETAIL SHEET

REVISIONS	
NO.	DESCRIPTION

DEPARTMENT OF PUBLIC WORKS OF CANADA
BUILDING CONSTRUCTION BRANCH
ST. JOHN'S, Nfld.
SHOPS, STORES & ADMINISTRATION BLDG. (D.O.T.)
DETAIL WALL SECTIONS ADMINISTRATION WING
DRAWN BY: J. J. O. DATE: 27-9-68
CHECKED BY: J. J. O. DATE: 27-9-68
JOB NO. CA 61-1-15
SCALE: 1/2"=1'-0"

G-CA-61-1-13/12

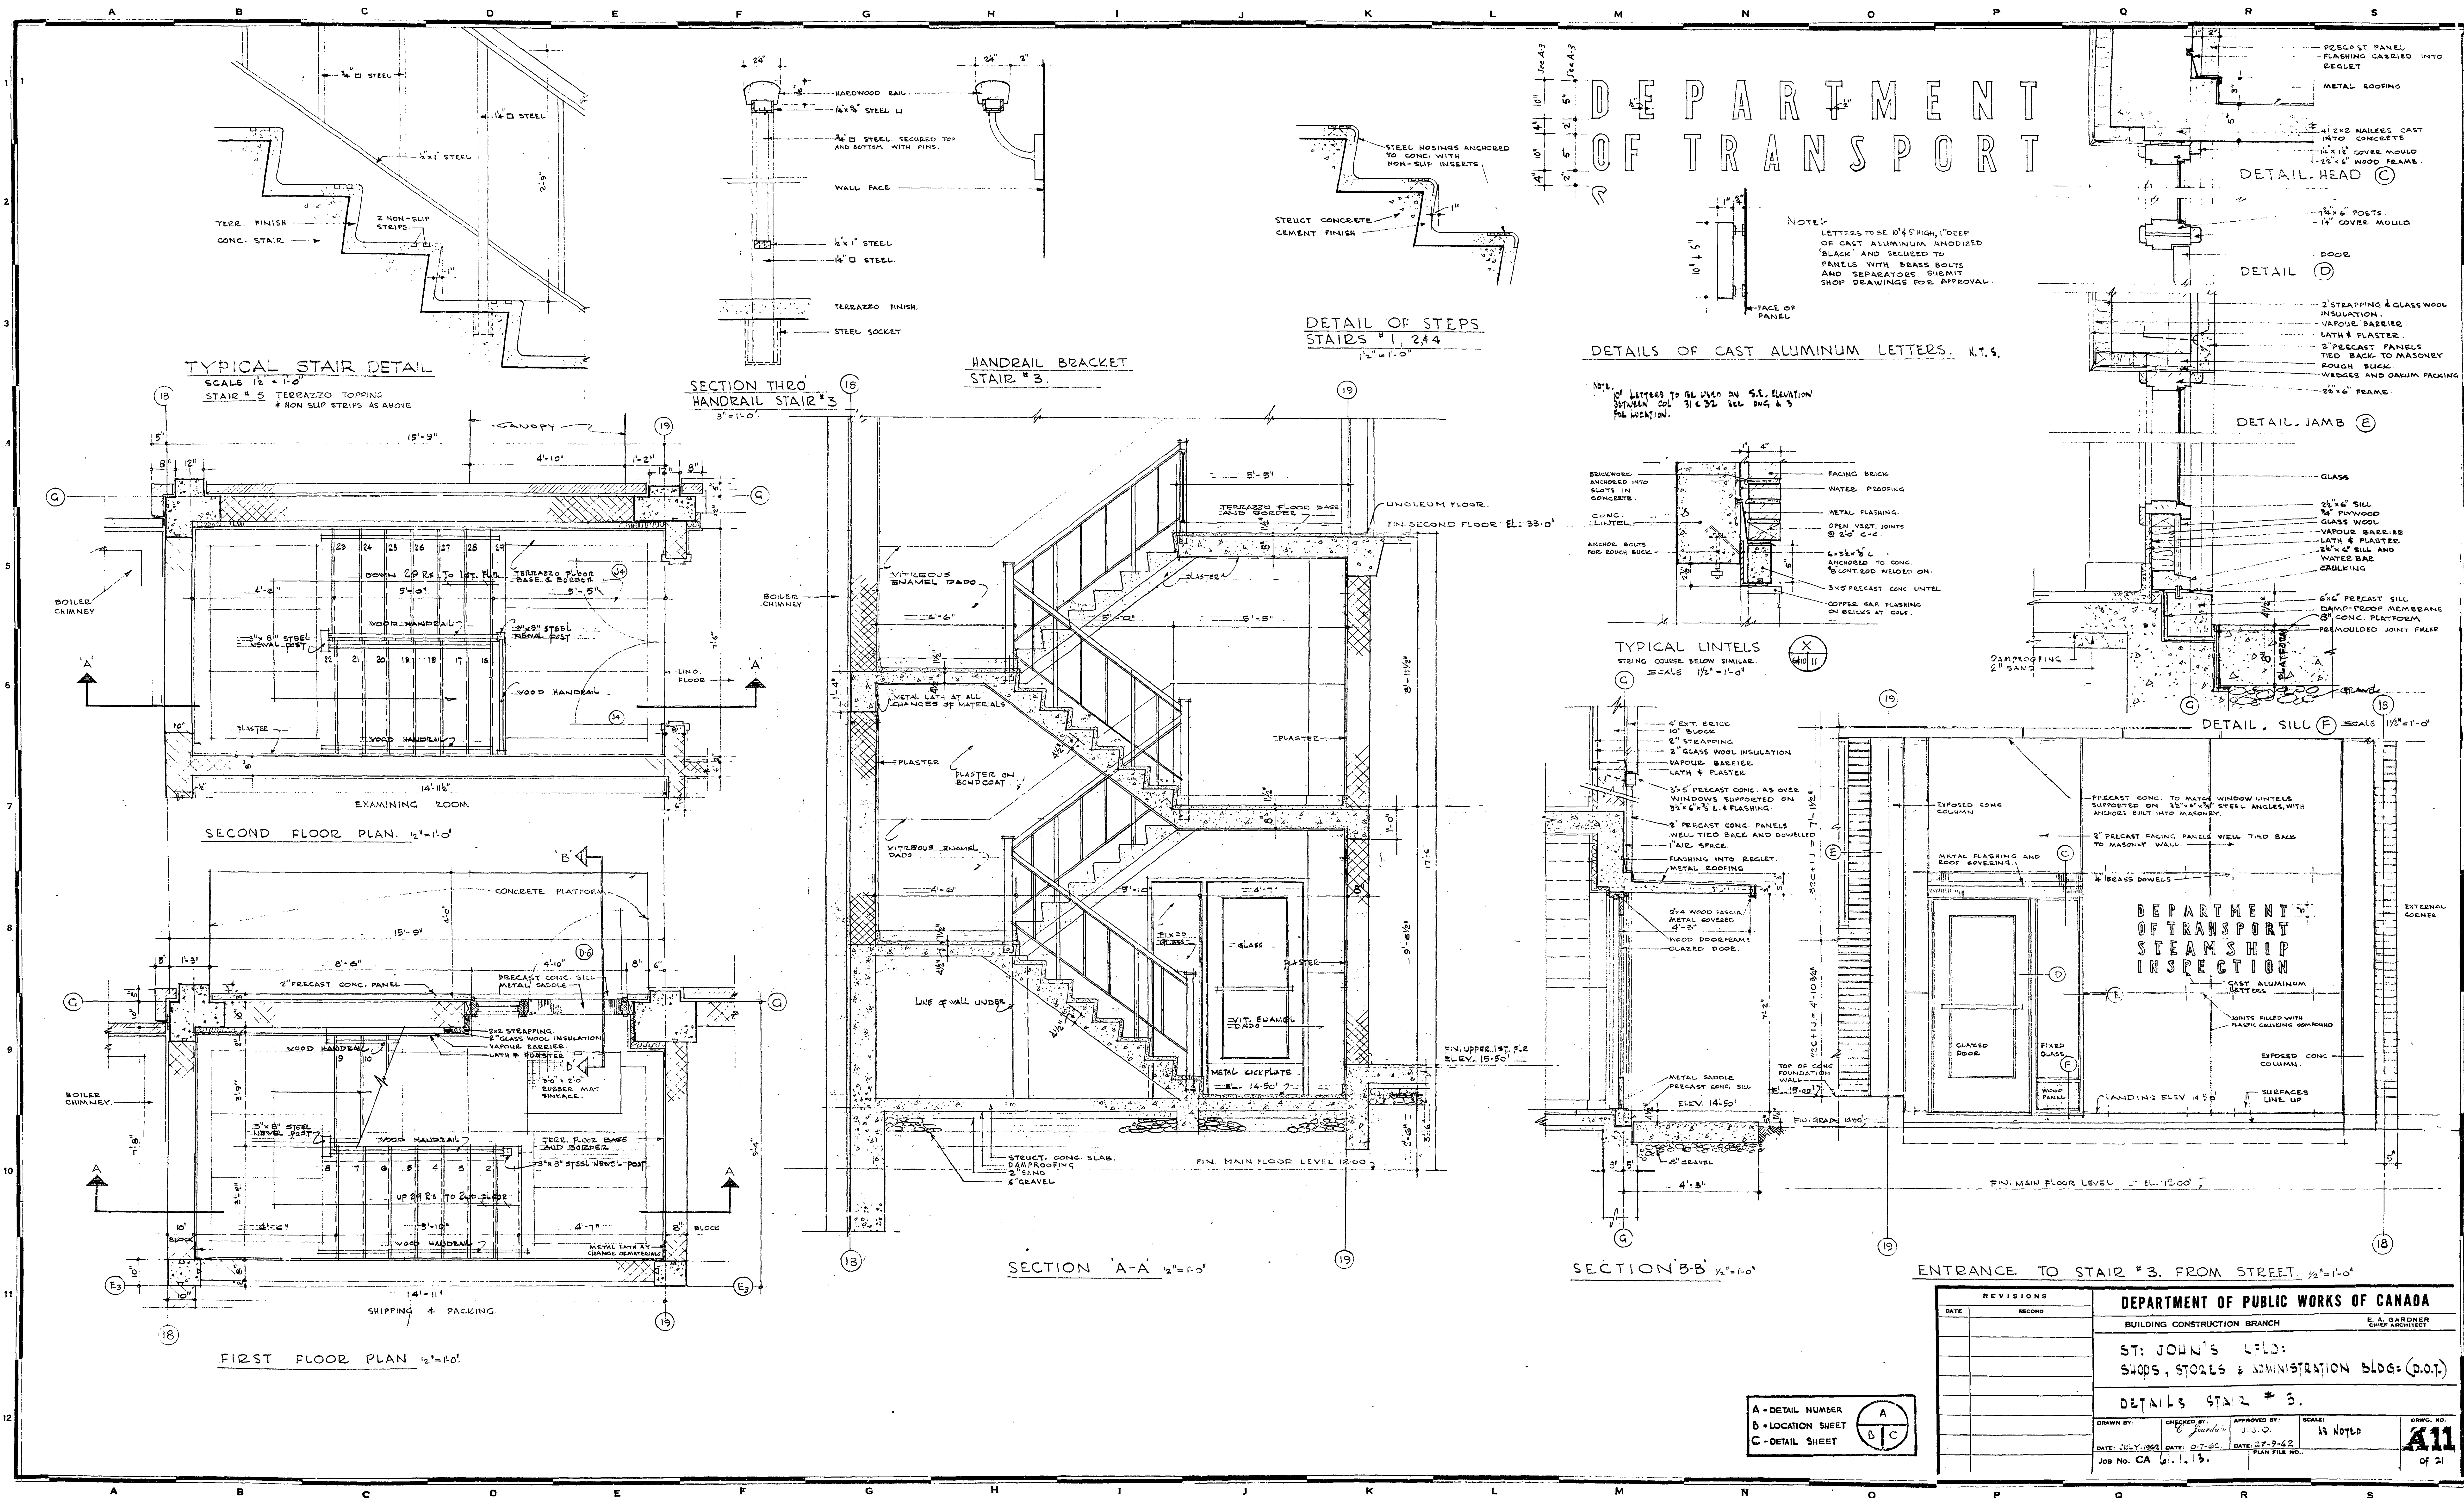


REVISIONS		DEPARTMENT OF PUBLIC WORKS OF CANADA	
DATE	RECORD	BUILDING CONSTRUCTION BRANCH	E.A. GARDNER CHIEF ARCHITECT
		ST. JOHN'S OFFICE	
		STAIRS, STAIRS & ADMINISTRATION BLDG. (P.O.T.)	
		DETAILS STAIR #3.	
DRAWN BY	C. Gardner	CHECKED BY	J. J. O.
DATE: JULY 1962	DATE: 07-62	APPROVED BY	DATE: 07-62
JOB NO. CA 61.1.13.	PLAN FILE NO.	SCALE: AS NOTED	DWG. NO. A11


A - DETAIL NUMBER
B - LOCATION SHEET
C - DETAIL SHEET

A
B
C


CA-61-1-13/13 MICROFILMED.

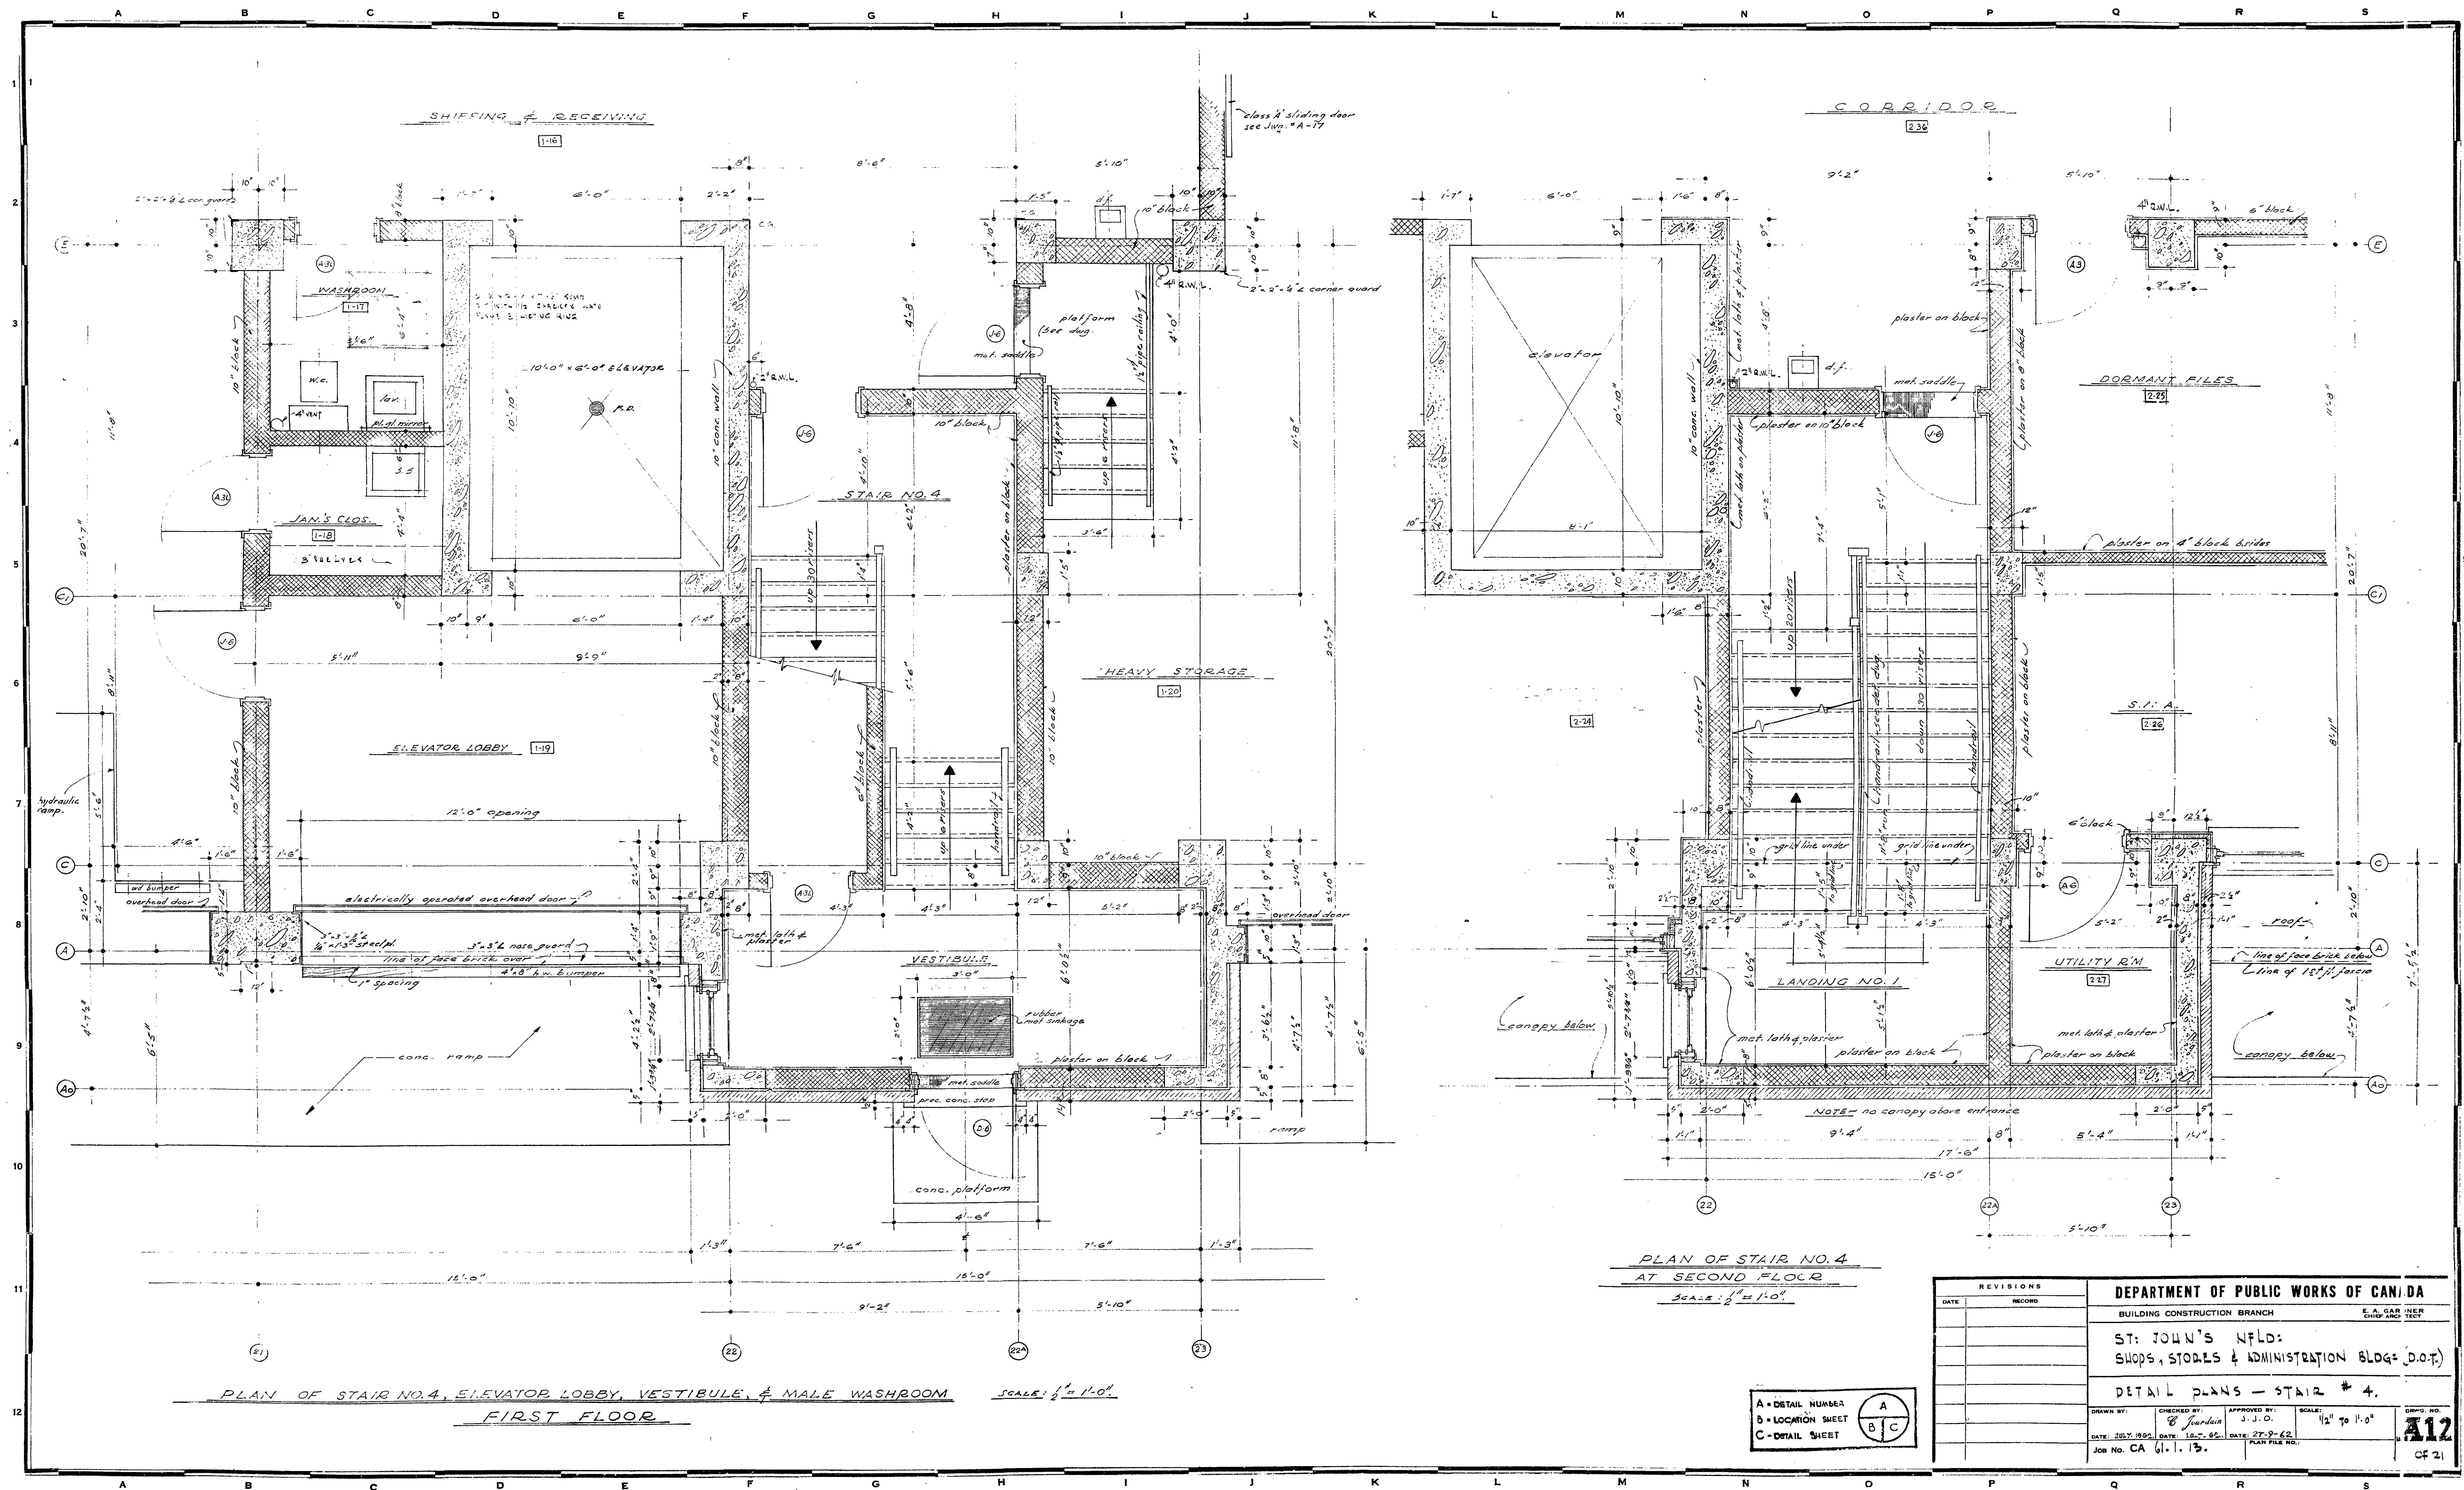


9-CA-61-1-13/14 MICROFILMED

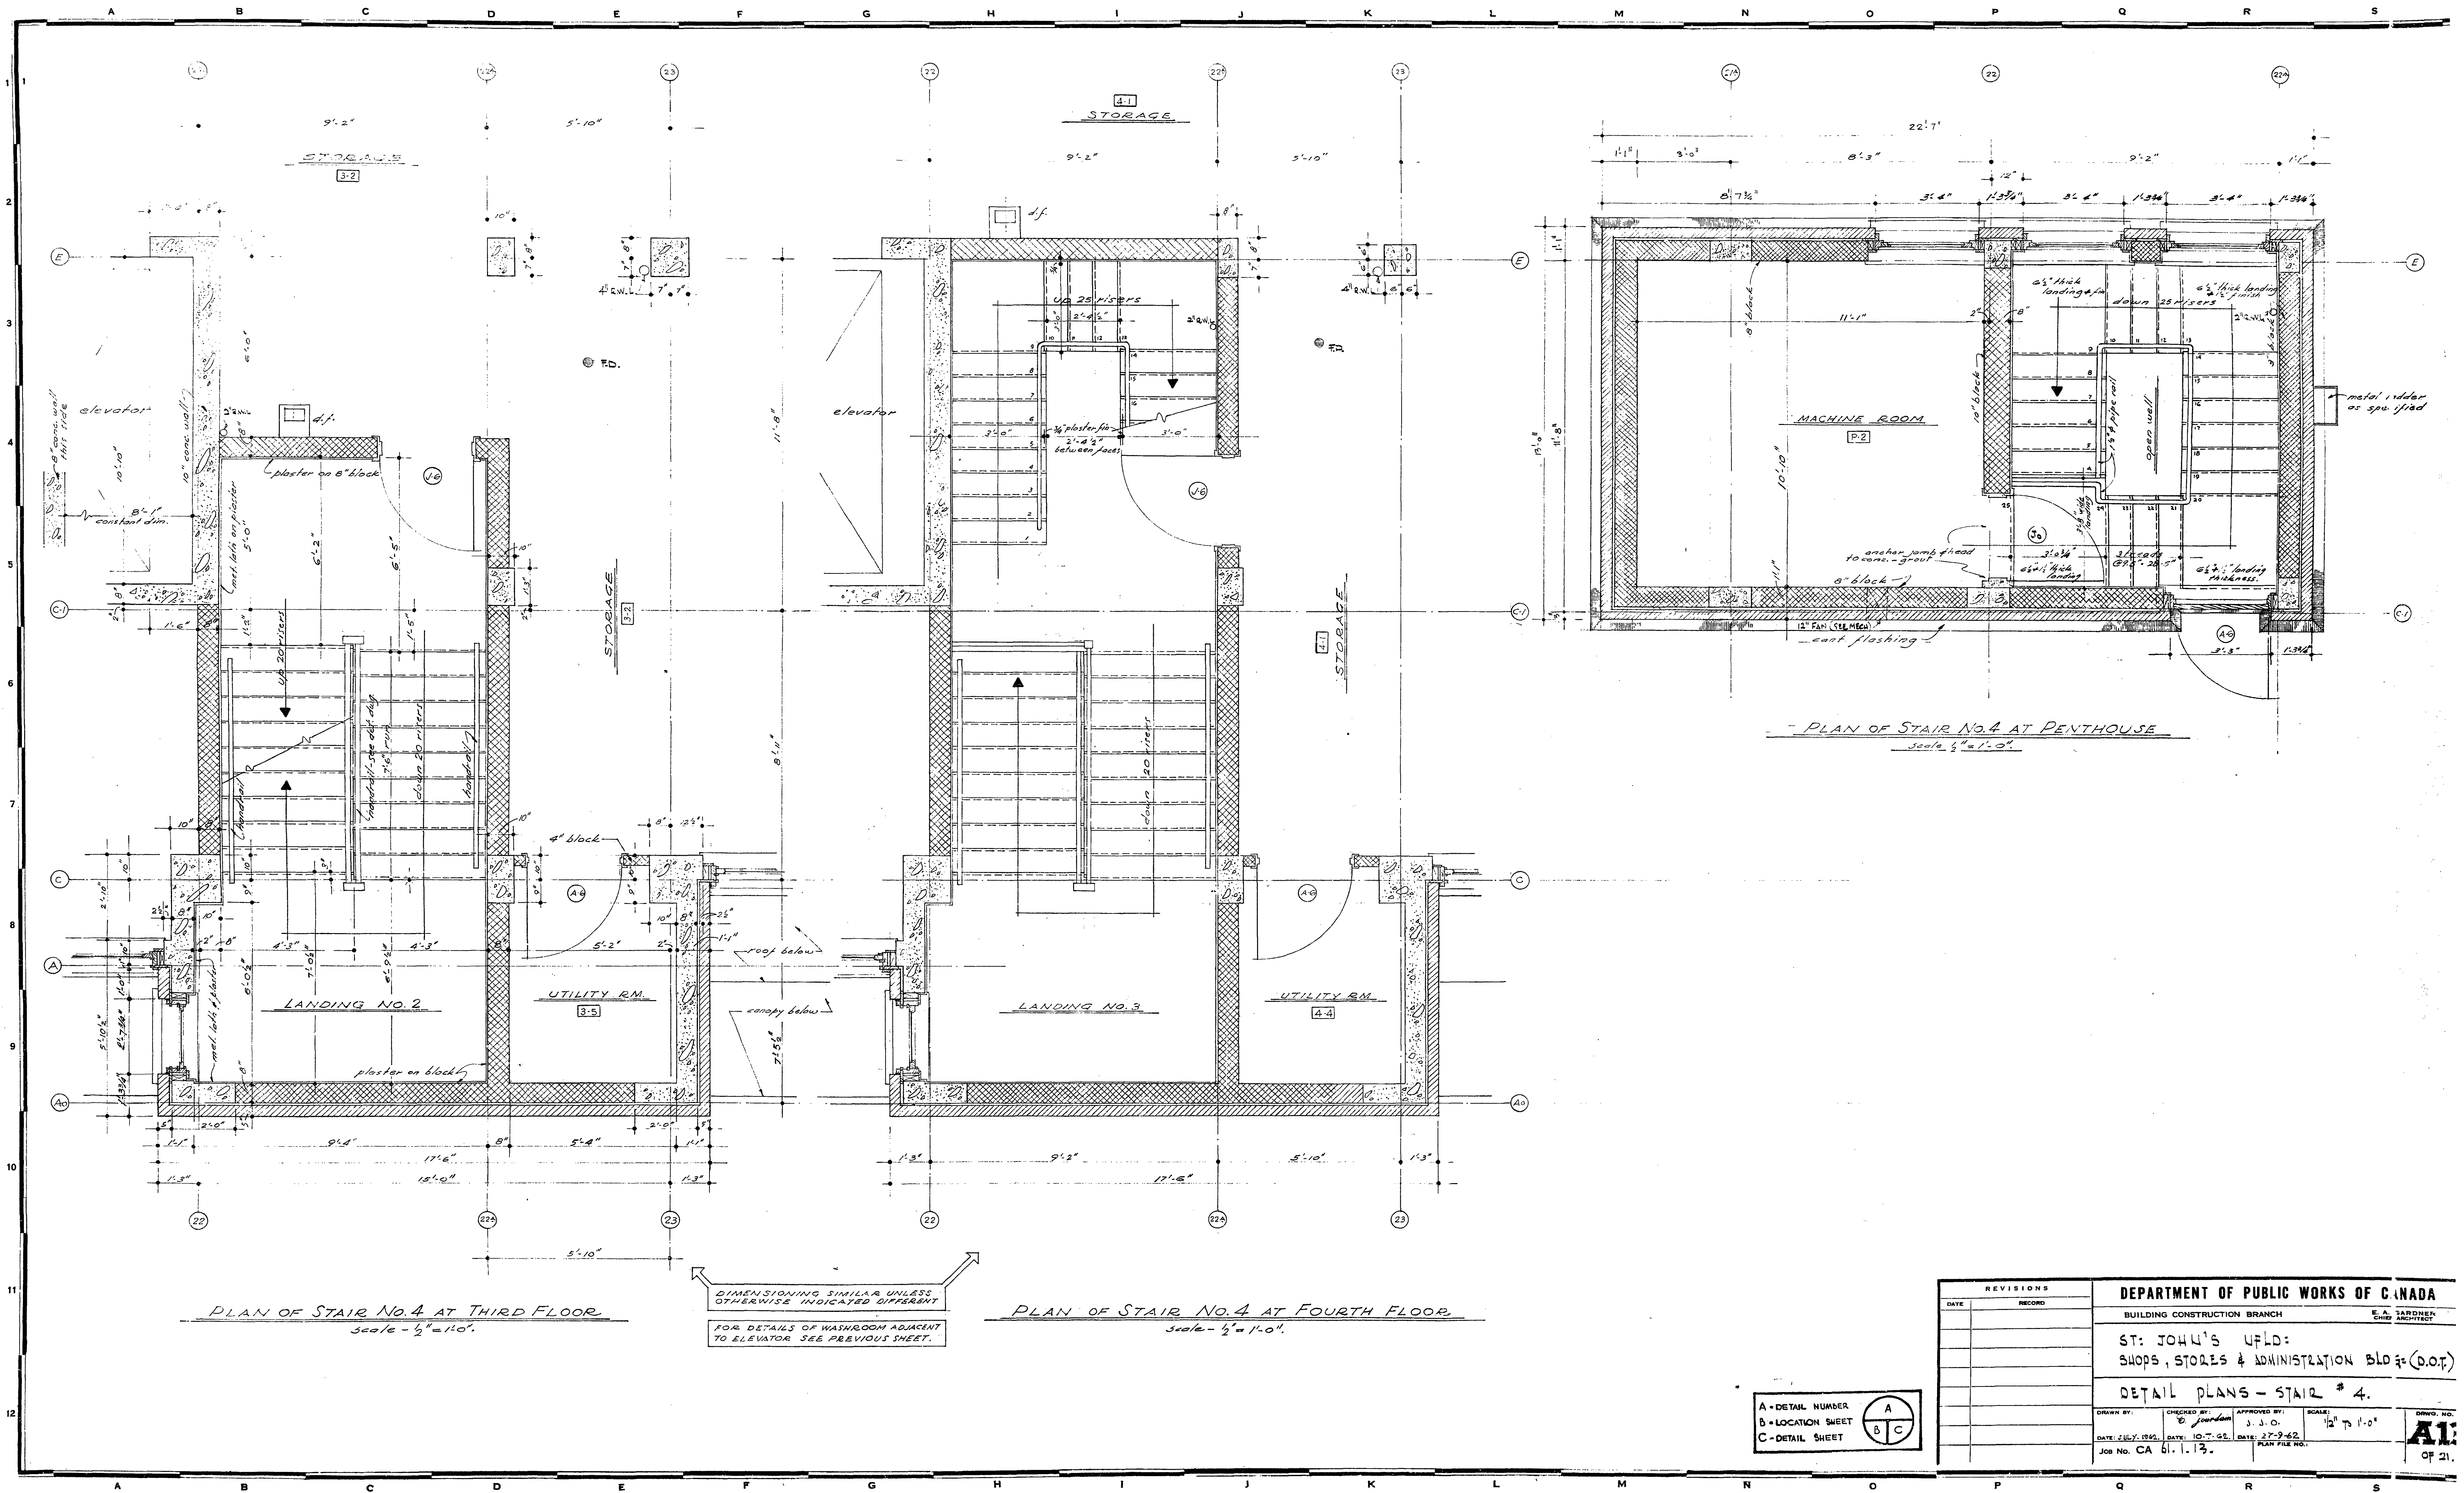

REVISIONS		DEPARTMENT OF PUBLIC WORKS OF CANADA	
DATE	RECORD	BUILDING CONSTRUCTION BRANCH	E. A. JARDNER, CHIEF ARCHITECT
		ST. JOHN'S UFLD: SHOPS, STORES & ADMINISTRATION BLDG. (D.O.F.)	
		DETAIL PLANS - STAIR # 4.	
DRAWN BY:	C. J. O.	CHECKED BY:	J. J. O.
DATE: JULY, 1955.	DATE: 10-7-55.	APPROVED BY:	DATE: 12-9-55.
JOB NO. CA 61.1.13.	PLAN FILE NO.		

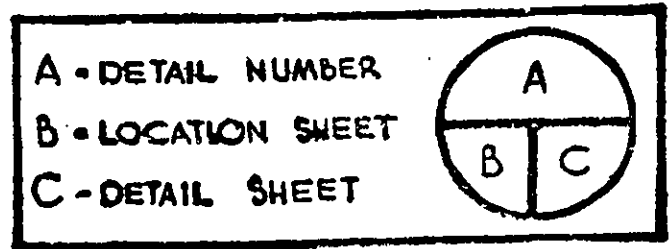

11
OF 21

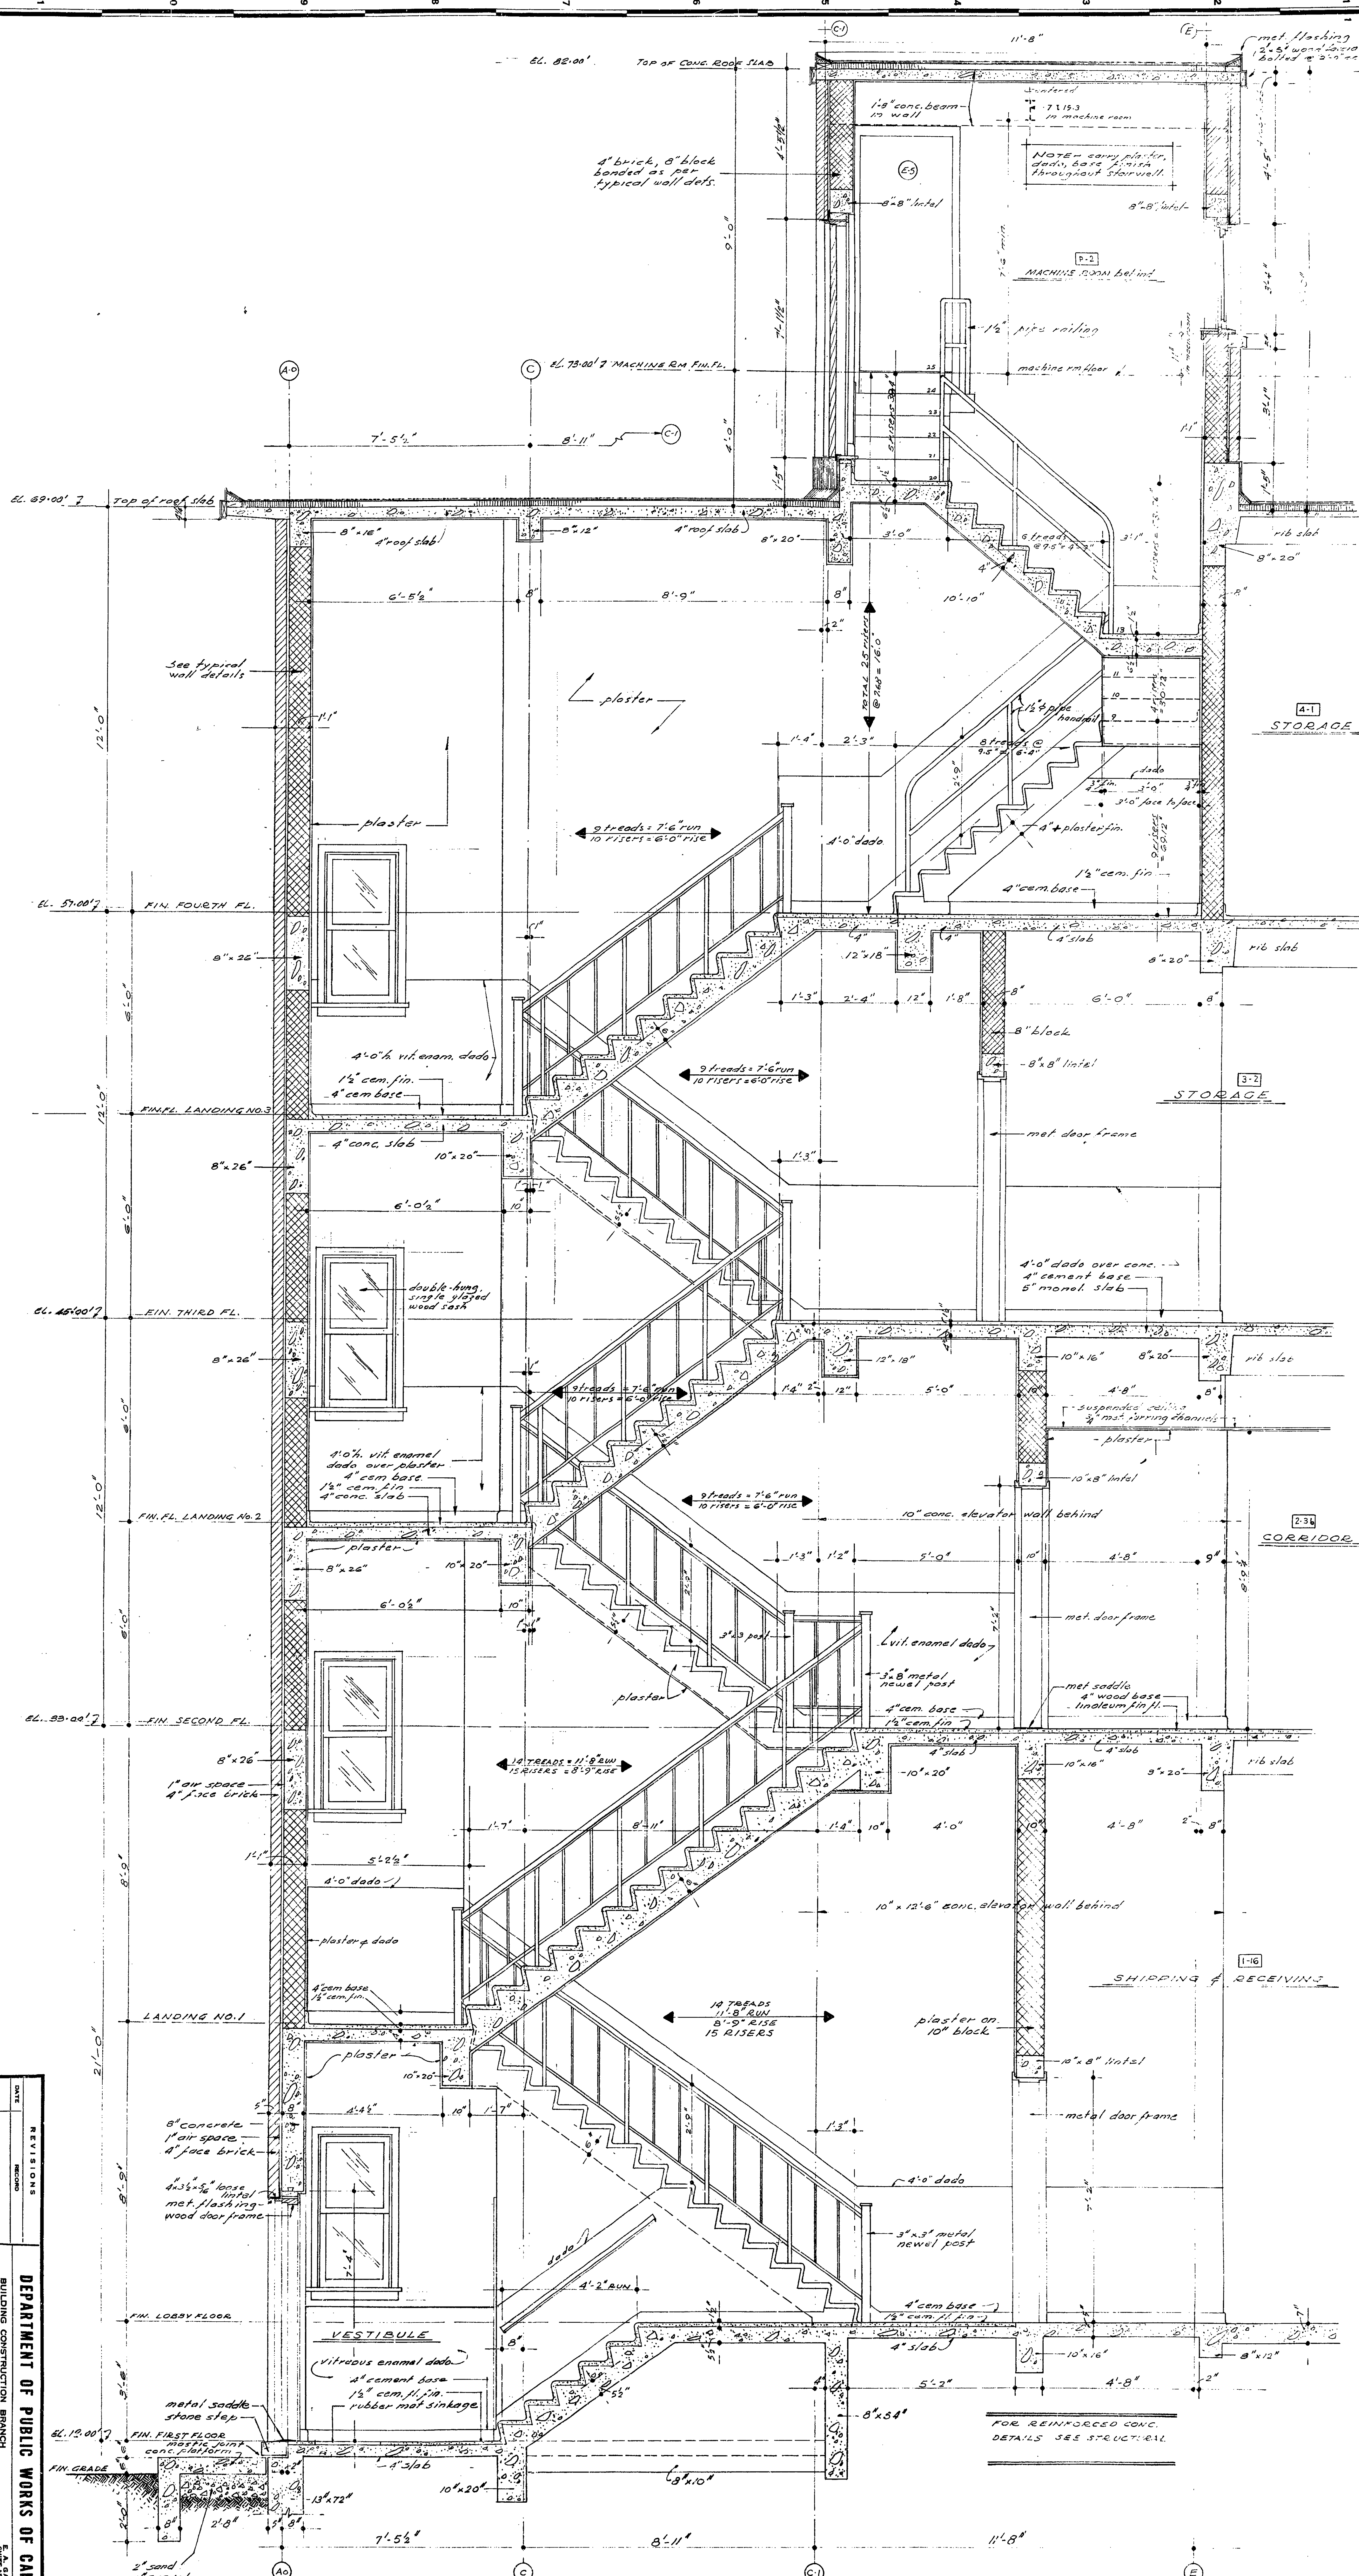

SECTION THRU STAIR NO. 4

SCALE: 2" = 1'-0"

<div>REVISIONS</div> <div>DATE</div> <div>RECORD</div>		<div>DEPARTMENT OF PUBLIC WORKS OF CANADA</div> <div>BUILDING CONSTRUCTION BRANCH</div> <div>E. A. GARDNER</div>
--	--	--


ST: JOHN'S NFLD:
SHOPS, STORES & ADMINISTRATION Bldg: (DOO.)

DETAIL SECTION - STAIR # 4.


IN BY:	CHECKED BY: <i>E. Jordan</i>	APPROVED BY: J. J. O.	SCALE: 1/2" TO 1'-0"	DRAWN BY: A
--------	---------------------------------	--------------------------	-------------------------	-----------------------

NO. CA 61-1-13. /15 PLAN FILE NO.: DATE: 27-9-54

a
 r
 s

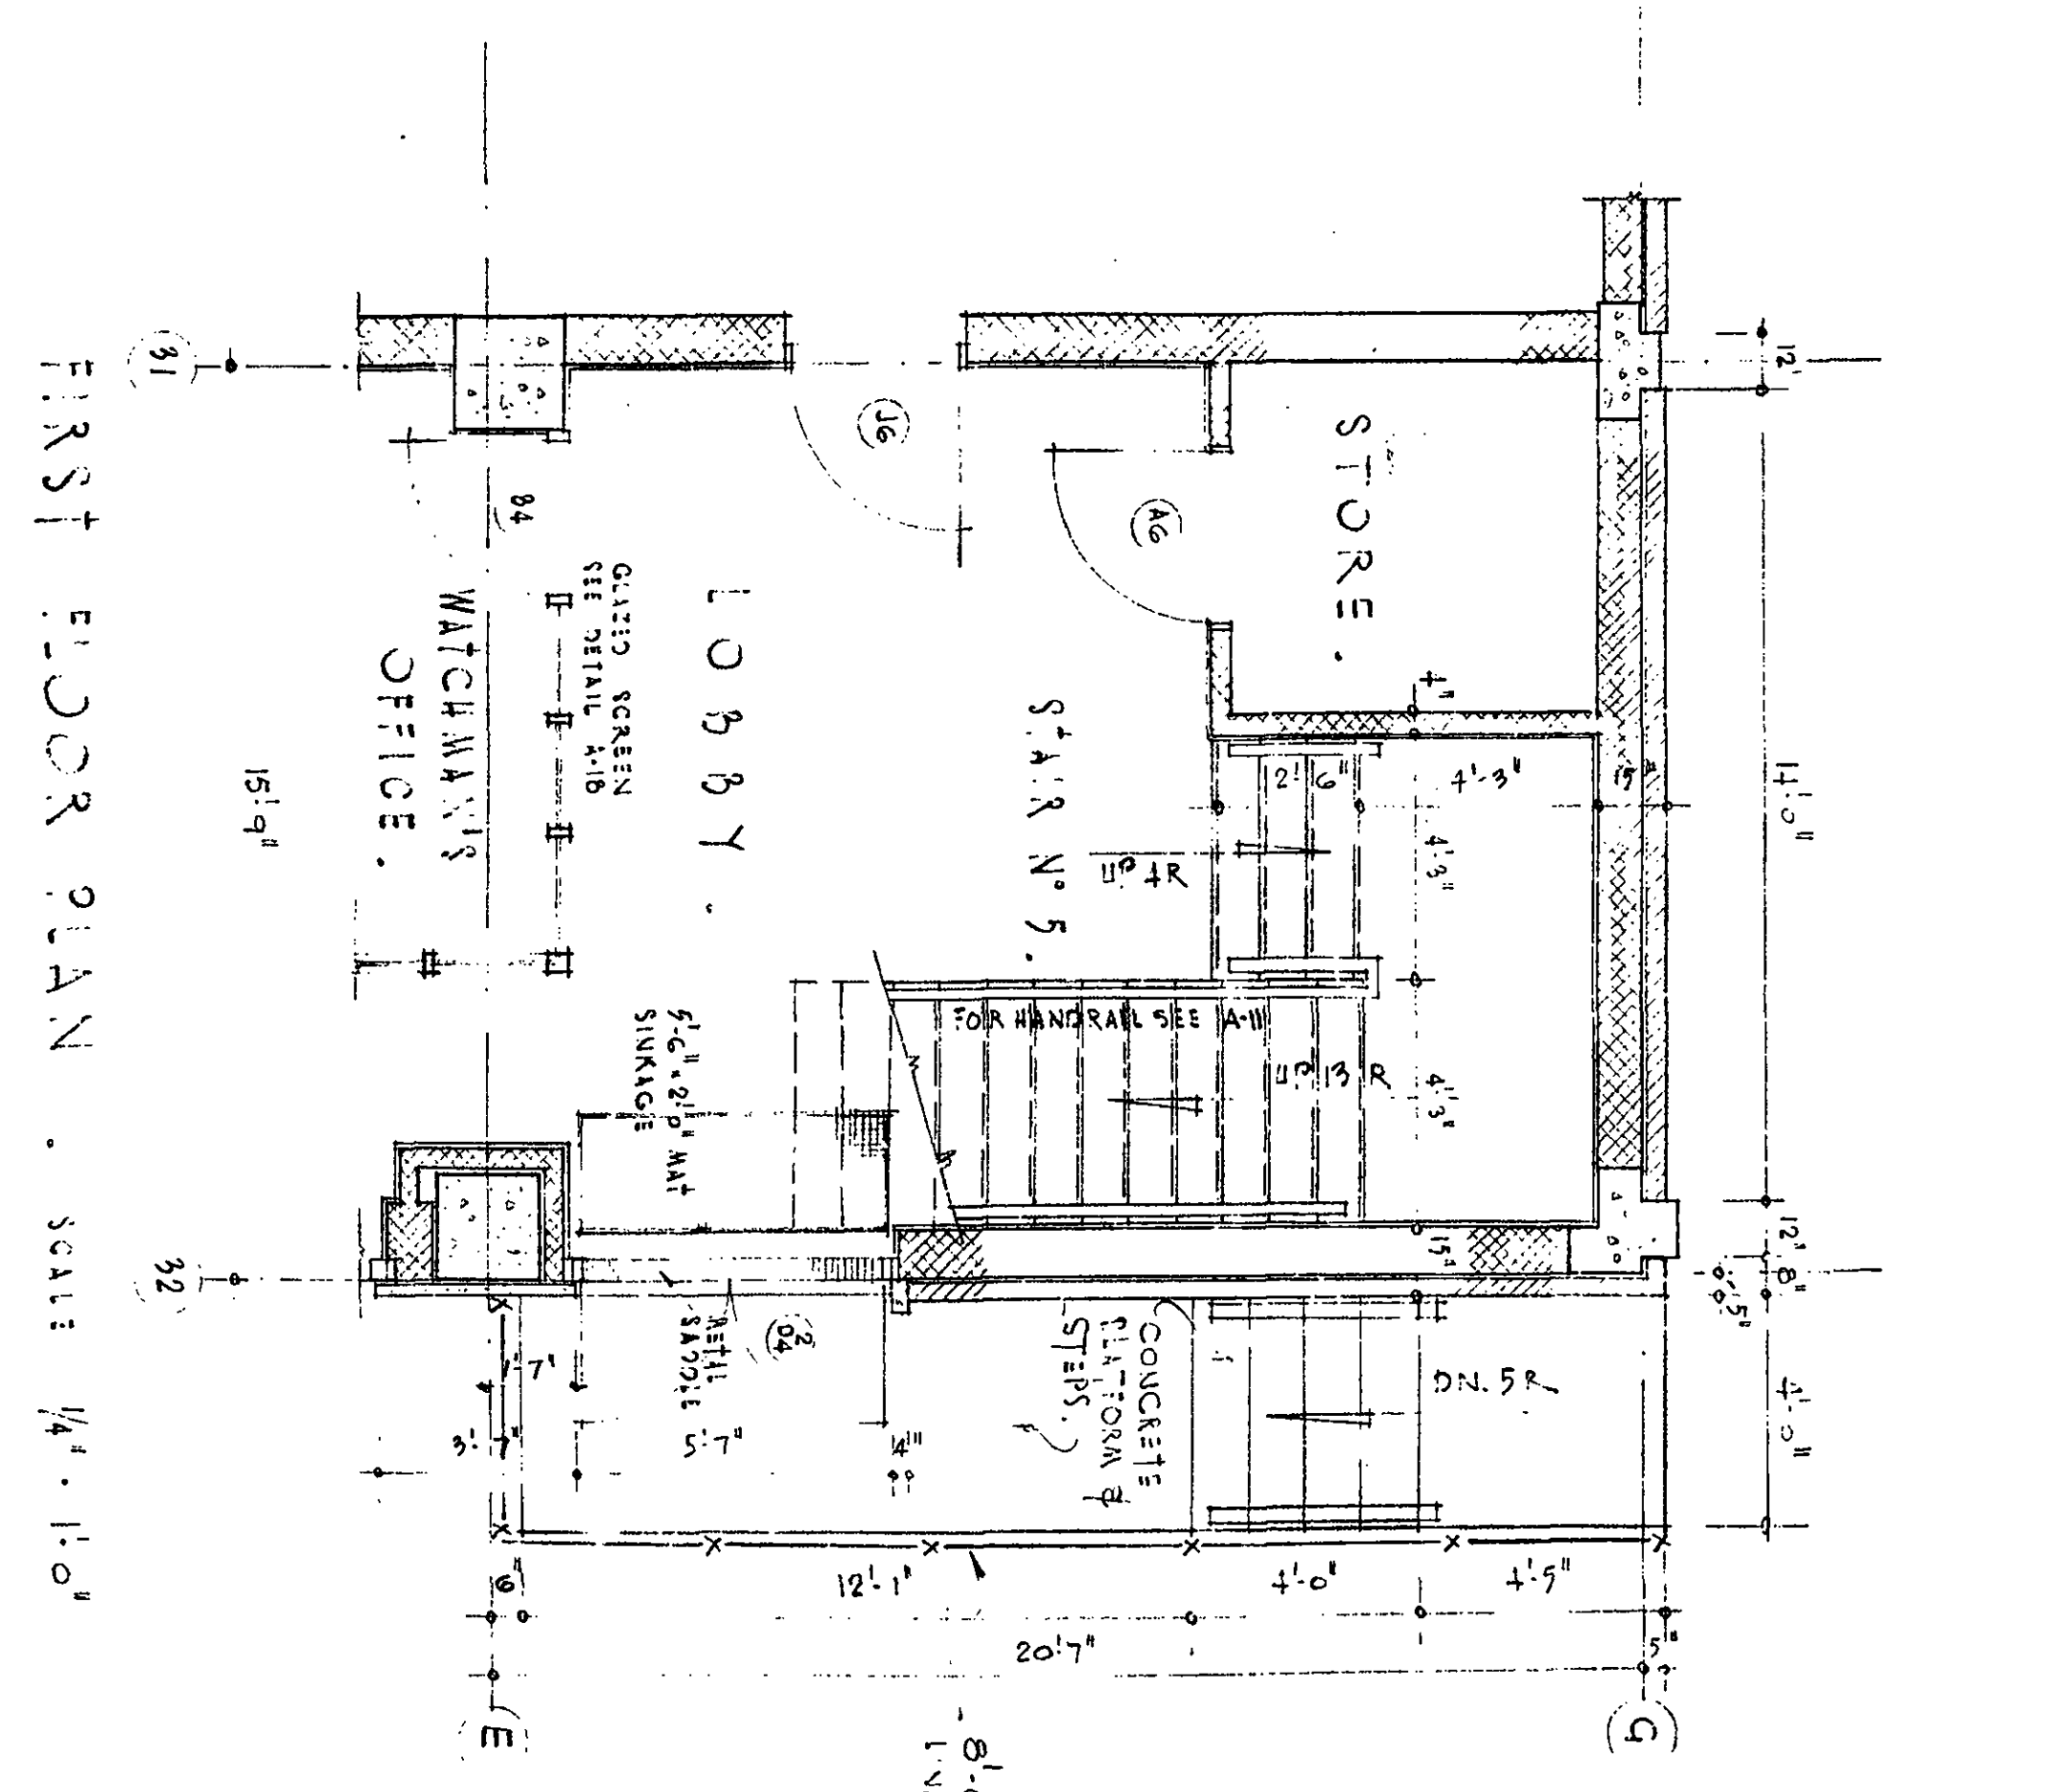


DATE	REVISIONS	RECORD							
DEPARTMENT OF PUBLIC WORKS OF CANADA									
BUILDING CONSTRUCTION BRANCH									
ST: 304W'S NPLD:									
SHOPS, STAGES & ADMINISTRATION BLDG: (D-01)									
DETAILS STAIR No 5.									
DESIGNED BY:	APPROVED BY:	SCALE:	DATE:	DATE:	DATE:	DATE:	DATE:	DATE:	DATE:
<i>G. J. O.</i>	<i>G. J. O.</i>	<i>1/4" = 1'-0"</i>	<i>2-7-58</i>	<i>2-7-58</i>	<i>2-7-58</i>	<i>2-7-58</i>	<i>2-7-58</i>	<i>2-7-58</i>	<i>2-7-58</i>
JOHN NO. CA	JOHN NO. CA	JOHN NO. CA	JOHN NO. CA	JOHN NO. CA	JOHN NO. CA	JOHN NO. CA	JOHN NO. CA	JOHN NO. CA	JOHN NO. CA
0	21	0	21	0	21	0	21	0	21

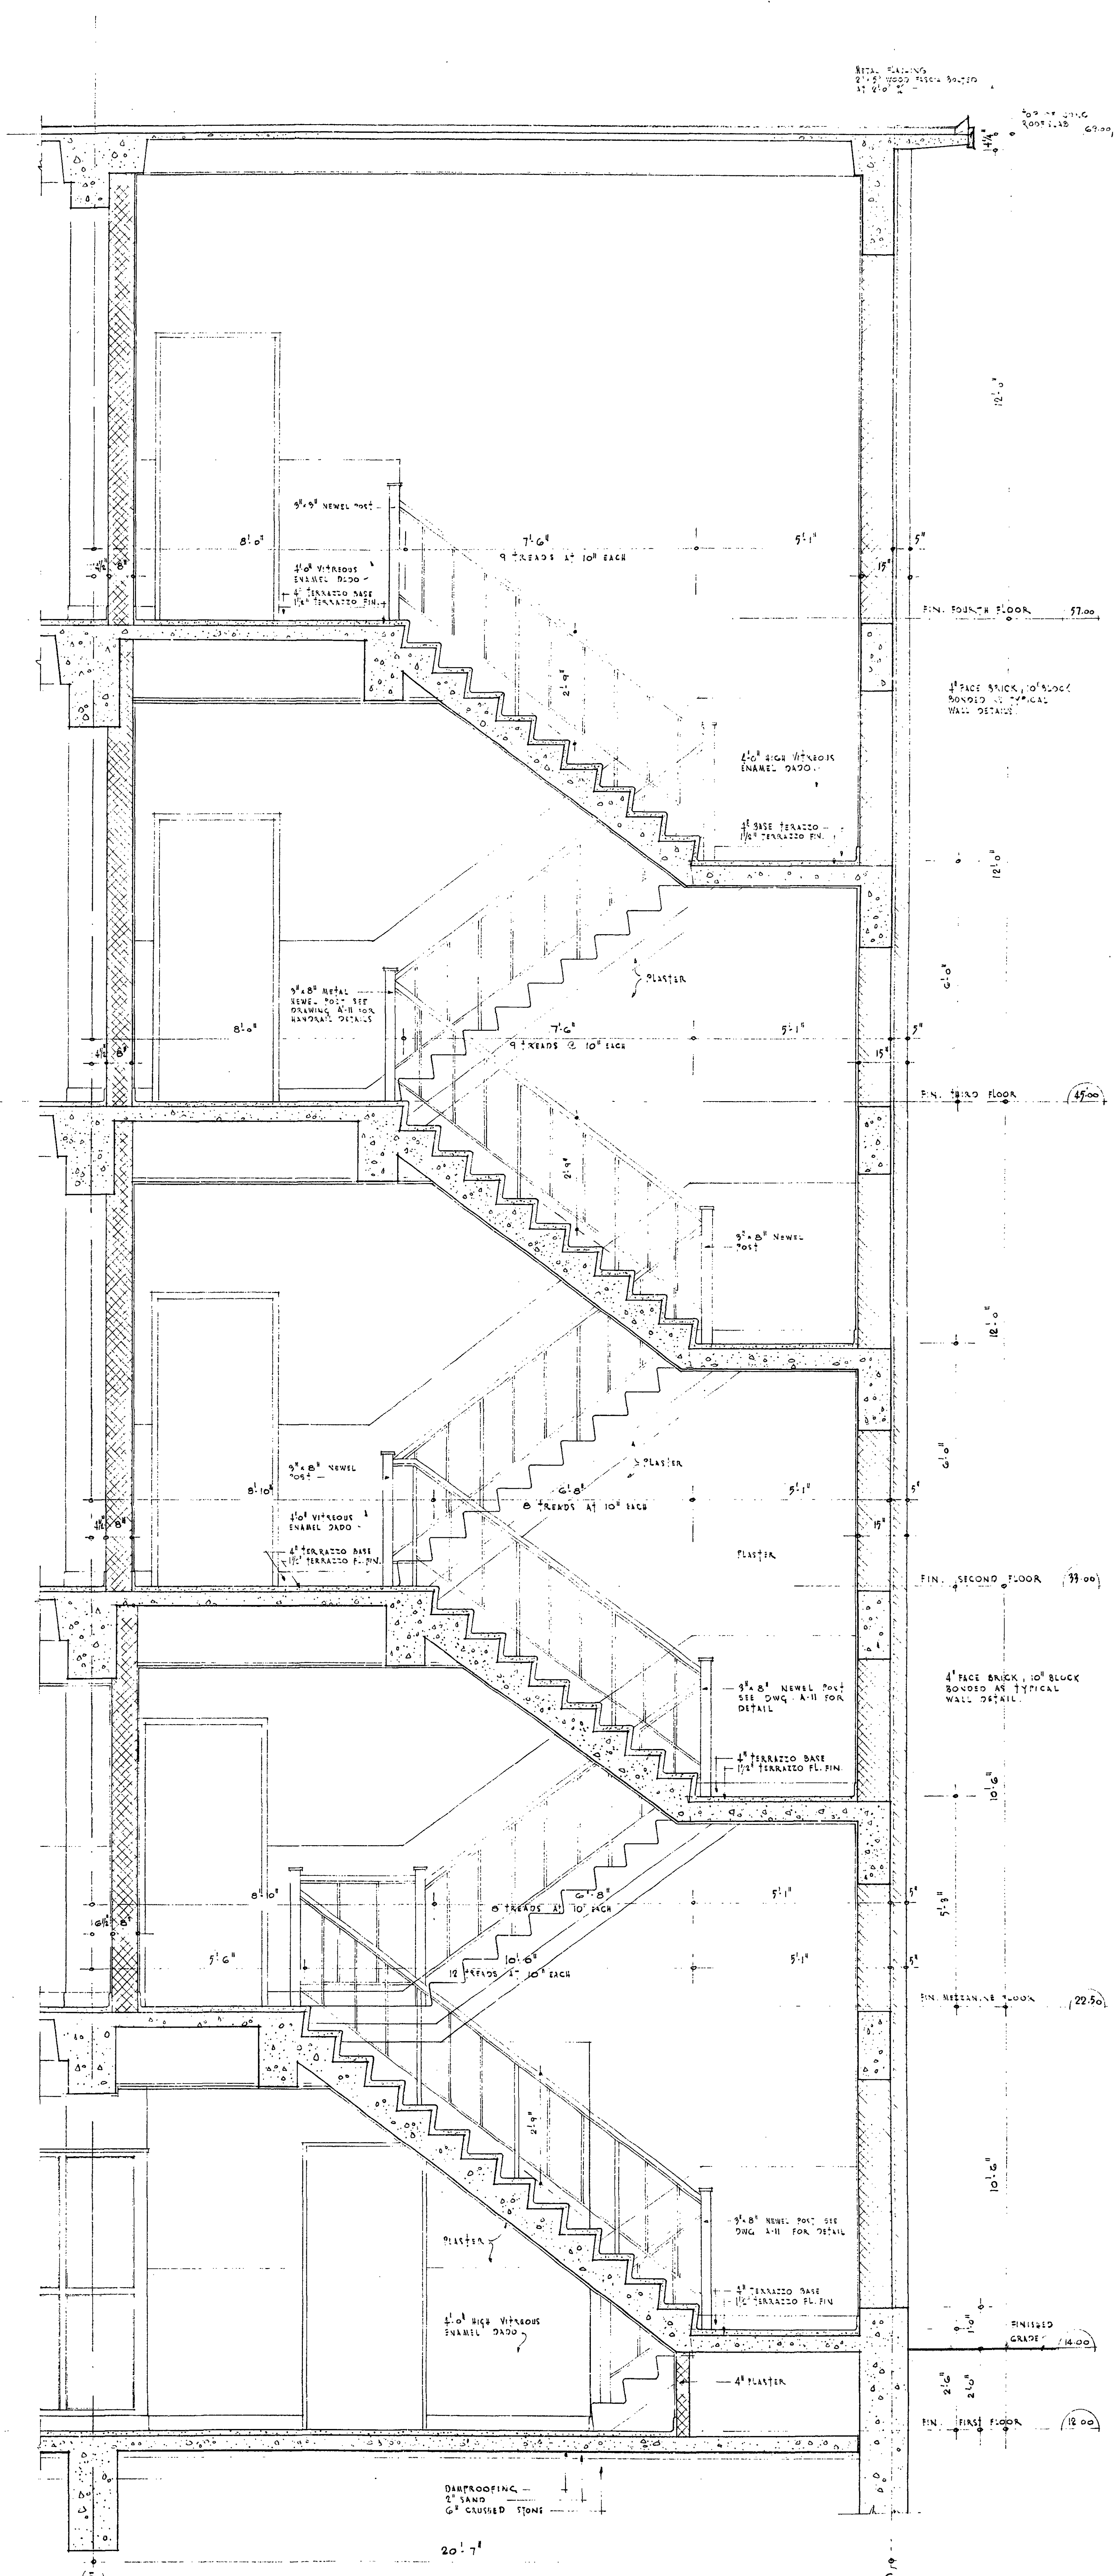


SECTION THRU STAIRWAY N° 5.

SCALE $\frac{1}{2}'' = 1.0'$.


G-CA-61-1-13/17 MICROFILMED.

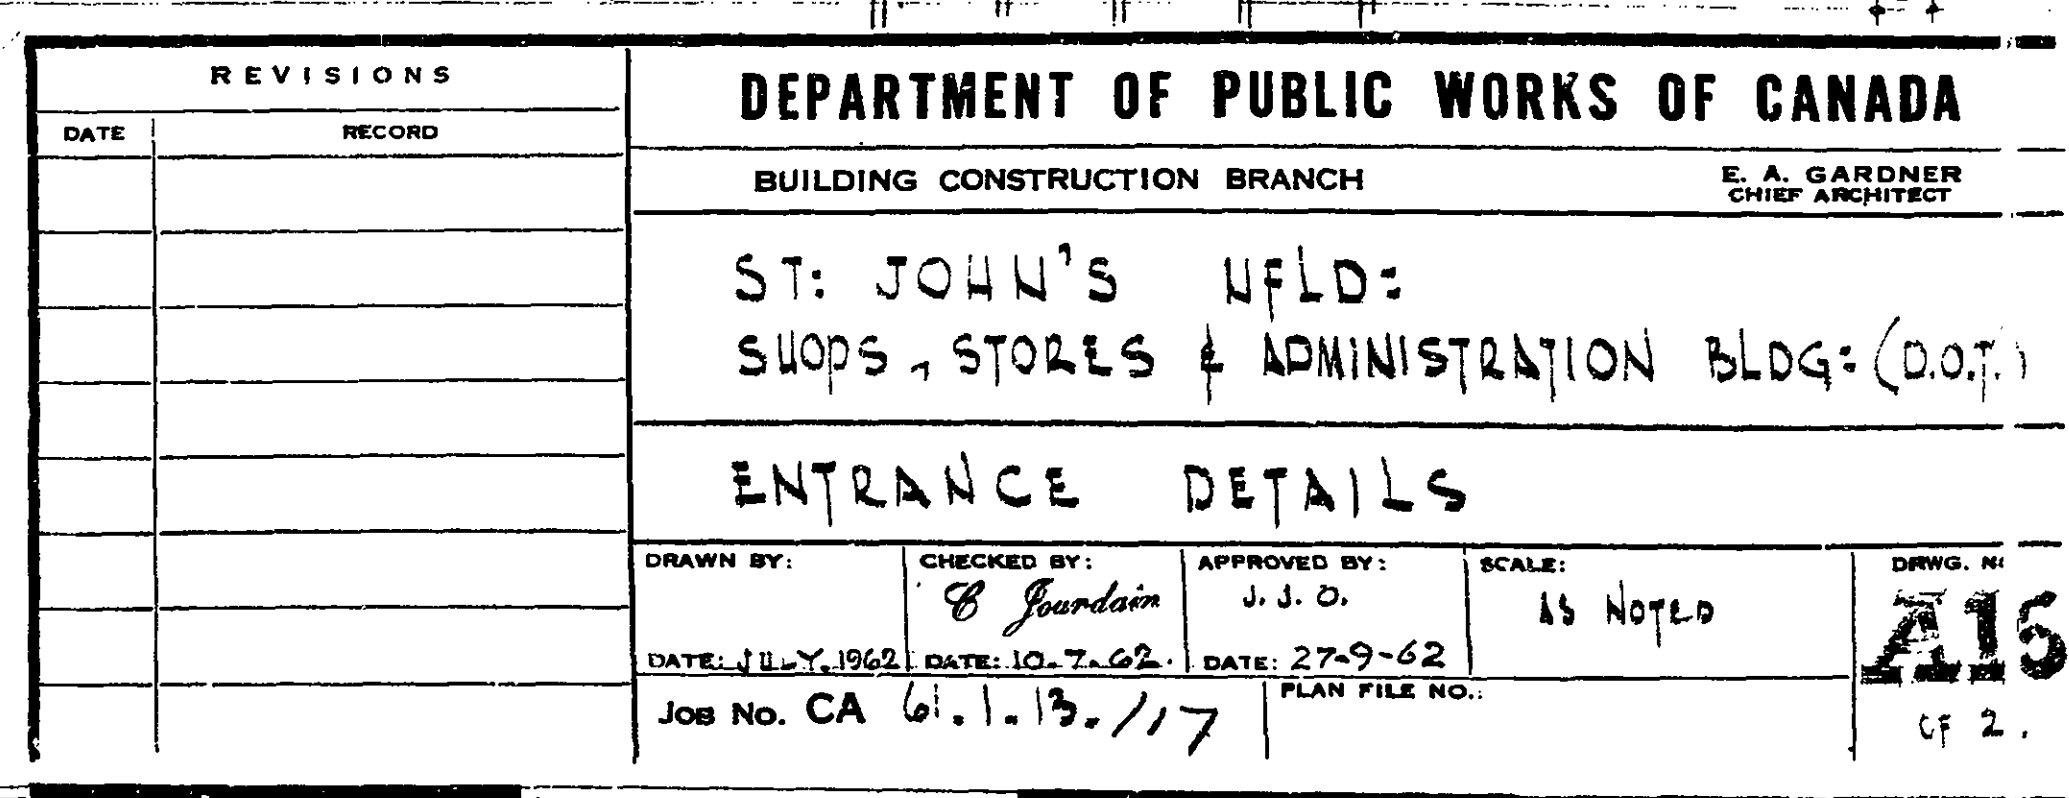

GA-61-1-13/18

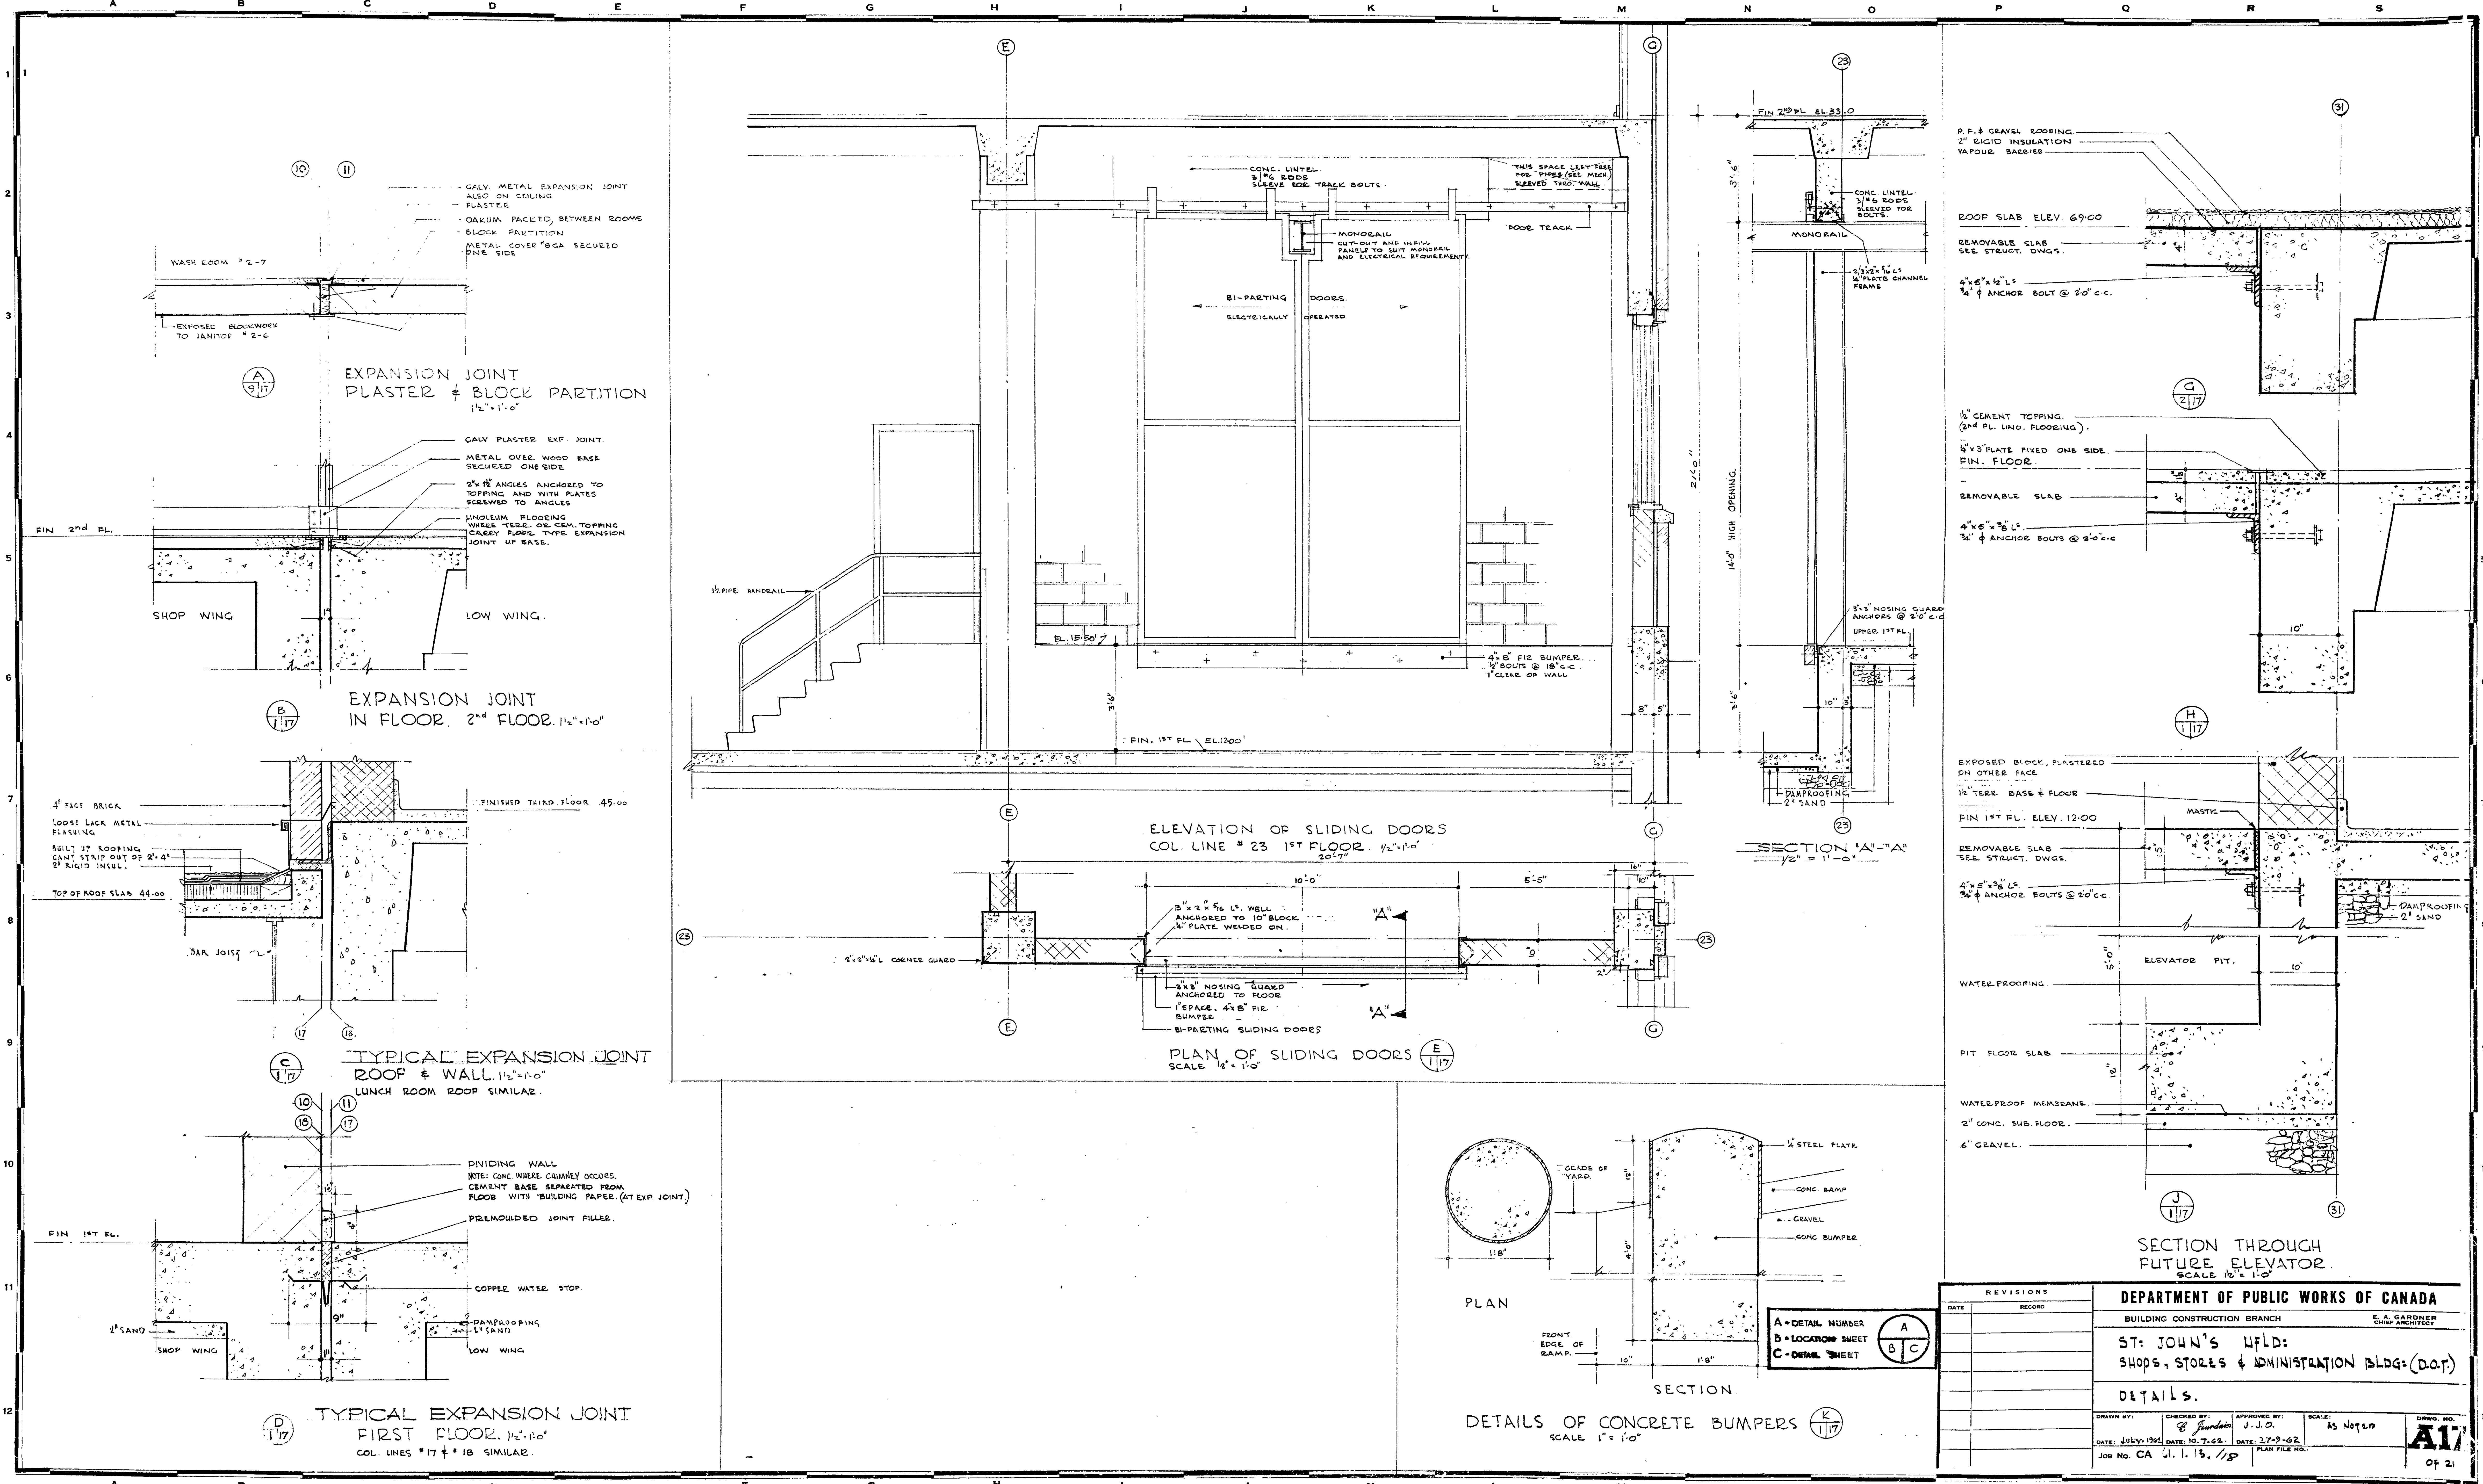


G-CA-61-1-13/19

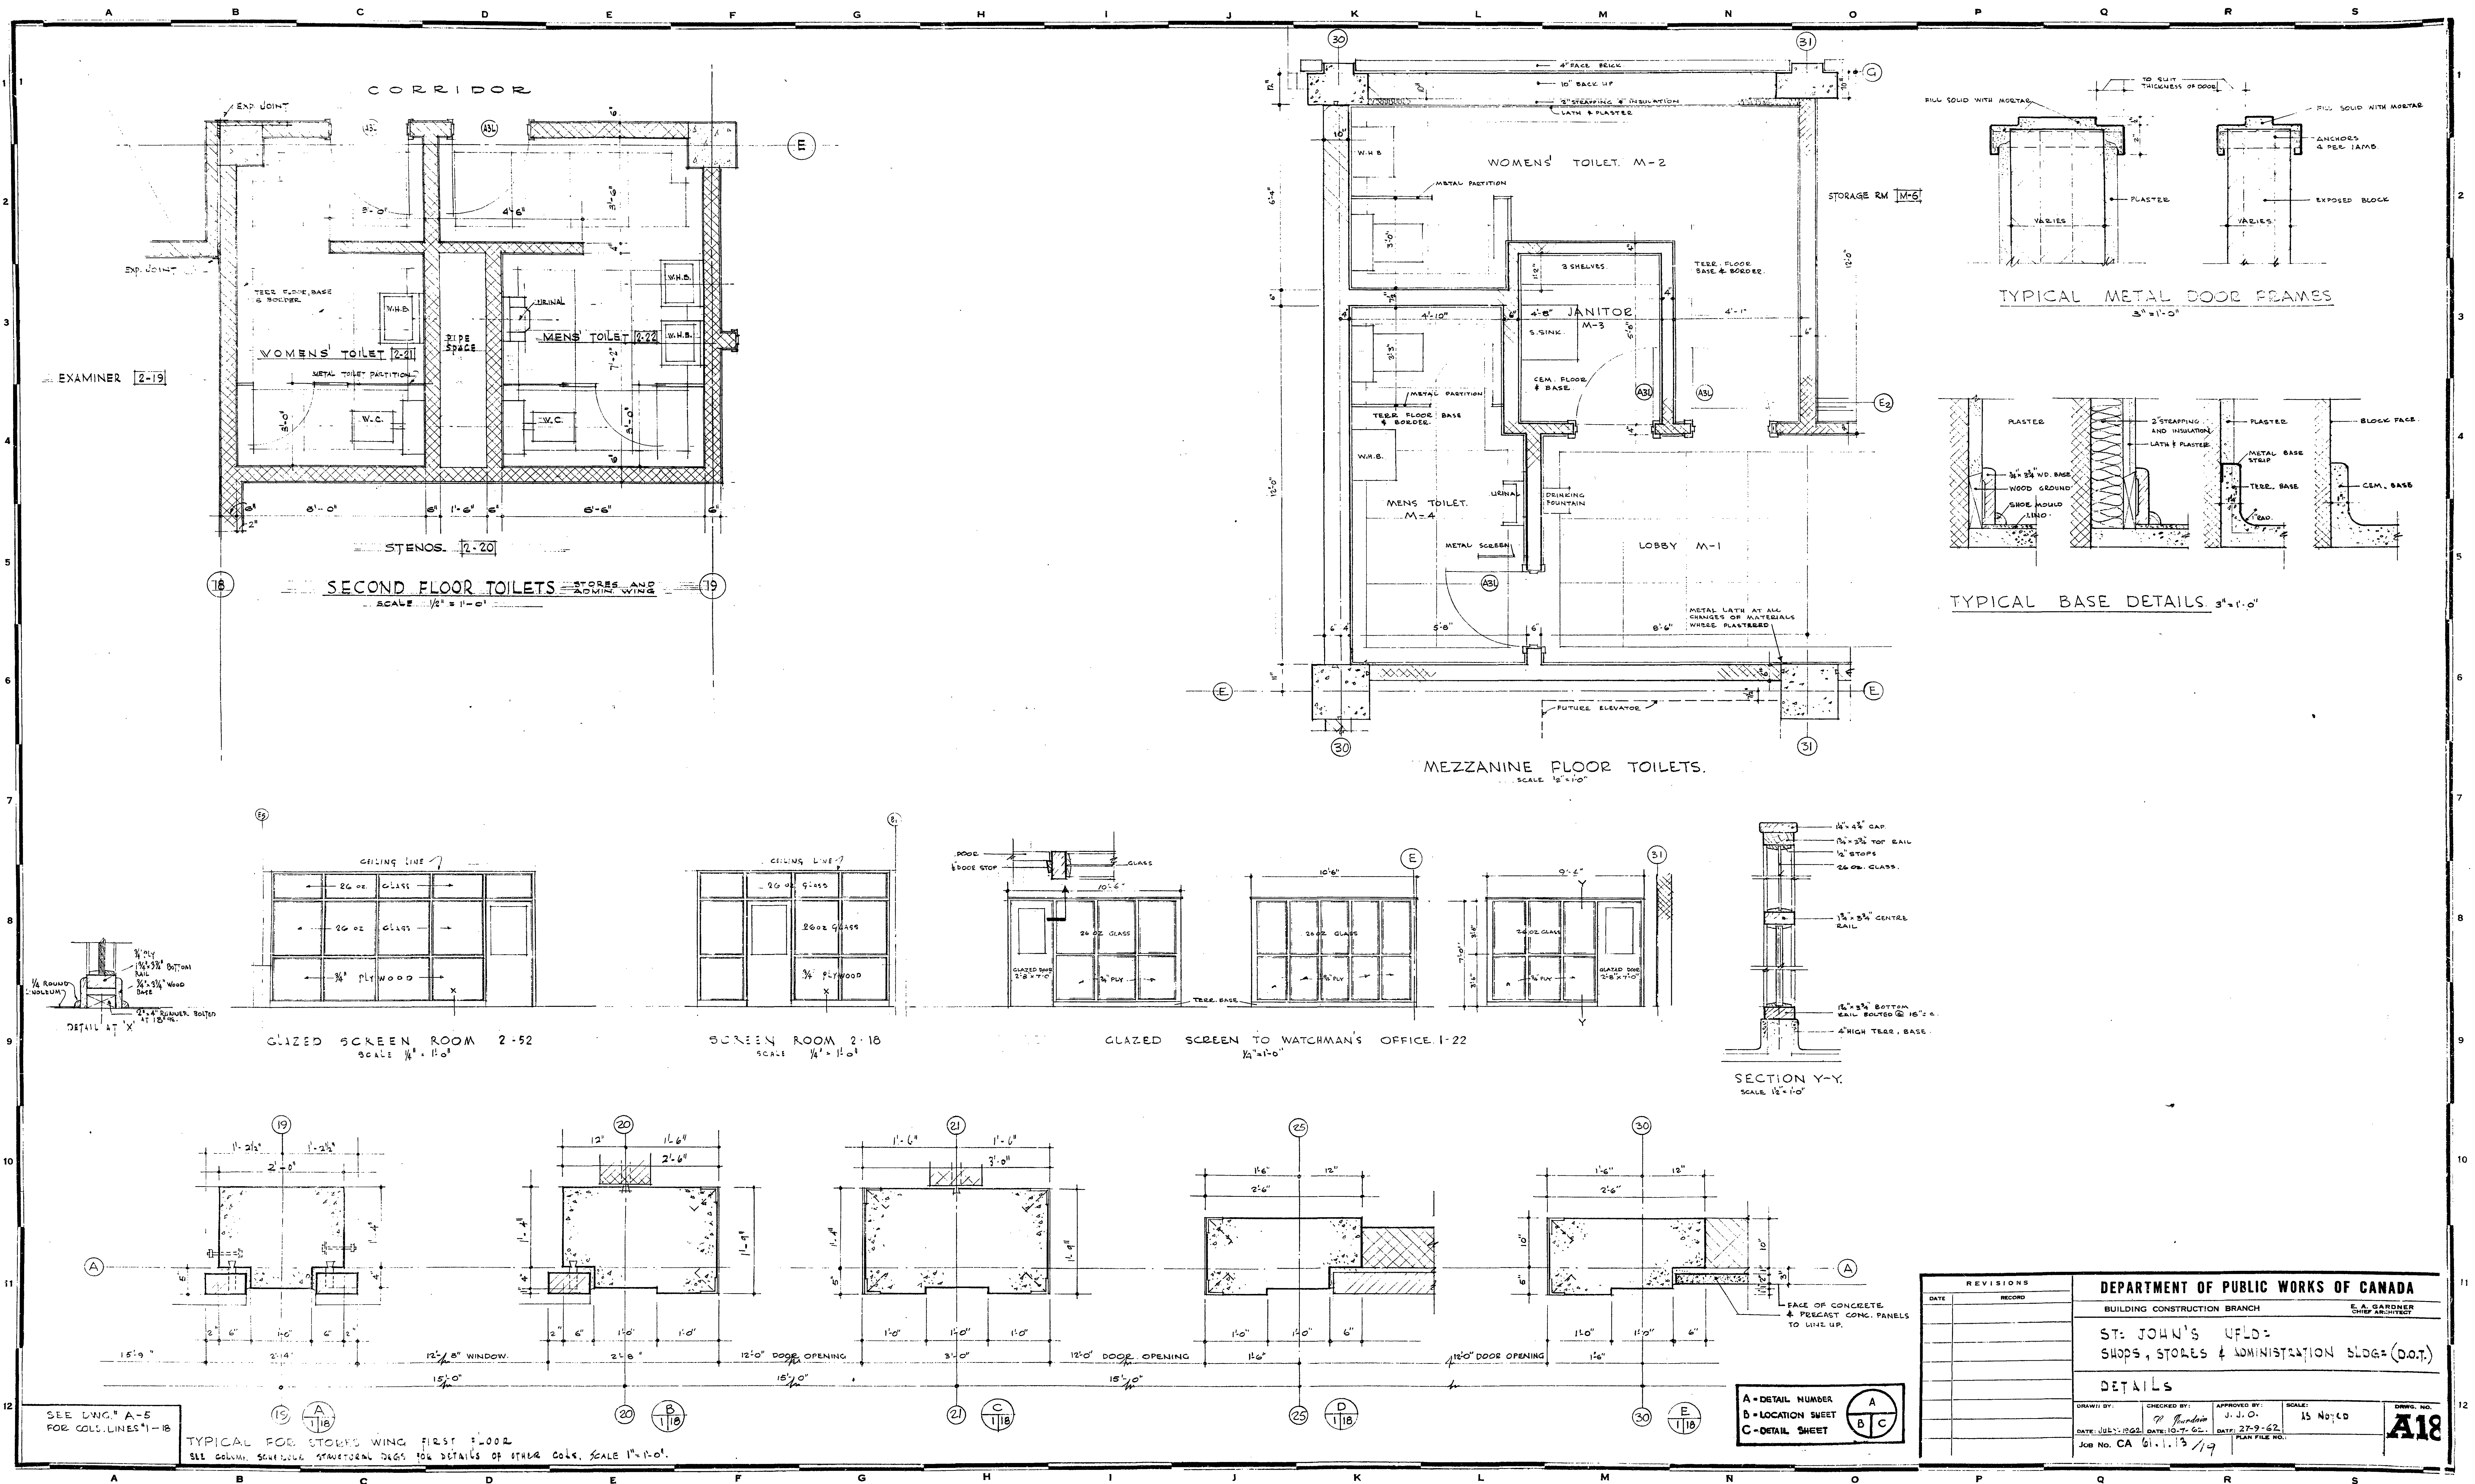

REVISIONS		DEPARTMENT OF PUBLIC WORKS OF CANADA	
DATE	RECORD	BUILDING CONSTRUCTION BRANCH	E.A. GARDNER CHIEF ARCHITECT
		ST. JOHN'S UPLOD SHOPS, STORES & ADMINISTRATION BLDG. (D.O.T.)	
		DETAILS	
DRAWN BY:	CHECKED BY:	APPROVED BY:	SCALE:
J. J. O.	J. J. O.	J. J. O.	1/8" = 1'-0"
DATE: JULY 1962	DATE: JULY 1962	DATE: JULY 1962	PLAN FILE NO.
JOB NO. CA 61.1.13/19			

A18

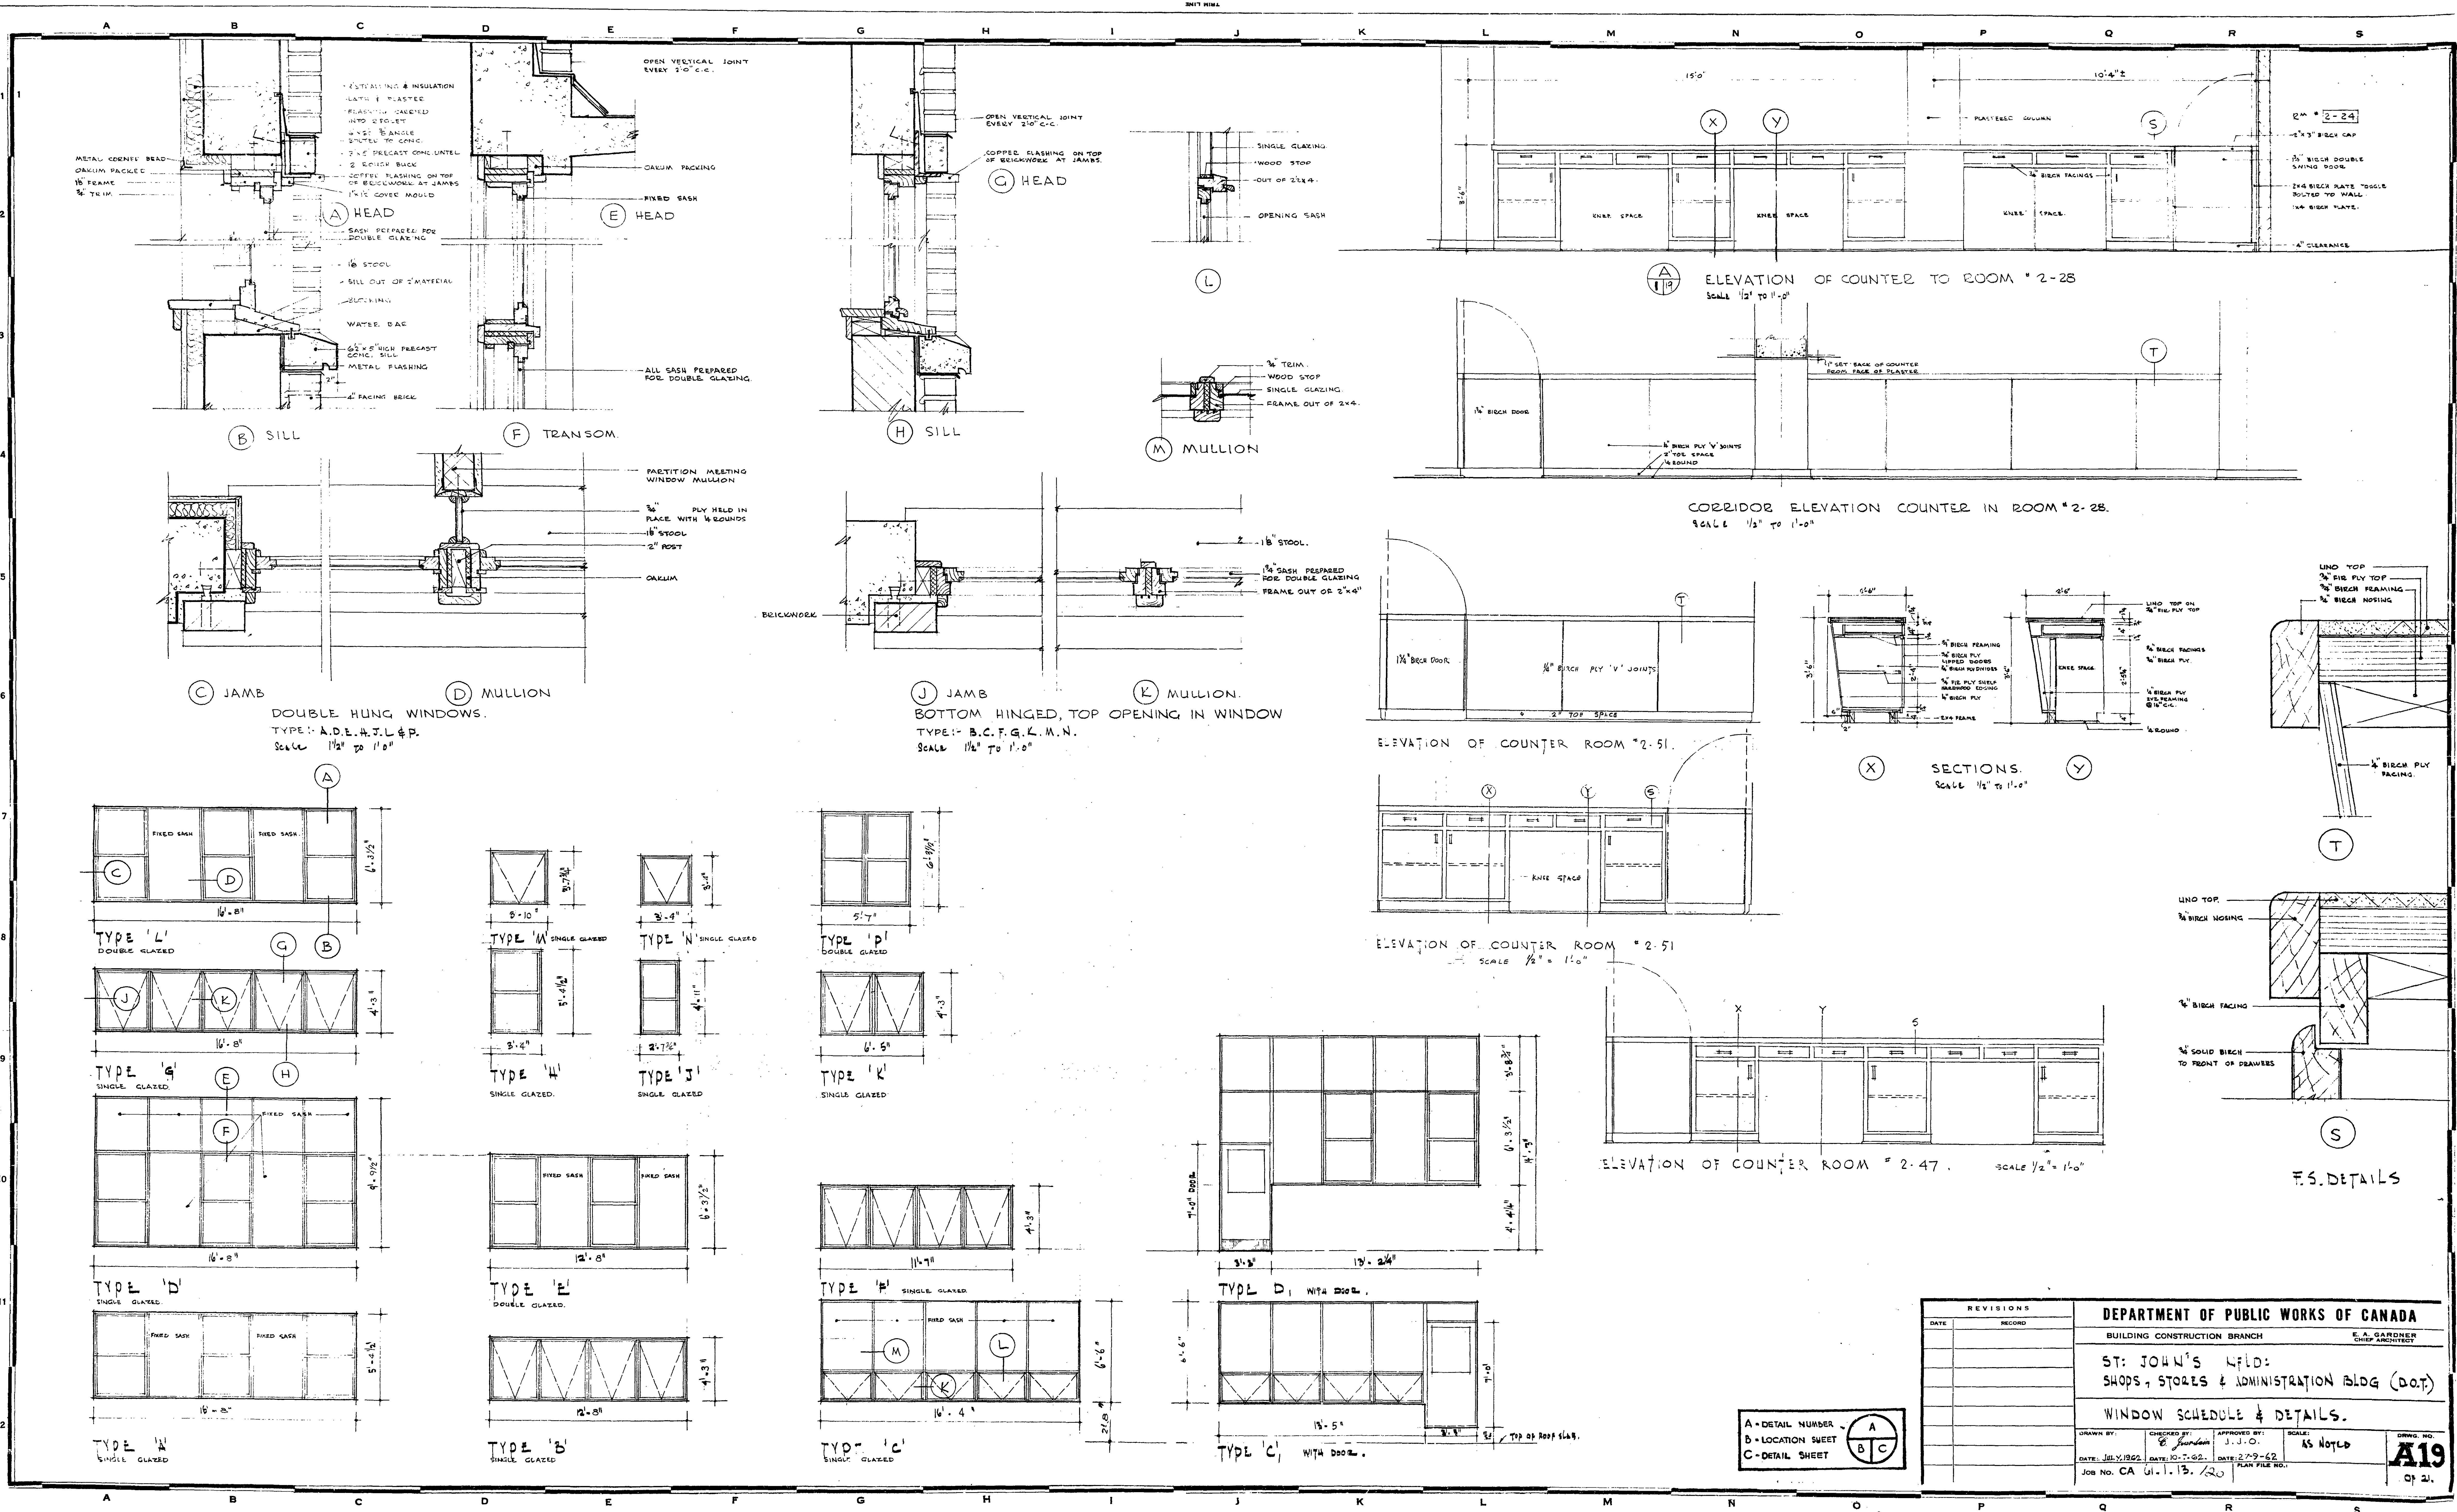

REVISIONS		DEPARTMENT OF PUBLIC WORKS OF CANADA	
DATE	RECORD	BUILDING CONSTRUCTION BRANCH	E. A. GARDNER CHIEF ARCHITECT
		ST. JOHN'S WFLD: SHOPS, STORES & ADMINISTRATION BLDG (DOT)	
		WINDOW SCHEDULE & DETAILS.	
DRAWN BY: <i>E. A. Gardner</i>		CHECKED BY: <i>J. J. O.</i>	
DATE: JUL 1/1962		DATE: 10-7-62	
JOB NO. CA 61-1.13.20		DATE: 2/9-62	
		PLAN FILE NO.	
		SCALE: AS NOTED	
		DRAWING NO. A19	
		OF 2.	

A U G. 1960


DOOR TYPES

NOTES

- *T FOLLOWING DOOR TYPE NO. ON PLANS INDICATES TRANSOM OVER.
- *L FOLLOWING TYPE NO. ON PLANS INDICATES LOUVER IN DOOR.
- *2 PRECEDING TYPE NO. ON PLANS INDICATES A PAIR OF DOORS.

NOTES

- * T FOLLOWING DOOR TYPE NO. ON PLANS INDICATES TRANSOM OVER.
- * L FOLLOWING TYPE NO. ON PLANS INDICATES LOUVRE IN DOOR.
- * 2 PRECEDING TYPE NO. ON PLANS INDICATES A PAIR OF DOORS.

REVISIONS		DEPARTMENT OF PUBLIC WORKS OF CANADA			
DATE	RECORD	BUILDING CONSTRUCTION BRANCH			E. A. GARDNER CHIEF ARCHITECT
		ST. JOHN'S NFD.			
		STORES & ADMINISTRATION BLDG. (D.O.T.)			
		DRAWN BY:	CHECKED BY: <i>E. Gardner</i>	APPROVED BY: J. J. O.	SCALE:
		DATE: JULY 1968	DATE: 10-7-68	DATE: 27-9-62	
		JOB NO. C	65-1-12-23	PLAN FILE NO.:	
					

ROOM FINISH SCHEDULE SHEET 1.

DEPARTMENT OF PUBLIC WORKS OF CANADA

BUILDING CONSTRUCTION BRANCH **E. A. GARDNER**
CHIEF ARCHITECT

ST: JOHN'S NFD
STORES & ADMINISTRATION BLDG: (D.O.T.)
























DRAWN BY:	CHECKED BY: <i>R. E. ...</i>	APPROVED BY: <i>J. J. O.</i>	SCALE:	DRWG. NO.
-----------	---------------------------------	---------------------------------	--------	-----------

DATE: JULY 1962	DATE: 10-7-62	DATE: 27-9-62	A2
PLAN FILE NO.:			

A2

3 AUG. 1960

SECOND FLOOR CONT.
STORES & ADMINISTRATION

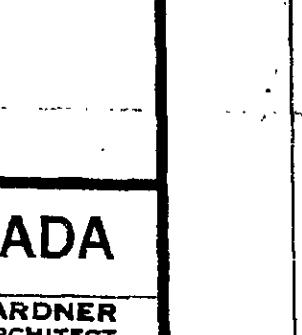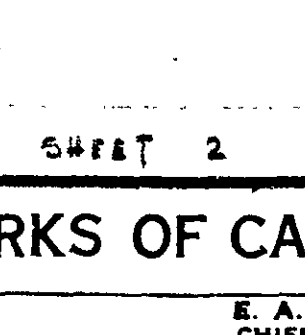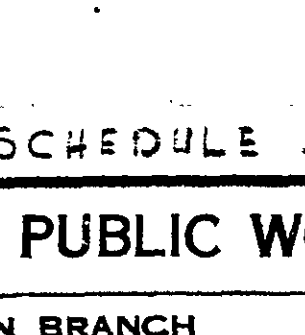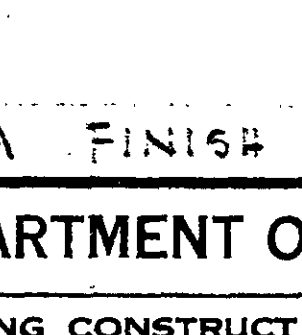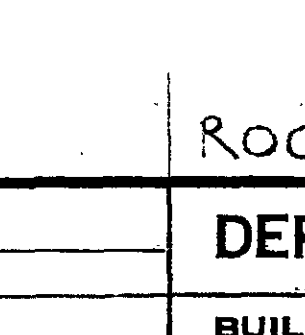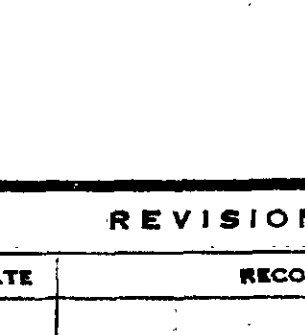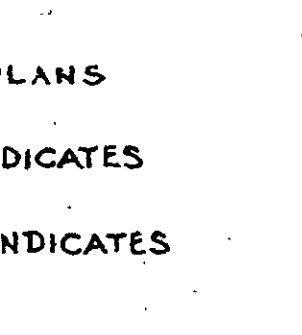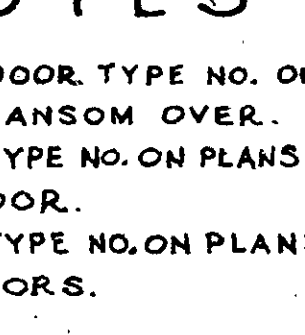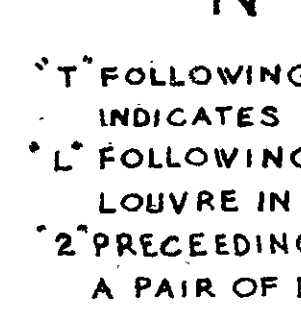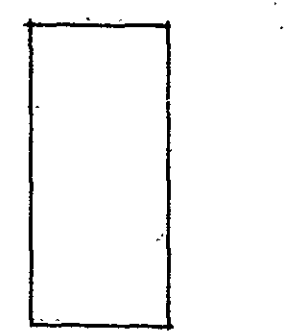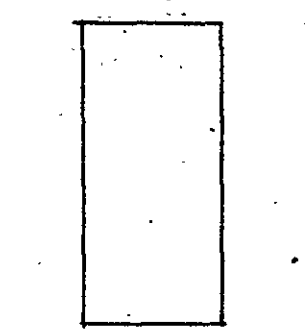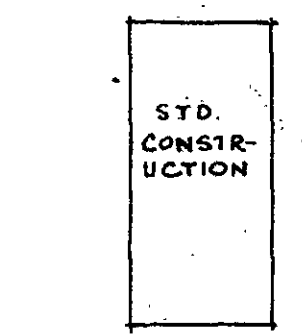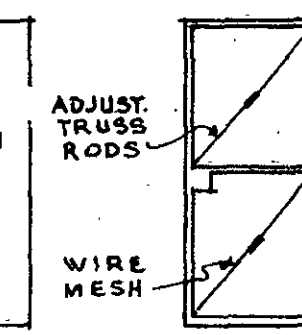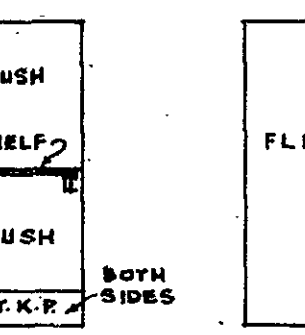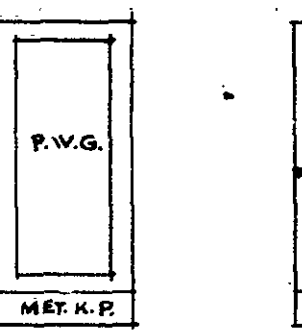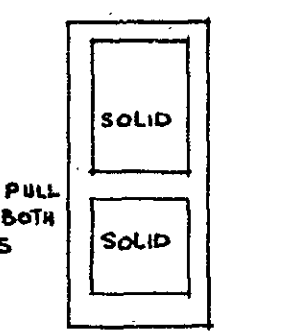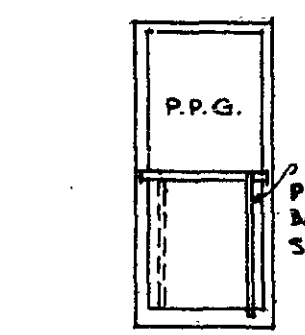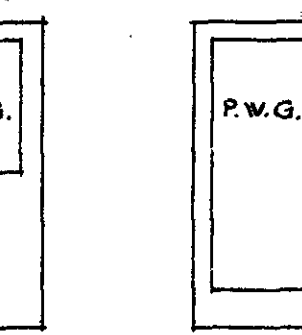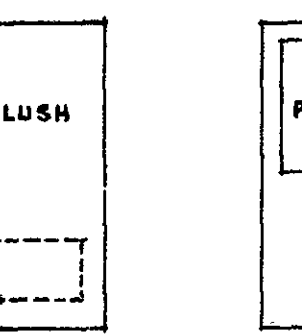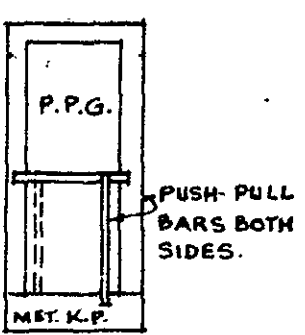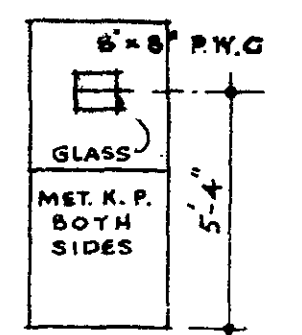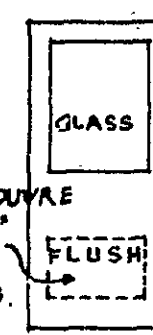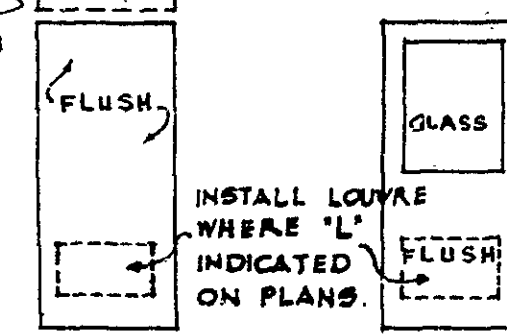


Λ	WOOD	WOOD	WOOD	WOOD	HOLLOW METAL	HOLLOW METAL	HOLLOW METAL	ALUMINUM	KALAMINE	KALAMINE	WOOD/DUTCH DOOR	WOOD/ACCESS	METAL	BIRCH/REFRIG.
A0	2'-0" x 6'-0"													
A1	2'-0" x 6'-0"	B. 2'-0" x 4'-8"	C. 2'-0" x 6'-8"	D. 2'-0" x 6'-8"	E. 2'-0" x 7'-0"	F. 2'-0" x 7'-0"	G. 2'-0" x 7'-0"	H. 2'-0" x 7'-0"	J0 2'-0" x 7'-0"	K. 2'-0" x 7'-0"	L. 2'-0" x 6'-8"	M. 1'-0" x 4'-8"	N. 2'-0" x 6'-8"	O. 2'-0" x 7'-0"
A2	2'-2" x 6'-0"	B1 2'-2" x 4"	C1 2'-2" x 6"	D1 2'-2" x 6"	E1 2'-2" x 7"	F1 2'-2" x 7"	G1 2'-2" x 7"	H1 2'-2" x 7"	J1 2'-2" x 7"	K1 2'-2" x 7"	L1 2'-2" x 6"	M1 1'-2" x 4"	N1 2'-2" x 6"	O1 2'-2" x 7"
A3	2'-4" x 6'-0"	B2 2'-4" x 4"	C2 2'-4" x 6"	D2 2'-4" x 6"	E2 2'-4" x 7"	F2 2'-4" x 7"	G2 2'-4" x 7"	H2 2'-4" x 7"	J2 2'-4" x 7"	K2 2'-4" x 7"	L2 2'-4" x 6"	M2 1'-4" x 4"	N2 2'-4" x 6"	O2 2'-4" x 7"
A4	2'-6" x 6'-8"	B3 2'-6" x 4"	C3 2'-6" x 6"	D3 2'-6" x 6"	E3 2'-6" x 7"	F3 2'-6" x 7"	G3 2'-6" x 7"	H3 2'-6" x 7"	J3 2'-6" x 7"	K3 2'-6" x 7"	L3 2'-6" x 6"	M3 1'-6" x 4"	N3 2'-6" x 6"	O3 3'-0" x 7"
A4	2'-8" x 7'-0"	B4 2'-8" x 7'-0"	C4 2'-8" x 7'-0"	D4 2'-8" x 7'-0"	E4 2'-8" x 7'-0"	F4 2'-8" x 7'-0"	G4 2'-8" x 7'-0"	H4 2'-8" x 7'-0"	J4 2'-8" x 7'-0"	K4 2'-8" x 7'-0"	L4 2'-8" x 7'-0"	M4 1'-8" x 4"	N4 2'-8" x 7'-0"	O4 3'-2" x 7"
A5	2'-10" x 7'-0"	B5 2'-10" x 7'-0"	C5 2'-10" x 7'-0"	D5 2'-10" x 7'-0"	E5 2'-10" x 7'-0"	F5 2'-10" x 7'-0"	G5 2'-10" x 7'-0"	H5 2'-10" x 7'-0"	J5 2'-10" x 7'-0"	K5 2'-10" x 7'-0"	L5 2'-10" x 7'-0"	M5 1'-10" x 4"	N5 2'-10" x 7'-0"	O5 3'-4" x 7"
A6	3'-0" x 7'-0"	B6 3'-0" x 7'-0"	C6 3'-0" x 7'-0"	D6 3'-0" x 7'-0"	E6 3'-0" x 7'-0"	F6 3'-0" x 7'-0"	G6 3'-0" x 7'-0"	H6 3'-0" x 7'-0"	J6 3'-0" x 7'-0"	K6 3'-0" x 7'-0"	L6 3'-0" x 7'-0"	M6 3'-0" x 7'-0"	N6 3'-0" x 7'-0"	O6 3'-6" x 7"


- * T FOLLOWING DOOR TYPE NO. ON PLANS INDICATES TRANSOM OVER.
- * L FOLLOWING TYPE NO. ON PLANS INDICATES LOUVRE IN DOOR.
- * 2 PRECEDING TYPE NO. ON PLANS INDICATES A PAIR OF DOORS.

DRWG. No
A 21
OF 21









4-CA-61-1-13/25

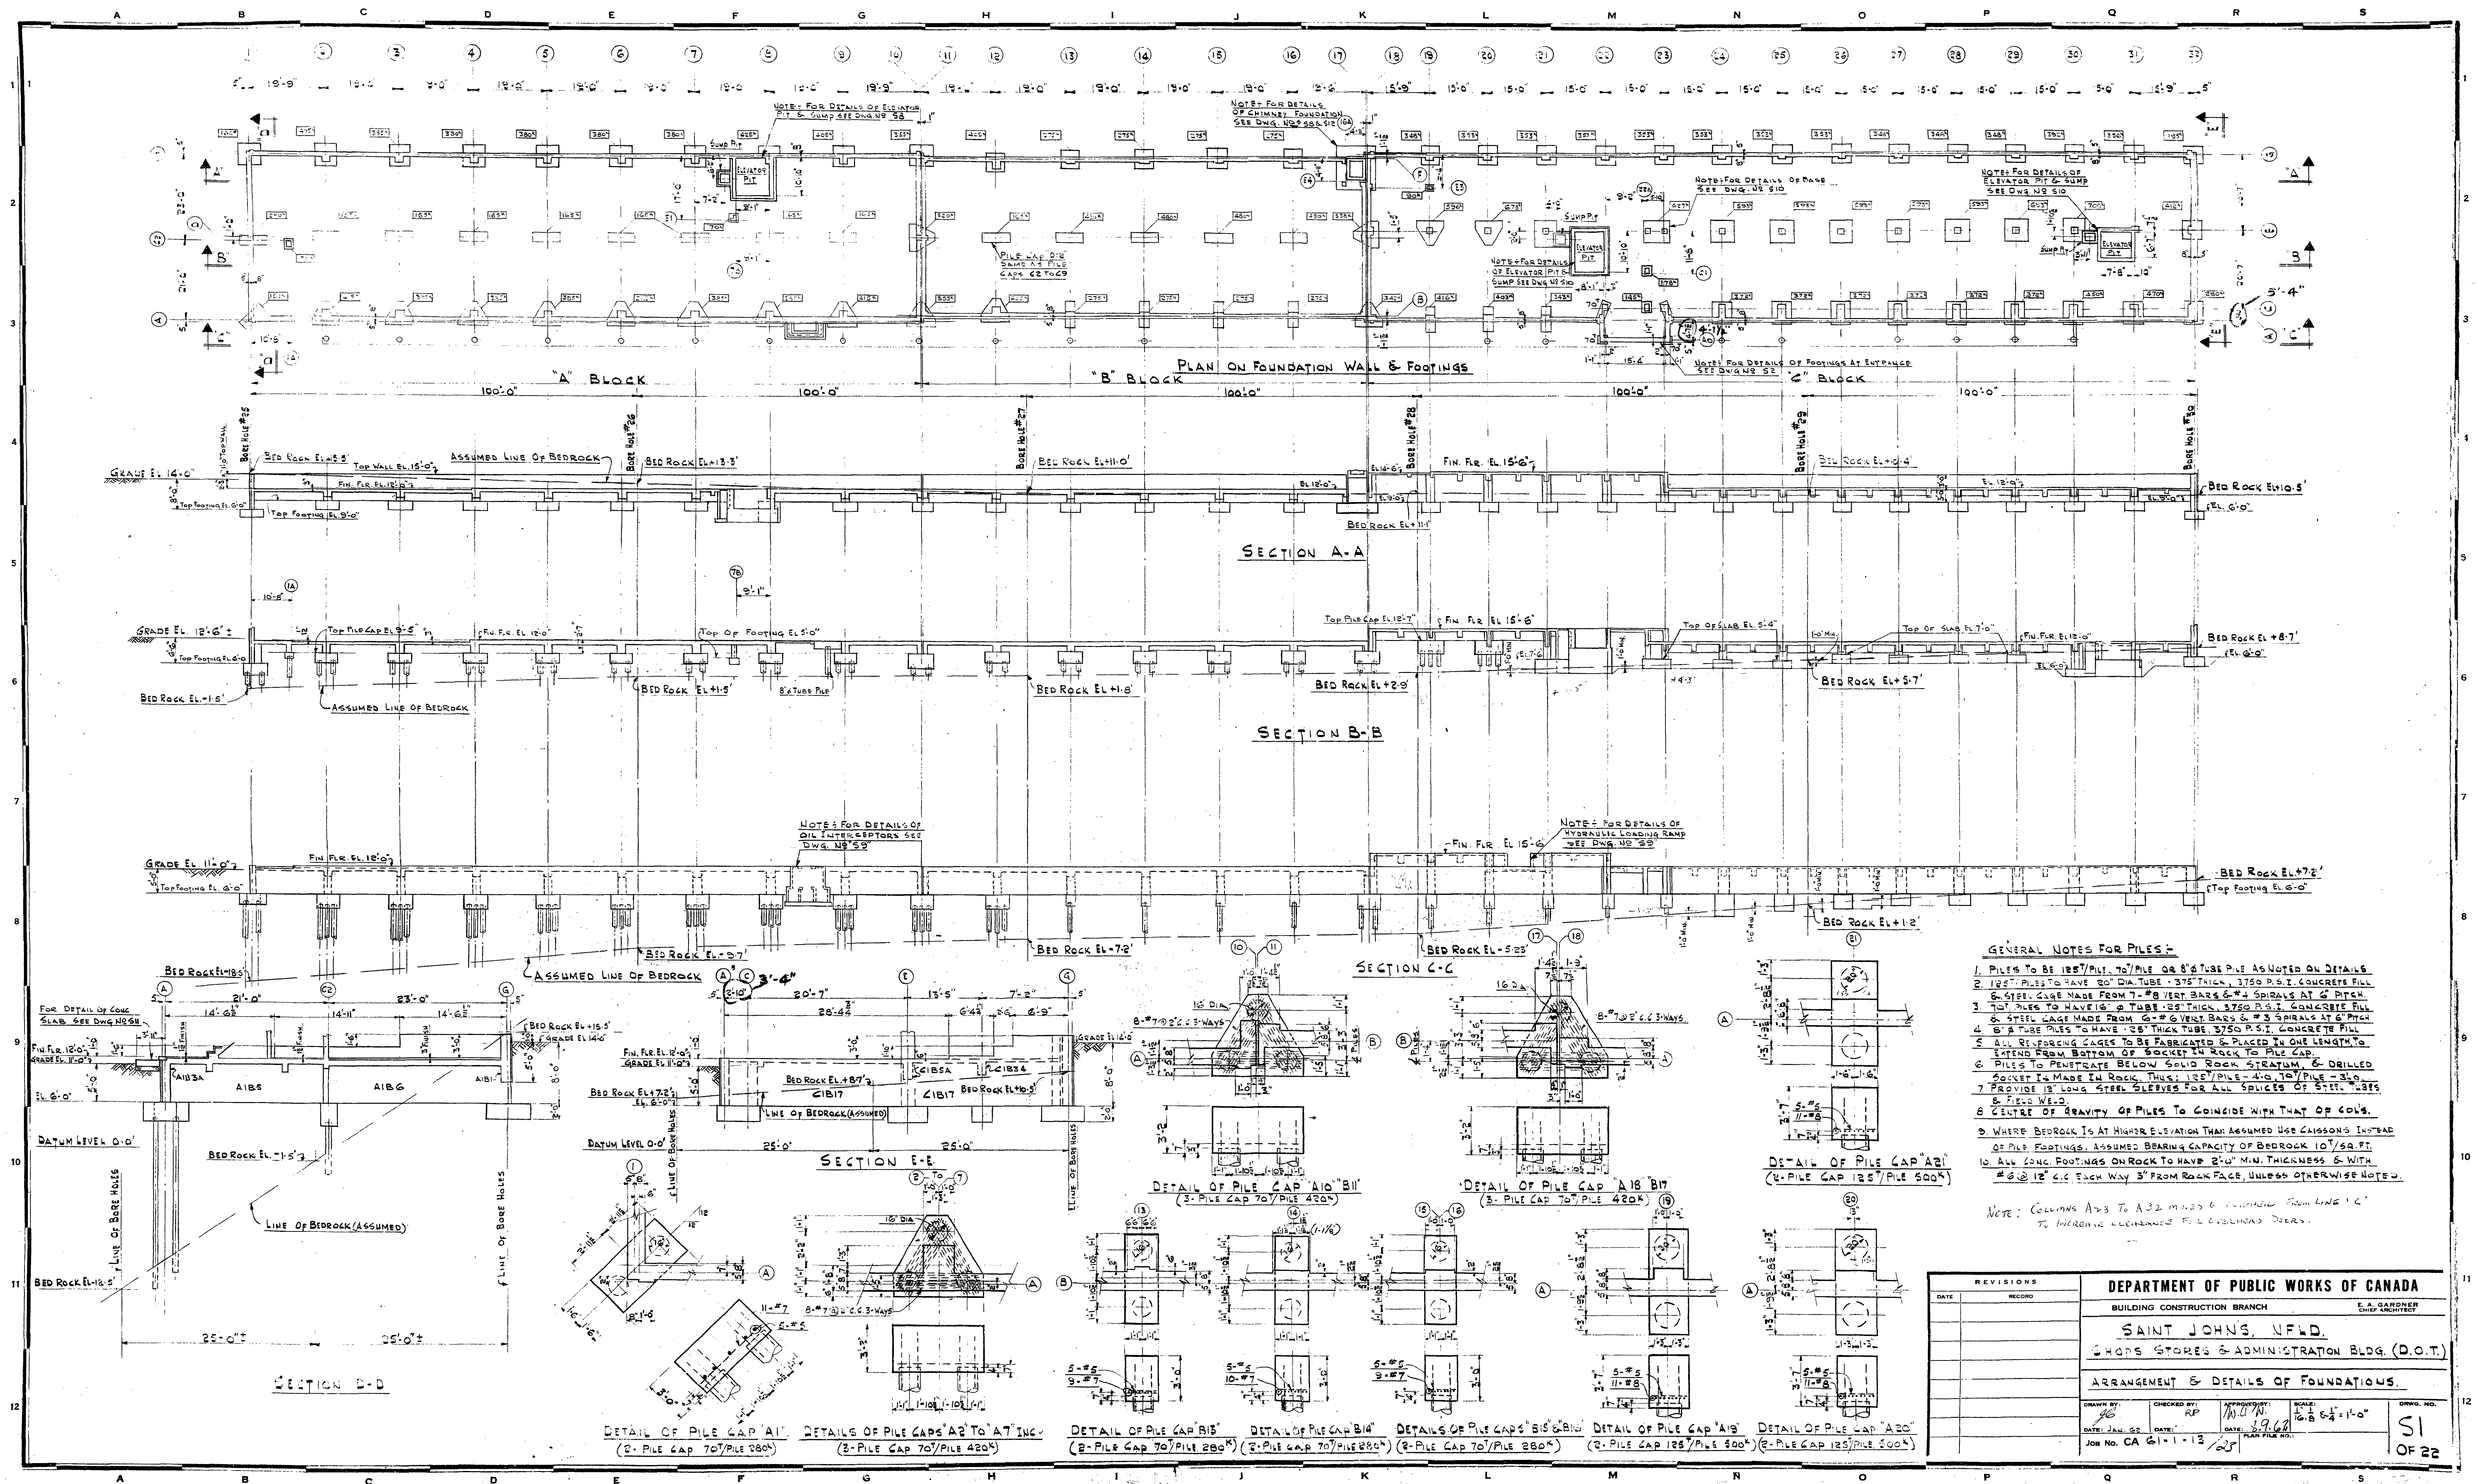

REVISIONS		DEPARTMENT OF PUBLIC WORKS OF CANADA	
DATE	RECORD	BUILDING CONSTRUCTION BRANCH	E. A. GARDNER CHIEF ARCHITECT
		SAINT JOHN'S, N.F.L.D.	
		SHOPS STORES & ADMINISTRATION BLDG. (D.O.T.)	
		ARRANGEMENT & DETAILS OF FOUNDATIONS	
DRAWN BY	CHECKED BY	APPROVED BY	SCALE
DATE: JAN. 22	DATE: 1/13	DATE: 1/13	1/8" = 1'-0"
JOB NO. CA 61-1-13	DATE: 1/13	DATE: 1/13	DATE: 1/13
			DRWG. NO.
			SI
			OF 22

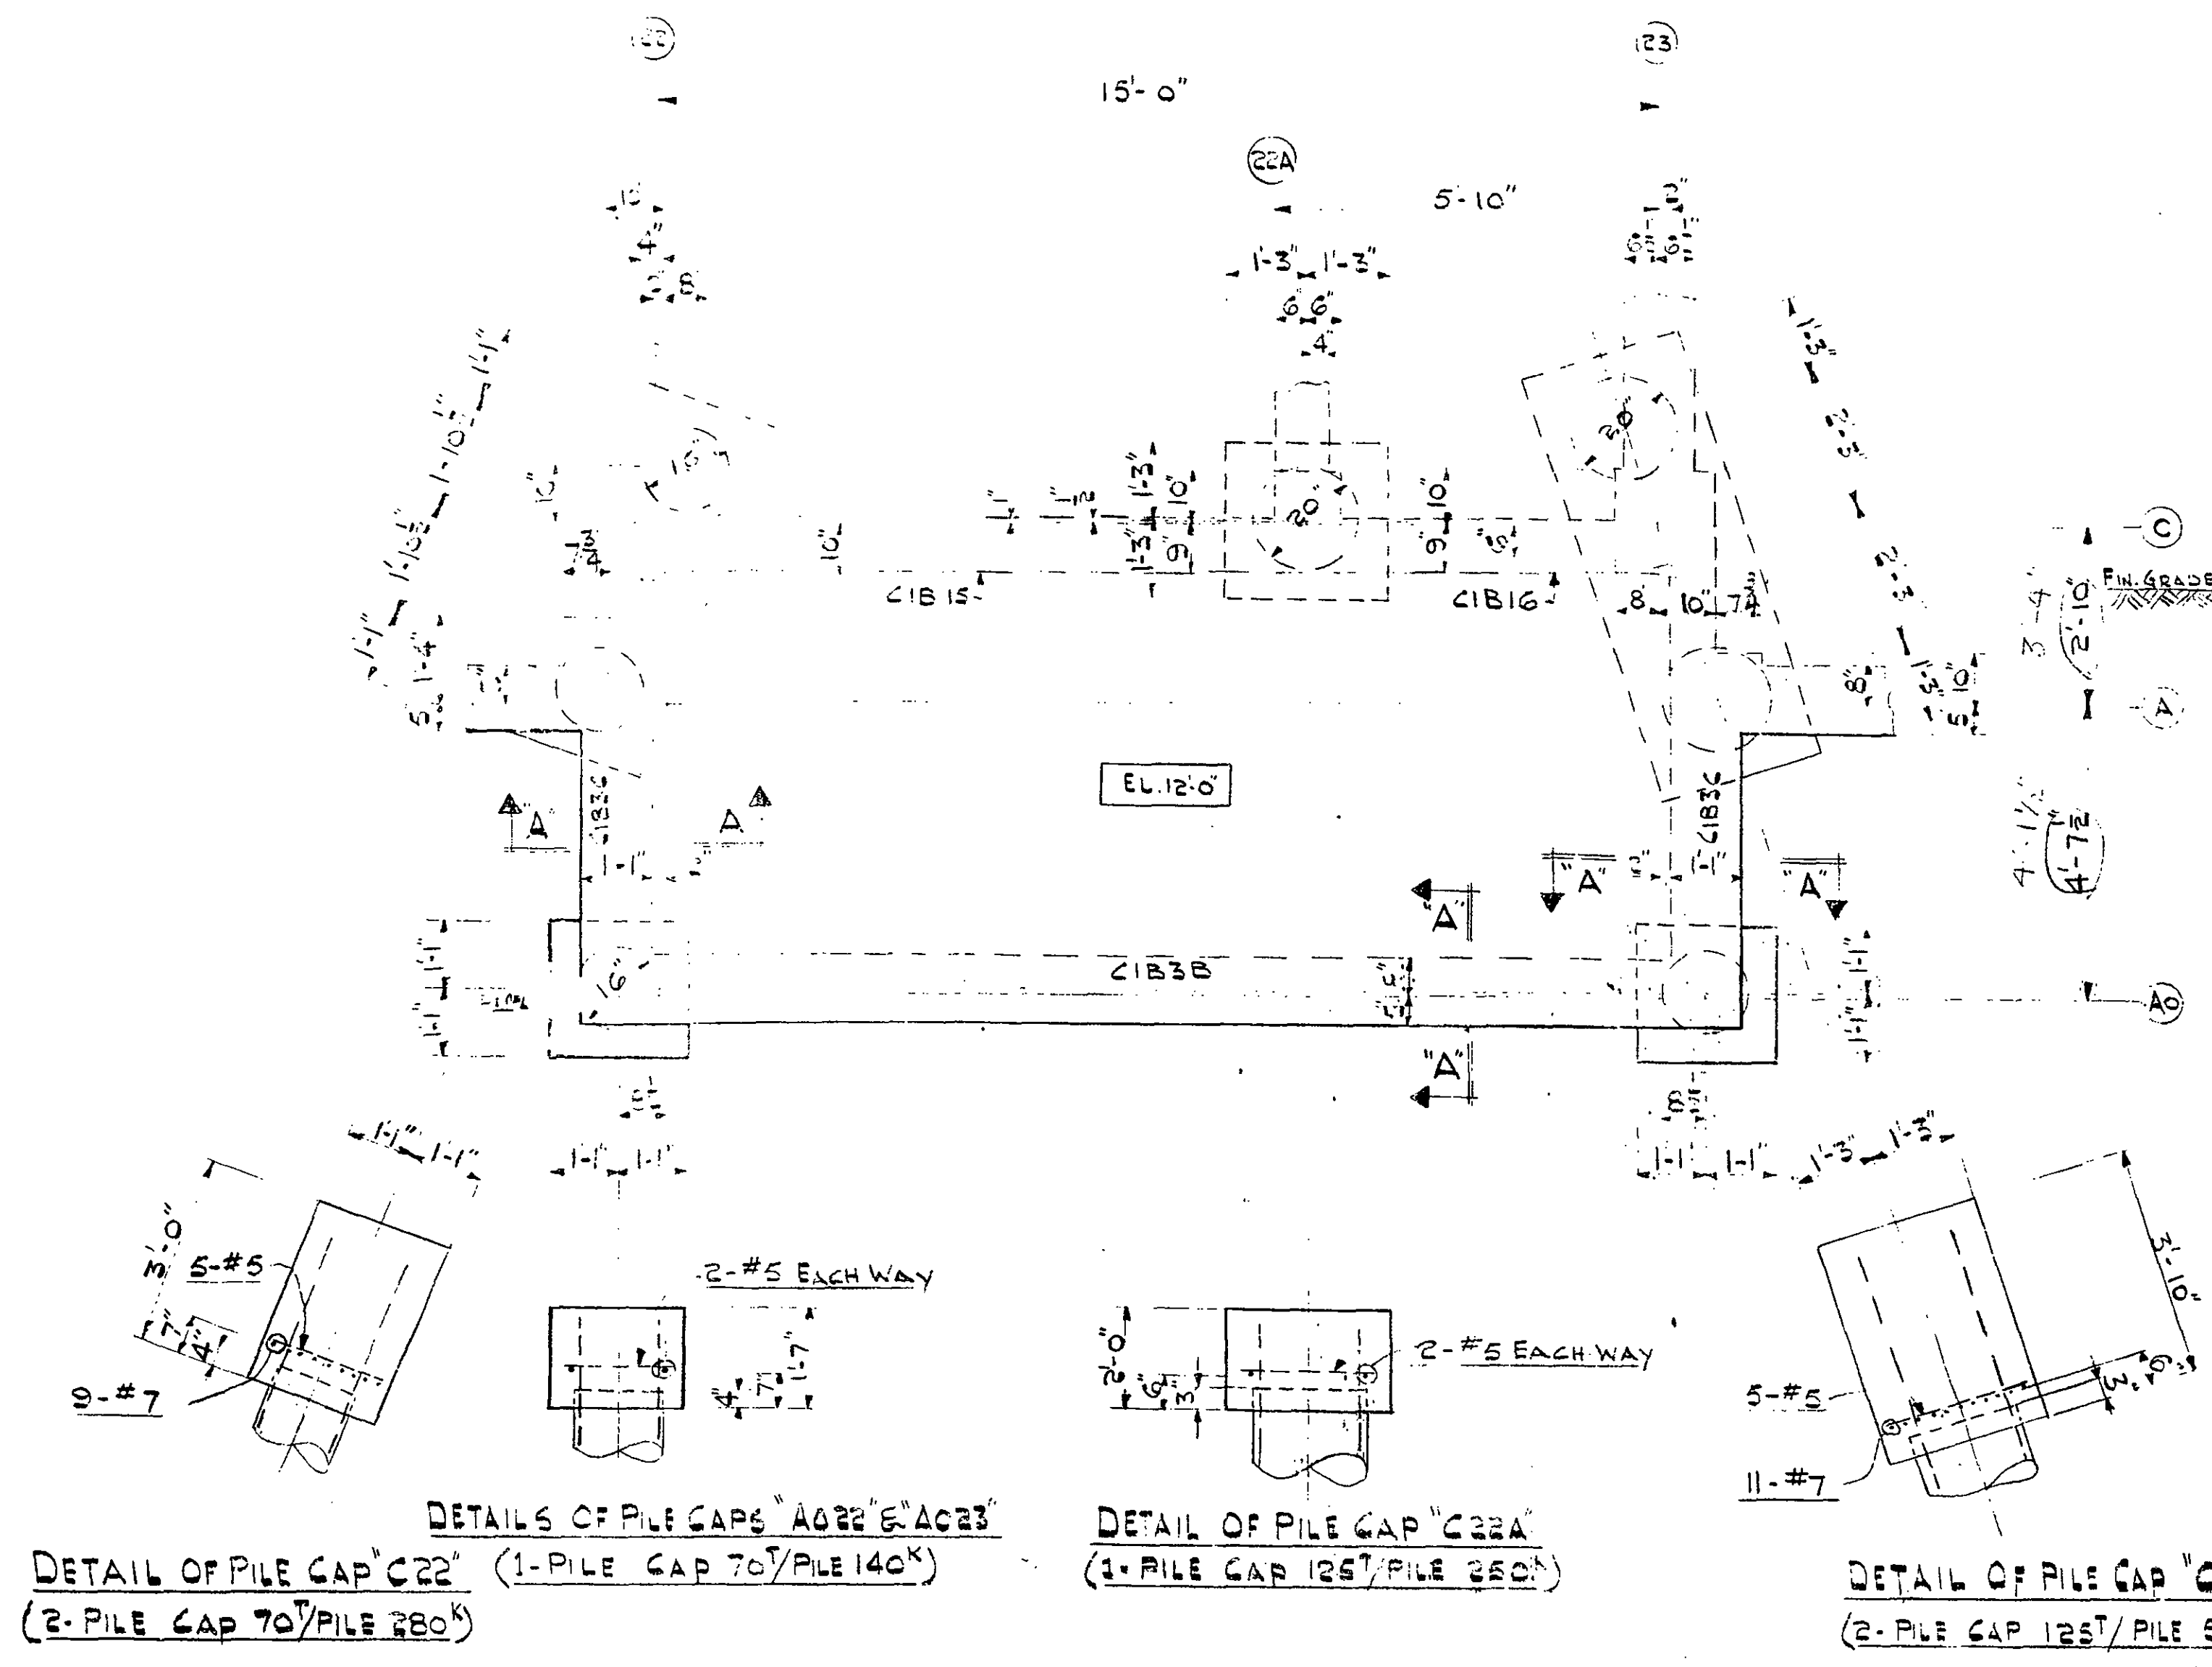


ARRANGEMENT OF PILES AT ENTRANCE

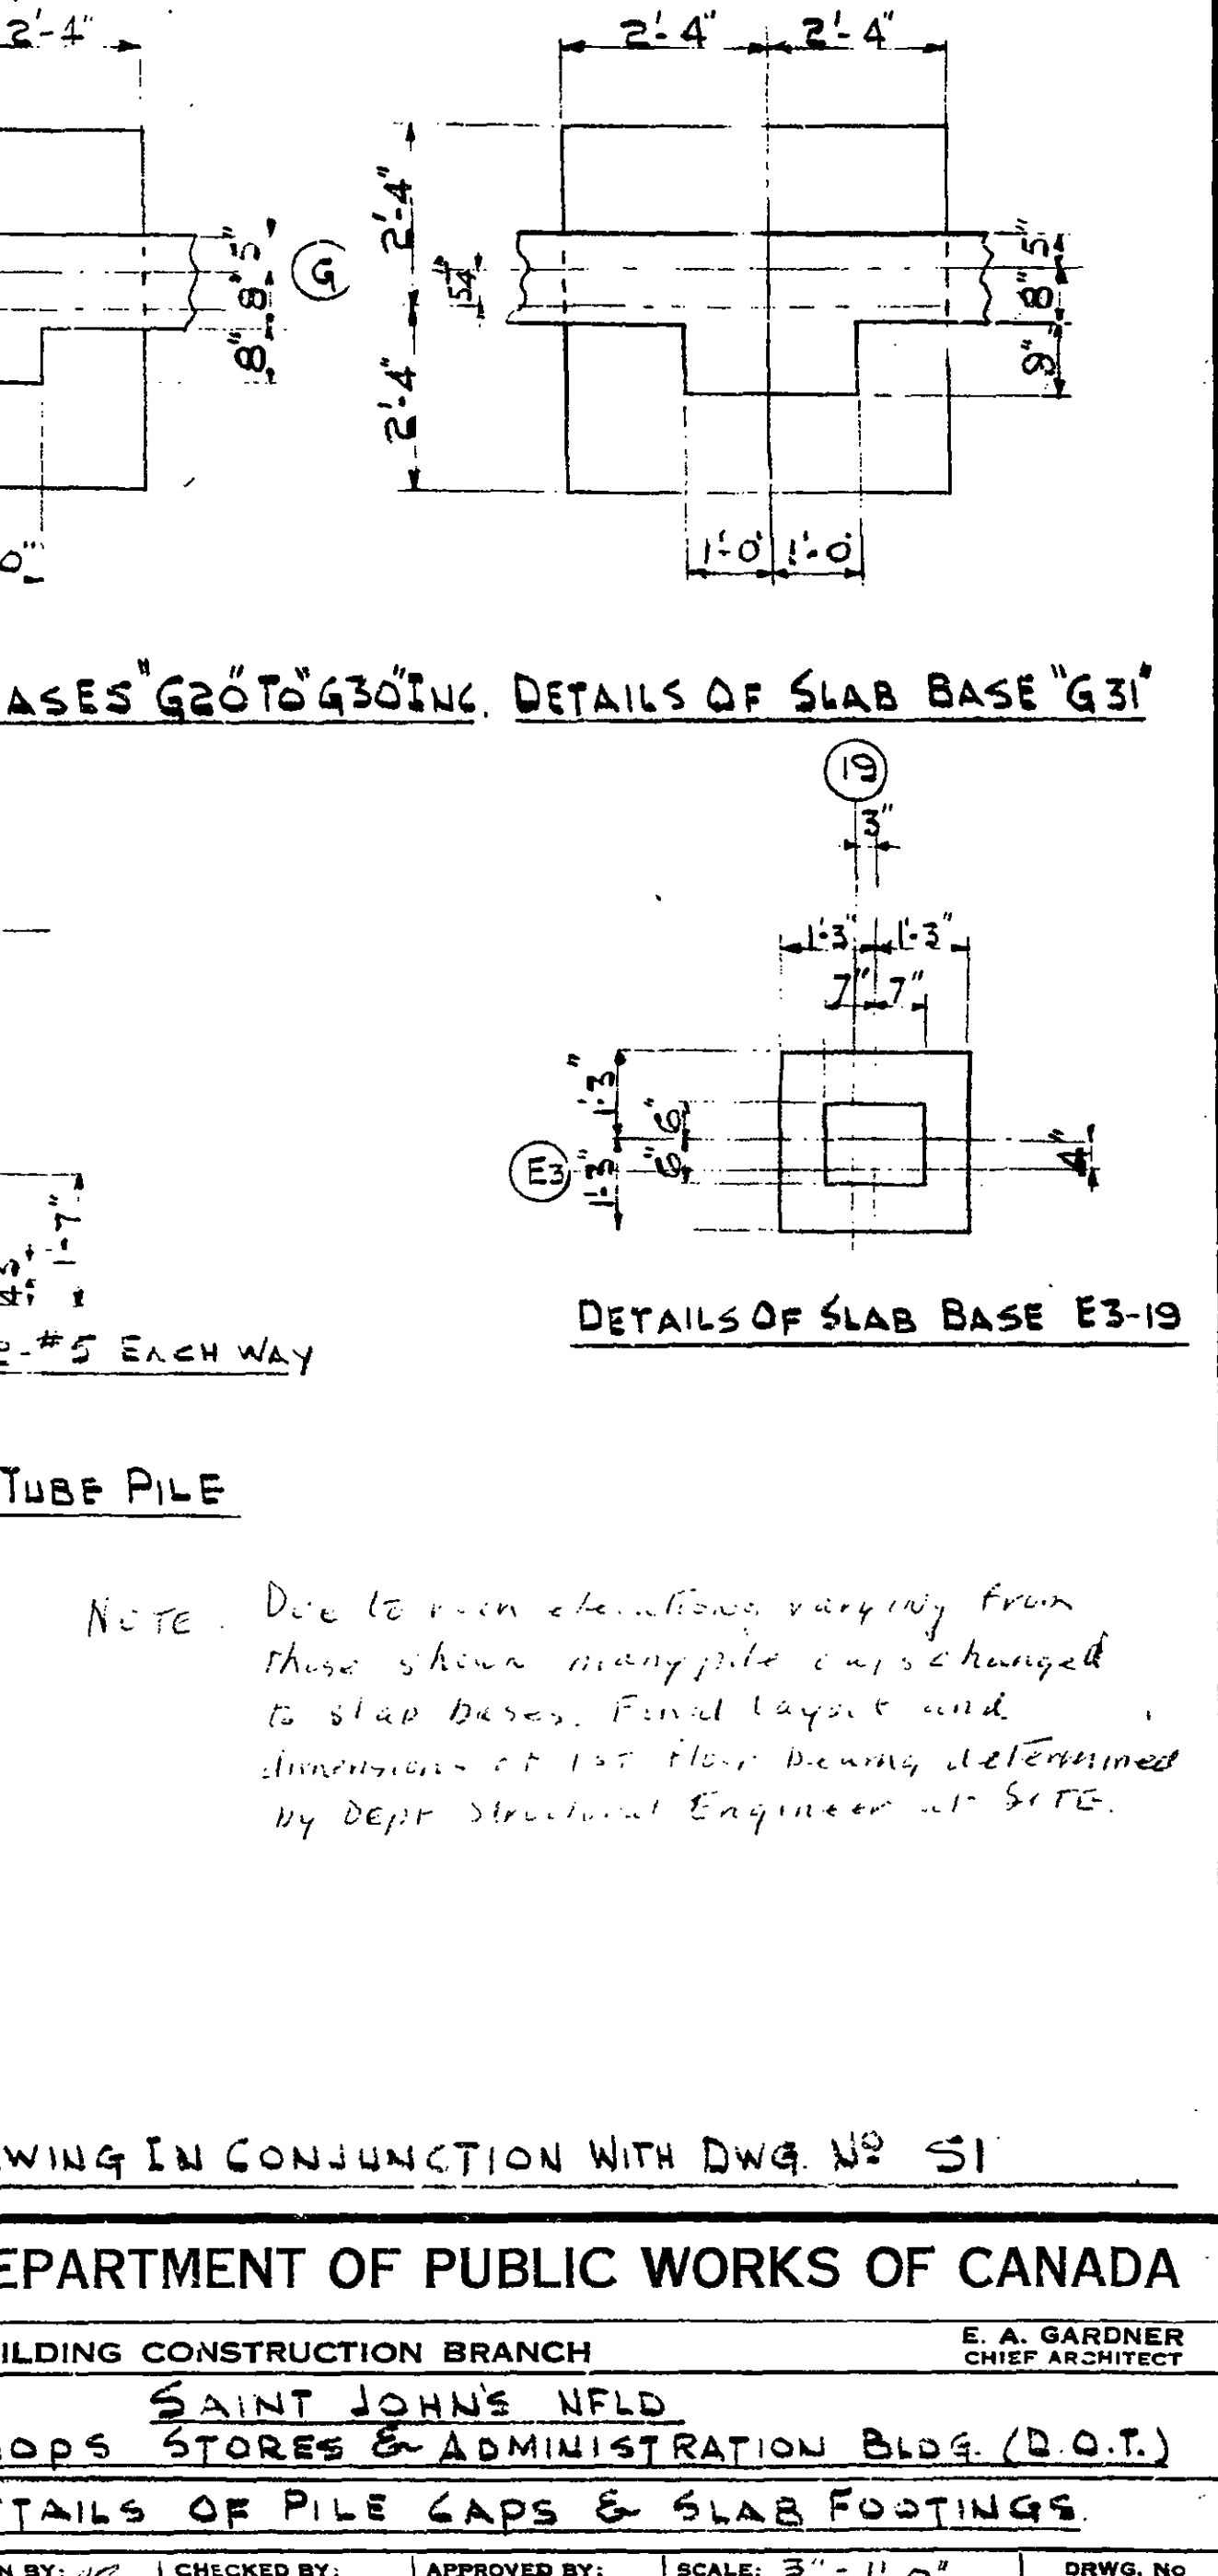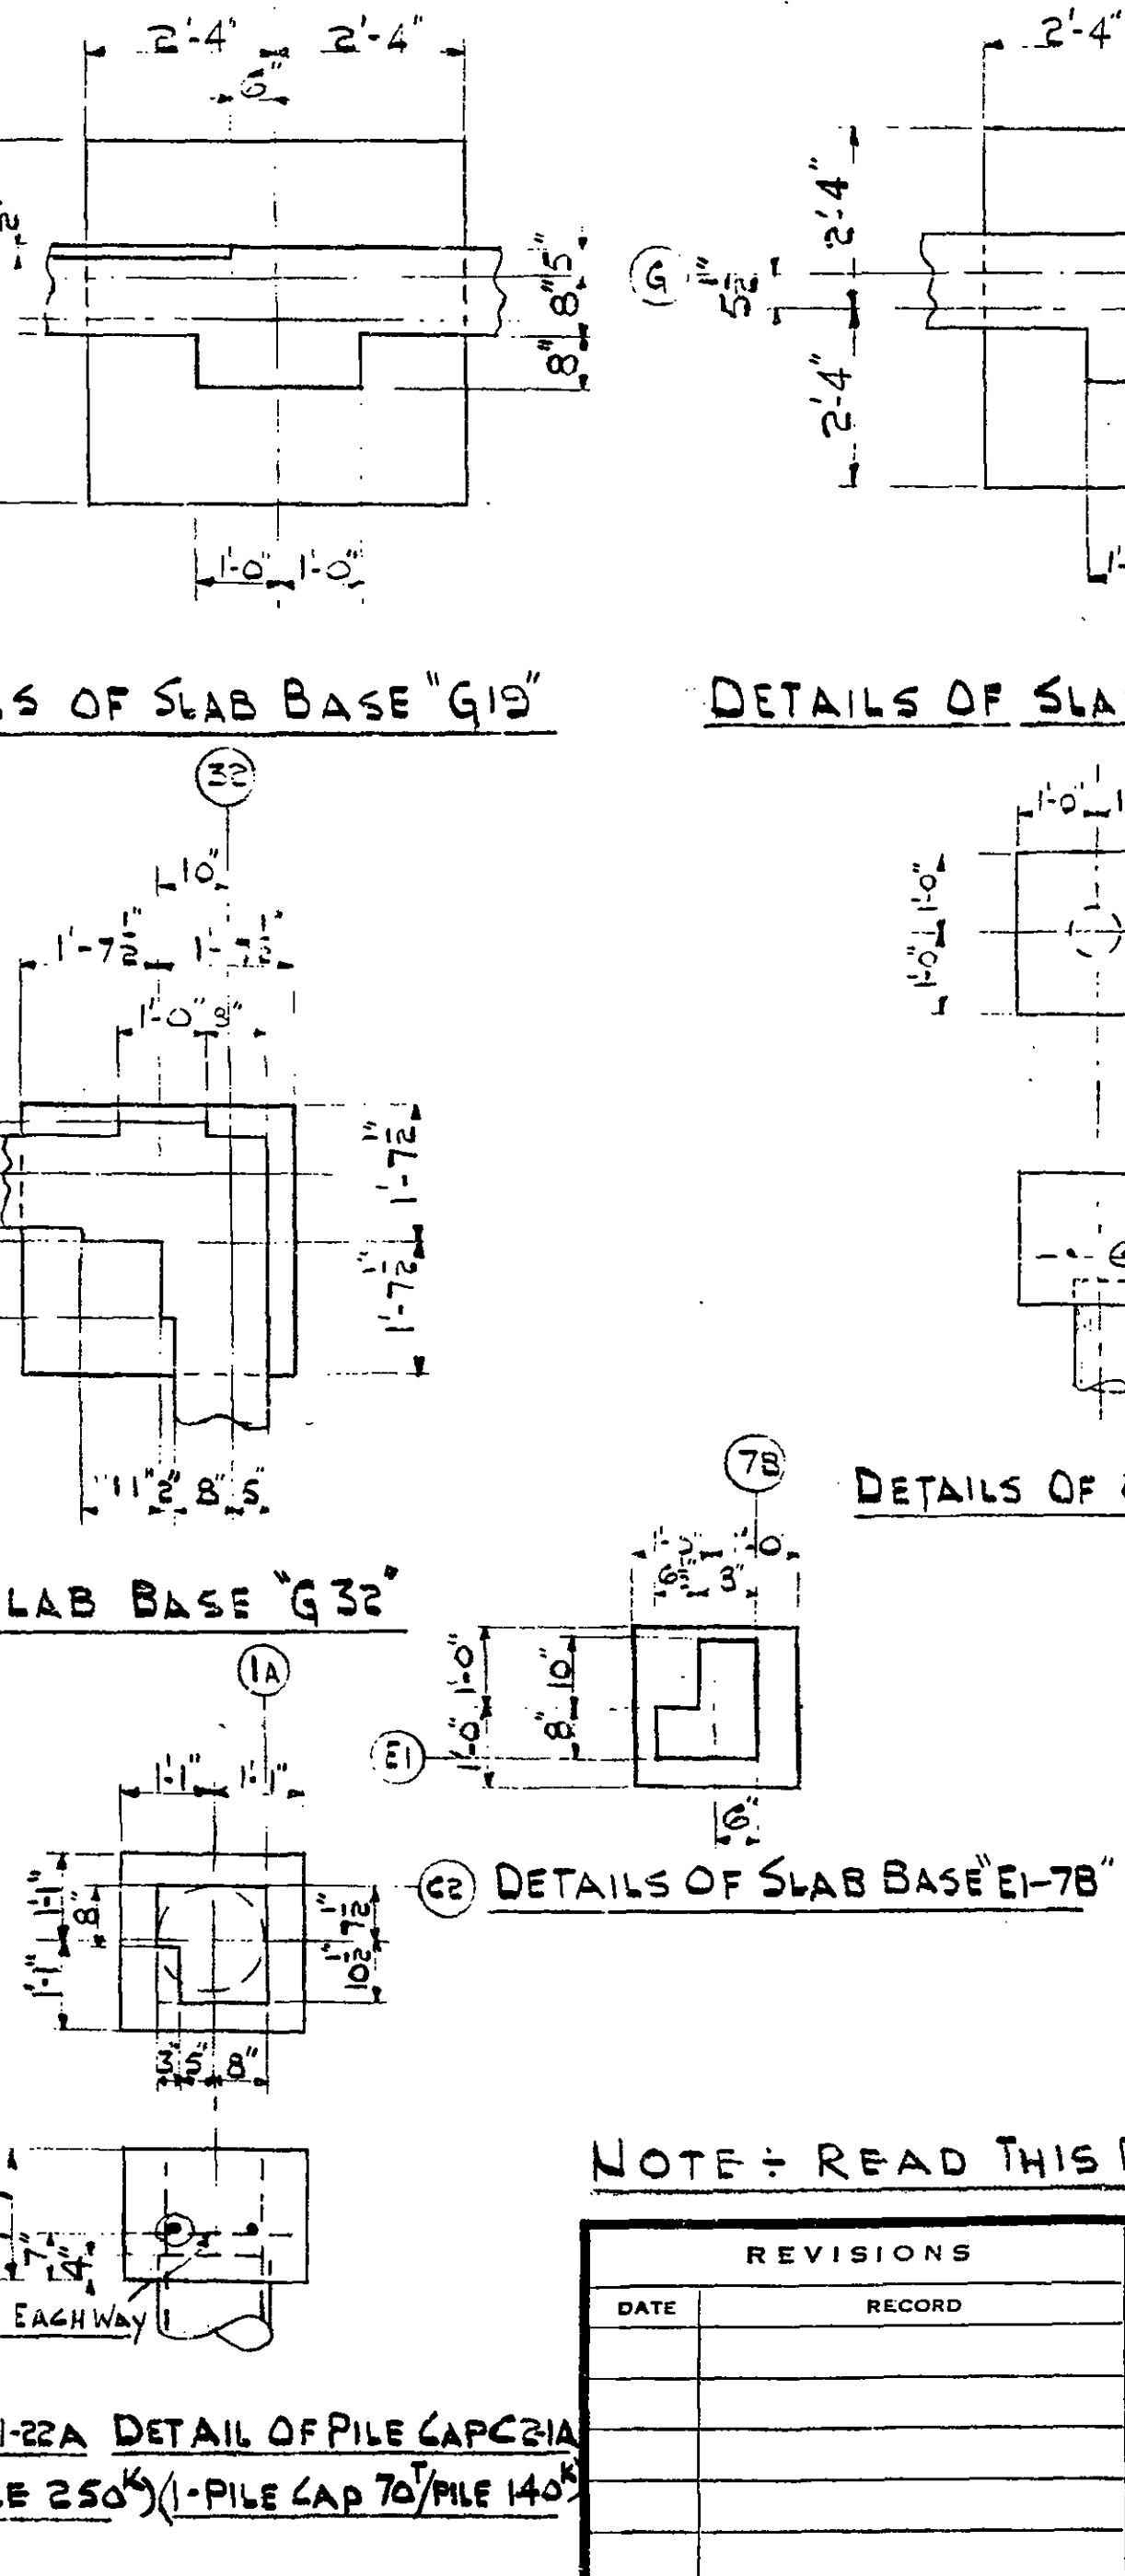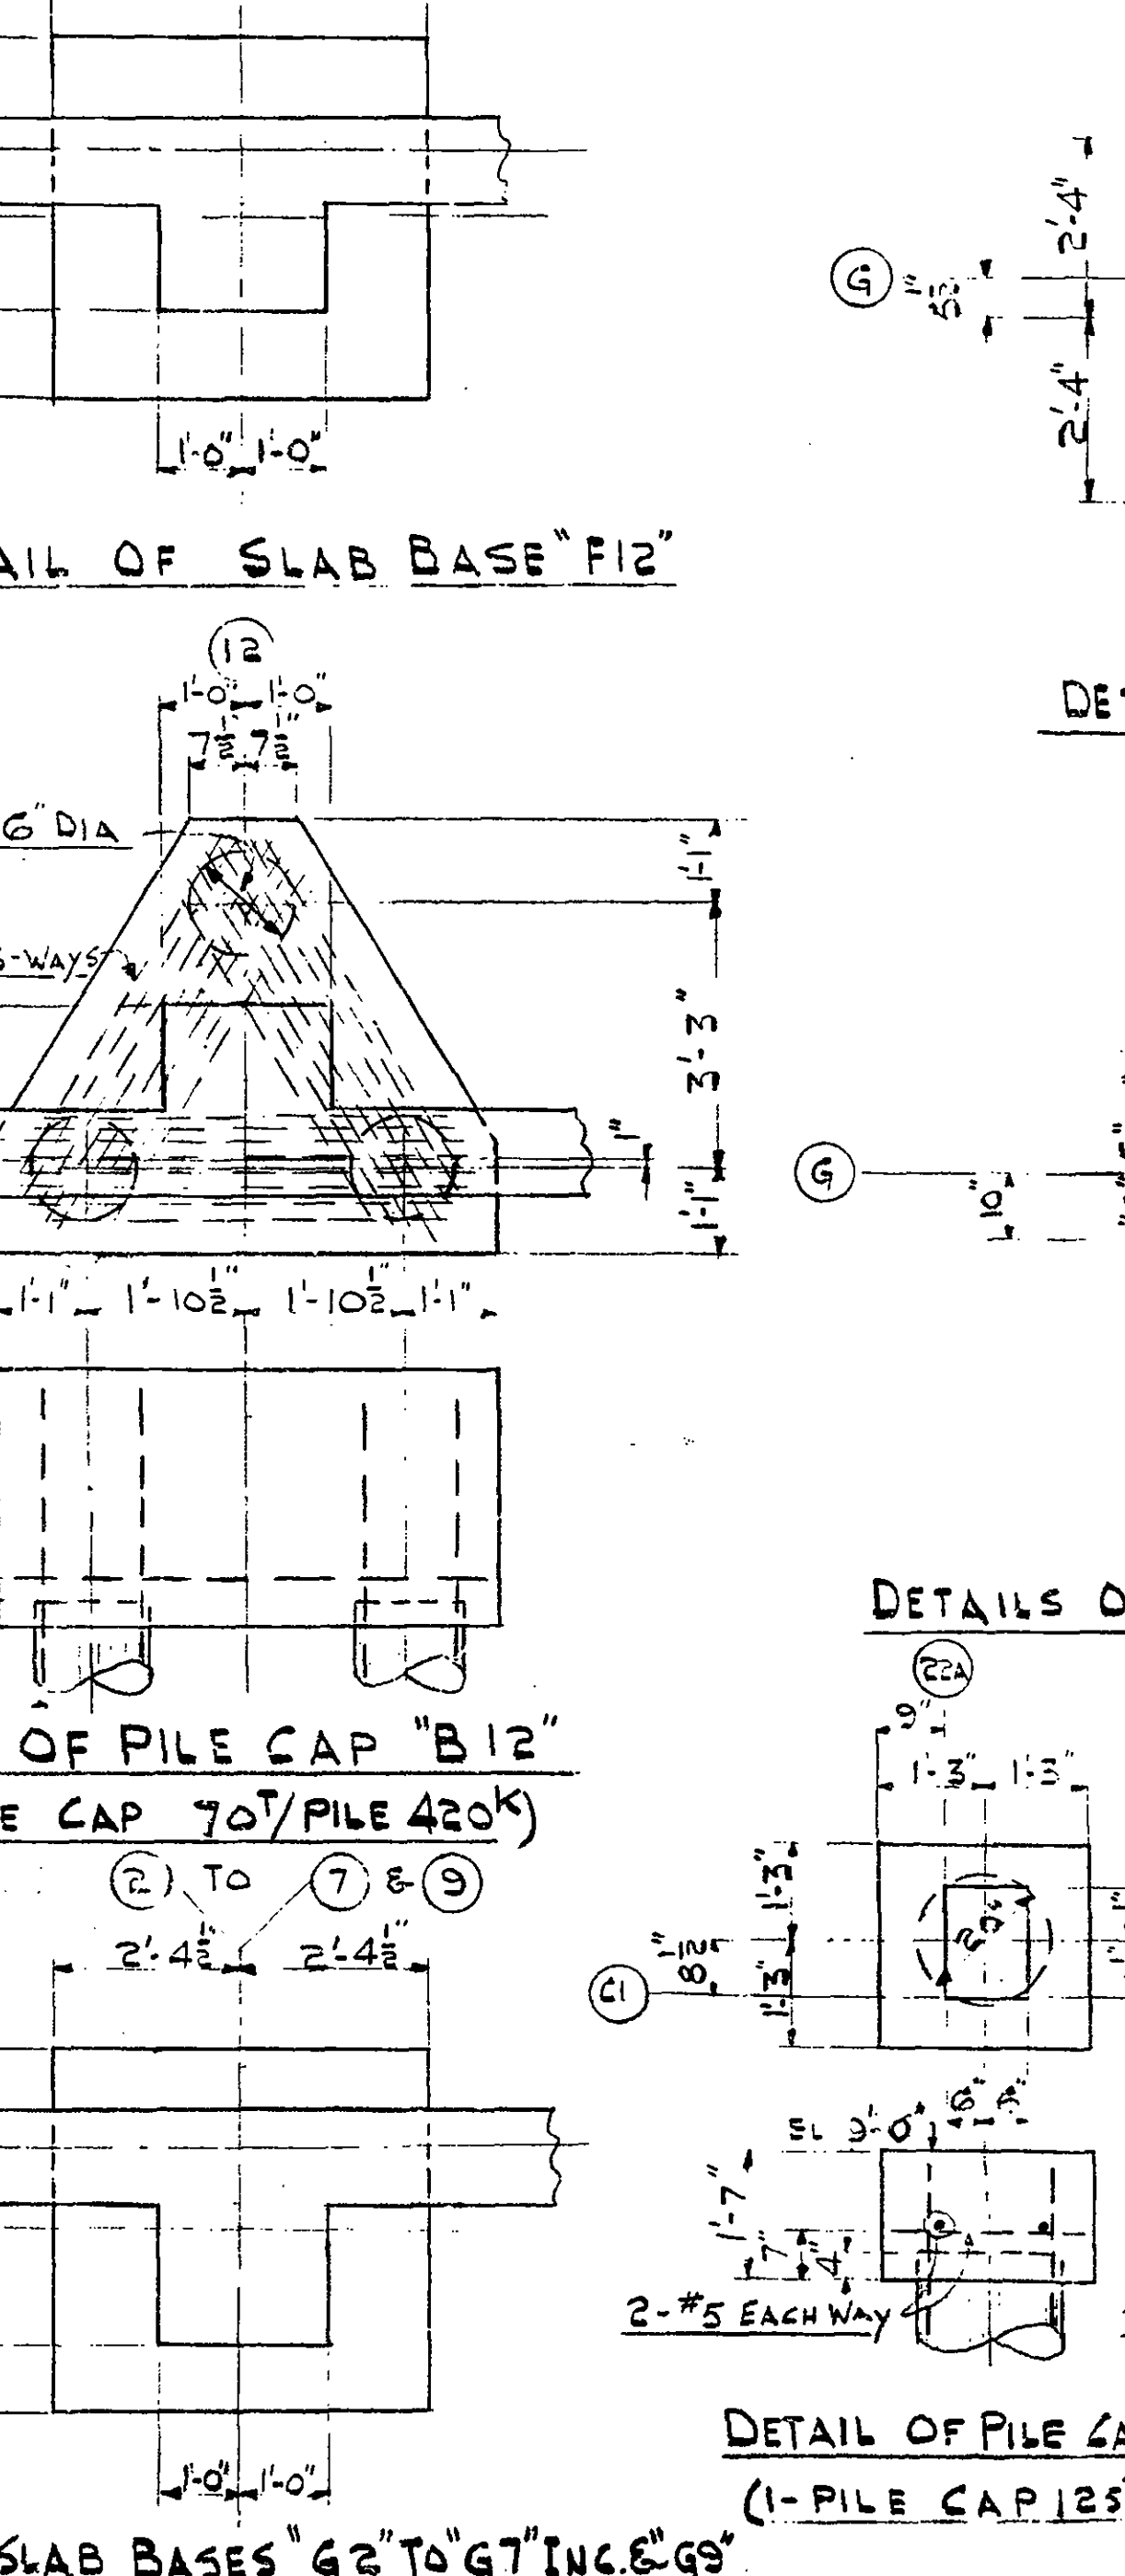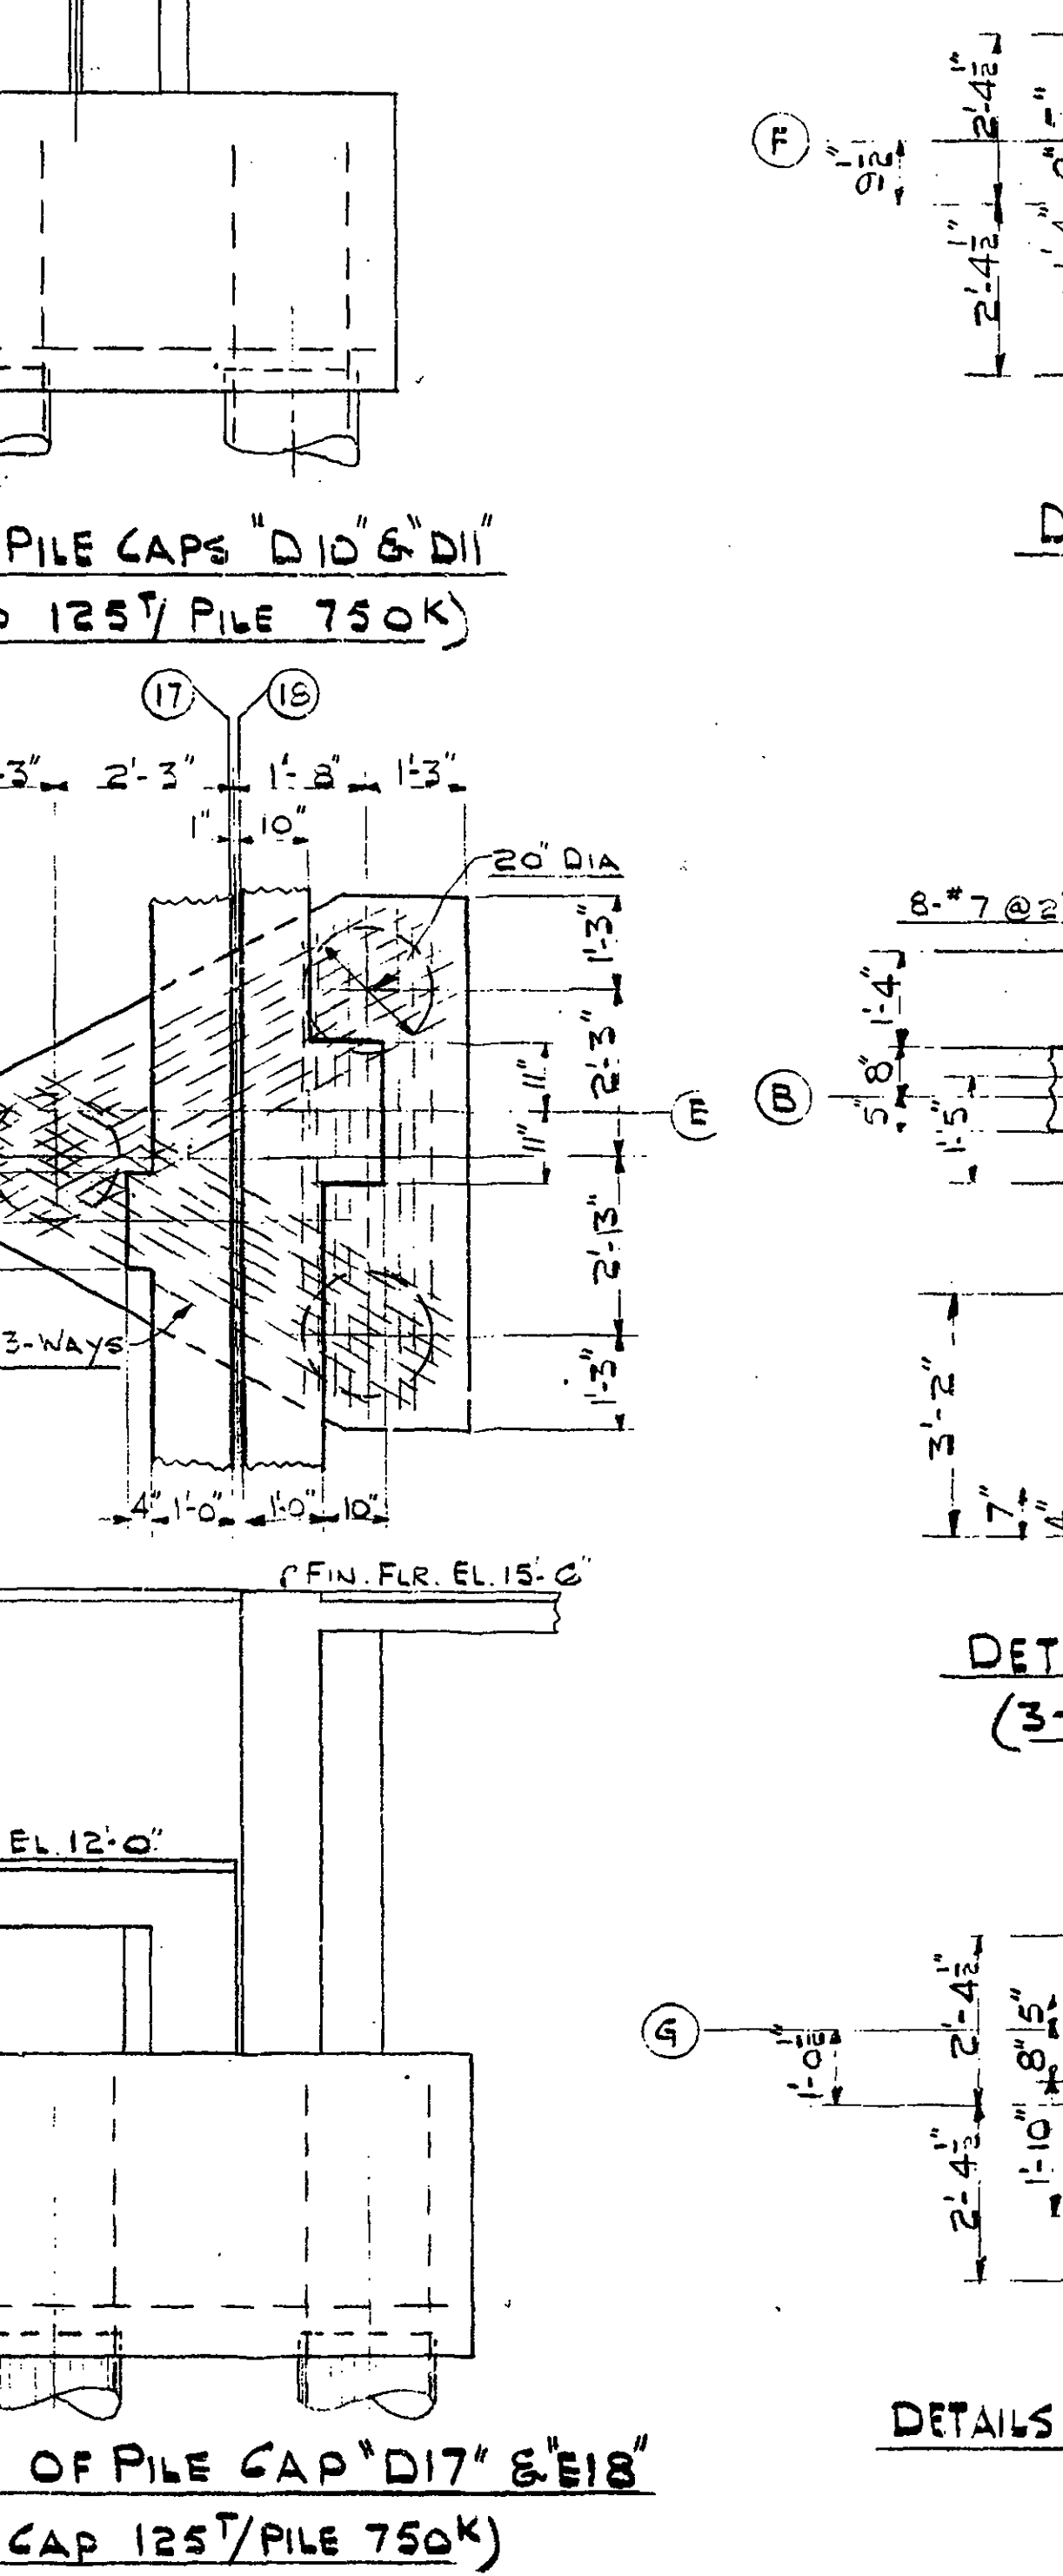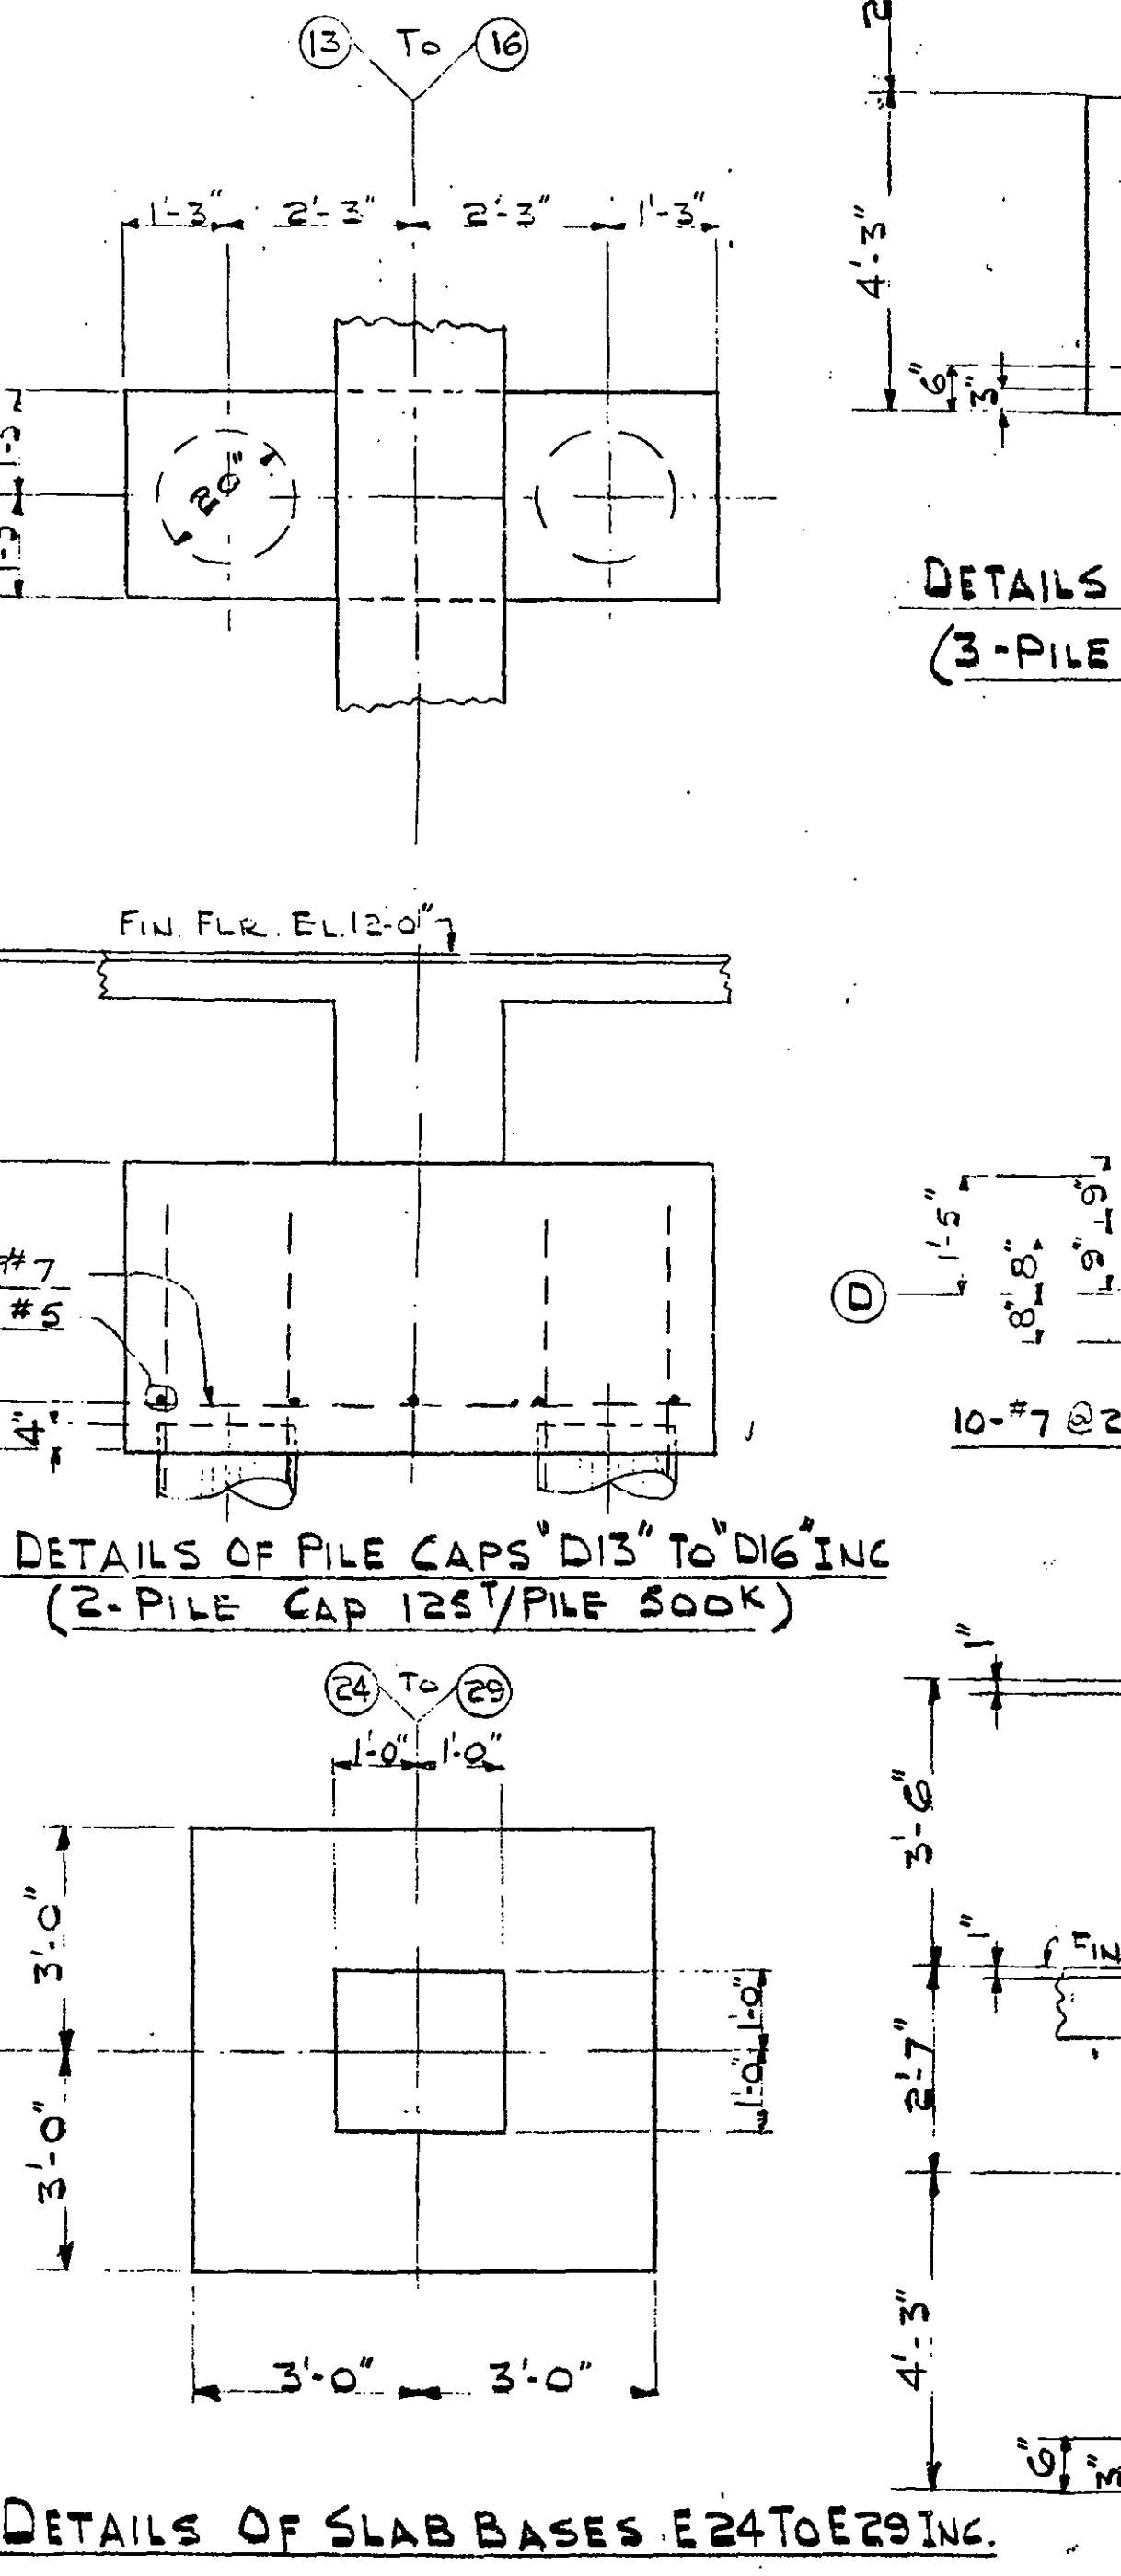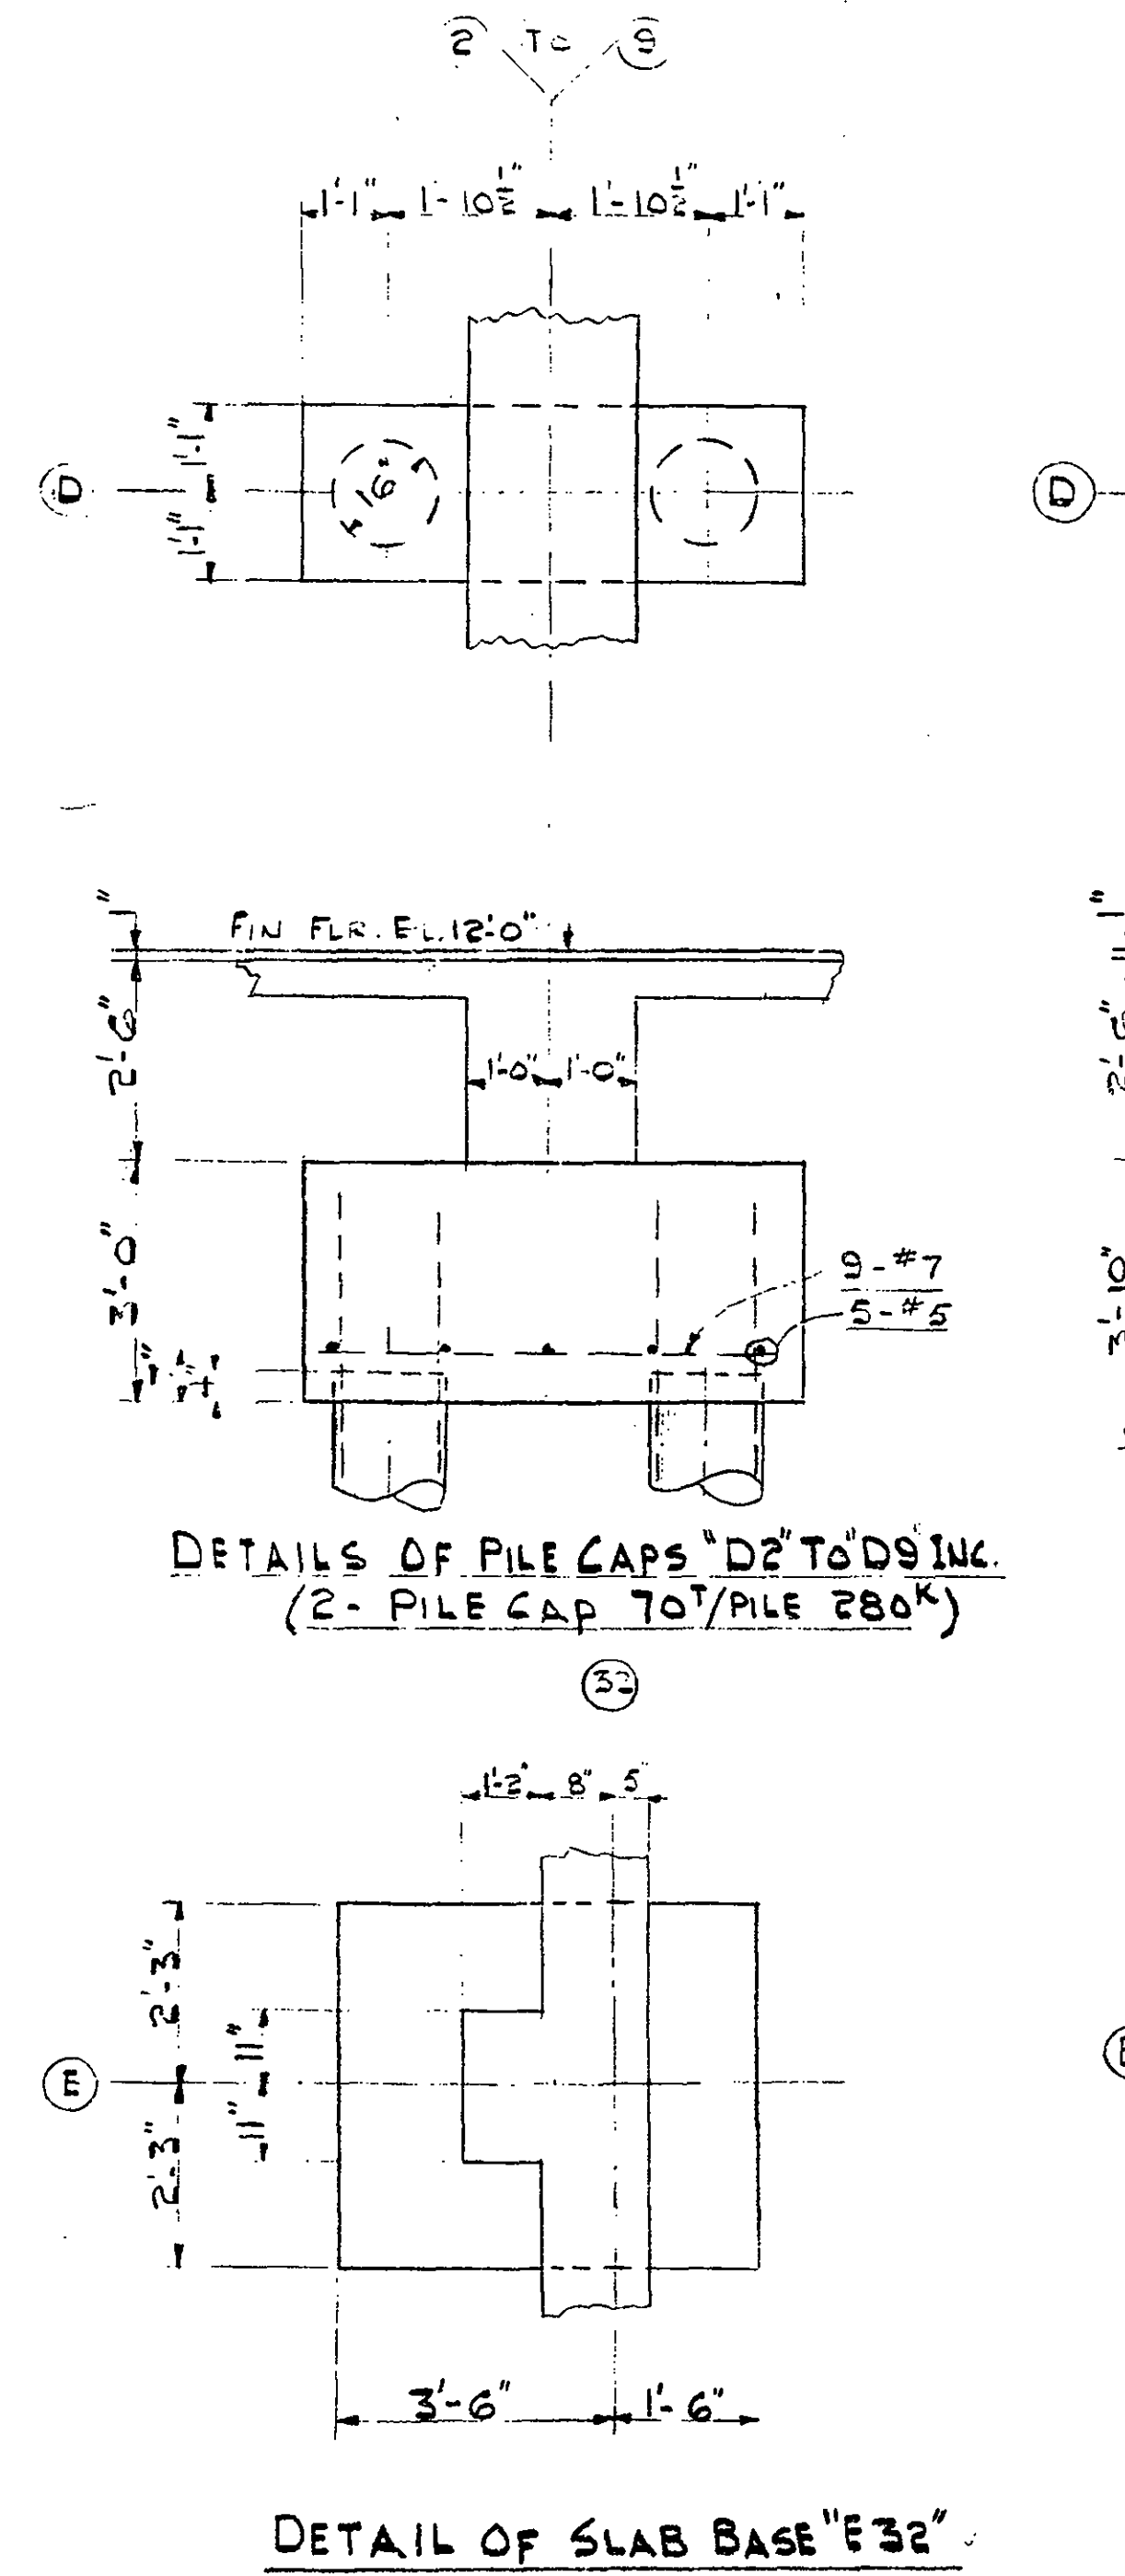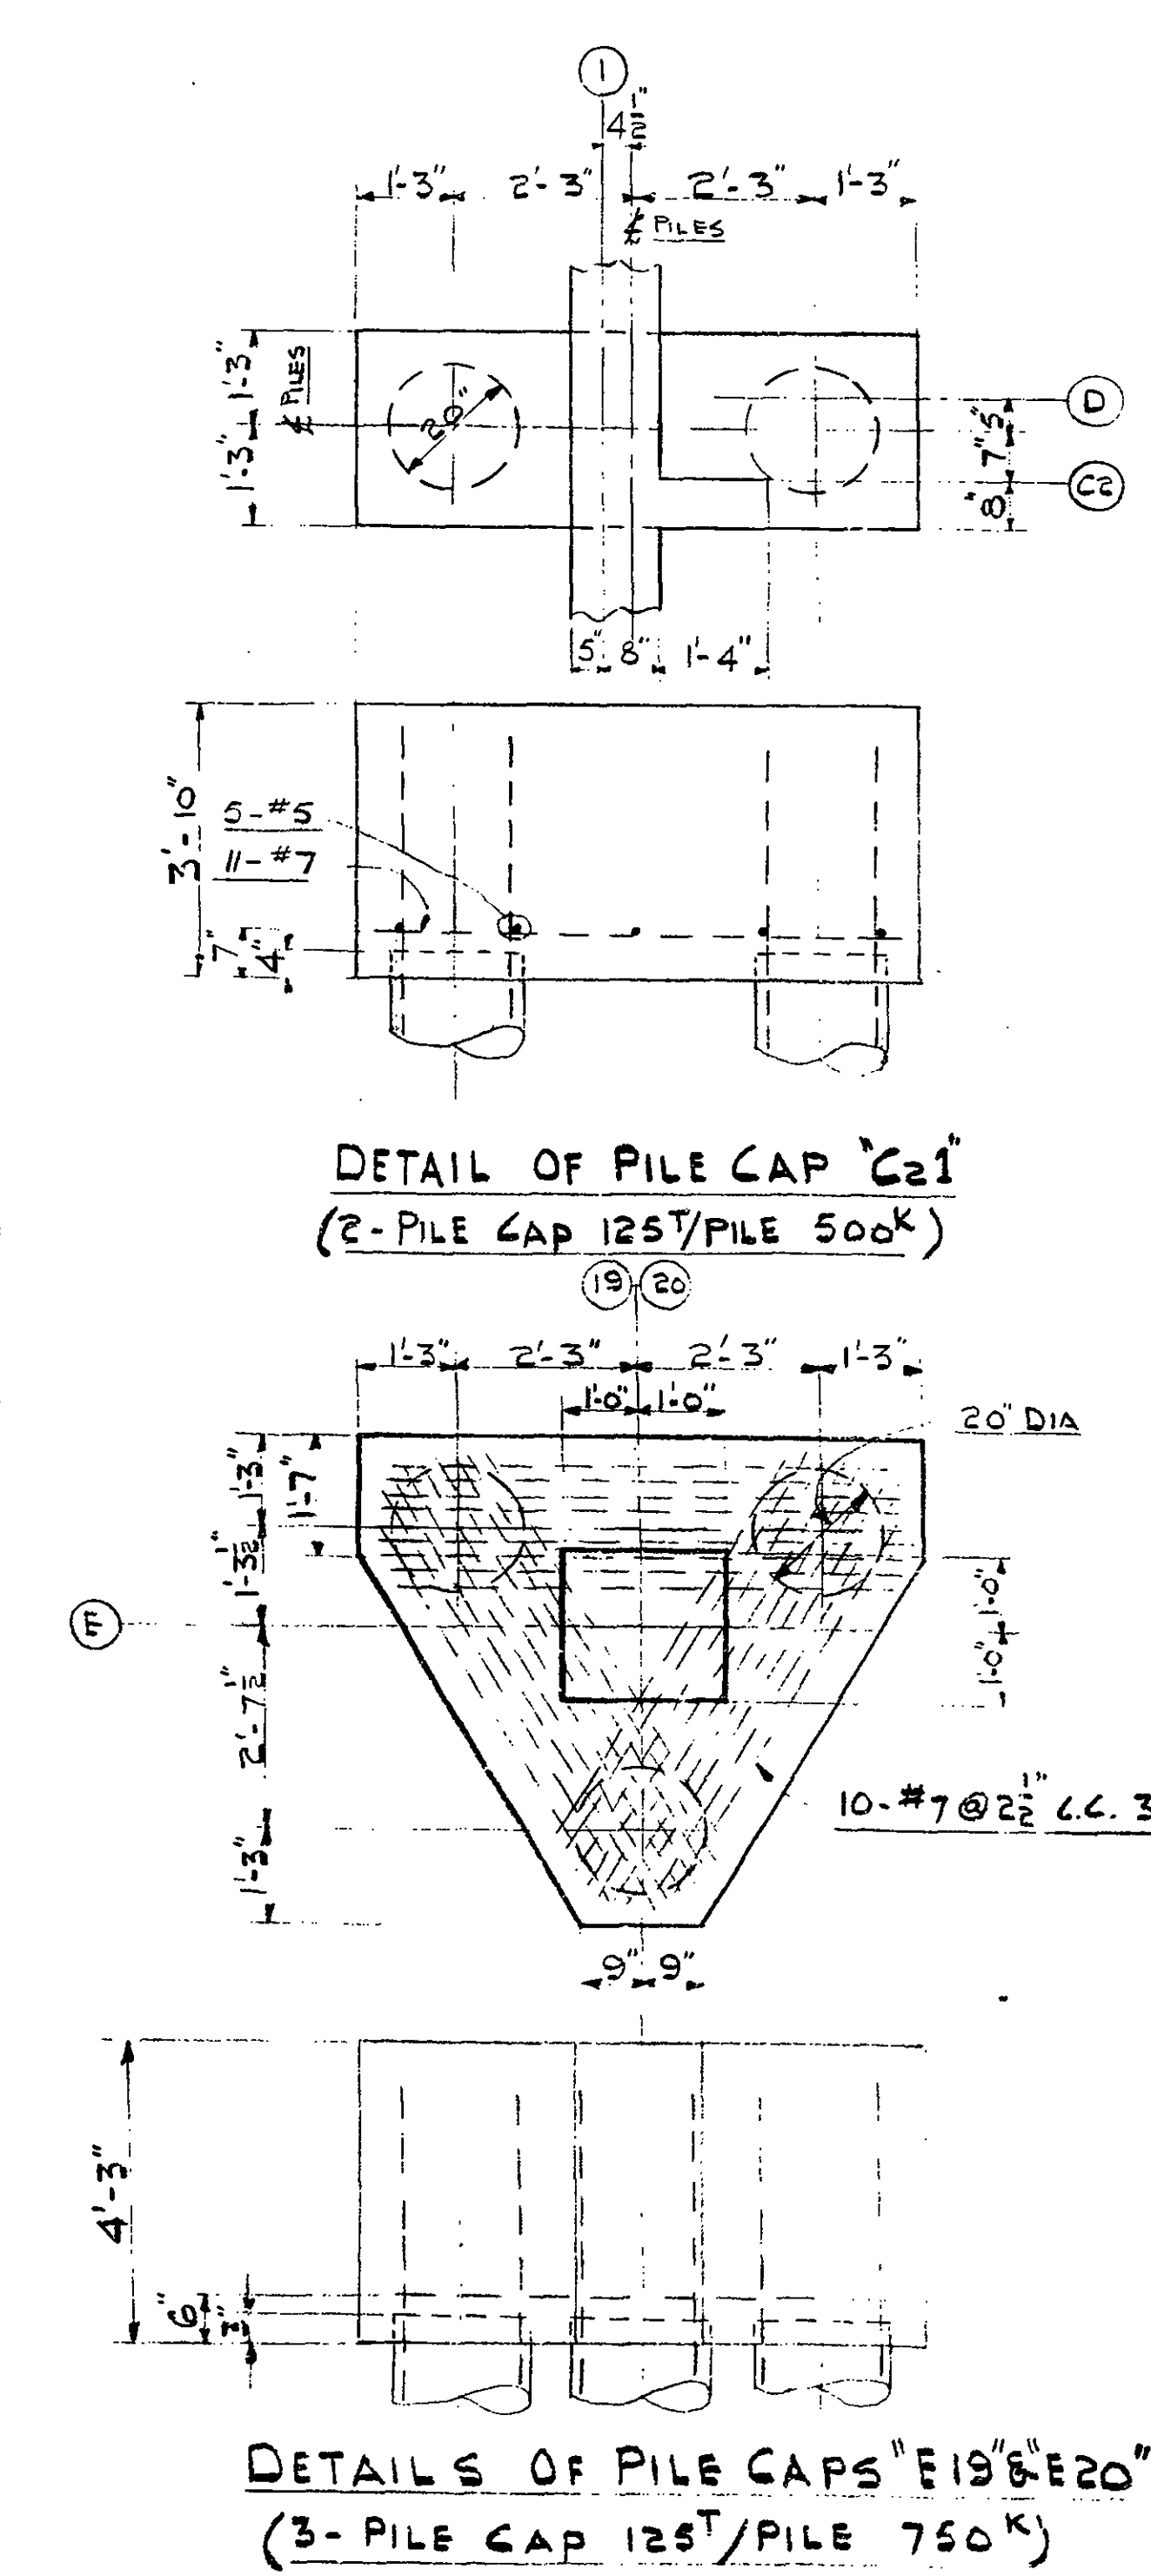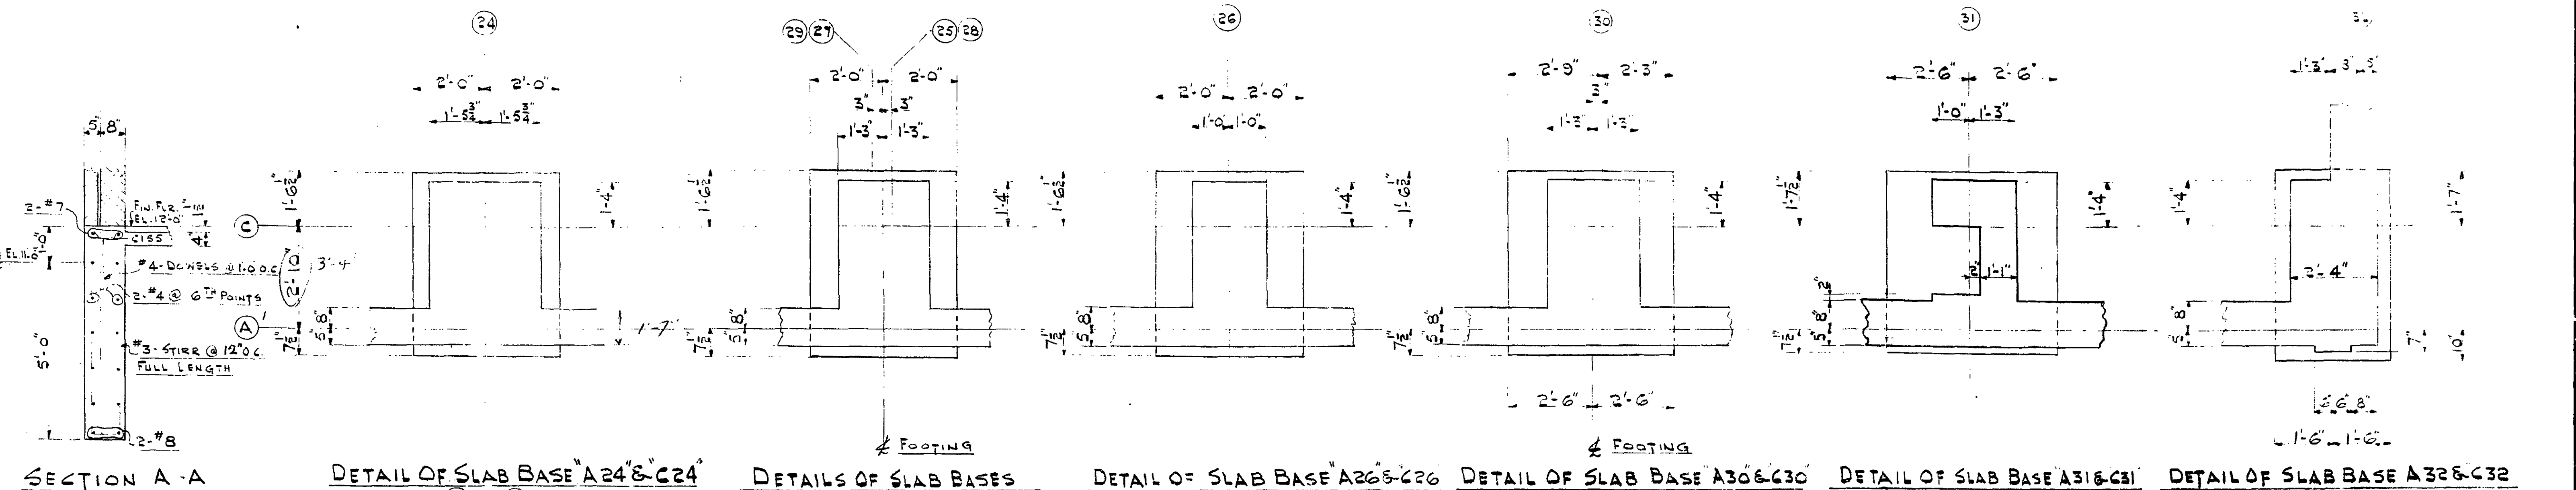

NOTE - READ THIS DRAWING IN CONJUNCTION WITH DWG. NO. 51


REVISIONS		DEPARTMENT OF PUBLIC WORKS OF CANADA	
DATE	RECORD	BUILDING CONSTRUCTION BRANCH	E. A. GARDNER CHIEF ARCHITECT
		SAINT JOHN'S NFED	
		SHOPS STORES & ADMINISTRATION BLDG. (D.O.T.)	
		DETAILS OF PILE CAPS & SLAB FOOTINGS	
DRAWN BY J. A. G. 1/2/62	CHECKED BY R. P. 1/2/62	APPROVED BY W. B. 1/2/62	SCALE: 3/8" = 1'-0"
DATE: 1/2/62	DATE: 1/2/62	DATE: 1/2/62	JOB NO. CA 61-1-13/24
			OF 22

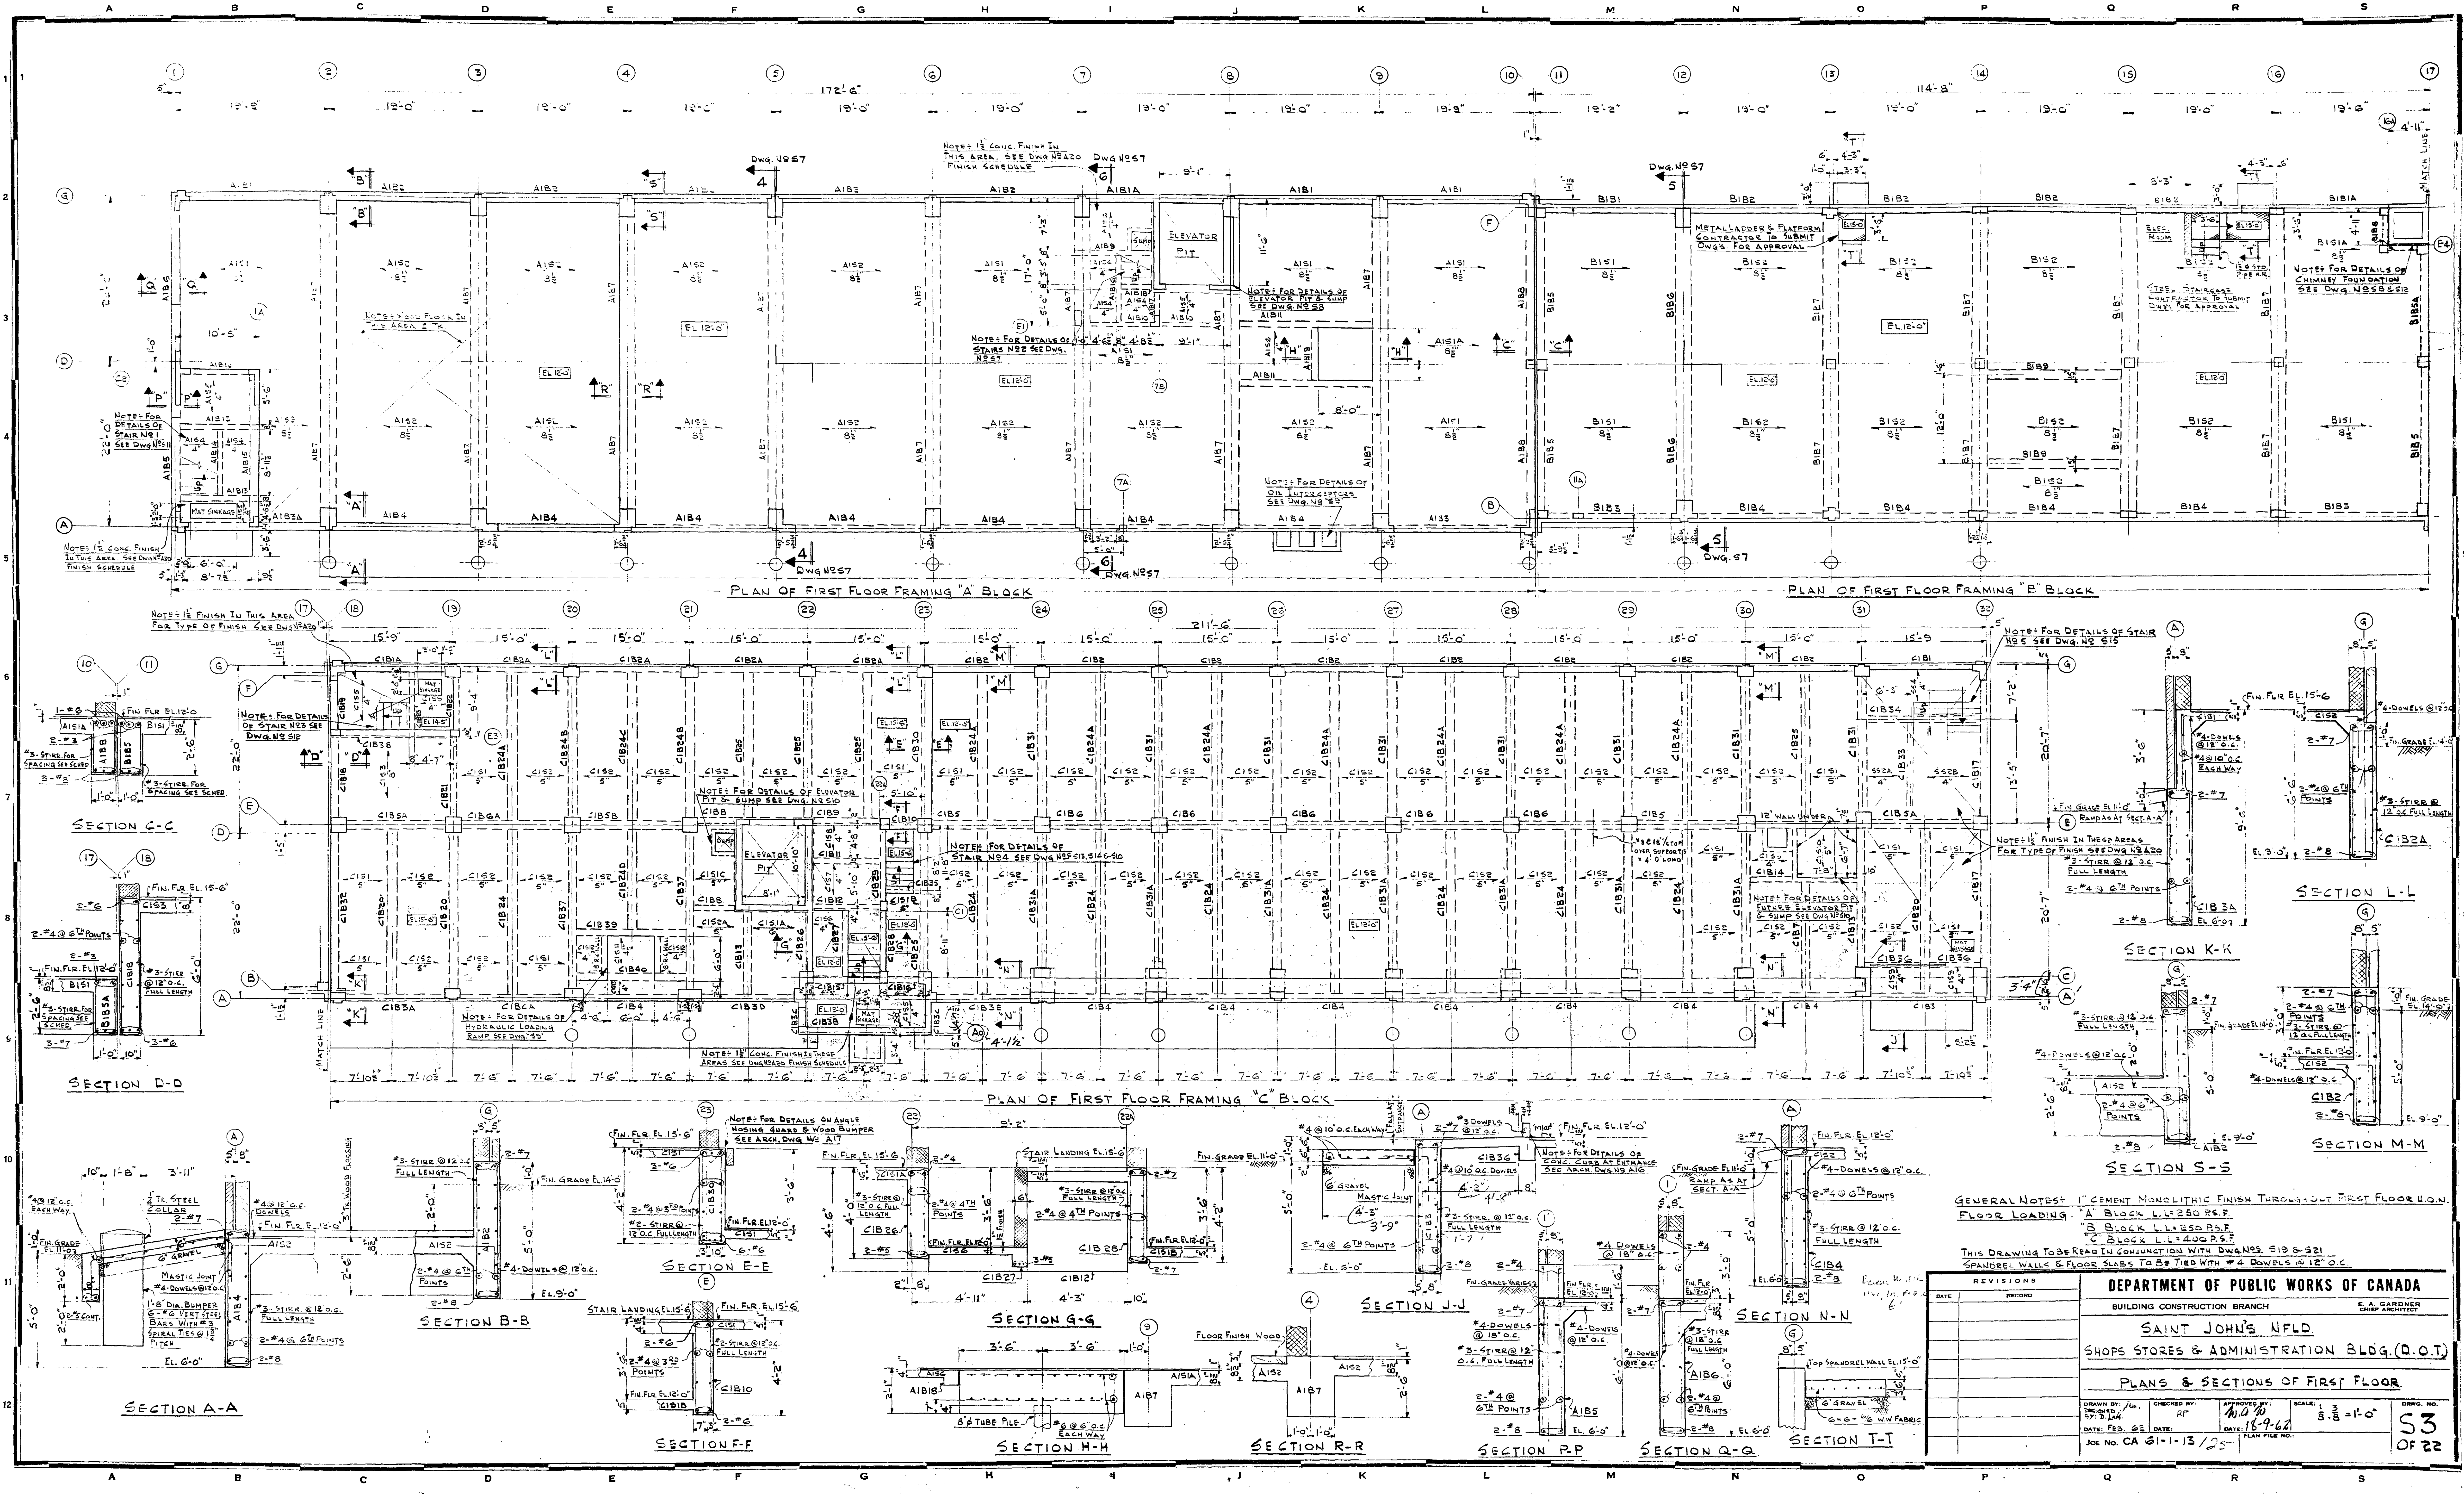

GENERAL NOTES: 1" CEMENT MONOLITHIC FINISH THROUGHOUT FIRST FLOOR U.O.N.
FLOOR LOADING: A BLOCK L.L. 250 R.S.F.
B BLOCK L.L. 250 R.S.F.
C BLOCK L.L. 400 R.S.F.
THIS DRAWING TO BE READ IN CONJUNCTION WITH DWG. NOS. 519 & 521.
SPANDREL WALLS & FLOOR SLABS TO BE TIED WITH #4 DOWELS @ 12" O.C.

REVISIONS	
DATE	RECORD

DEPARTMENT OF PUBLIC WORKS OF CANADA			
BUILDING CONSTRUCTION BRANCH			
E.A. GARDNER CHIEF ARCHITECT			
SAINT JOHN'S N.F.L.D.			
SHOPS STORES & ADMINISTRATION BLDG. (D.O.T.)			
PLANS & SECTIONS OF FIRST FLOOR			
DRAWN BY: J.A.	CHECKED BY: R.T.	APPROVED BY: H.A.P.	SCALE: 1/8" = 1'-0"
DATE: FEB. 66	DATE:	DATE: 10-9-66	DWG. NO. S3
JOE NO. CA 31-1-13	1/25	PLAN FILE NO.	OF 22

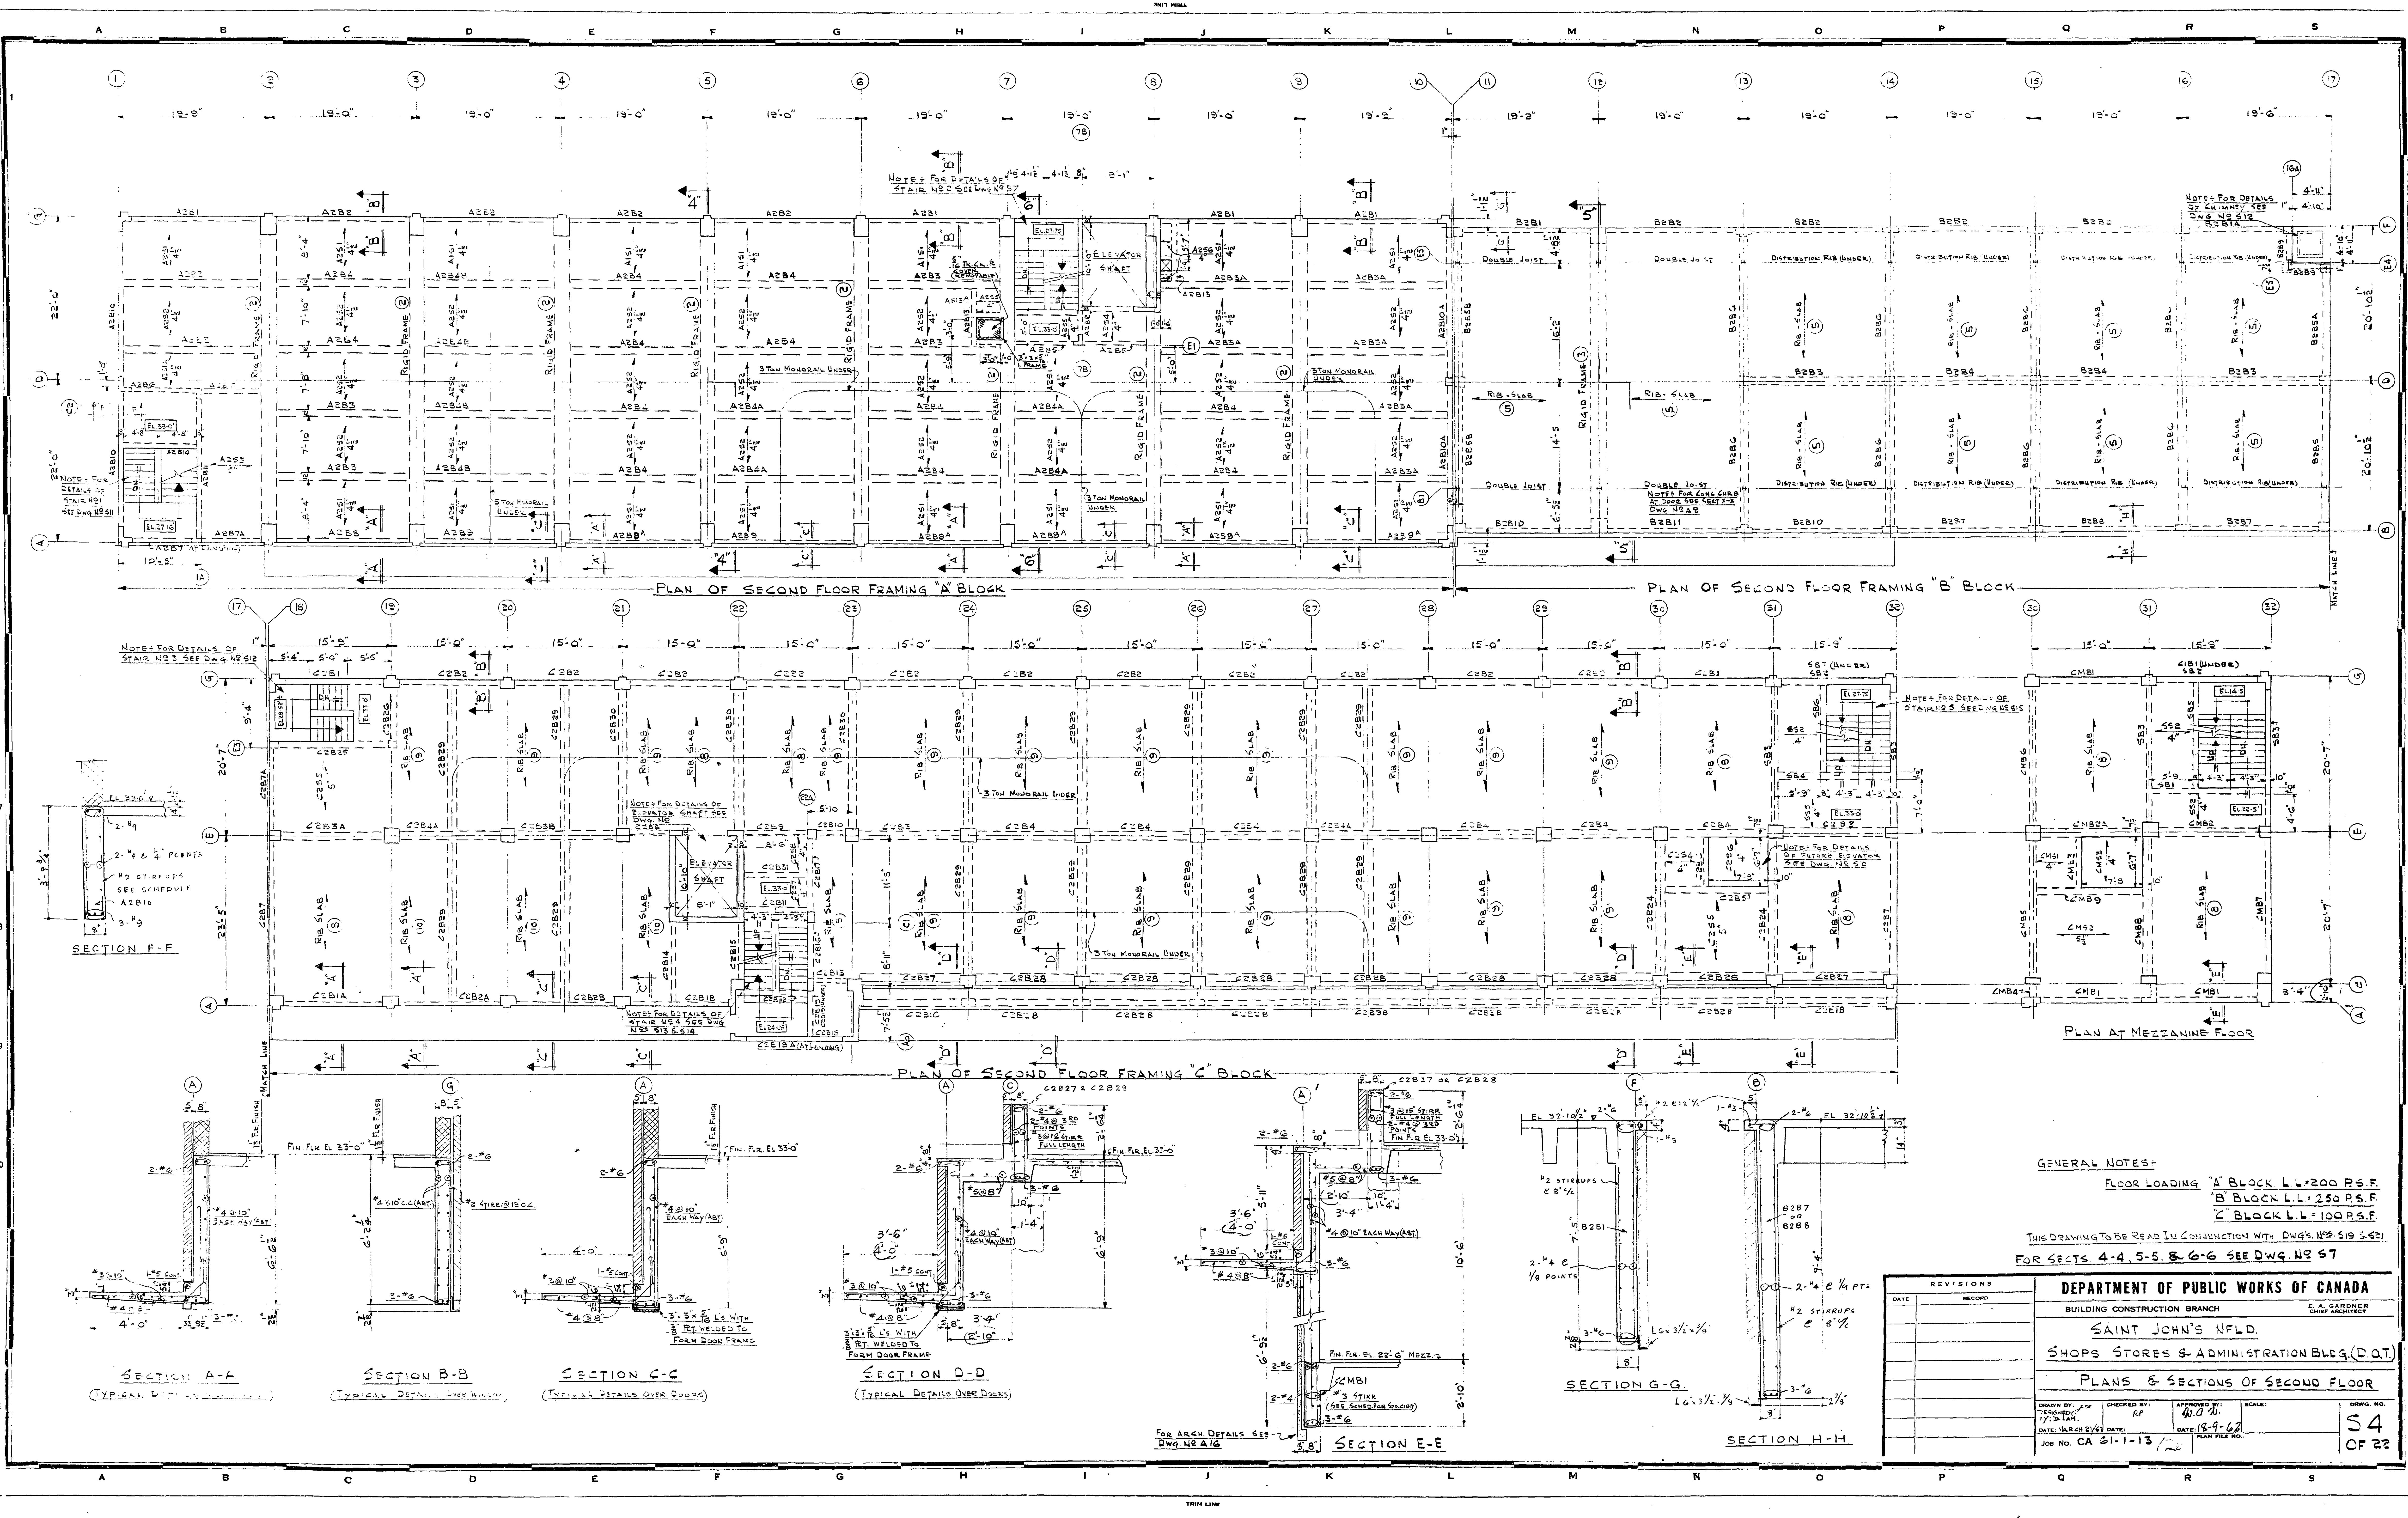

GENERAL NOTES:
FLOOR LOADING "A" BLOCK L.L. 200 P.S.F.
"B" BLOCK L.L. 250 P.S.F.
"C" BLOCK L.L. 100 P.S.F.
THIS DRAWING TO BE READ IN CONJUNCTION WITH DWG. NO. 519 5-521
FOR SECT. 4-4, 5-5, 6-6 SEE DWG. NO. 57

REVISIONS		RECORD	
DATE	BY	DATE	BY

DEPARTMENT OF PUBLIC WORKS OF CANADA		E. A. GARDNER CHIEF ARCHITECT	
BUILDING CONSTRUCTION BRANCH		SAINT JOHN'S Nfld.	
SHOPS STORES & ADMINISTRATION BLDG. (D.O.T.)		PLANS & SECTIONS OF SECOND FLOOR	
DRAWN BY J. J. LAM DATE: MARCH 21/61	CHECKED BY R. P. DATE: 8-9-61	APPROVED BY H. J. H. DATE: 8-9-61	SCALE: 1/4" = 1'-0"
JOB NO. CA 21-1-13		DWG. NO. 54 OF 22	

GENERAL NOTES:

- FLOOR & ROOF LOADING: "A" BLOCK L.L. = 200 P.S.F.
- "B" BLOCK L.L. = 60 P.S.F.
- "C" BLOCK L.L. = 250 P.S.F.
- THIS DRAWING TO BE READ IN CONJUNCTION WITH DWG. NOS. S19, S20

REVISIONS

DATE	RECORD

DEPARTMENT OF PUBLIC WORKS OF CANADA

BUILDING CONSTRUCTION BRANCH

SAINT JOHN'S Nfld.

SHOPS, STORES & ADMINISTRATION BLDG. (DOT)

PLANS & SECTIONS OF THIRD FLOOR & ROOF

DRAWN BY: J. L. M. CHECKED BY: J. L. M. DATE: 6-1-13

APPROVED BY: J. L. M. DATE: 6-1-13


SCALE: 1/4" = 1'-0"

DWG. NO. S19

OF 22

REVISIONS DATE RECORD		DEPARTMENT OF PUBLIC WORKS OF CANADA BUILDING CONSTRUCTION BRANCH E. A. GARDNER CHIEF ARCHITECT			
		<u>SAINT JOHN'S NFLD.</u> <u>SHOPS STORES & ADMINISTRATION BLDG. (DOT)</u>			
		<u>PLANS & SECTIONS OF THIRD FLOOR & ROOF</u>			
		DRAWN BY: <i>JS</i> DESIGNED BY: D.L.M. DATE:	CHECKED BY: <i>RP</i> DATE:	APPROVED BY: <i>RP</i> DATE: <i>18.4.66</i> 27	SCALE: S.S OF 22
		JOB NO. CA 61-1-13			


CA-61-1-13/28

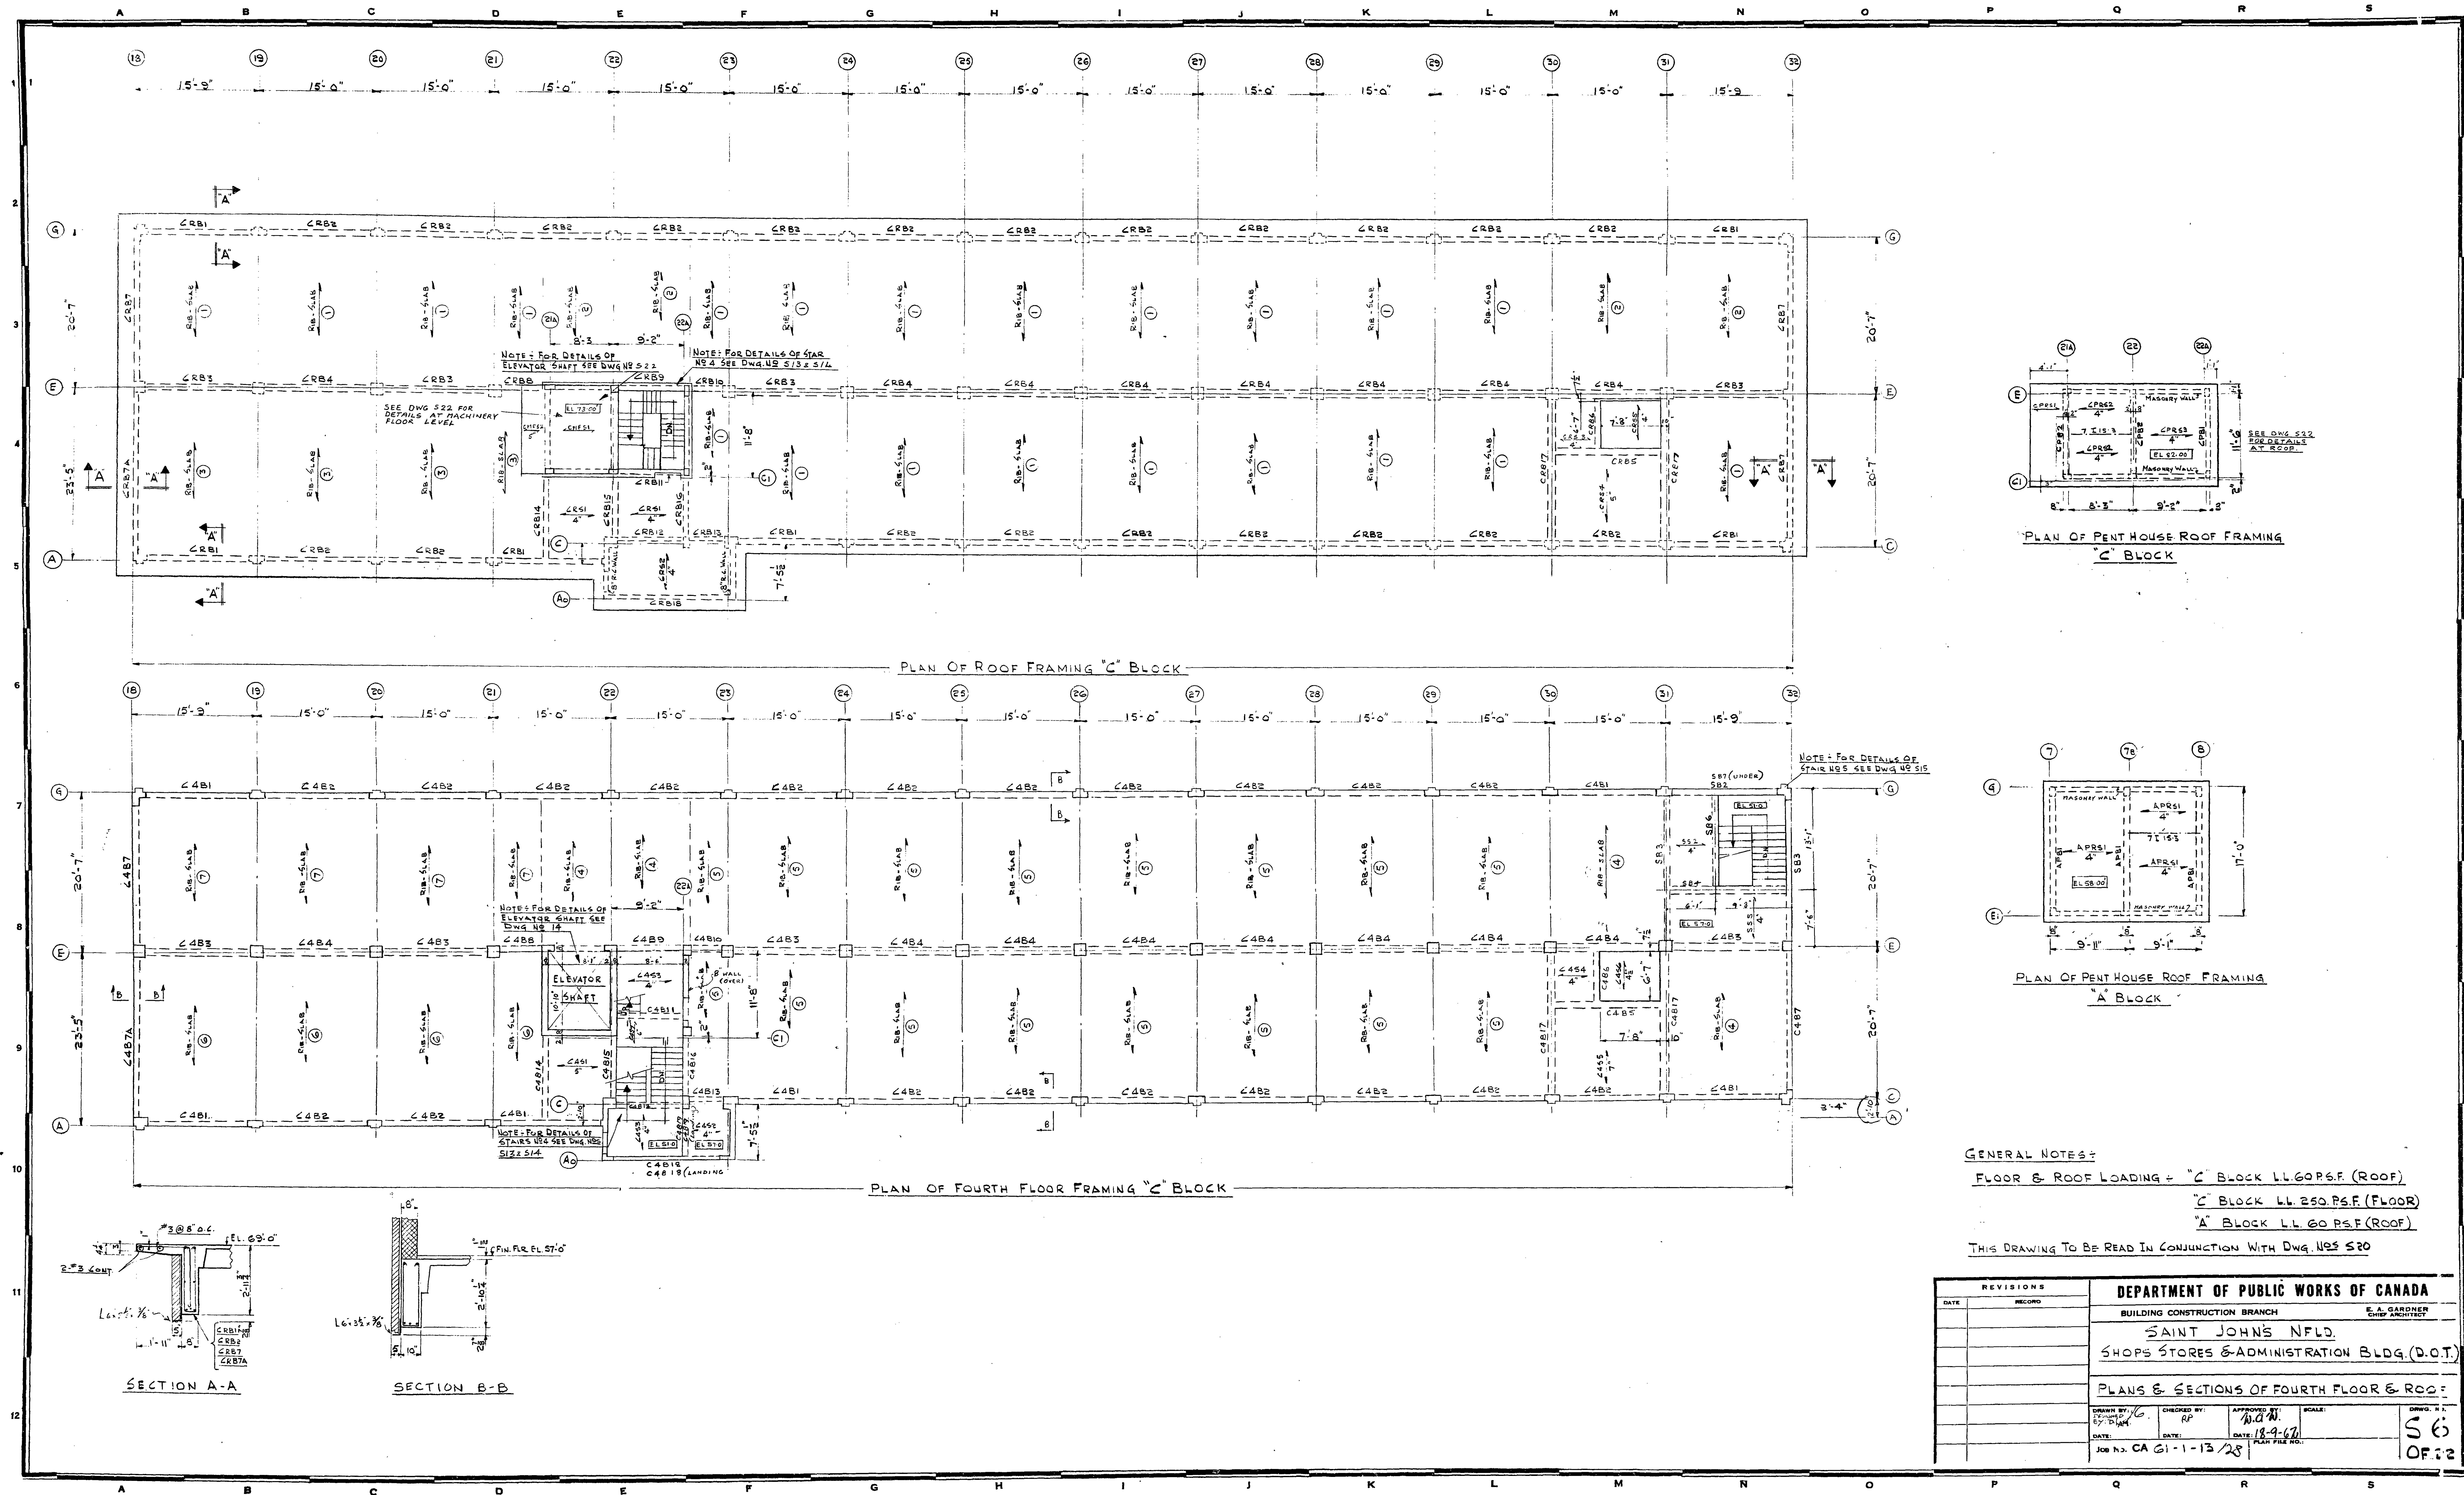


GENERAL NOTES:
FLOOR & ROOF LOADING - "C" BLOCK LL 60 P.S.F. (ROOF)
"C" BLOCK LL 250 P.S.F. (FLOOR)
"A" BLOCK LL 60 P.S.F. (ROOF)
THIS DRAWING TO BE READ IN CONJUNCTION WITH DWG. NOS S20

REVISIONS		DEPARTMENT OF PUBLIC WORKS OF CANADA			
DATE	RECORD	BUILDING CONSTRUCTION BRANCH		E. A. GARDNER CHIEF ARCHITECT	
		<u>SAINT JOHN'S N.F.L.D.</u>			
		<u>SHOPS STORES & ADMINISTRATION BLDG. (D.O.T.)</u>			
		<u>PLANS & SECTIONS OF FOURTH FLOOR & ROOF</u>			
DRAWN BY: J.C.		CHECKED BY: RP	APPROVED BY: E.A.G.	SCALE:	DWG. NO. S 6
DATE: 18-9-67		DATE: 18-9-67	DATE: 18-9-67	FILE NO.:	OF 2
JOB NO. CA 61-1-13/28					


G-CA-61-1-13/29

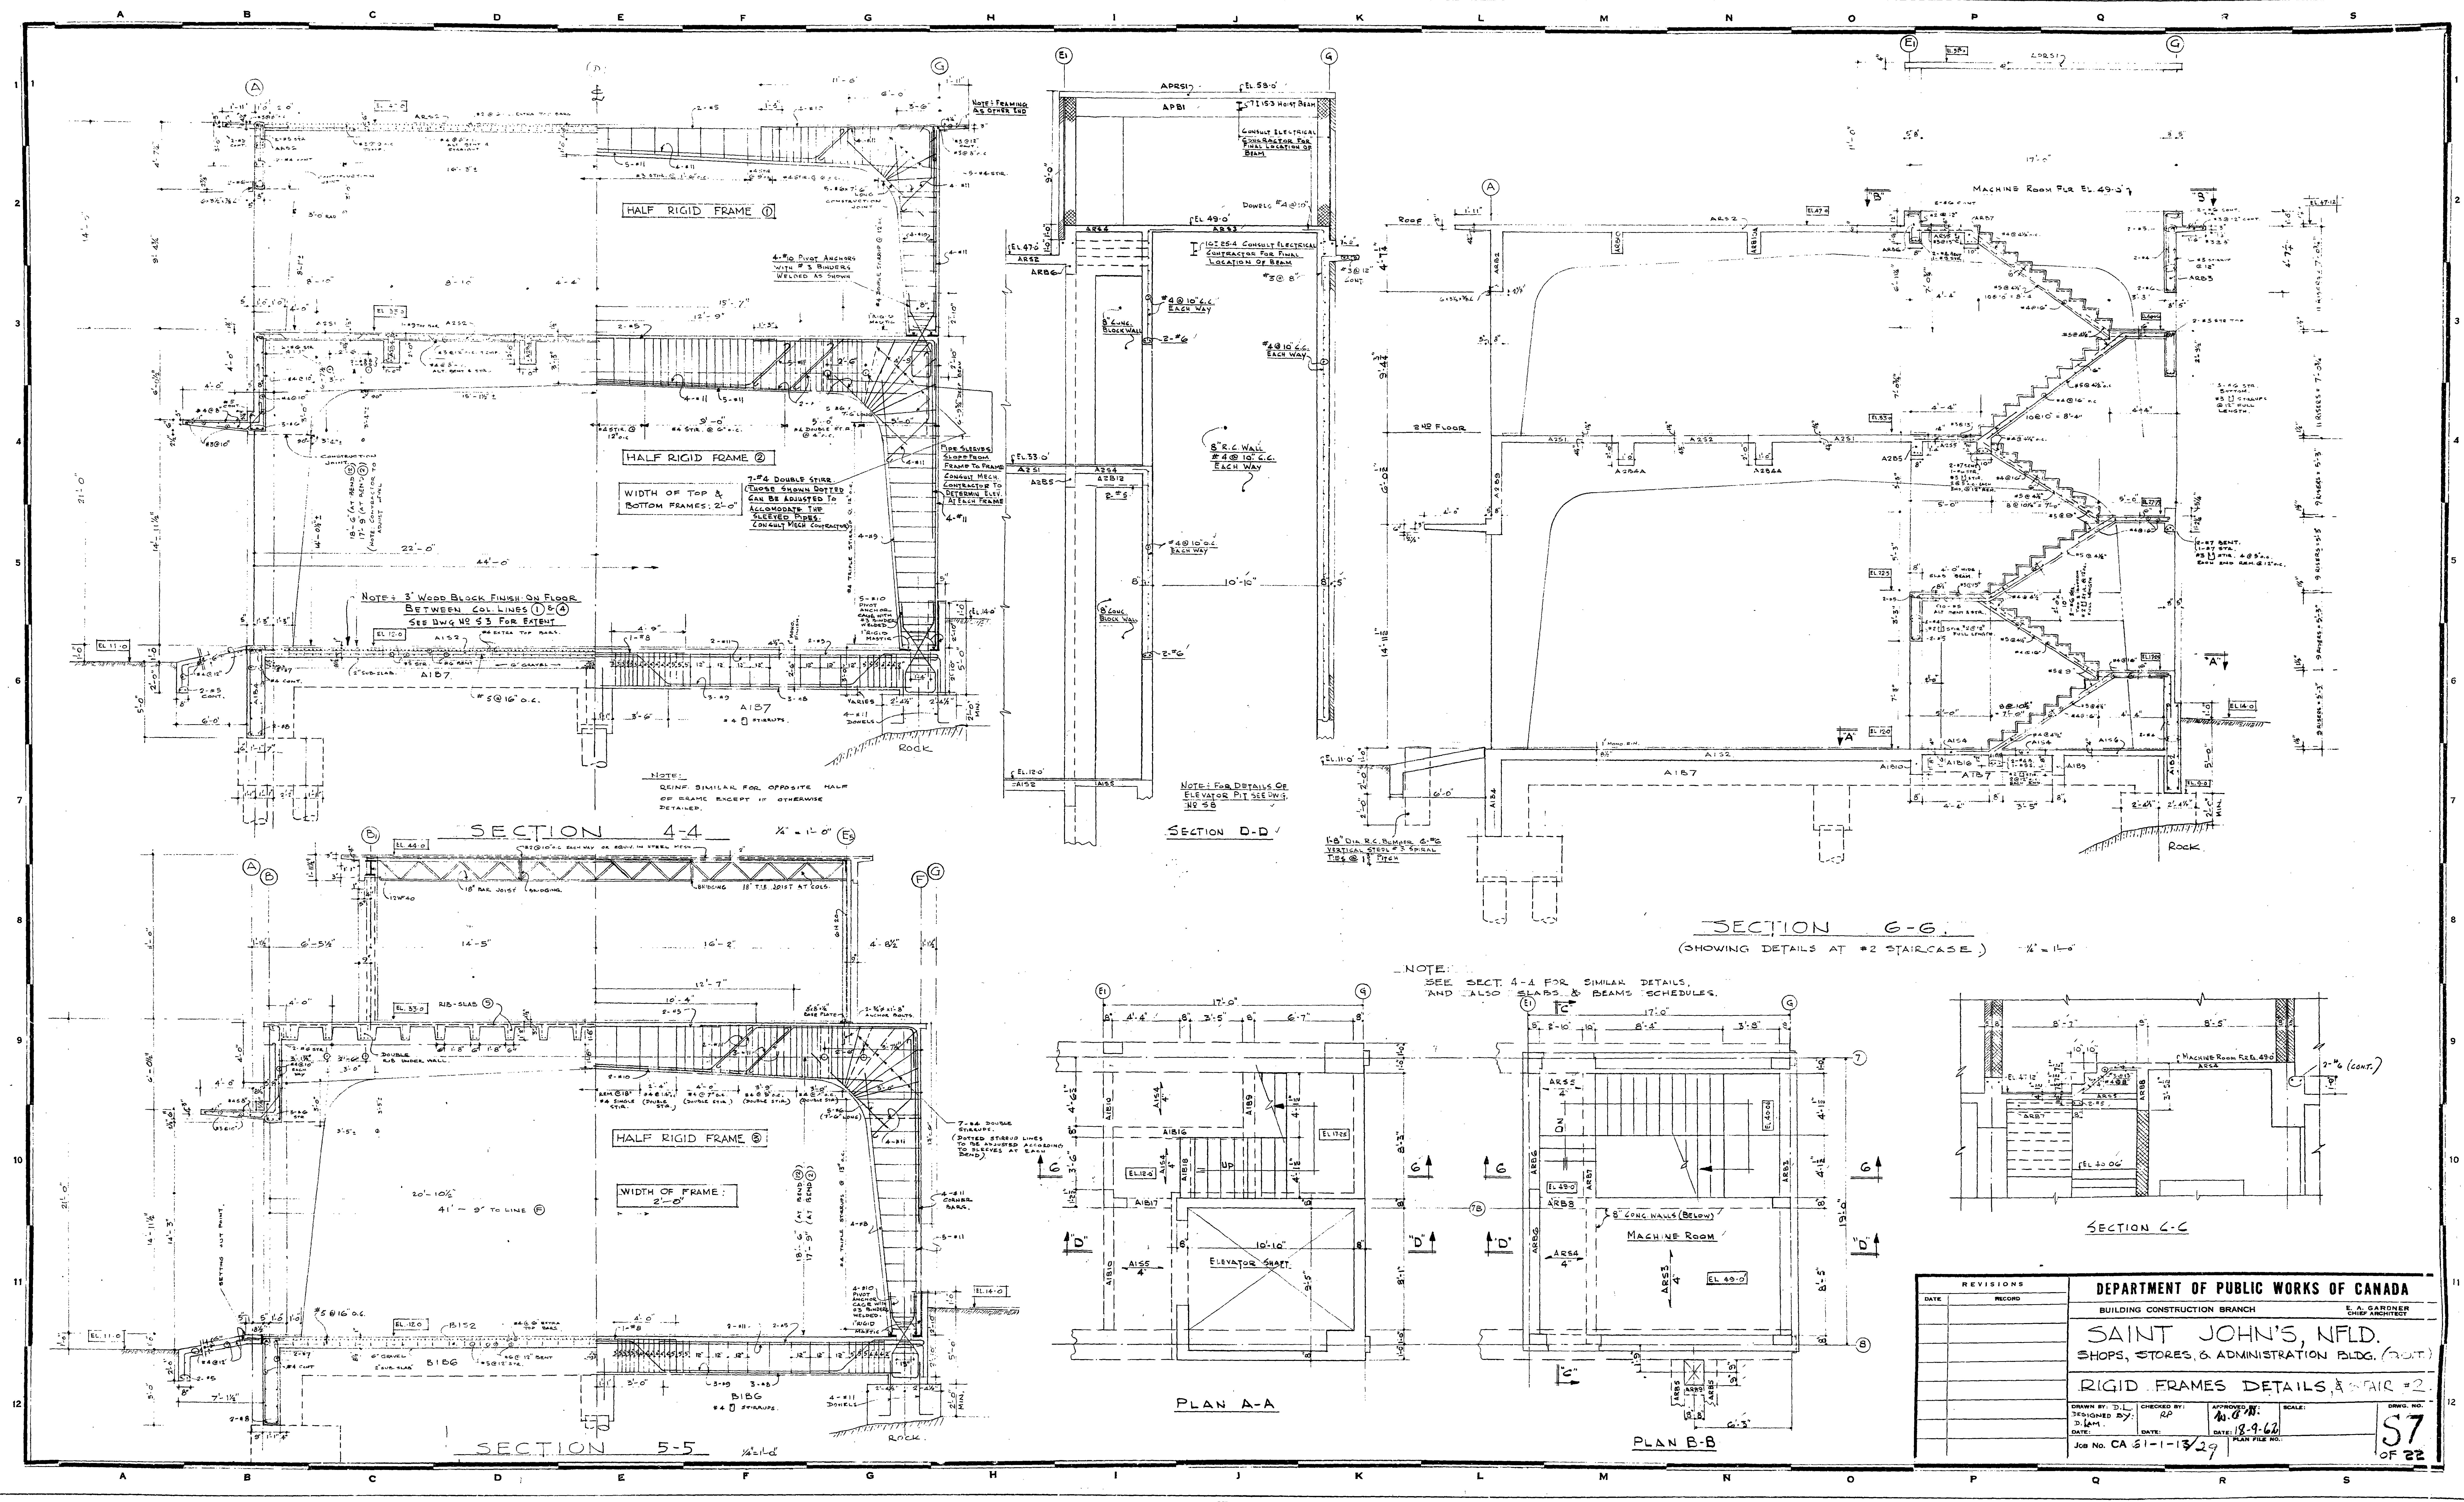

REVISIONS		DEPARTMENT OF PUBLIC WORKS OF CANADA	
DATE	RECORD	BUILDING CONSTRUCTION BRANCH	CHIEF ARCHITECT
		SAINT JOHN'S, Nfld.	
		SHOPS, STORES, & ADMINISTRATION BLDG. (R.O.I.)	
		RIGID FRAMES DETAILS, STAIR #2	
DRAWN BY: D.L.		CHECKED BY: RP	SCALE: 1/4" = 1'-0"
DESIGNED BY: D.L.		DATE: 12-9-62	DWG. NO. 57
DATE: 12-9-62		JOB NO. CA 51-1-13/29	PLAN FILE NO. 57 OF 22

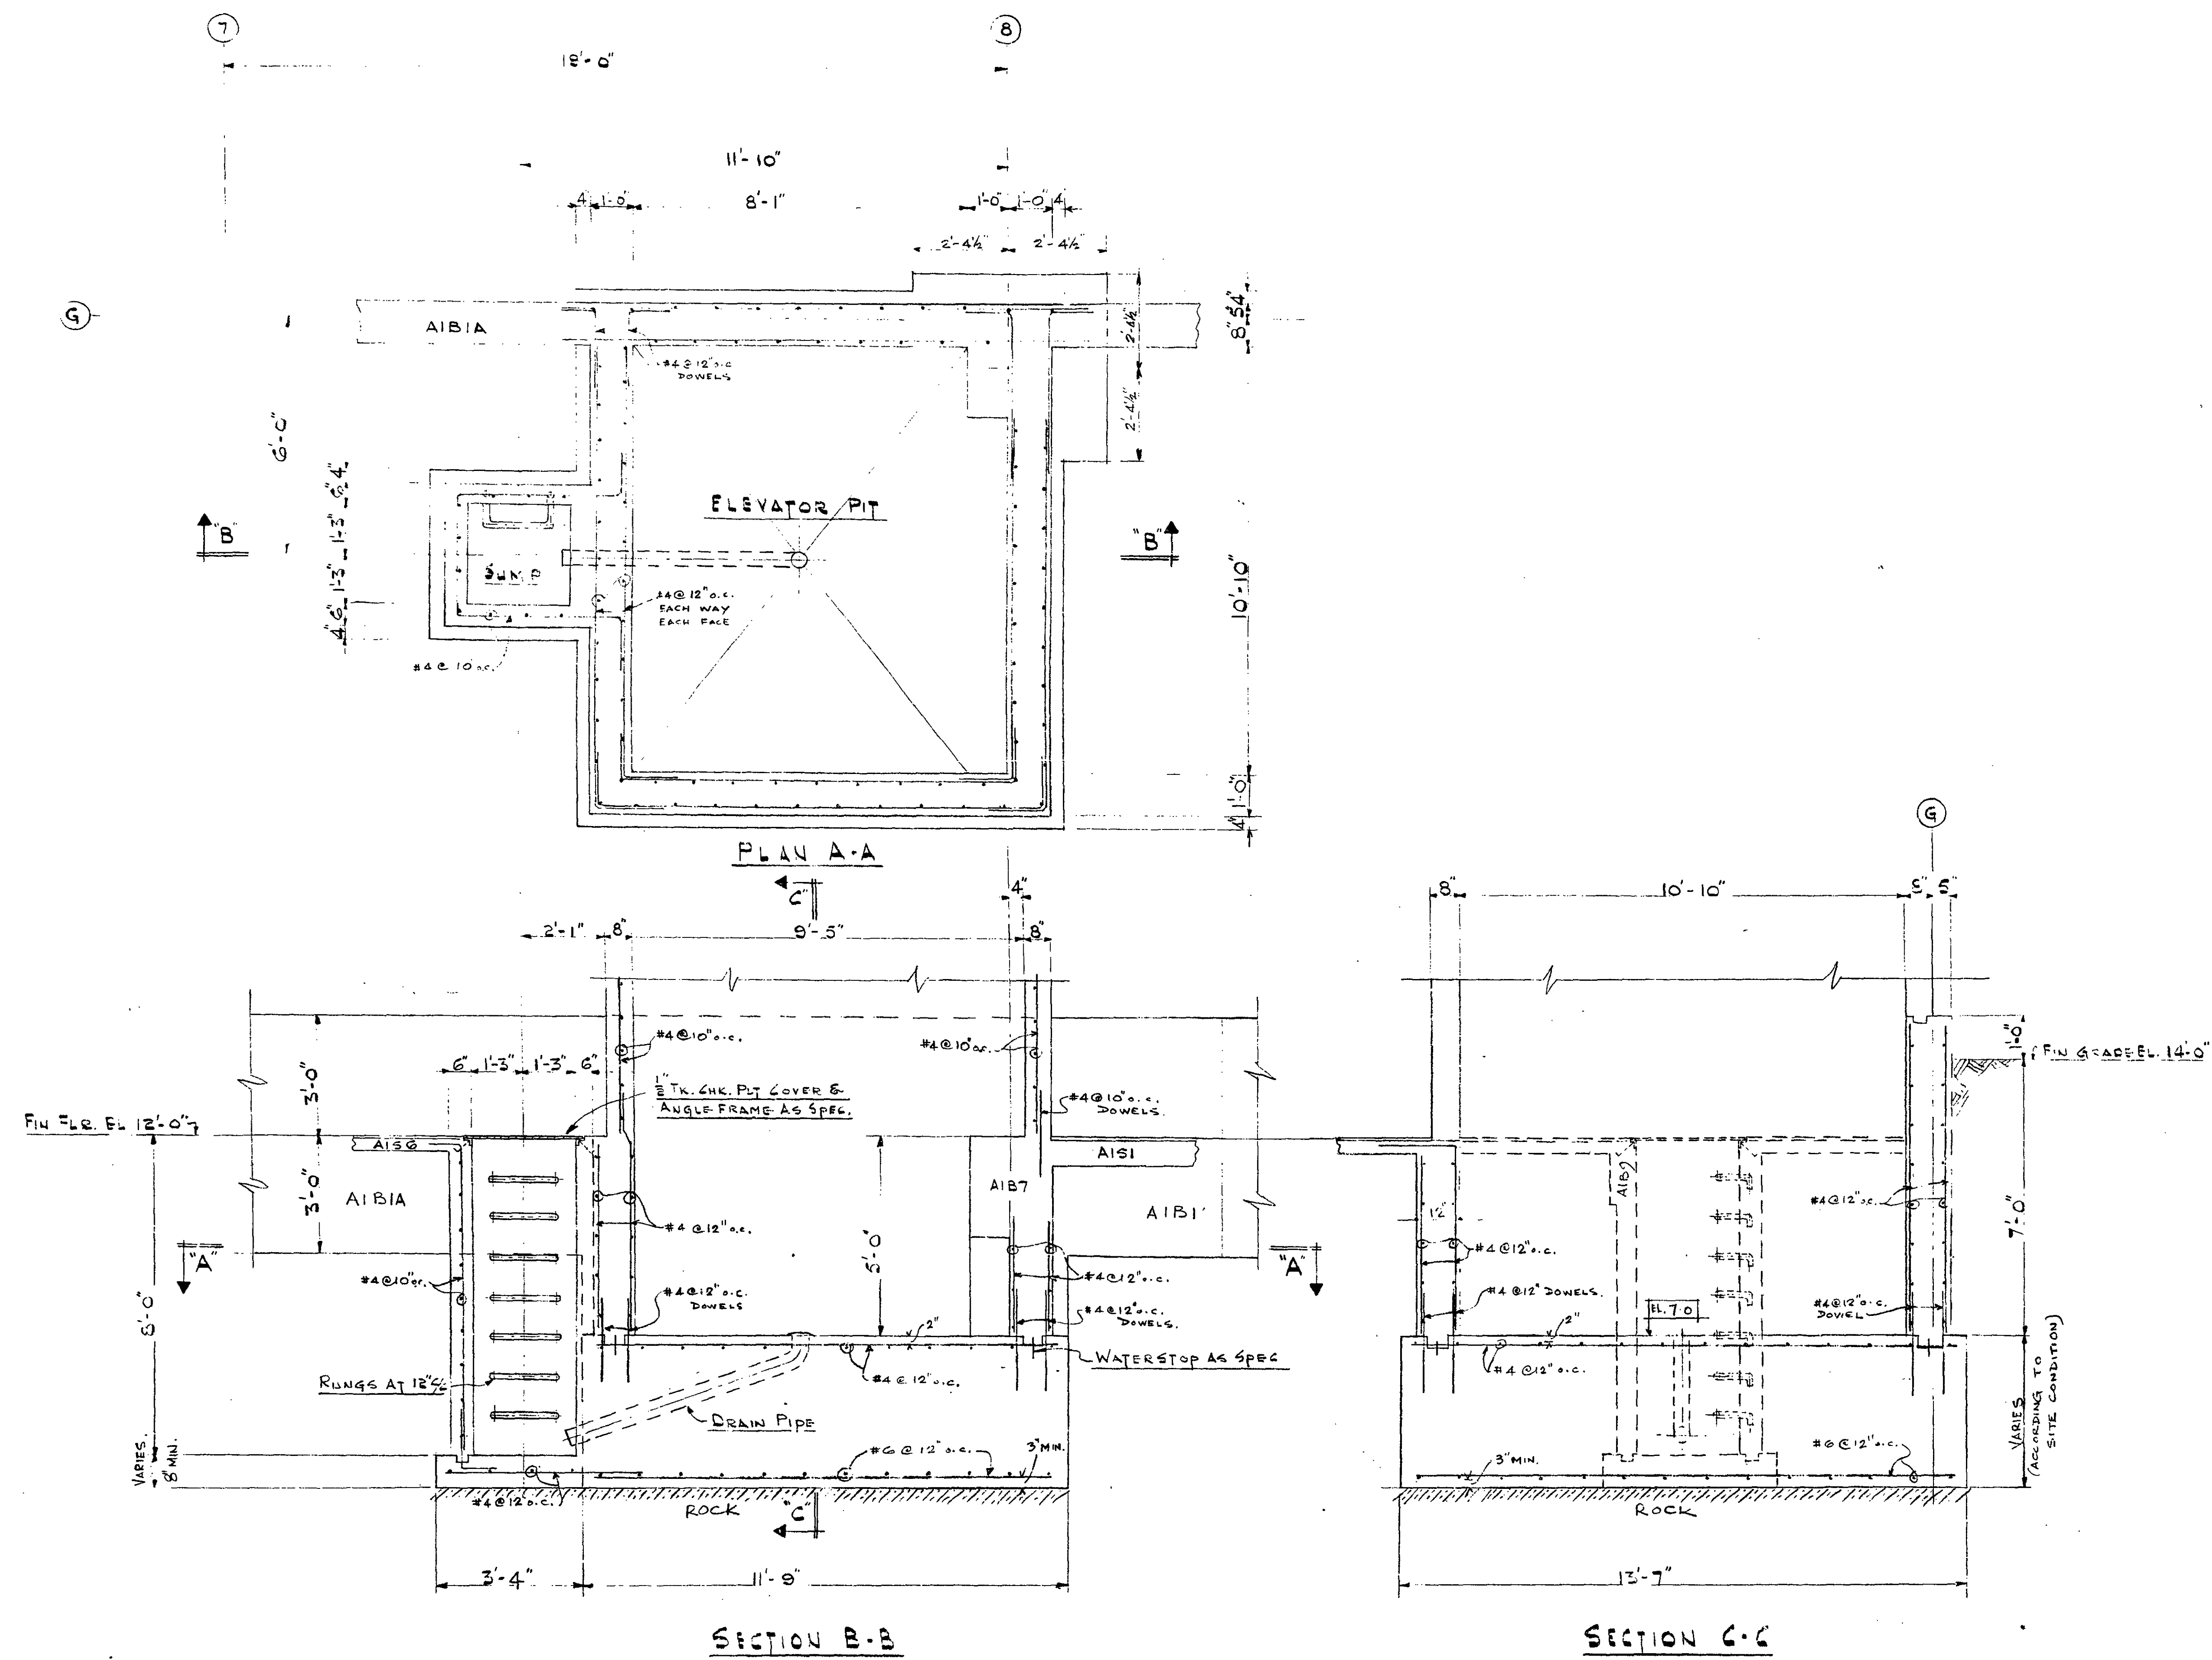

ARRANGEMENT OF FREIGHT ELEVATOR PIT

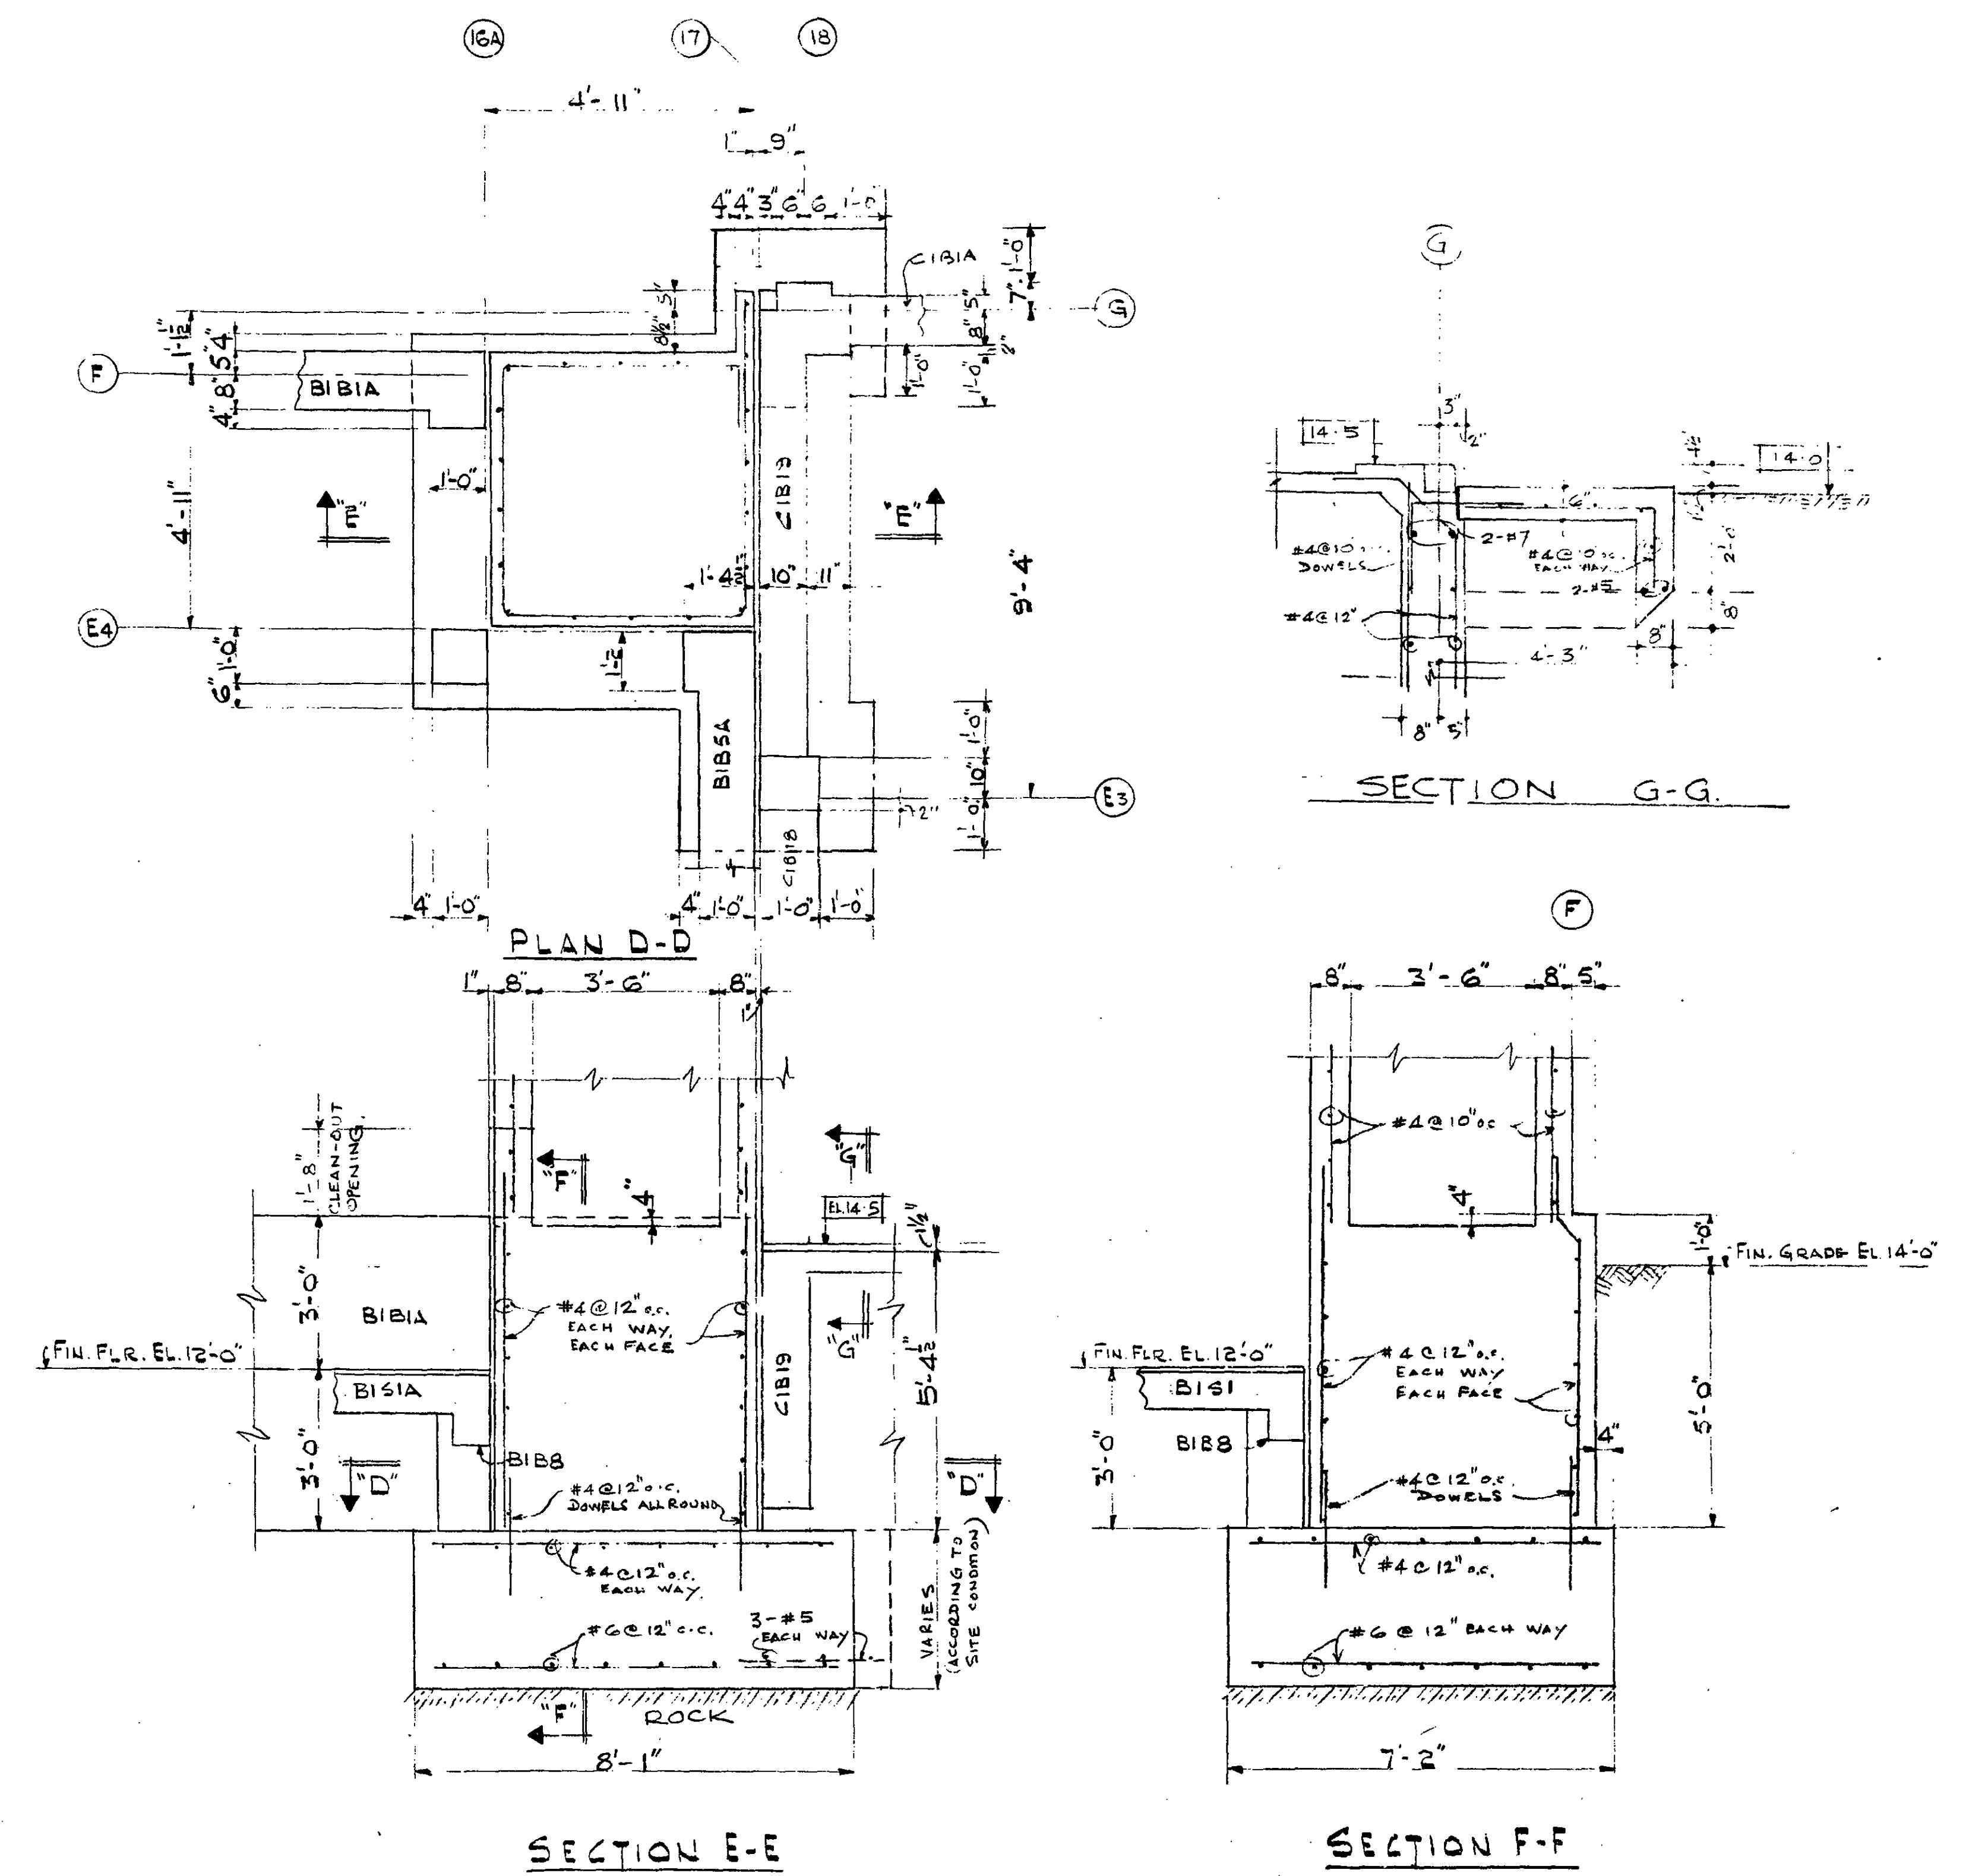


ARRANGEMENT OF CHIMNEY FOUNDATION



NOTE: SEE DRAWING #S-12 FOR FURTHER DETAILS OF CHIMNEY.

REVISIONS		DEPARTMENT OF PUBLIC WORKS OF CANADA			
DATE	RECORD	BUILDING CONSTRUCTION BRANCH		E. A. GARDNER CHIEF ARCHITECT	
		SAINT JOHN'S, Nfld.			
		SHOPS, STORES & ADMINISTRATION BLDG. (D.O.T.)			
		DETAILS OF FREIGHT ELEVATOR PIT & CHIMNEY FOUNDATION			
DRAWN BY: J.C.	CHECKED BY: R.P.	APPROVED BY: H.A.	SCALE: 3/8" = 1'-0"	D.W.G. NO. 58	
DATE: 1/24/68	DATE: 1/24/68	DATE: 1/24/68	DATE: 1/24/68	OF 22	
JOB NO. CA 61-1-13/30		PLAN FILE NO.			



G-CA-61-1-13/31

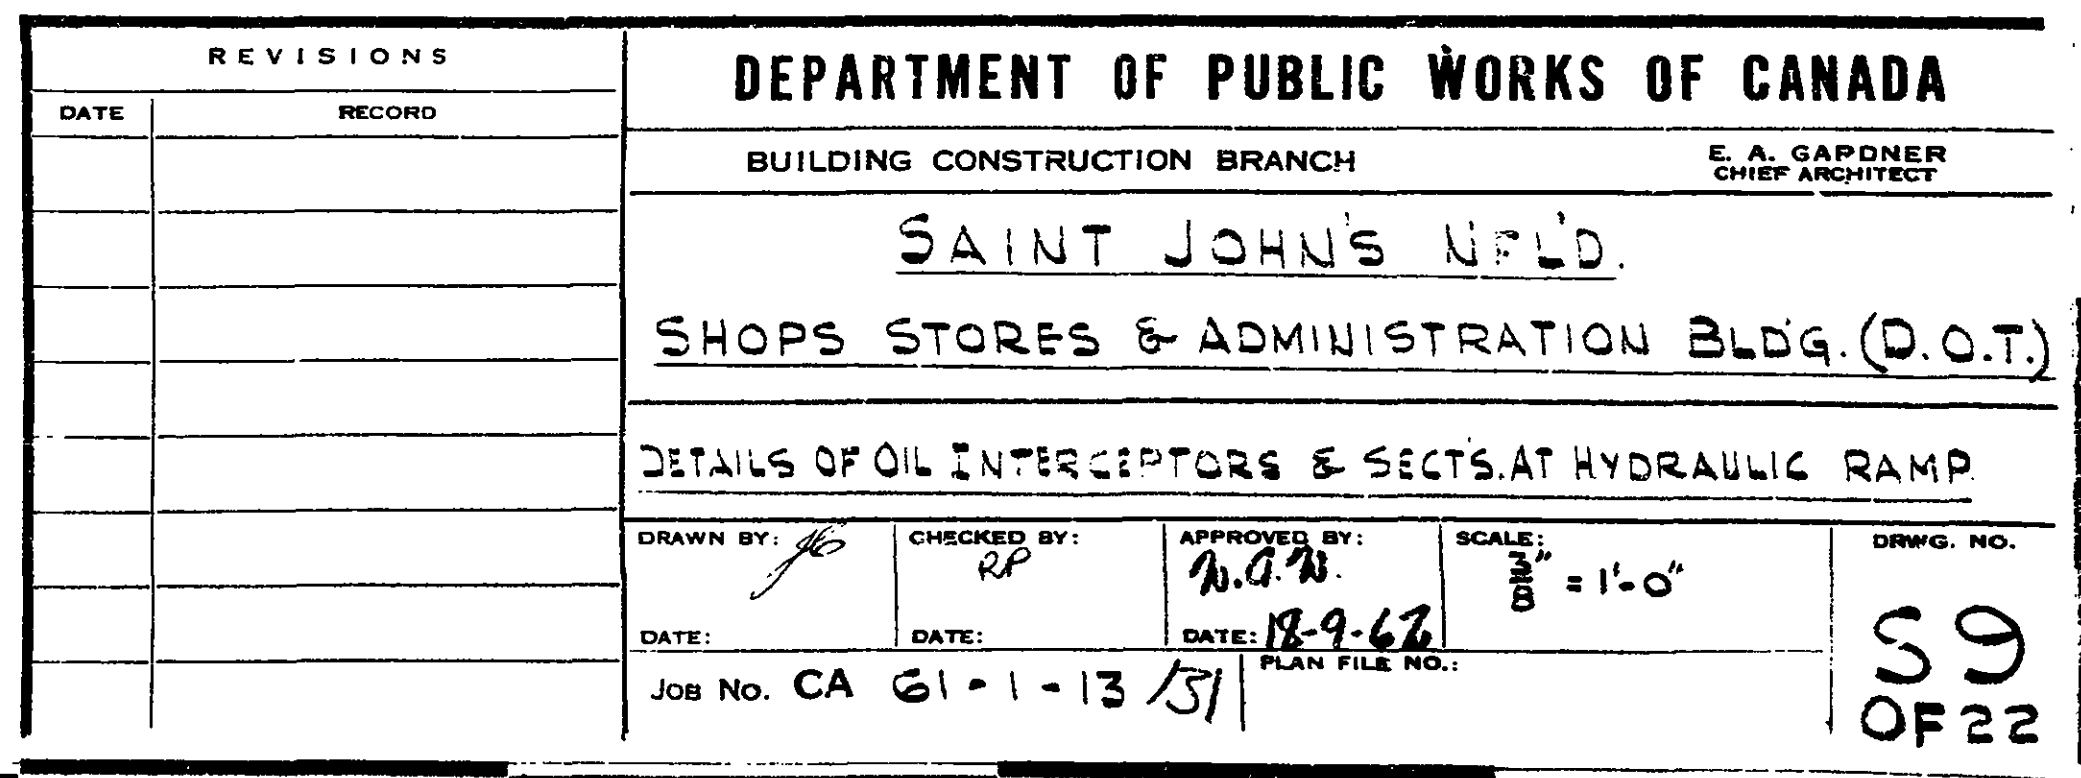

G-CA-61-1-13/32 MICROFILMED

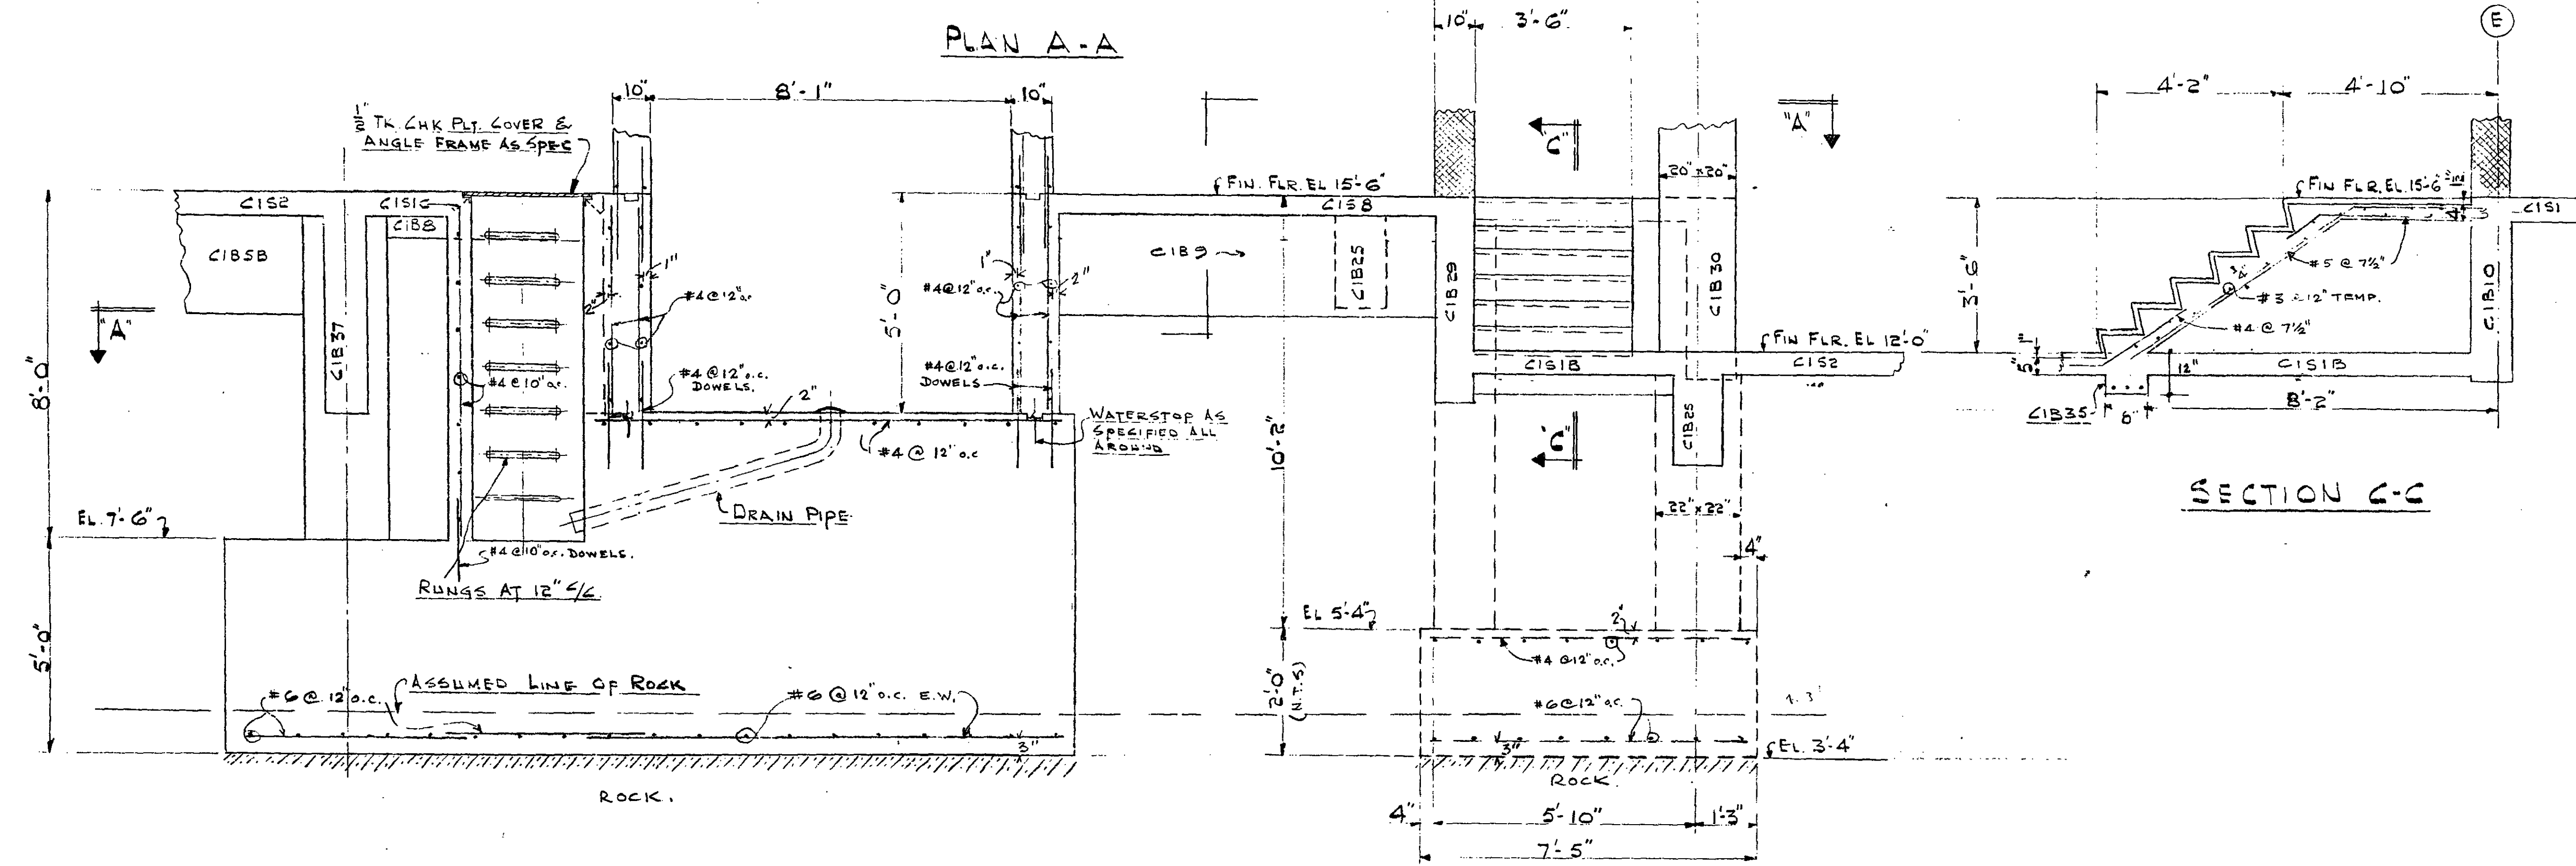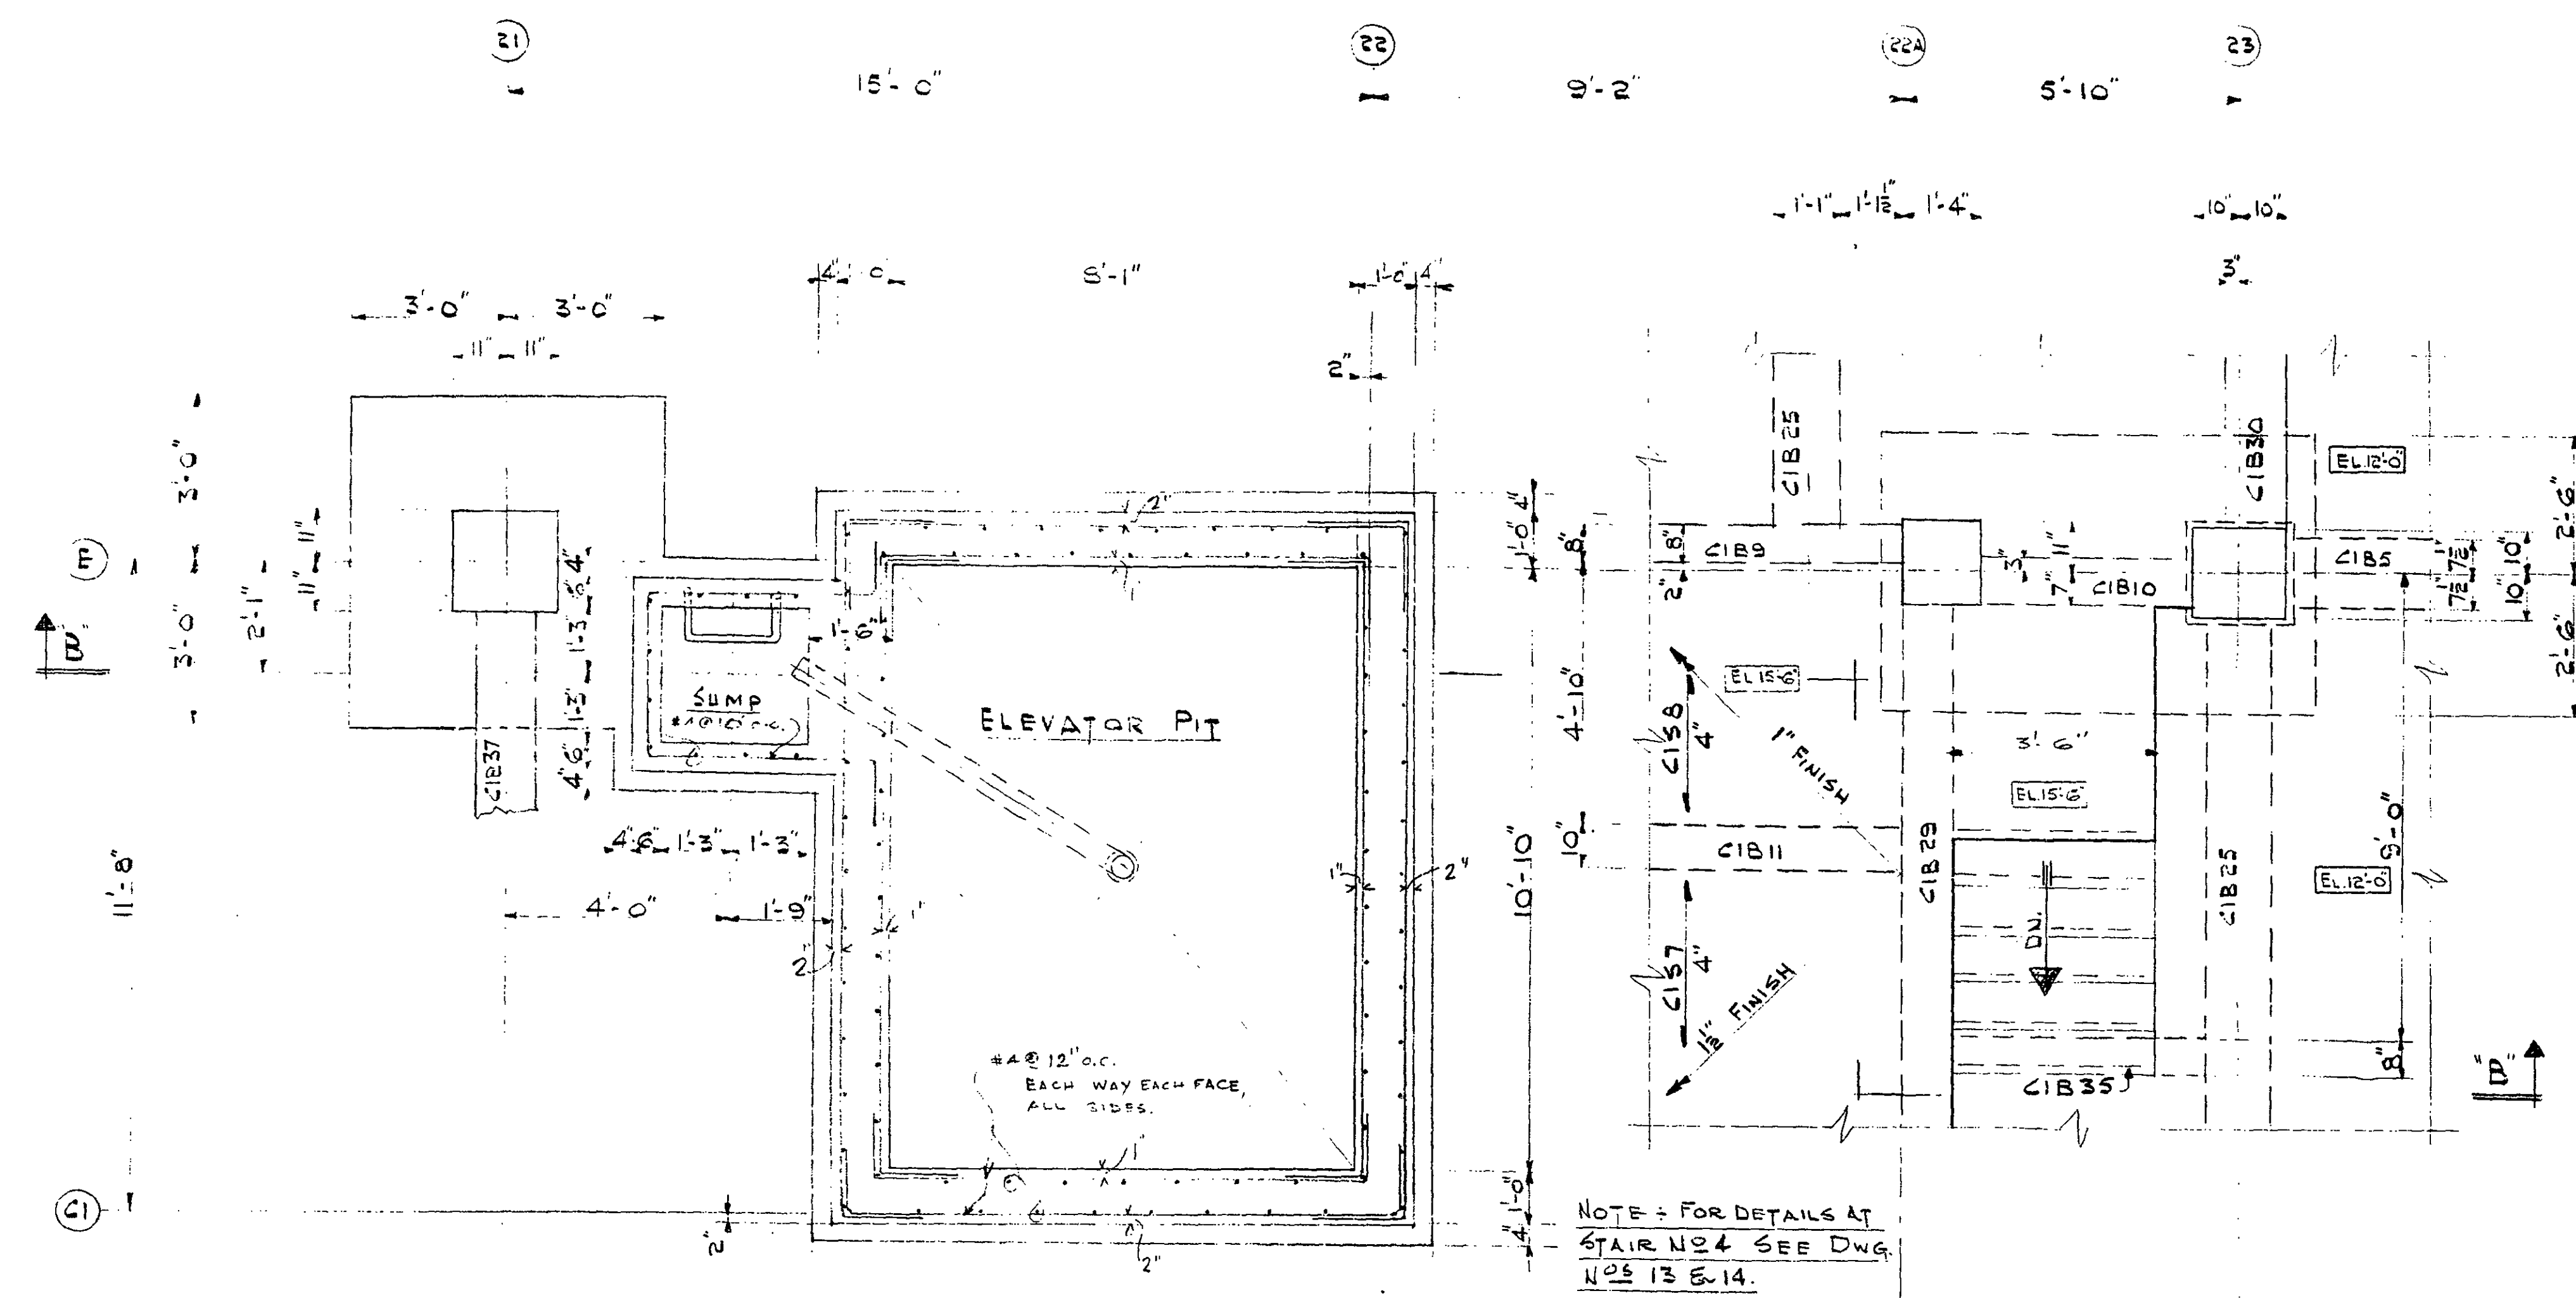

SECTION B-B
ARRANGEMENT OF ELEVATOR PIT

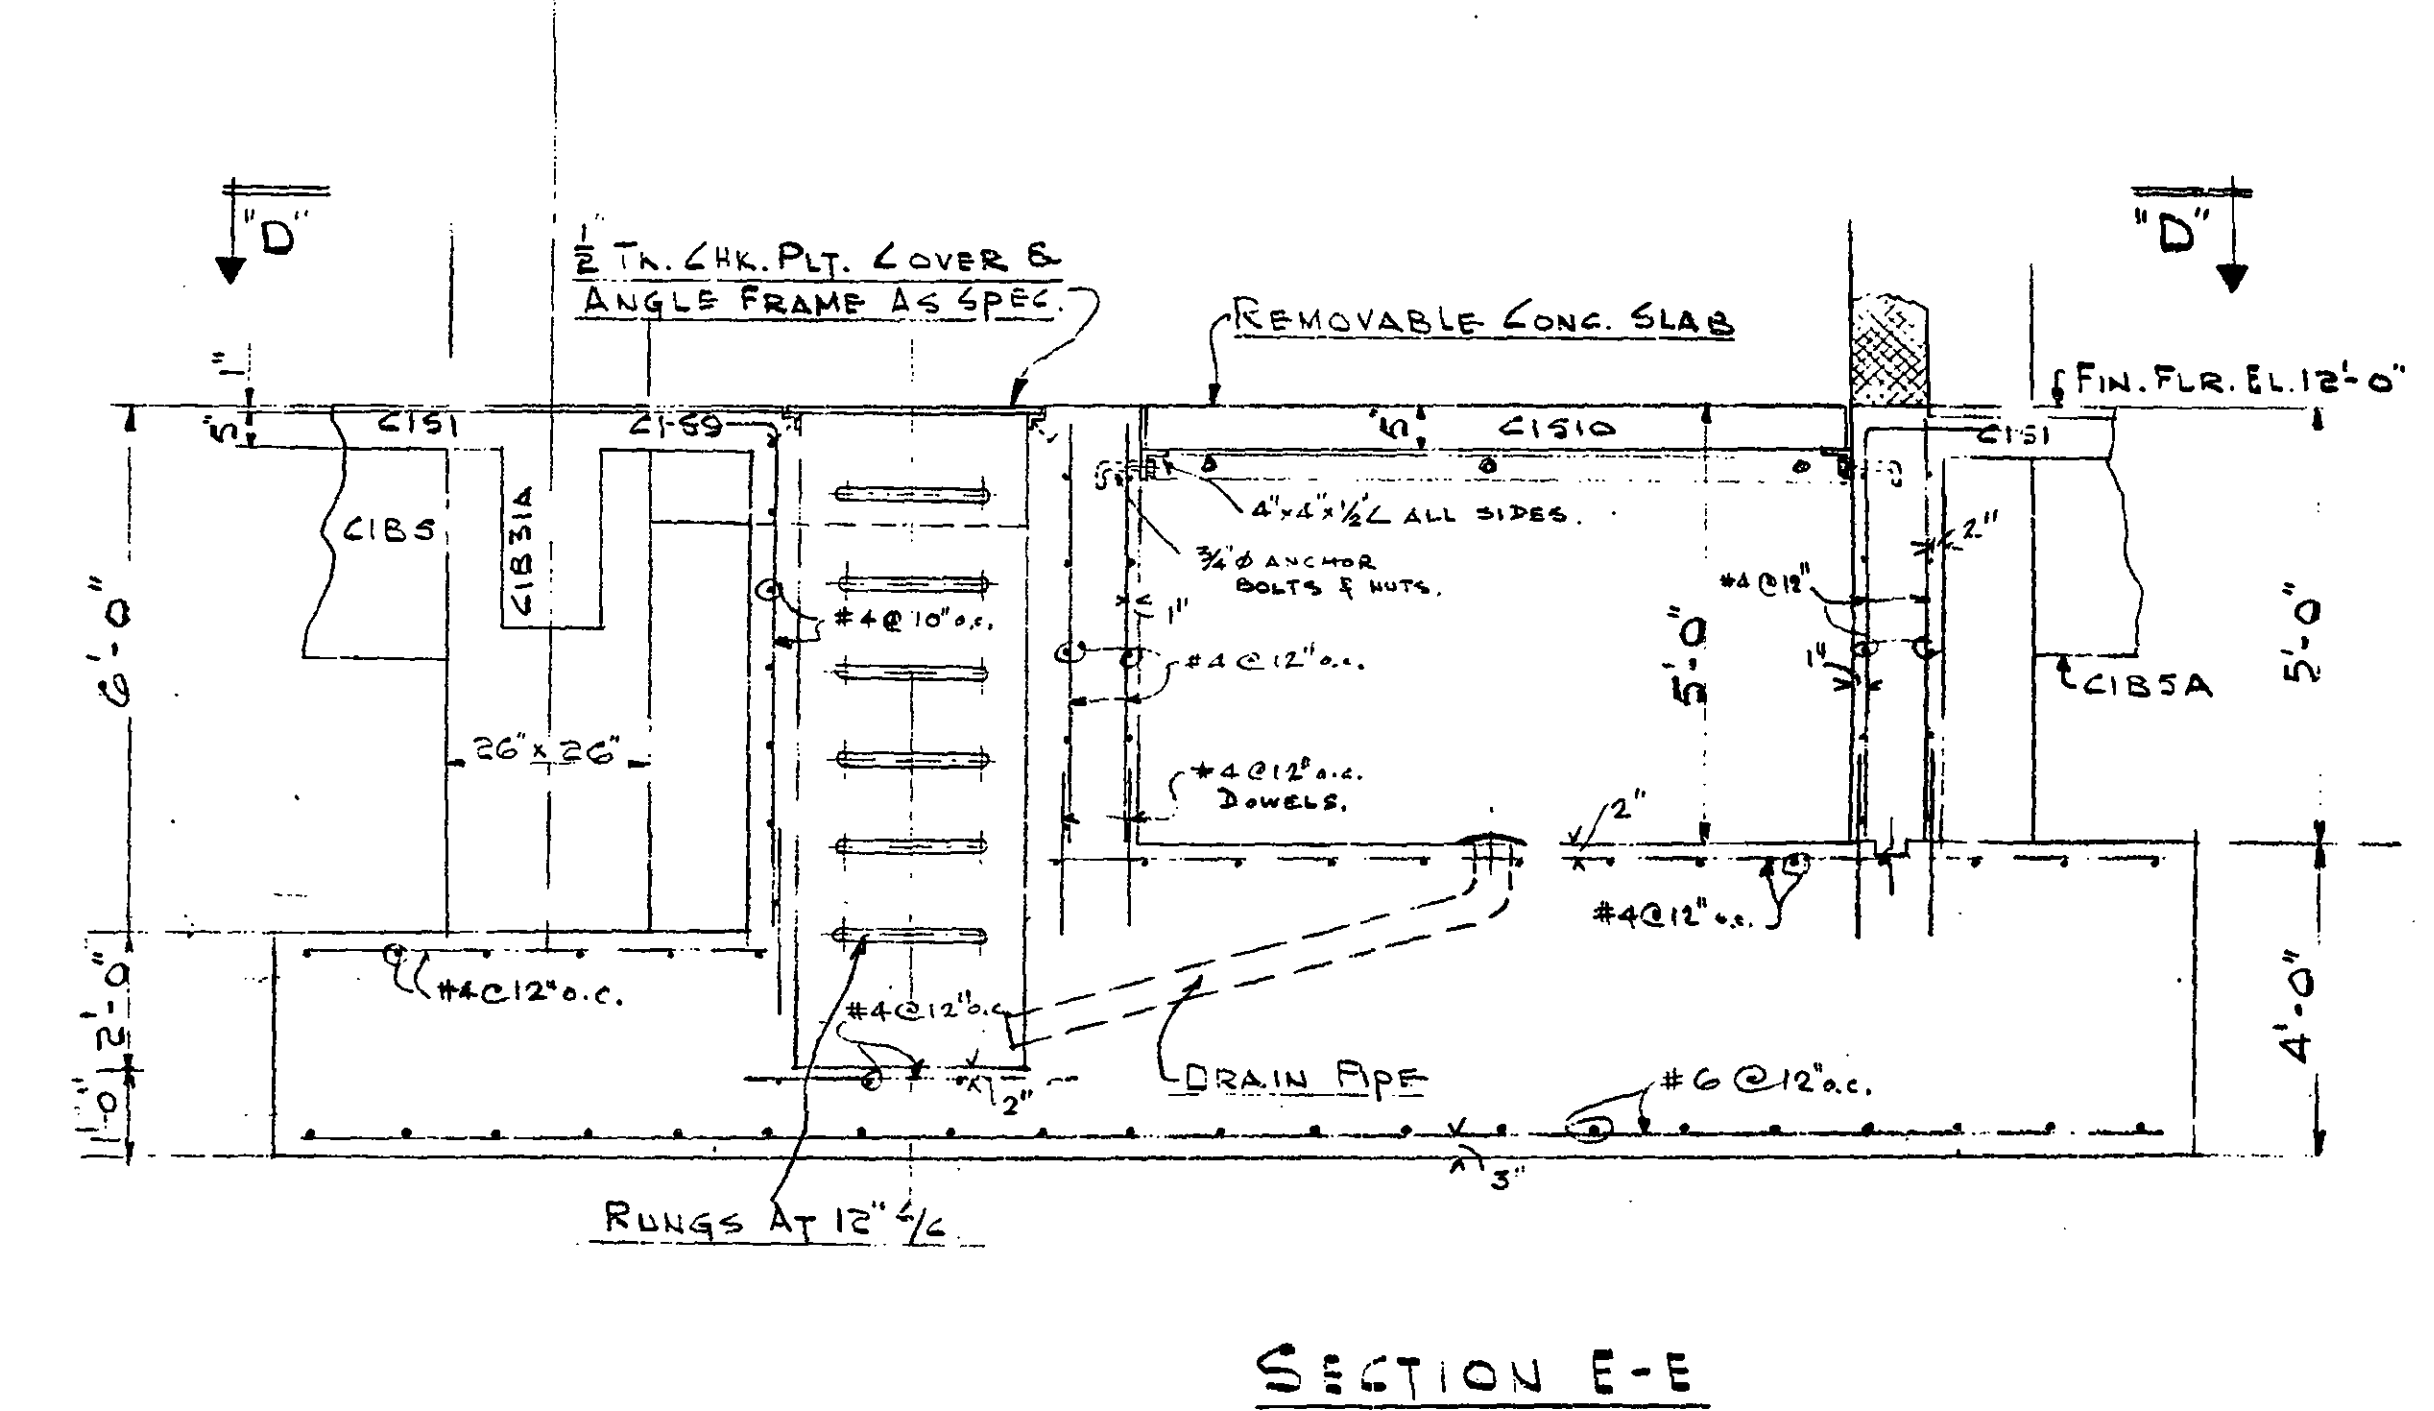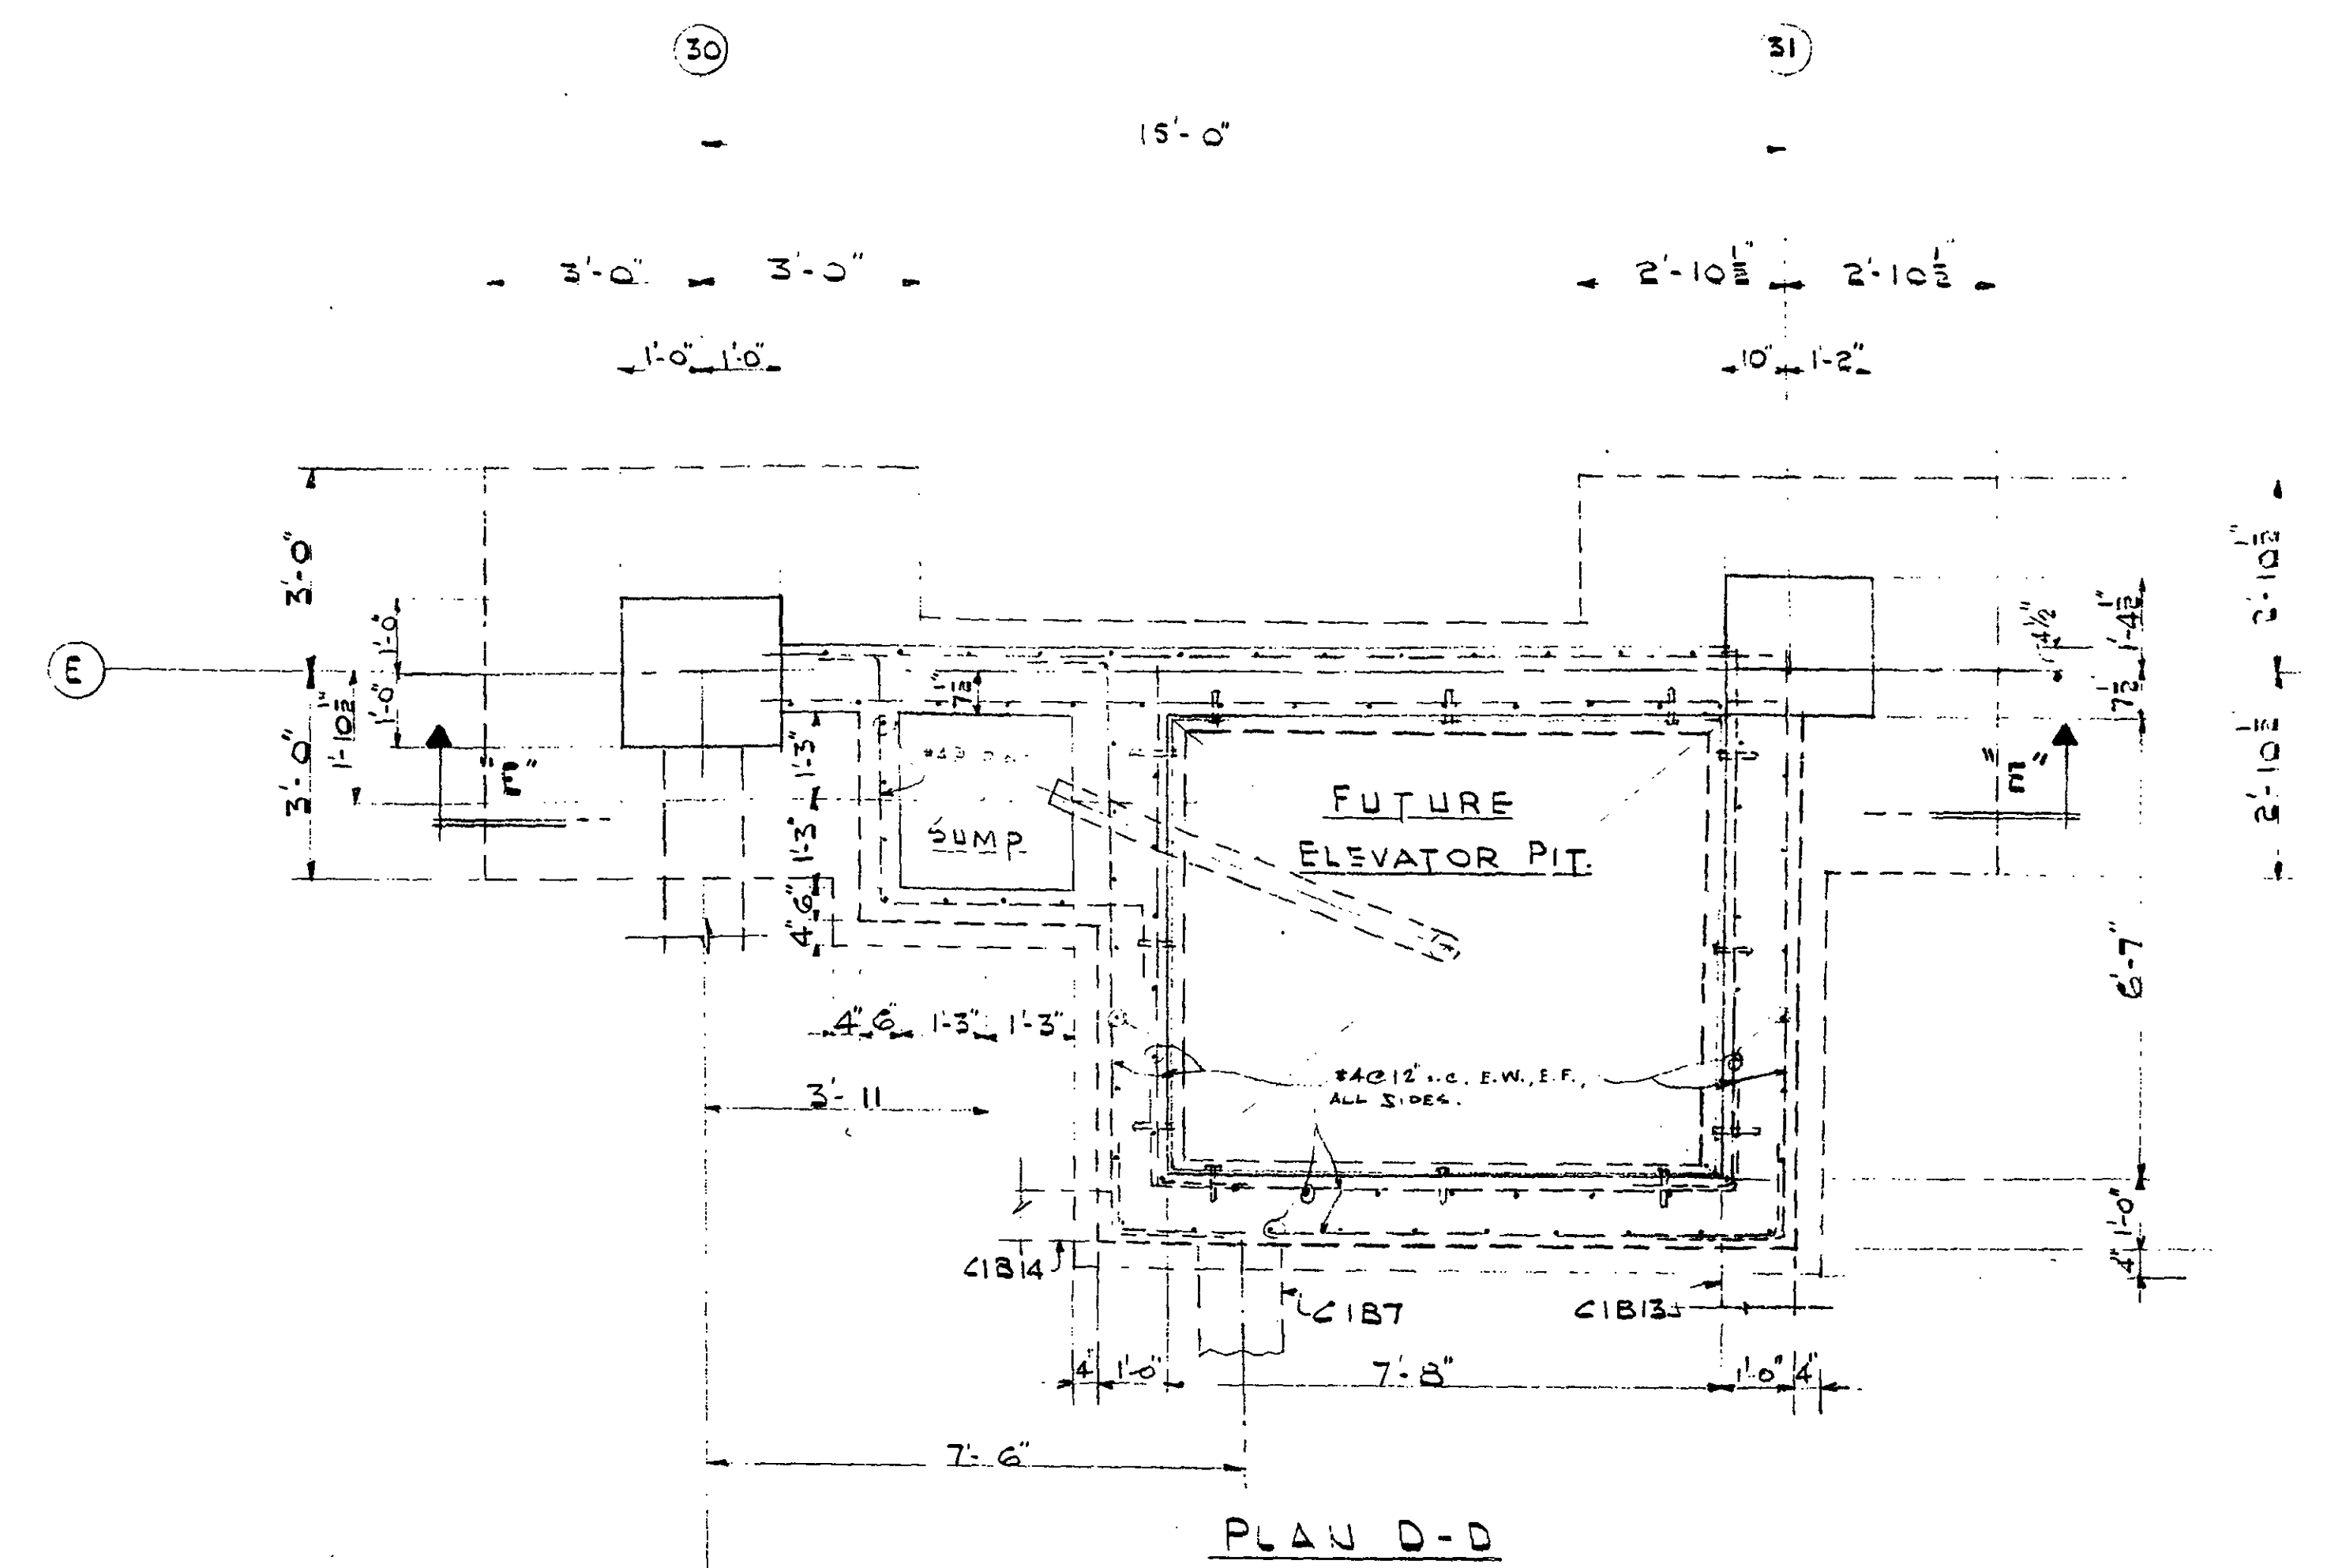

SECTION E-E
ARRANGEMENT OF FUTURE ELEVATOR PIT

REVISIONS		DEPARTMENT OF PUBLIC WORKS OF CANADA			
DATE	RECORD	BUILDING CONSTRUCTION BRANCH		E. A. GARDNER CHIEF ARCHITECT	
		SAINT JOHN'S N.F.L.D.			
		SHOPS STORES & ADMINISTRATION BLDG. (D.O.T.)			
		DETAILS OF ELEVATOR PITS			
		DRAWN BY: RP	CHECKED BY: RP	APPROVED BY: W. A. W.	SCALE: 3/8" = 1'-0"
		DATE: 12/1/47	DATE: 12/1/47	DATE: 12/1/47	DATE: 12/1/47
		JOB NO. CA 61-1-13/32		DRAWING NO. S10 OF 22	

The image displays two architectural floor plans, labeled 'PLAN AT B-B' and 'PLAN AT C-C', for a building. The plans include various rooms and structural elements with dimensions and section line indicators.

PLAN AT B-B:

- Overall dimensions: 10'-8" (width) x 21'-0" (length).
- Rooms and features:
 - TOILET (center)
 - CONC. CANOPY (right)
 - CONC. PLATFORM (bottom right)
 - MAT SINKAGE (bottom right)
 - EL. 33.0 (top left)
 - EL. 27.2 (top right)
- Dimensions:
 - Top: 10'-8"
 - Left: 10'-8"
 - Right: 4'-3", 7'-5", 1'-11"
 - Bottom: 6'-3", 7'-6", 5'-5"
 - Internal: 4'-8", 4'-8", 4'-8", 4'-8", 4'-8"
- Section lines: A-A (top), B-B (bottom).


PLAN AT C-C:


- Overall dimensions: 10'-8" (width) x 21'-0" (length).
- Rooms and features:
 - TOILET (center)
 - CONC. PLATFORM (right)
 - MAT SINKAGE (right)
 - EL. 19.7 (top left)
 - EL. 15.0 (bottom right)
- Dimensions:
 - Top: 10'-8"
 - Left: 10'-8"
 - Right: 6'-7", 1'-3", 1'-3"
 - Bottom: 1'-0", 5'-7", 10'-9", 5'-5"
 - Internal: 4'-8", 4'-8", 4'-8", 4'-8", 4'-8"
- Section lines: A-A (top), B-B (bottom).

Hand-drawn architectural floor plan of a bathroom, labeled "PLAN AT C-C" at the bottom. The plan shows a rectangular room with a toilet, a sink, and a platform. Dimensions are given in feet and inches. The toilet is located in the upper right corner, with a door labeled "TOILET" and a window. The sink is located in the lower right corner, with a door labeled "SINK" and a window. The platform is located in the lower left corner, with a door labeled "CONC PLATFORM" and a window. The overall dimensions of the room are 10'-6" by 8'-7 1/2". The plan also shows a staircase with an arrow pointing "UP" and a door labeled "FL 19-7". The plan is oriented with North (N) indicated by an arrow pointing towards the top right.

NOTE - THIS DRAWING TO BE READ IN CONJUNCTION WITH DWG. NOS 519 & 521

REVISIONS DATE _____ RECORD _____		DEPARTMENT OF PUBLIC WORKS OF CANADA BUILDING CONSTRUCTION BRANCH <u>SAINT JOHN'S NFLO</u> SHOPS STORES & ADMINISTRATION BLDG. (D.O.T.) ARRANGEMENT & SECTIONS FOR STAIRS N21				E. A. GARDNER CHIEF ARCHITECT	
DRAWN BY: <u>SG</u> DESIGNED: <u>17-5 LAM</u> DATE: _____		CHECKED BY: <u>RP</u> DATE: _____		APPROVED BY: <u>M.A.R.</u> DATE: <u>8-4-68</u>		SCALE: _____ DRWG. NO. <u>511</u> <u>OF 22</u>	
JOB NO. CA <u>61-1-13/33</u>		PLAN FILE NO.: _____					

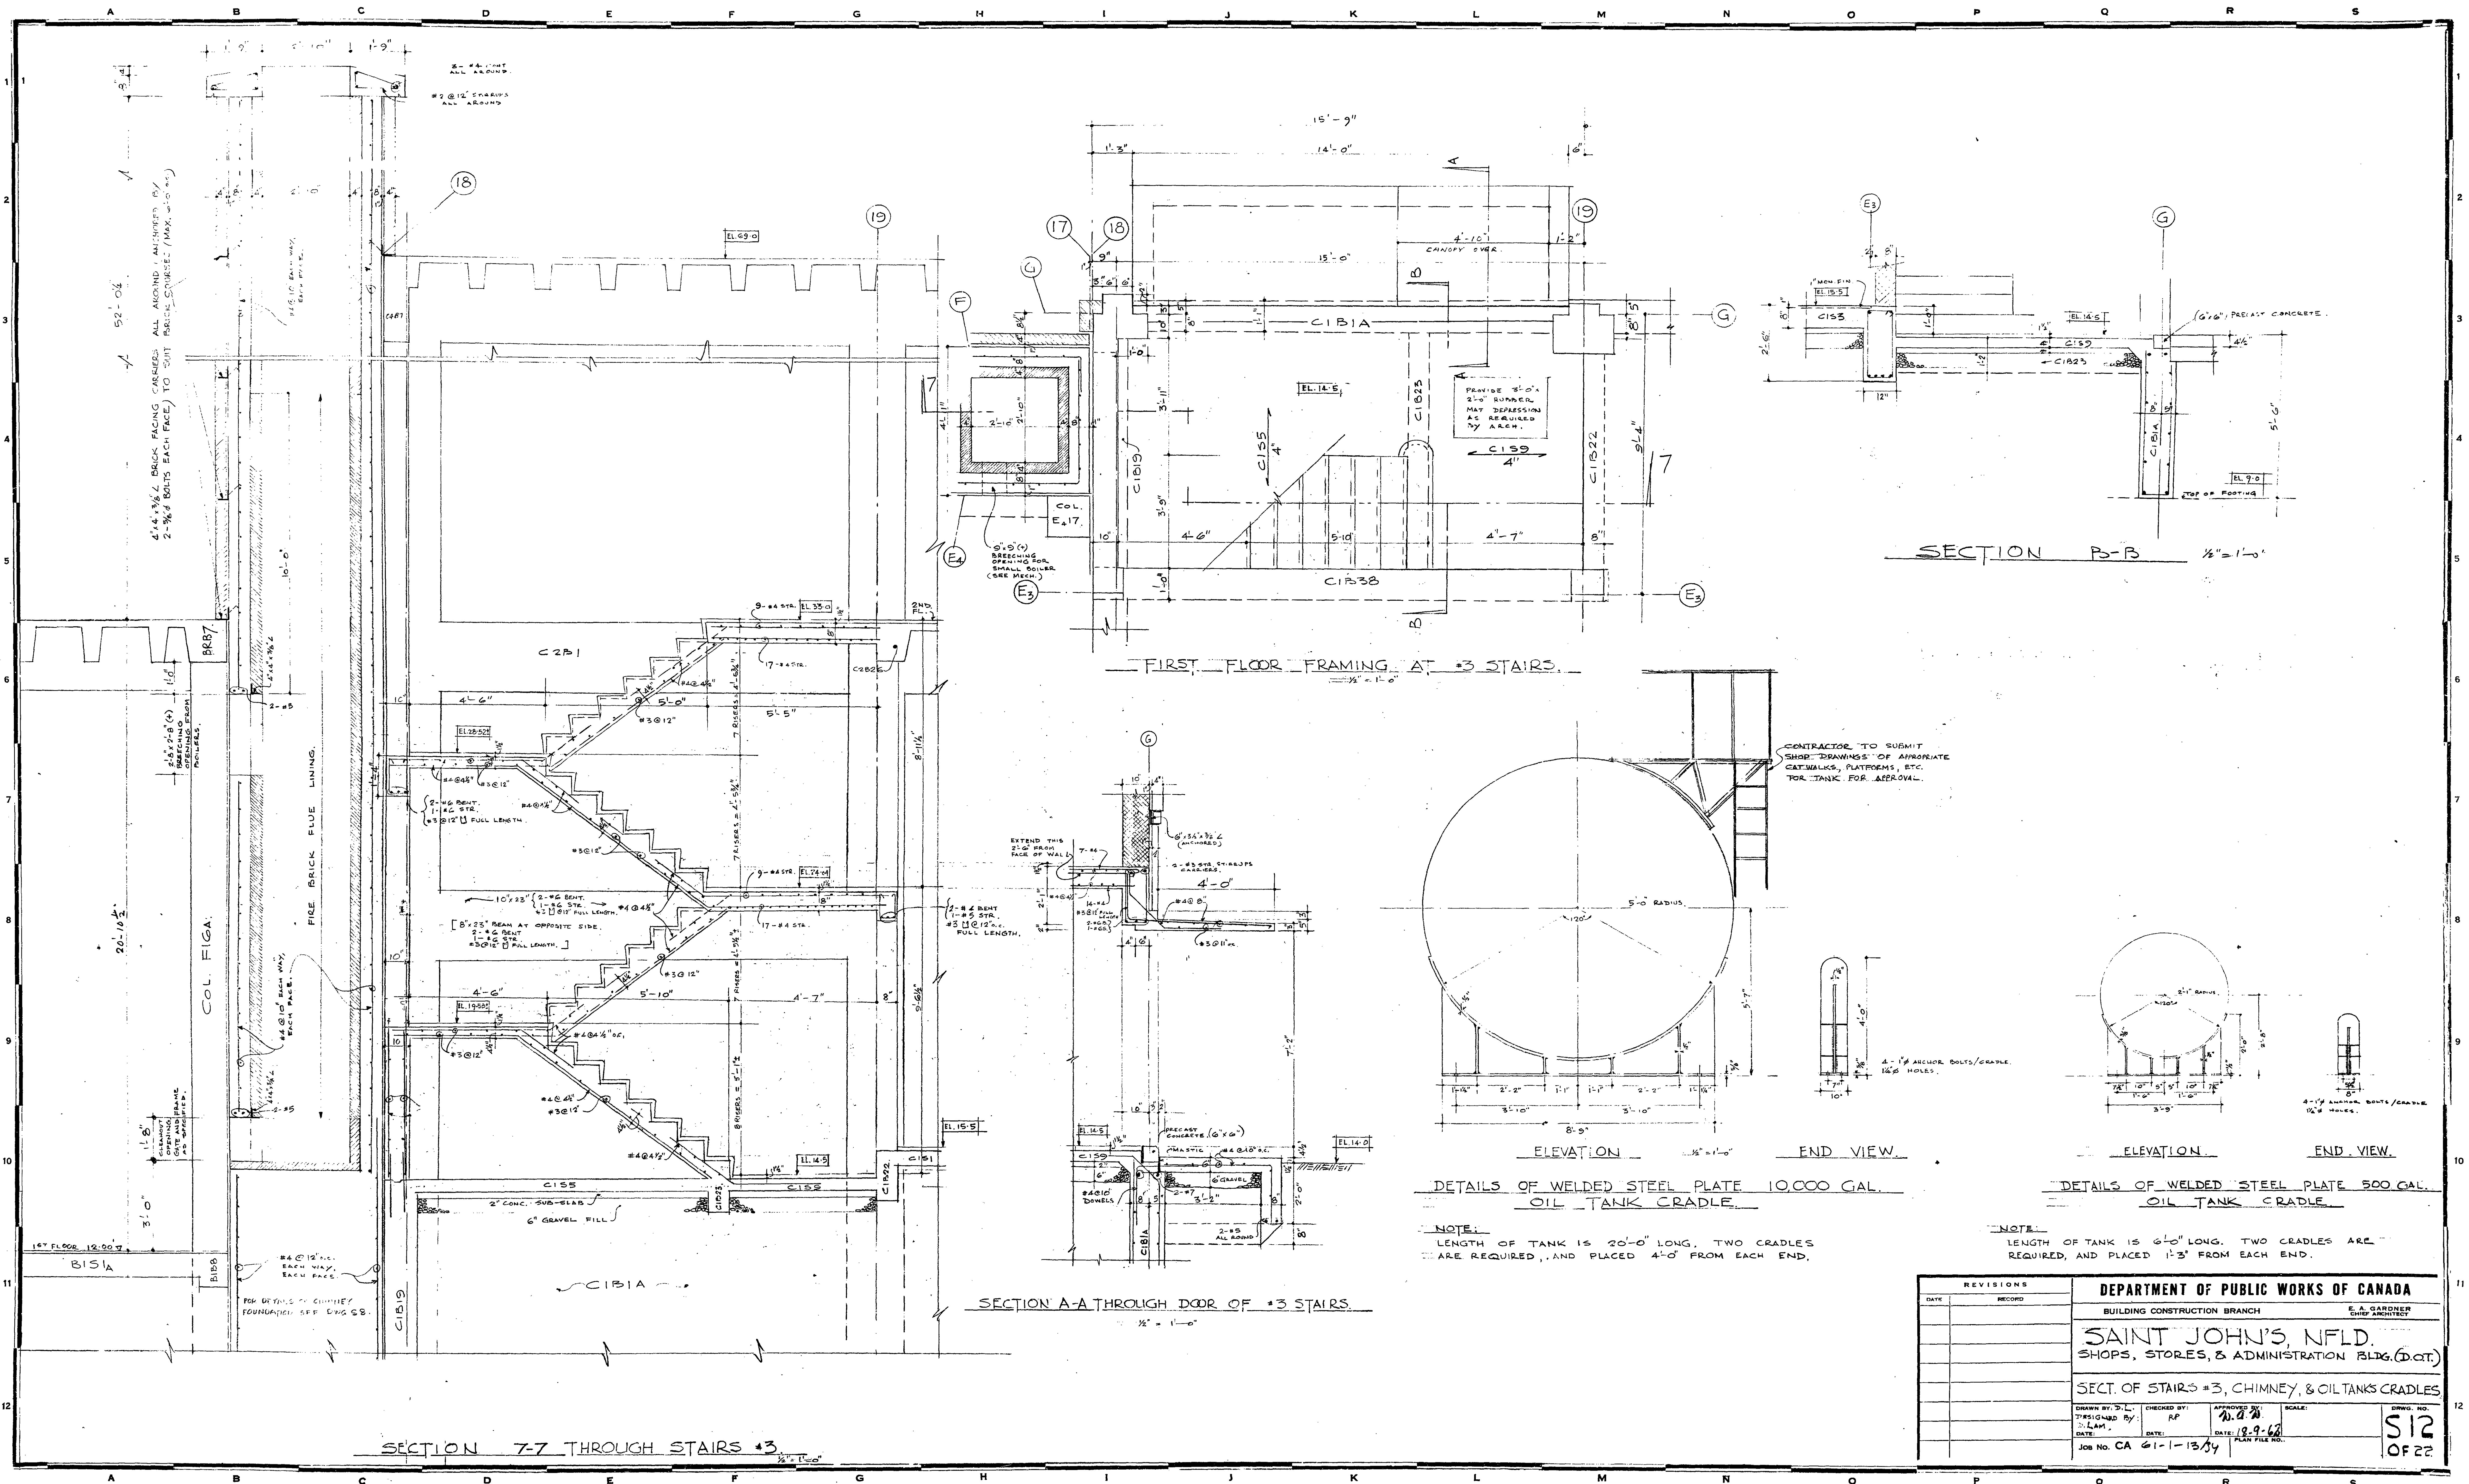

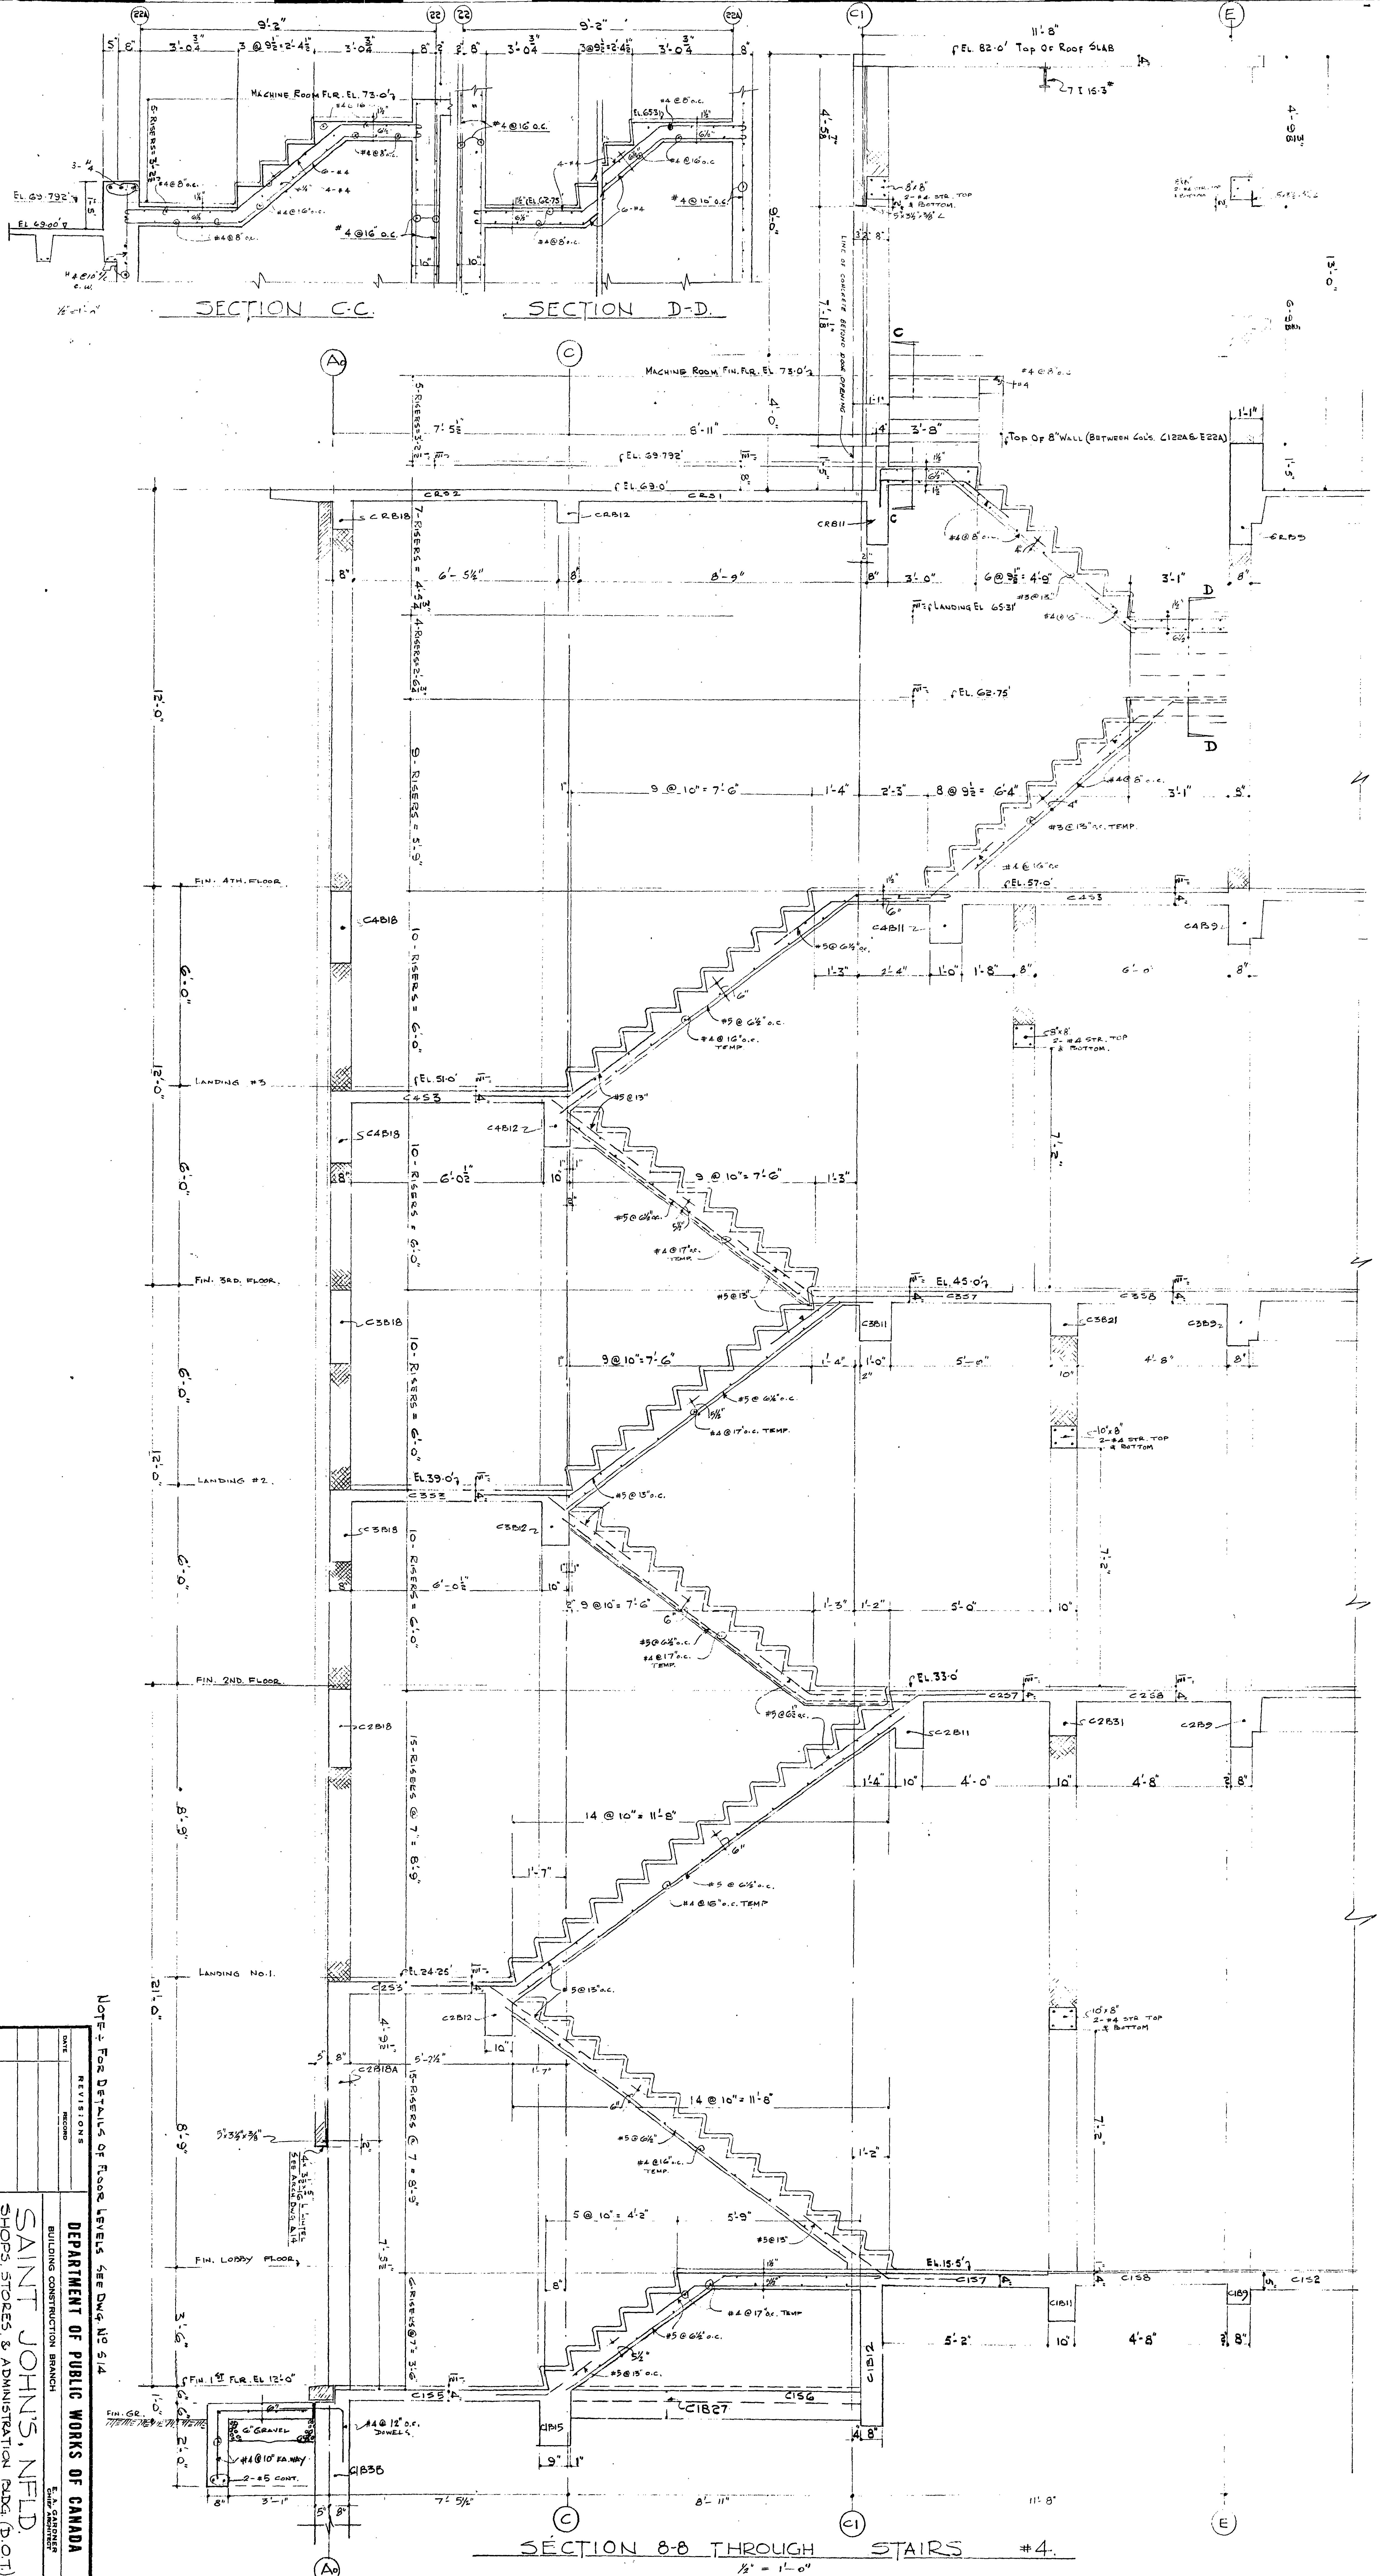

Notes: For Details of Floor Levels See DWG. No. 514

REVISIONS


DEPARTMENT OF PUBLIC WORKS OF CANADA
BUILDING CONSTRUCTION BRANCH
SAINT JOHN'S, Nfld.
SHOPS, STORES, & ADMINISTRATION BLDG. (D.O.T.)

SECTIONS THROUGH STAIRS #4.


DATE: 12/1/55
DRAWN BY: J.L.
CHECKED BY: R.P.
DATE: 12/1/55
JOB NO. CA 61-1-13/55

513
OF 62

6-CA-61-1-13/36

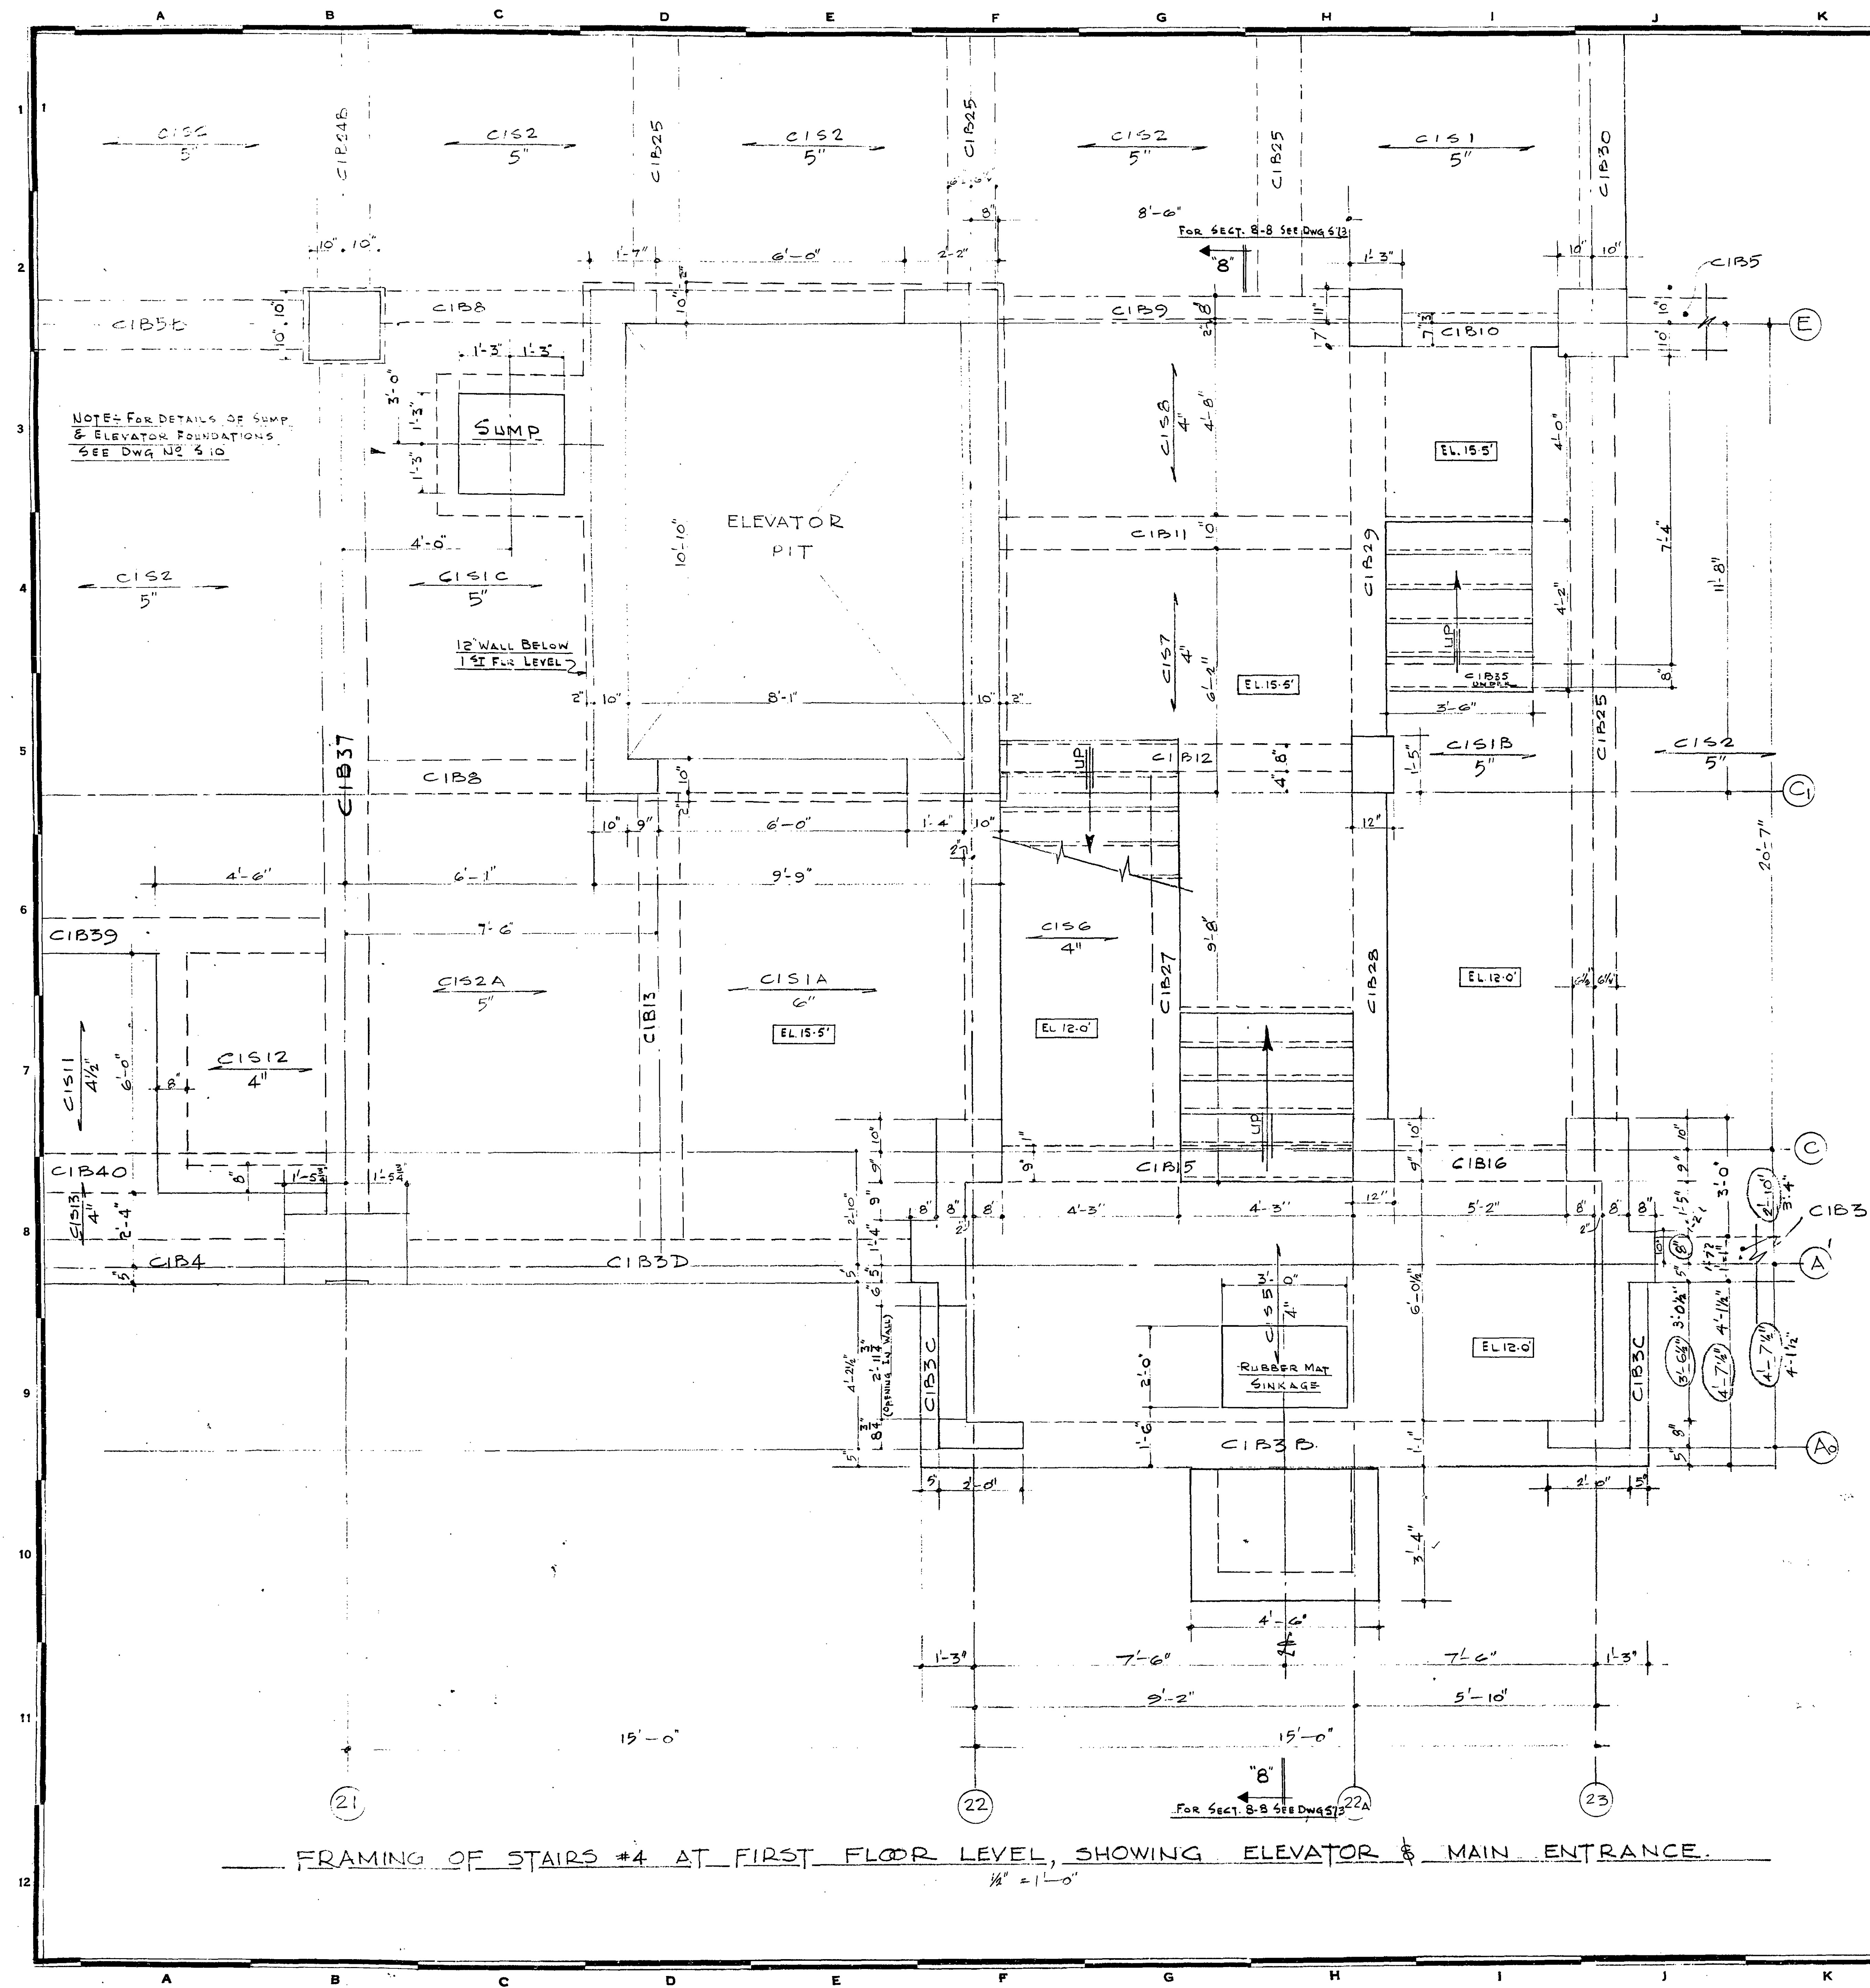

FRAMING OF STAIRS #4 AT FIRST FLOOR LEVEL, SHOWING ELEVATOR & MAIN ENTRANCE.

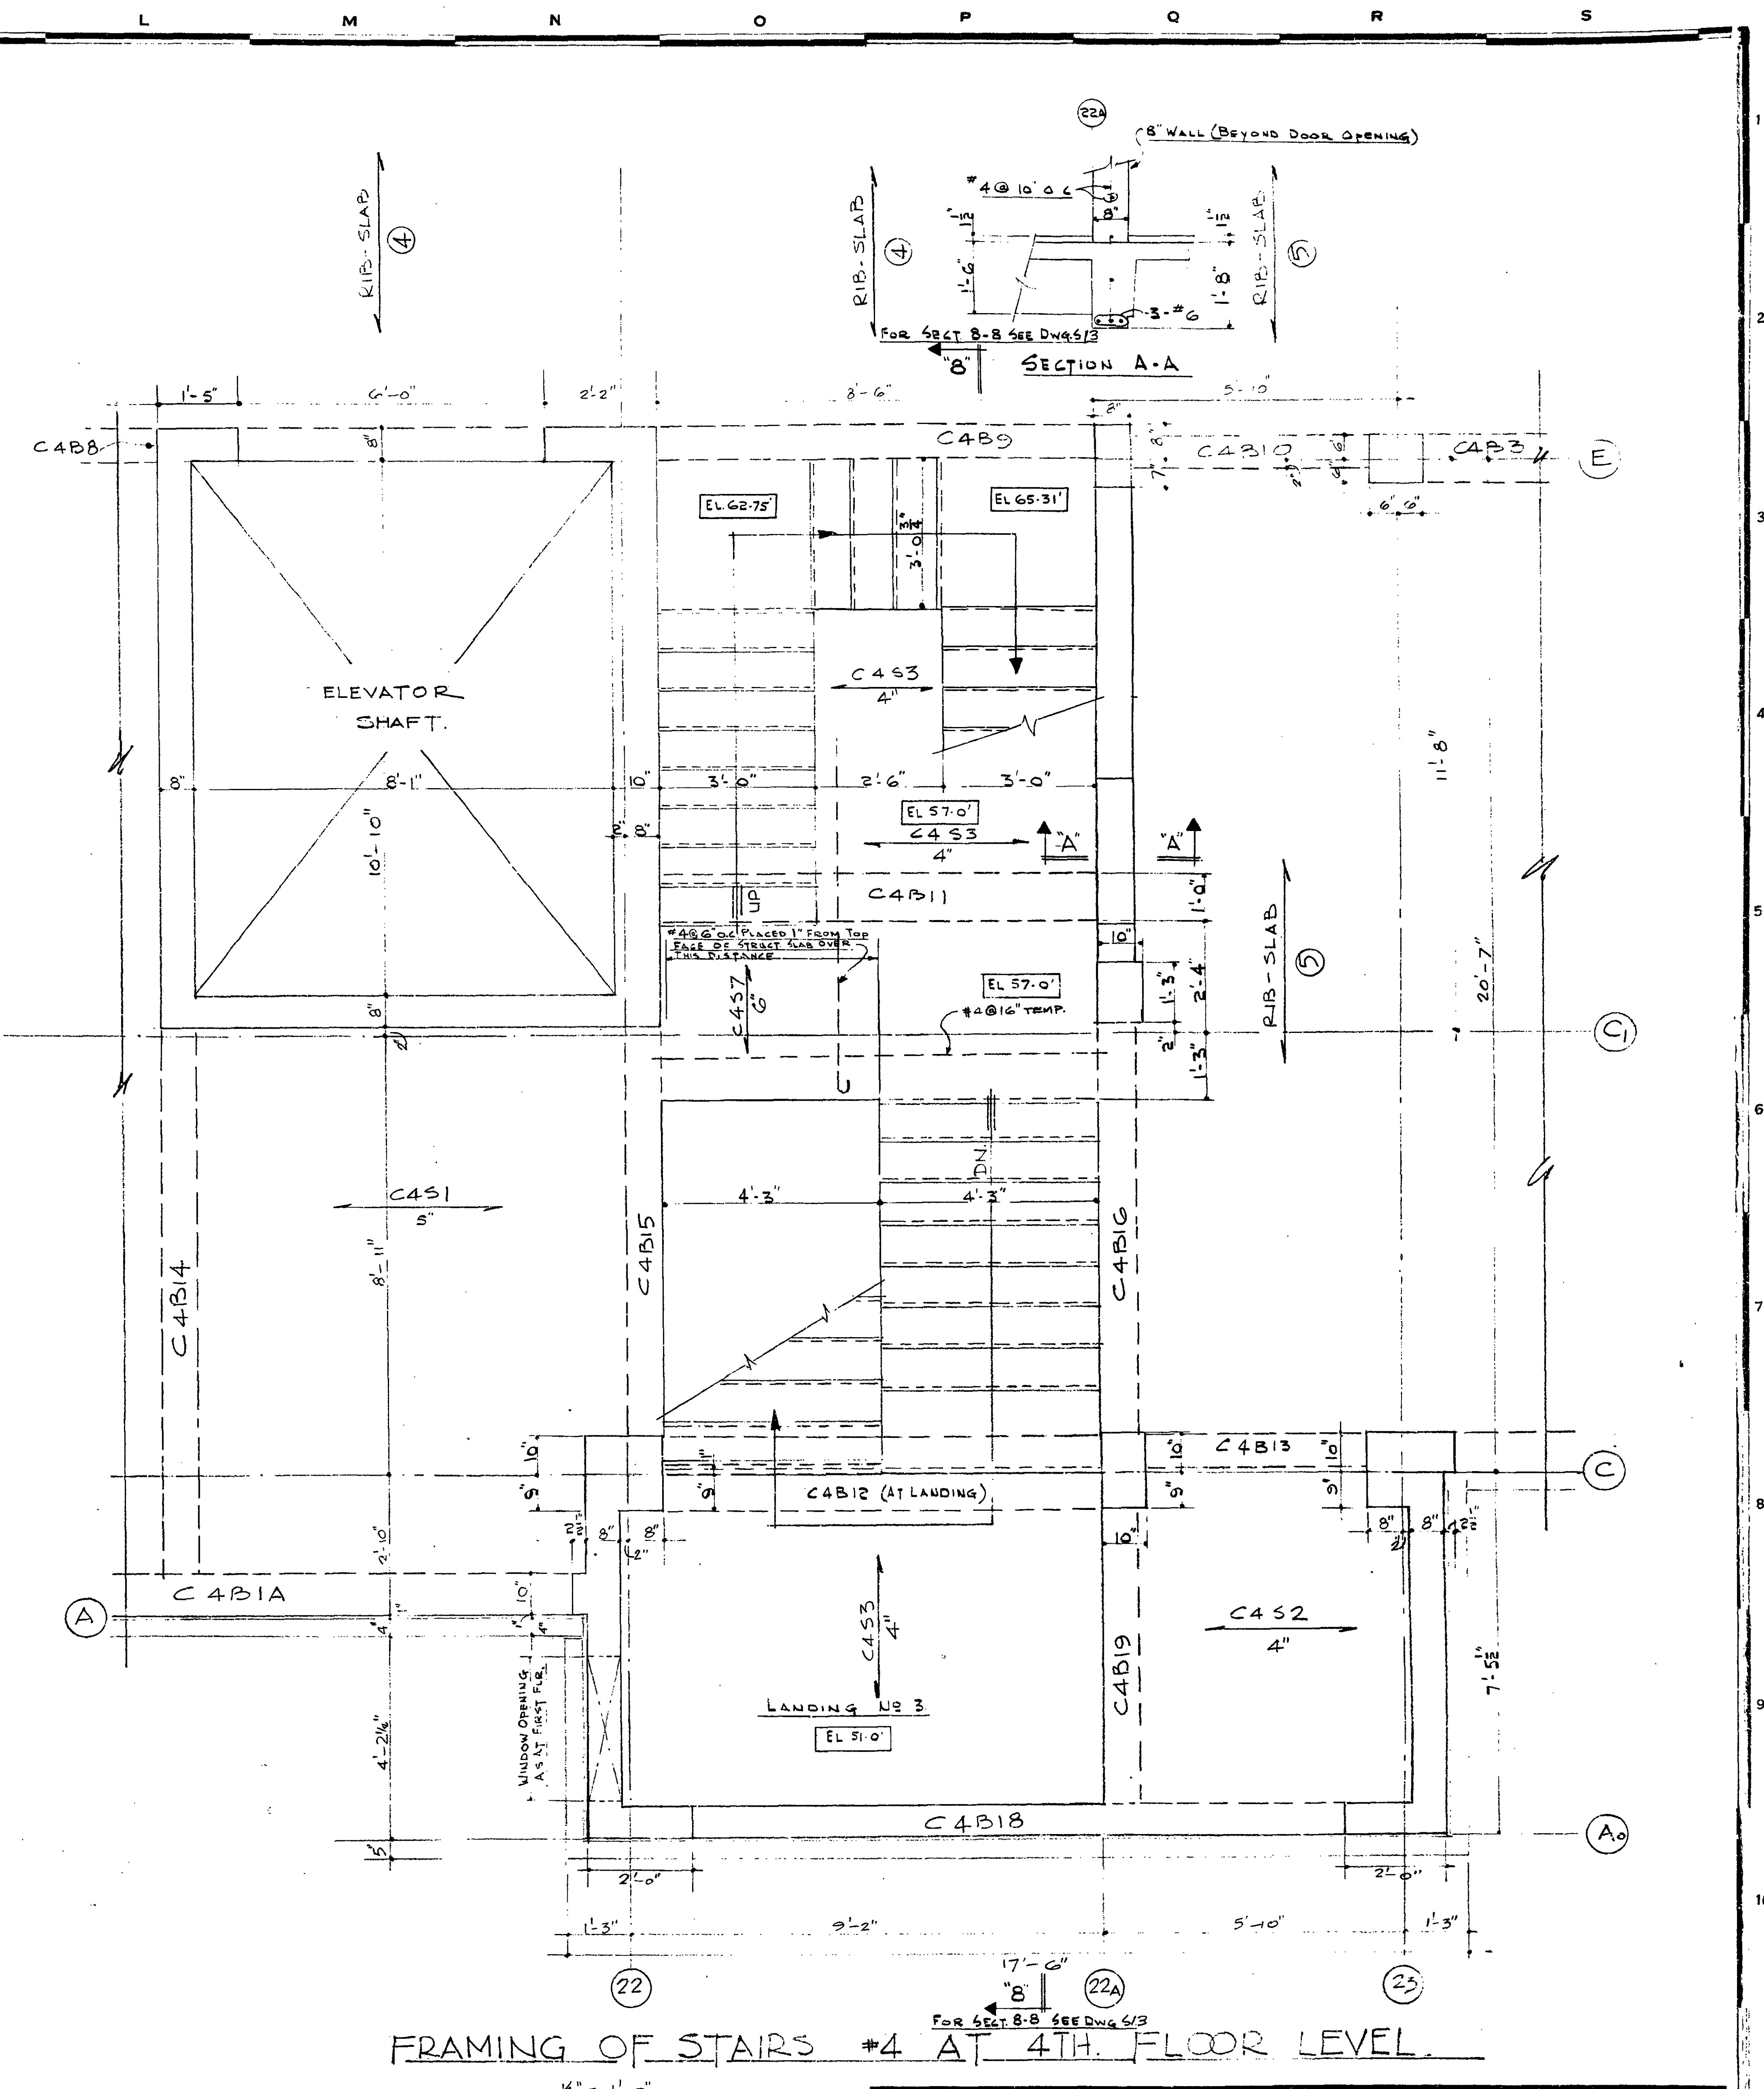


FRAMING OF STAIRS #4 AT 4TH FLOOR LEVEL

1/4" = 1'-0"

NOTE: FOR SECTION THROUGH STAIR #4 SEE DWG NO 5/3

REVISIONS		DEPARTMENT OF PUBLIC WORKS OF CANADA	
DATE	RECORD	BUILDING CONSTRUCTION BRANCH	
		E.A. GARDNER CHIEF ARCHITECT	
		SAINT JOHN'S, Nfld.	
		SHOPS, STORES, & ADMINISTRATION, BLDG. (DGT)	
		DETAILS OF STAIRS #4.	
		DRAWN BY: J.L. L.	
		CHECKED BY: R.P.	
		DATE: 12.9.62	
		SCALE: 1/2" = 1'-0"	
		JOB NO. CA 61-1-13/36	
		DRAWING NO. 514	
		OF 22	

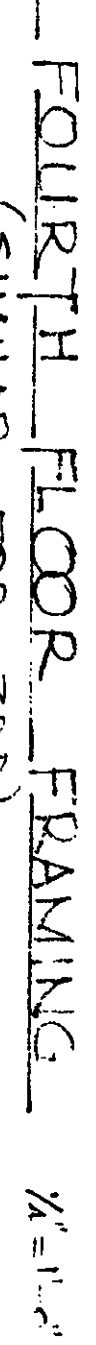
$$\frac{1}{2}'' = 1 \frac{1}{2}''$$
$$\frac{1}{2}'' = 1 \frac{1}{2}''$$


FOURTH FLOOR FRAMING 1/4"=1'-0"

SECOND FLOOR FRAMING 1/4" = 1'-0"

MEZZANINE FLOOR FRAMING. 1/4"=1'-0"

FIRST- FLOOR FRAMING. $\frac{1}{4}" = 1'-0"$

REVISIONS	
DATE	RECORD

DEPARTMENT OF PUBLIC WORKS OF CANADA

BUILDING CONSTRUCTION BRANCH
E. A. GARDNER
CHIEF ARCHITECT

ST. JOHN'S. NELD.

ENRGE STATES & ADMINISTRATION BOARD (A-C-H)

CHOP, 2010 & ADMINISTRATION. (D.O.I.)

11

$\frac{U}{\Delta T}$ $\frac{Z}{O}$ $\frac{U}{.}$

SCALE:	APPROVED BY:	CHECKED BY:	IN BY:
DRWG:	M. S. M.	RF	J. L.

DATE:	DATE: 18-9-68	U
-------	---------------	---

NO. CA 61-1-13/37 PLAN FILE NO. OF

100

9
2
5

DRWG. NO.
516
OF 22

G-CA-61-1-13/39

COLUMN SCHEDULE. "C" BLOCK. ASSUMED SOIL BEARING CAPACITY:

COLUMN MARK	B13	F13	B14	F14a, E14a	COLUMN MARK	C24, C29, C25, C30, C26, C27, C28	G19, G24, G29, G20, G25, G30, G21, G26, G22, G27, G23, G28	A19, A20, A21	E19, E26, E20, E27, E24, E28, E25, E29	E30	A24, A25, A26, A27, A28, A29, A30	E31	E18, E32	A18	G18	G31
FLOOR					FLOOR											
PENTHOUSE ROOF (EL. 82.0)					PENTHOUSE ROOF (EL. 82.0)											
MACHINE RM. FL. (EL. 75.0)					MACHINE RM. FL. (EL. 75.0)											
MAIN ROOF (EL. 69.0)					MAIN ROOF (EL. 69.0)											
4TH. FL. (EL. 57.0)					4TH. FL. (EL. 57.0)											
3RD. FL. (EL. 45.0)					3RD. FL. (EL. 45.0)	AS ABOVE	AS ABOVE	AS ABOVE						AS ABOVE	AS ABOVE	AS ABOVE
2ND. FL. (EL. 33.0)					2ND. FL. (EL. 33.0)	AS 10-#8 VERT. ABOVE. (2-#5 EXTRA AS ABOVE)	AS 10-#8 VERT. ABOVE. (2-#5 EXTRA AS ABOVE)	AS 10-#8 VERT. ABOVE. (2-#5 EXTRA AS ABOVE)						AS ABOVE	AS ABOVE	AS ABOVE
TOP OF CANOPY (EL. 26.95)					TOP OF CANOPY (EL. 26.95)									AS ABOVE	AS ABOVE	AS ABOVE
MEZZANINE (EL. 22.5)					MEZZANINE (EL. 22.5)									AS ABOVE	AS ABOVE	AS ABOVE
1ST. FL. (EL. 12.0)					1ST. FL. (EL. 12.0)											
ROOF SLAB (EL. 32.97)					ROOF SLAB (EL. 32.97)											
TOP OF CANOPY (EL. 26.95)	SEE DETAIL & REINFORC. BELOW				TOP OF CANOPY (EL. 26.95)											
1ST. FL. (EL. 12.0)					1ST. FL. (EL. 12.0)											
DOWELS:	8-#8	8-#8	8-#8	4-#8	DOWELS:	10-#8	10-#8	AS MANY AS NO. OF BARS IN COLS.	12-#9	14-#10	AS MANY AS NO. OF BARS IN COLS.	14-#11	10-#11	10-#9	10-#9	12-#8
ELEVATION OF TOP OF PILE CAP OR FOOTING.	6'-0"	9'-0"	6'-0"	9'-0"	ELEVATION OF TOP OF PILE CAP OR FOOTING.	6'-0"	9'-0"	6'-0"	6'-0"	6'-0"	6'-0"	6'-0"	E18: 9'-6" E32: 6'-0"	6'-0"	9'-0"	9'-0"
COL. LOAD (KIPS)	275	275	275	COMBINED AS INDICATED IN PILING PLAN.	COL. LOAD (KIPS)	372	353	AS INDICATED ON PILING PLAN.	AS INDICATED ON PILING PLAN.	700	COMBINED AS INDICATED ON PLAN.	645	E18: COMBINED AS INDICATED ON PILING PLAN E32: 612	COMBINED AS INDICATED ON PILING PLAN	COMBINED AS INDICATED ON PILING PLAN	356
FOOT'G SIZE & REINFORC. WHERE INDICATED.					FOOT'G SIZE & REINFORC. WHERE INDICATED	SAME AS A24 TO A29.				SEE DWG. S10 FOR FOOTING.						
DETAILS.					DETAILS.											

SEE ALSO FOUNDATION DWGS S1 & S2 FOR FOOTING DETAILS.

REVISIONS		DEPARTMENT OF PUBLIC WORKS OF CANADA	
DATE	RECORD	BUILDING CONSTRUCTION BRANCH	
		E.A. GARDNER	
		SAINT JOHN'S, Nfld.	
		SHOPS, STORES, & ADMINISTRATION BLDG. (D.C.T.)	
		COLUMN SCHEDULES.	
DRAWN BY: D.L. SPECIFIED BY: S.L.M.		CHECKED BY: R.P.	APPROVED BY: H.A.D.
DATE: 8-4-68		DATE: 8-4-68	SCALE: 1/2" = 1'-0"
JOB NO. CA 61-1-13/39		DWG. NO. 517 OF 32	

BLOCK.


ASSUMED SOIL BEARING CAPACITY:

DETAILS

REVISIONS		DEPARTMENT OF PUBLIC WORKS OF CANADA			
DATE	RECORD	BUILDING CONSTRUCTION BRANCH		E. A. GARDNER CHIEF ARCHITECT	
		SAINT JOHN'S, Nfld. SHOPS, STORES, & ADMINISTRATION BLDG. (60T.)			
		COLUMN SCHEDULES.			
DRAWN BY: S.L. DESIGNED BY: S.L.M.		CHECKED BY: R.P.		APPROVED BY: W.A.H.	SCALE:
DATE:		DATE:		DATE: 8-4-62	
JOB NO. CA		61-1-13		PLAN FILE NO.	
					518 OF 22

DIMENSIONS ARE GIVEN LOOKING PLAN FROM

DIMENSIONS ARE GIVEN LOOKING PLAN FROM

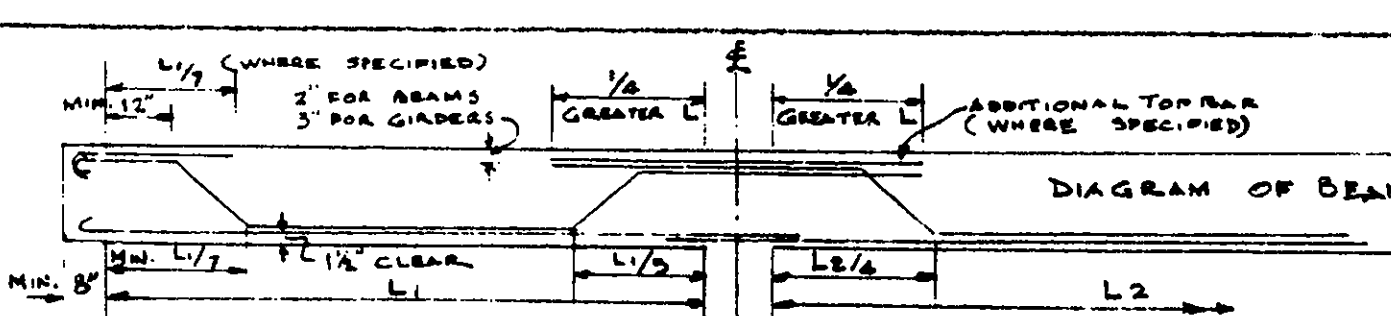

NOTE: FOR BEAMS NOT SHOWN ON SCHEDULES SEE
DETAILS AT STAIRWELLS.

REVISIONS		DEPARTMENT OF PUBLIC WORKS OF CANADA					
DATE	RECORD	BUILDING CONSTRUCTION BRANCH				C. L. GARDNER CHIEF ARCHITECT	
SAINT JOHN'S Nfld.							
SHOPS STORES & ADMINISTRATION BLDG. (D.O.T.)							
BEAM SCHEDULE							
DRAWN BY: <i>[Signature]</i>		CHECKED BY: RF		APPROVED BY: <i>[Signature]</i>		SCALE:	
DATE:		DATE:		DATE: 10-9-67		DWG. NO.	
JOB NO. CA 61-1-13				PLAN FILE NO.		519 OF 32	


[illegible]

DIMENSIONS ARE GIVEN LOOKING PLAN FROM
BOTTOM OR RIGHT-HAND SIDE


NOTE - FOR BEAMS NOT LISTED ON SCHEDULES
SEE DETAILS AT STAIRWELLS.

REVISIONS		DEPARTMENT OF PUBLIC WORKS OF CANADA			
DATE	RECORD	BUILDING CONSTRUCTION BRANCH		E. A. GARDNER CHIEF ARCHITECT	
		SAINT JOHN'S, Nfld. SHOPS, STORES, & ADMINISTRATION BLDG. (DOT.)			
		BEAMS SCHEDULES.			
DRAWN BY: J. L. H.		CHECKED BY: J. P.	APPROVED BY: M. G. G.	SCALE:	DRWG. NO.
DESIGNED BY: D. LAM.		DATE:	DATE: 12-9-62		520
			PLAN FILE NO.		OF 22
		JOB NO. CA 61-1-1342			


SLAB SCHEDULE

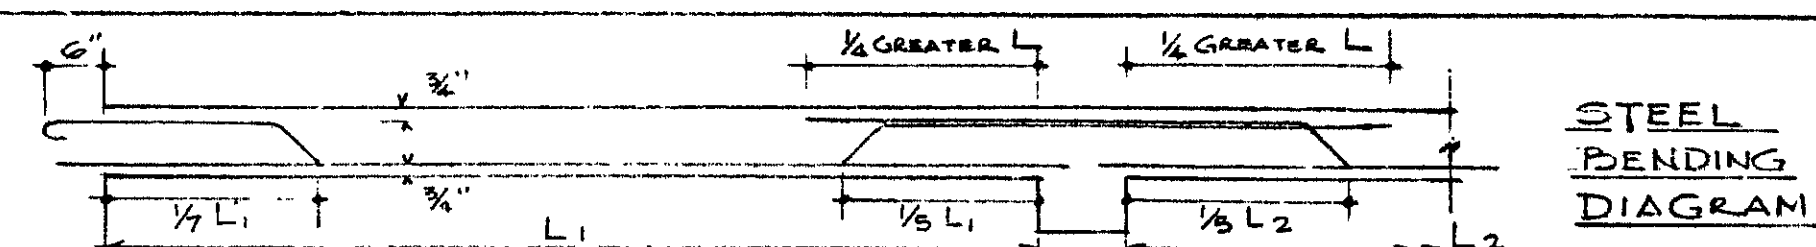


MARK.	THICKNESS	REINFORCING	REMARKS	MARK.	THICKNESS	REINFORCING	REMARKS
A1S1	8 1/2"	#4 @ 12" O.C. ALT. BENT & STRAIGHT. #5 @ 10" O.C. TEMP.	#4 @ 6" O.C. EXTRA TOP BARS OVER SUPPORT BETWEEN A1S1 & A1S2.	C2S1	4 1/2"	#4 @ 5" O.C. ALT. BENT & STRAIGHT. #3 @ 15" O.C. TEMP.	
A1S2	8 1/2"	#4 @ 12" O.C. BENT & STR. (PLACED ALT.) #5 @ 10" O.C. TEMP.	#4 @ 6" O.C. EXTRA TOP BARS OVER SUPPORT BETWEEN A1S2 & A1S3.	C2S2	4"	#4 @ 5" O.C. ALT. BENT & STRAIGHT. #3 @ 15" O.C. TEMP.	
A1S3	8 1/2"	#5 @ 12" O.C. ALT. BENT & STRAIGHT. #5 @ 10" O.C. TEMP.	#5 @ 6" O.C. EXTRA TOP BARS OVER SUPPORT BETWEEN A1S3 & A1S4.	C2S3	4"	#4 @ 5" O.C. ALT. BENT & STRAIGHT. #3 @ 15" O.C. TEMP.	
A1S4	4"	#4 @ 12" O.C. STRAIGHT TOP, #4 @ 8" O.C. STRAIGHT BOT. #3 @ 15" O.C. TEMP.		C2S4	4"	#4 @ 10" O.C. STR. TOP, #4 @ 8" O.C. STR. BOTTOM. #5 @ 15" O.C. TEMP.	
A1S5	4"	#4 @ 12" O.C. STRAIGHT TOP, #4 @ 8" O.C. STRAIGHT BOT. #3 @ 15" O.C. TEMP.		C2S5	5"	#4 @ 6" O.C. ALT. BENT & STRAIGHT. #3 @ 10" O.C. TEMP.	
A1S6	4"	#4 @ 6" O.C. ALT. BENT & STRAIGHT. #3 @ 15" O.C. TEMP.		C2S6	4"	#4 @ 5" O.C. ALT. BENT & STRAIGHT. #3 @ 15" O.C. TEMP.	
A1S1A	8 1/2"	#4 @ 6" O.C. ALT. BENT & STRAIGHT. #5 @ 10" O.C. TEMP.	HOOKED ENDS.	C2S7	4"	#4 @ 5" O.C. ALT. BENT & STRAIGHT. #3 @ 15" O.C. TEMP.	#2 @ 8" O.C. EXTRA TOP BAR OVER SUPPORT BETWEEN C2S7 & C2S8.
A2S1	4 1/2"	#4 @ 5" O.C. ALT. BENT & STRAIGHT. #3 @ 15" O.C. TEMP.		C2S8	4"	- DO -	
A2S2	4 1/2"	#4 @ 5" O.C. ALT. BENT & STRAIGHT. #3 @ 15" O.C. TEMP.		CM51	4"	#4 @ 6" O.C. STR. TOP, #4 @ 8" O.C. STR. BOTTOM. #3 @ 15" O.C. TEMP.	
A2S1A	4 1/2"	#4 @ 5" O.C. STRAIGHT BOTTOM. #3 @ 15" O.C. TEMP.	CARRY BENT BAR ACROSS FROM A2S2.	CM52	5 1/2"	#5 @ 6" O.C. ALT. STRAIGHT & BENT. #4 @ 14" O.C. TEMP.	
A2S3	5"	#5 @ 6" O.C. ALT. BENT & STRAIGHT. #4 @ 10" O.C. TEMP.		CM53	4"	#4 @ 5" O.C. ALT. BENT & STRAIGHT. #3 @ 15" O.C. TEMP.	
A2S4	4"	#4 @ 10" O.C. STR. TOP, #4 @ 8" O.C. STR. BOTTOM. #3 @ 15" O.C. TEMP.		CM54	4 1/2"	#4 @ 5" O.C. ALT. BENT & STRAIGHT. #3 @ 15" O.C. TEMP.	
A2S5	4"	- DO -		C3S1	5"	#5 @ 4" O.C. ALT. BENT & STRAIGHT. #4 @ 10" O.C. TEMP.	
A2S6	4"	- DO -		C3S2	4"	#4 @ 5" O.C. ALT. BENT & STRAIGHT. #3 @ 15" O.C. TEMP.	
ARS1	6"	#4 @ 10" O.C. STR., #5 @ 12" O.C. BENT (ALT. PLACED) #4 @ 10" O.C. TEMP.	#5 @ 6" O.C. EXTRA TOP BARS OVER SUPPORT BETWEEN ARS1 & ARS2.	C3S3	4"	#4 @ 5" O.C. ALT. BENT & STRAIGHT. #3 @ 15" O.C. TEMP.	
ARS2	6"	#4 @ 6" O.C. ALT. BENT & STRAIGHT. #4 @ 10" O.C. TEMP.	#4 @ 6" O.C. EXTRA TOP BARS OVER SUPPORT BETWEEN ARS2 & ARS3.	C3S4	4"	#4 @ 10" O.C. STR. TOP, #4 @ 8" O.C. STR. BOTTOM. #3 @ 15" O.C. TEMP.	
ARS3	6"	#4 @ 10" O.C. ALT. BENT & STRAIGHT. #4 @ 10" O.C. TEMP.		C3S5	7"	#5 @ 4" O.C. ALT. BENT & STRAIGHT. #4 @ 14" O.C. TEMP.	
ARS4	4"	#4 @ 10" O.C. STR. TOP, #4 @ 8" O.C. STR. BOTTOM. #3 @ 15" O.C. TEMP.		C3S7	4"	#4 @ 5" O.C. ALT. BENT & STRAIGHT. #3 @ 15" O.C. TEMP.	#2 @ 8" O.C. EXTRA TOP BAR OVER SUPPORT BETWEEN C3S7 & C3S8.
ARS5	4"	- DO -		C3S8	4"	- DO -	
ARS6	4"	- DO -		C3S6	4 1/2"	#4 @ 5" O.C. ALT. BENT & STRAIGHT. #3 @ 15" O.C. TEMP.	
APRS1	4"	#4 @ 10" O.C. ALT. BENT & STRAIGHT. #3 @ 15" O.C. TEMP.		C4S1	5"	#5 @ 4" O.C. ALT. BENT & STRAIGHT. #4 @ 10" O.C. TEMP.	
B1S1	8 1/2"	#4 @ 5" O.C. ALT. BENT & STRAIGHT. #5 @ 10" O.C. TEMP.	#4 @ 6" O.C. EXTRA TOP BARS OVER SUPPORT BETWEEN B1S1 & B1S2.	C4S2	4"	#4 @ 5" O.C. ALT. BENT & STRAIGHT. #3 @ 15" O.C. TEMP.	
B1S2	8 1/2"	#4 @ 5" O.C. BENT, #5 @ 12" O.C. STR. (PLACED ALT.) #5 @ 10" O.C. TEMP.	#4 @ 6" O.C. EXTRA TOP BARS OVER SUPPORT BETWEEN B1S2 & B1S3.	C4S3	4"	#4 @ 5" O.C. ALT. BENT & STRAIGHT. #3 @ 15" O.C. TEMP.	
B1S1A	8 1/2"	#4 @ 12" O.C. ALT. BENT & STRAIGHT. #5 @ 10" O.C. TEMP.	#5 @ 6" O.C. EXTRA TOP BARS OVER SUPPORT BETWEEN B1S1A & B1S2.	C4S4	4"	#4 @ 10" O.C. STR. TOP, #4 @ 8" O.C. STR. BOTTOM. #3 @ 15" O.C. TEMP.	
C1S1	5"	#4 @ 6" O.C. ALT. BENT & STRAIGHT. #4 @ 10" O.C. TEMP.	#3 @ 6" O.C. EXTRA TOP BARS OVER SUPPORT BETWEEN C1S1 & C1S2.	C4S5	7"	#5 @ 4" O.C. ALT. BENT & STRAIGHT. #4 @ 14" O.C. TEMP.	
C1S2	5"	- DO -		C4S6	4 1/2"	#4 @ 5" O.C. ALT. BENT & STRAIGHT. #3 @ 15" O.C. TEMP.	
C1S1A	6"	#5 @ 6" O.C. ALT. BENT & STRAIGHT. #4 @ 10" O.C. TEMP.	#4 @ 6" O.C. EXTRA TOP BARS OVER SUPPORT BETWEEN C1S1A & C1S2A.	C4S7	6"	#5 @ 6" O.C. STRAIGHT, 1" FROM TOP FACE OF SLAB, #4 @ 10" O.C. TEMP.	MAIN TOP BARS TO EXTEND EQUAL DISTANCE BEYOND C4S7 INTO C4S8.
C1S1B	5"	#4 @ 10" O.C. STR. TOP, #4 @ 8" O.C. STR. BOTTOM. #4 @ 10" O.C. TEMP.	#3 @ 6" O.C. EXTRA TOP BARS OVER SUPPORT BETWEEN C1S1B & C1S2B.	CRS1	4"	#4 @ 6" O.C. ALT. BENT & STRAIGHT. #3 @ 15" O.C. TEMP.	
C1S1C	5"	#4 @ 6" O.C. ALT. BENT & STRAIGHT. #4 @ 10" O.C. TEMP.	#3 @ 6" O.C. EXTRA TOP BARS OVER SUPPORT BETWEEN C1S1C & C1S2C.	CRS2	4"	#4 @ 8" O.C. ALT. BENT & STRAIGHT. #3 @ 15" O.C. TEMP.	
C1S2A	5"	#4 @ 6" O.C. ALT. BENT & STRAIGHT. #4 @ 10" O.C. TEMP.	#2 @ 6" O.C. EXTRA TOP BARS OVER SUPPORT BETWEEN C1S2A & C1S2B.	CRS3	4"	#4 @ 10" O.C. STR. TOP, #4 @ 8" O.C. STR. BOTTOM. #3 @ 15" O.C. TEMP.	
C1S3	8"	#4 @ 5" O.C. ALT. BENT & STRAIGHT. #4 @ 11" O.C. TEMP.		CRS4	5"	#4 @ 5" O.C. ALT. BENT & STRAIGHT. #4 @ 10" O.C. TEMP.	
C1S4	4 1/2"	#4 @ 5" O.C. ALT. BENT & STRAIGHT. #3 @ 15" O.C. TEMP.		CRS5	4"	#4 @ 10" O.C. STR. TOP, #4 @ 8" O.C. STR. BOTTOM. #3 @ 15" O.C. TEMP.	
C1S5	4"	#4 @ 6" O.C. ALT. BENT & STRAIGHT. #3 @ 15" O.C. TEMP.		SS1	6 1/2"	STAIR SLAB. SEE DWG. S-15.	
C1S6	4"	#4 @ 10" O.C. STR. TOP, #4 @ 8" O.C. STR. BOTTOM. #3 @ 15" O.C. TEMP.		SS2	4"	#4 @ 10" O.C. STRAIGHT TOP & BOTTOM. #3 @ 15" O.C. TEMP.	
C1S7	4"	#4 @ 5" O.C. ALT. BENT & STRAIGHT. #3 @ 15" O.C. TEMP.	#2 @ 8" O.C. EXTRA TOP BAR OVER SUPPORT BETWEEN C1S7 & C1S8.	SS3	6 1/2"	STAIR SLAB. SEE DWG. S-15.	
C1S8	4"	- DO -		SS4	5 1/2"	- DO -	
C1S9	4"	#4 @ 10" O.C. STR. TOP, #4 @ 8" O.C. STR. BOTTOM. #3 @ 15" O.C. TEMP.		SS5	4"	#4 @ 9" O.C. ALT. BENT & STR. #3 @ 15" O.C. TEMP.	
C1S10	5"	#5 @ 6" O.C. ALT. BENT & STRAIGHT. #4 @ 10" O.C. TEMP.		SS6	5 1/2"	STAIR SLAB. SEE DWG. S-15.	
C1S11	4 1/2"	#4 @ 10" O.C. STR. TOP, #4 @ 5" O.C. STR. BOTTOM. #3 @ 15" O.C. TEMP.	CARRY TOP & BOTTOM BARS ACROSS TO FORM REIN. FOR C1S13.				
C1S12	4"	#4 @ 10" O.C. STR. TOP, #4 @ 8" O.C. STR. BOTTOM. #3 @ 15" O.C. TEMP.					
C1S13	4"	TOP & BOTTOM BARS FROM C1S11.	SEE SECTION IN DWG. S-9.				

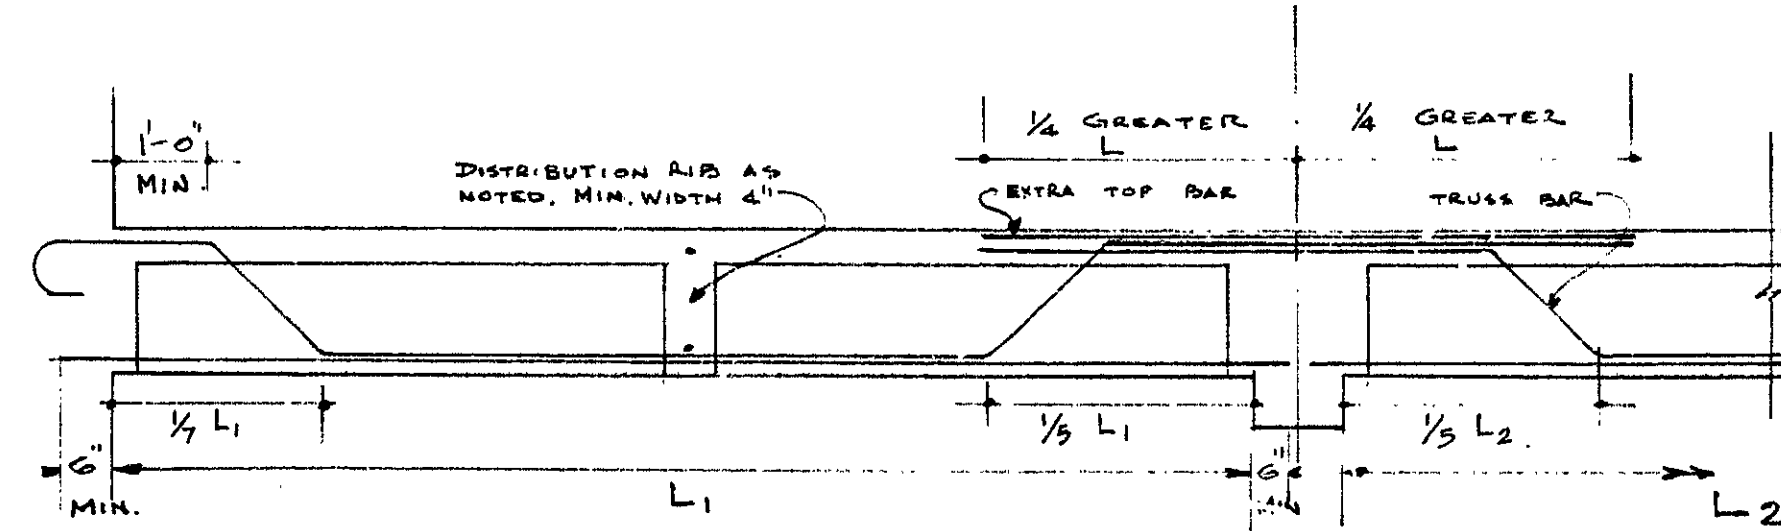


BAR BENDING DIAGRAM FOR R.C. RIBS. NOT TO SCALE.

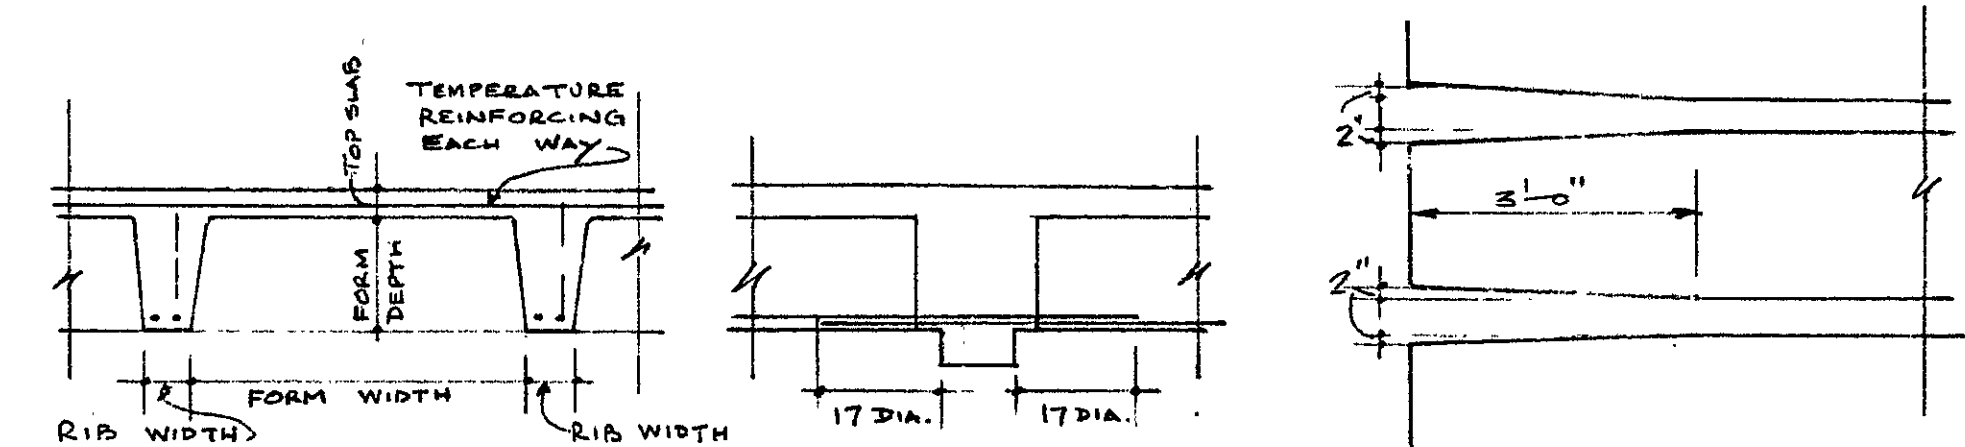

VARIOUS DETAILS OF R.C. RIB SLABS. NOT TO SCALE.

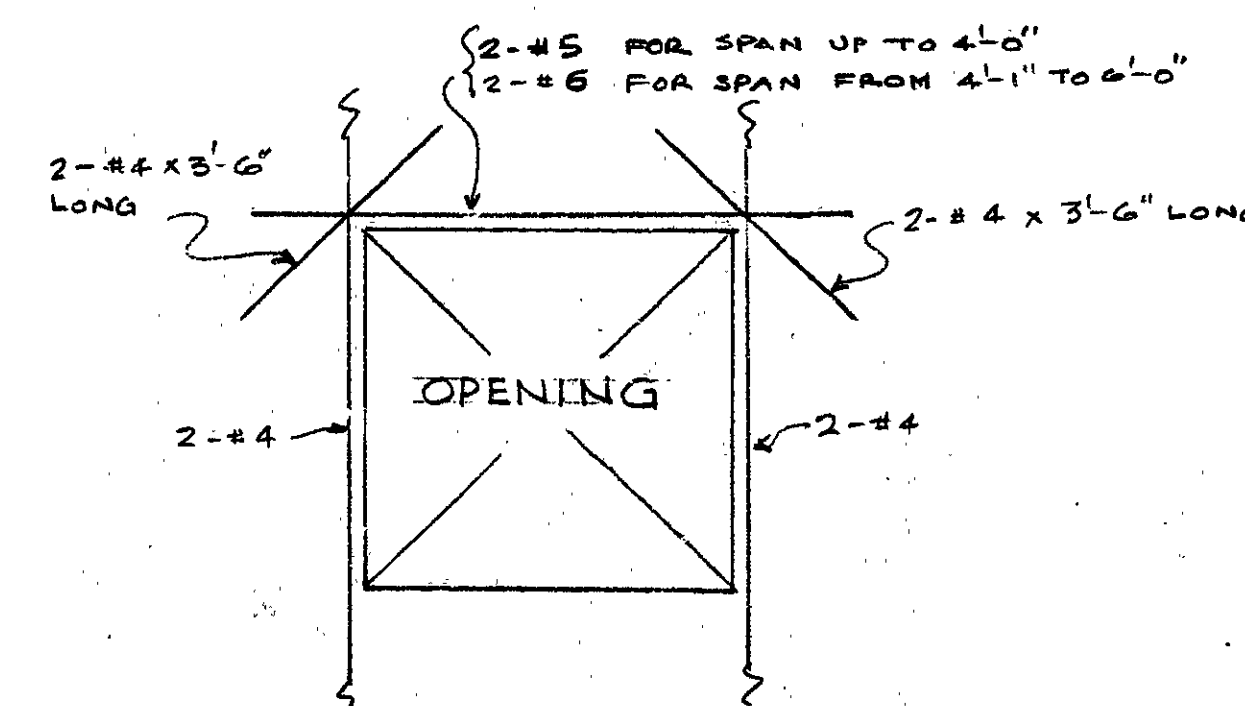

REINFORCING AROUND OPENING IN R.C. WALLS. NOT TO SCALE.

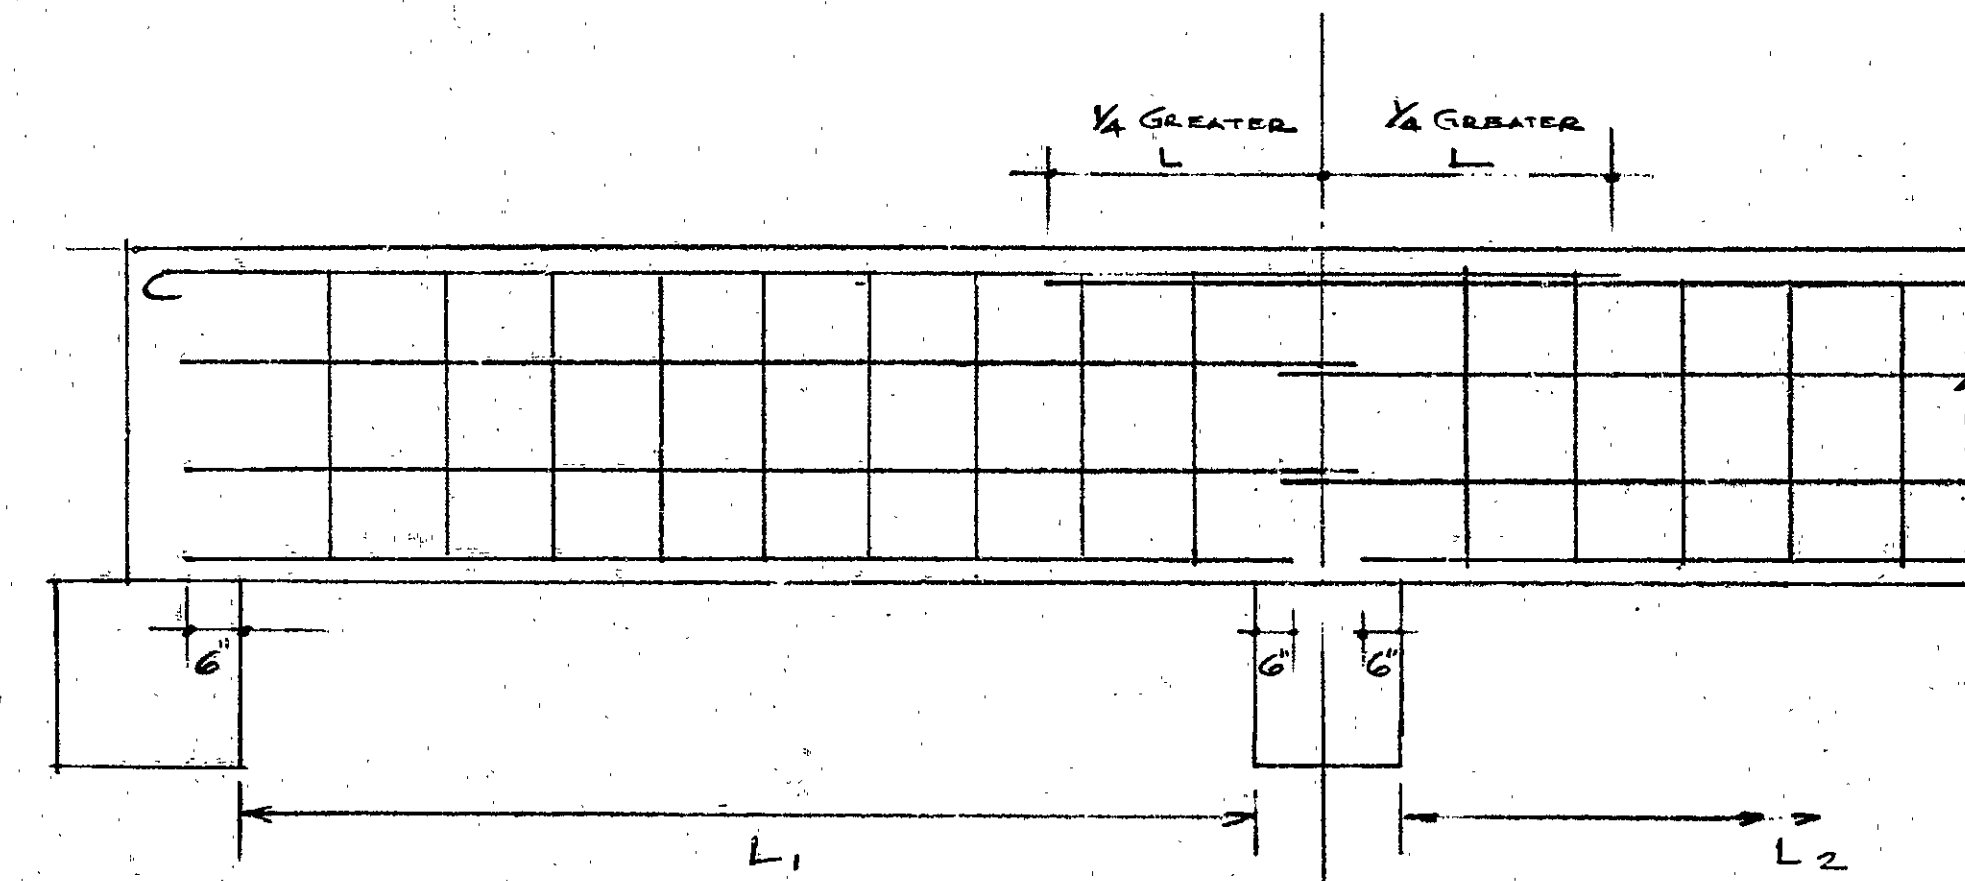

ARRANGEMENT OF STEEL IN DEEP BEAMS.

LINTEL SCHEDULE


MARK.	DETAIL.	REINFORCING.	REMARKS.
L1		8" x 8" R.C. LINTEL. 2-#4 STR. TOP & BOTTOM. 1-5" x 3 1/2" x 3/4" L (LOOSE).	FOR EXTERIOR OPENING UP TO 4'-0" SPAN. MIN. END BEARING = 6".
L2		8" x 12" R.C. LINTEL. 2-#6 STR. TOP & BOTTOM. 1-5" x 3 1/2" x 3/4" L (ANCHORED AT MID-POINT) #2 STIRR. @ 8" O.C.	FOR EXTERIOR OPENING FROM 4'-1" TO 8'-0" SPAN. MIN. END BEARING = 8".
L3		4" x 6" x 8" R.C. LINTEL. 1-#4 STR. TOP & BOTTOM.	FOR INTERIOR OPENING UP TO 4'-0" SPAN. MIN. END BEARING = 6".
L4		4" x 6" x 12" R.C. LINTEL. 1-#6 STR. TOP & BOTTOM.	FOR INTERIOR OPENING FROM 4'-1" TO 8'-0" SPAN. MIN. END BEARING = 8".
L5		8" x 10" x 8" R.C. LINTEL. 2-#5 STR. TOP & BOTTOM.	FOR INTERIOR OPENING UP TO 4'-0" SPAN. MIN. END BEARING = 6".
L6		8" x 10" x 12" R.C. LINTEL. 2-#6 STR. TOP & BOTTOM. #2 STIRR. @ 8" O.C.	FOR INTERIOR OPENING FROM 4'-1" TO 8'-0" SPAN. MIN. END BEARING = 8".

GENERAL NOTES:-

- ALL CONCRETE TO HAVE A COMPRESSIVE STRENGTH OF 3000 P.S.I. AT 28 DAYS.
- ALL REINFORCING STEEL TO BE INTERMEDIATE OR HARD GRADE DEFORMED BARS.
- LAP ALL VERTICAL & HORIZONTAL BARS 20 DIA. AT ALL CORNERS & SPLICES IN WALLS.
- FILL ALL JOINTS OF BLOCK WALL FOR 2 CONSECUTIVE COURSES, IF BEARING IS CALLED FOR.
- REINFORCEMENT NOT SHOWN IN WALLS, BEAMS, OR SLABS IS IDENTICAL TO THAT GIVEN FOR WALLS, BEAMS, OR SLABS OF SIMILAR DIMENSIONS ELSEWHERE IN SECTIONS OR SCHEDULES.
- BEAMS & SLABS MAY BEAR IDENTICAL MARKS HAVE SIMILAR CROSS-SECTIONAL DIMENSIONS, AND TYPE OF REINFORCEMENT, BUT SPANS MAY VARY RESULTING IN VARIATION OF OVERALL LENGTHS OF BARS.
- FOR FLOOR DRAINS & ROSE HOPPERES CONSULT ARCHITECTURAL DWGS.
- FOR EQUIPMENT OPENINGS CONSULT MECHANICAL DWGS.
- SUBMIT SHOP DWGS. OF MONORAIL DETAILS FOR APPROVAL.
- PROVIDE SUPPORTS FOR ELEVATOR GUIDE RAIL BRACKETS AT EACH FLOOR LEVEL AND ROOF. MAX. VERTICAL SPACING 7'-0". CONSULT ELEVATOR CONTRACTOR FOR EXACT LOCATIONS AND DETAILS.
- REFER TO SCHEDULES FOR BEAM & SLAB REINFORCEMENTS NOT SHOWN.
- COVER TO REINFORCEMENT SHALL COMPLY WITH THE NATIONAL BUILDING CODE, 1961 E.D.
- FOR DETAILS OF EXPANSION JOINTS SEE ARCH. DWGS. A-5 & A-17.
- PROVIDE WATERPROOF MEMBRANE AS SPECIFIED AND INDICATED IN ARCH. DETAILS.

REVISIONS		DEPARTMENT OF PUBLIC WORKS OF CANADA			
DATE	RECORD	BUILDING CONSTRUCTION BRANCH		E. A. GARDNER CHIEF ARCHITECT	
SAINT JOHN'S, N.F.L.D.					
SHOPS, STORES, & ADMINISTRATION BLDG. (DOW)					
SLAB & LINTEL SCHEDULES, GENERAL NOTES.					
DESIGNED BY: D.L.	CHECKED BY: RP	APPROVED BY: M.A.W.	SCALE:	DWG. NO. 521 OF 22	
DATE: 10-9-66	DATE:	DATE: 10-9-66	DATE:	JOB NO. CA 61-1-13/66	

G-CA-61-1-13/44 MICROFILMED.

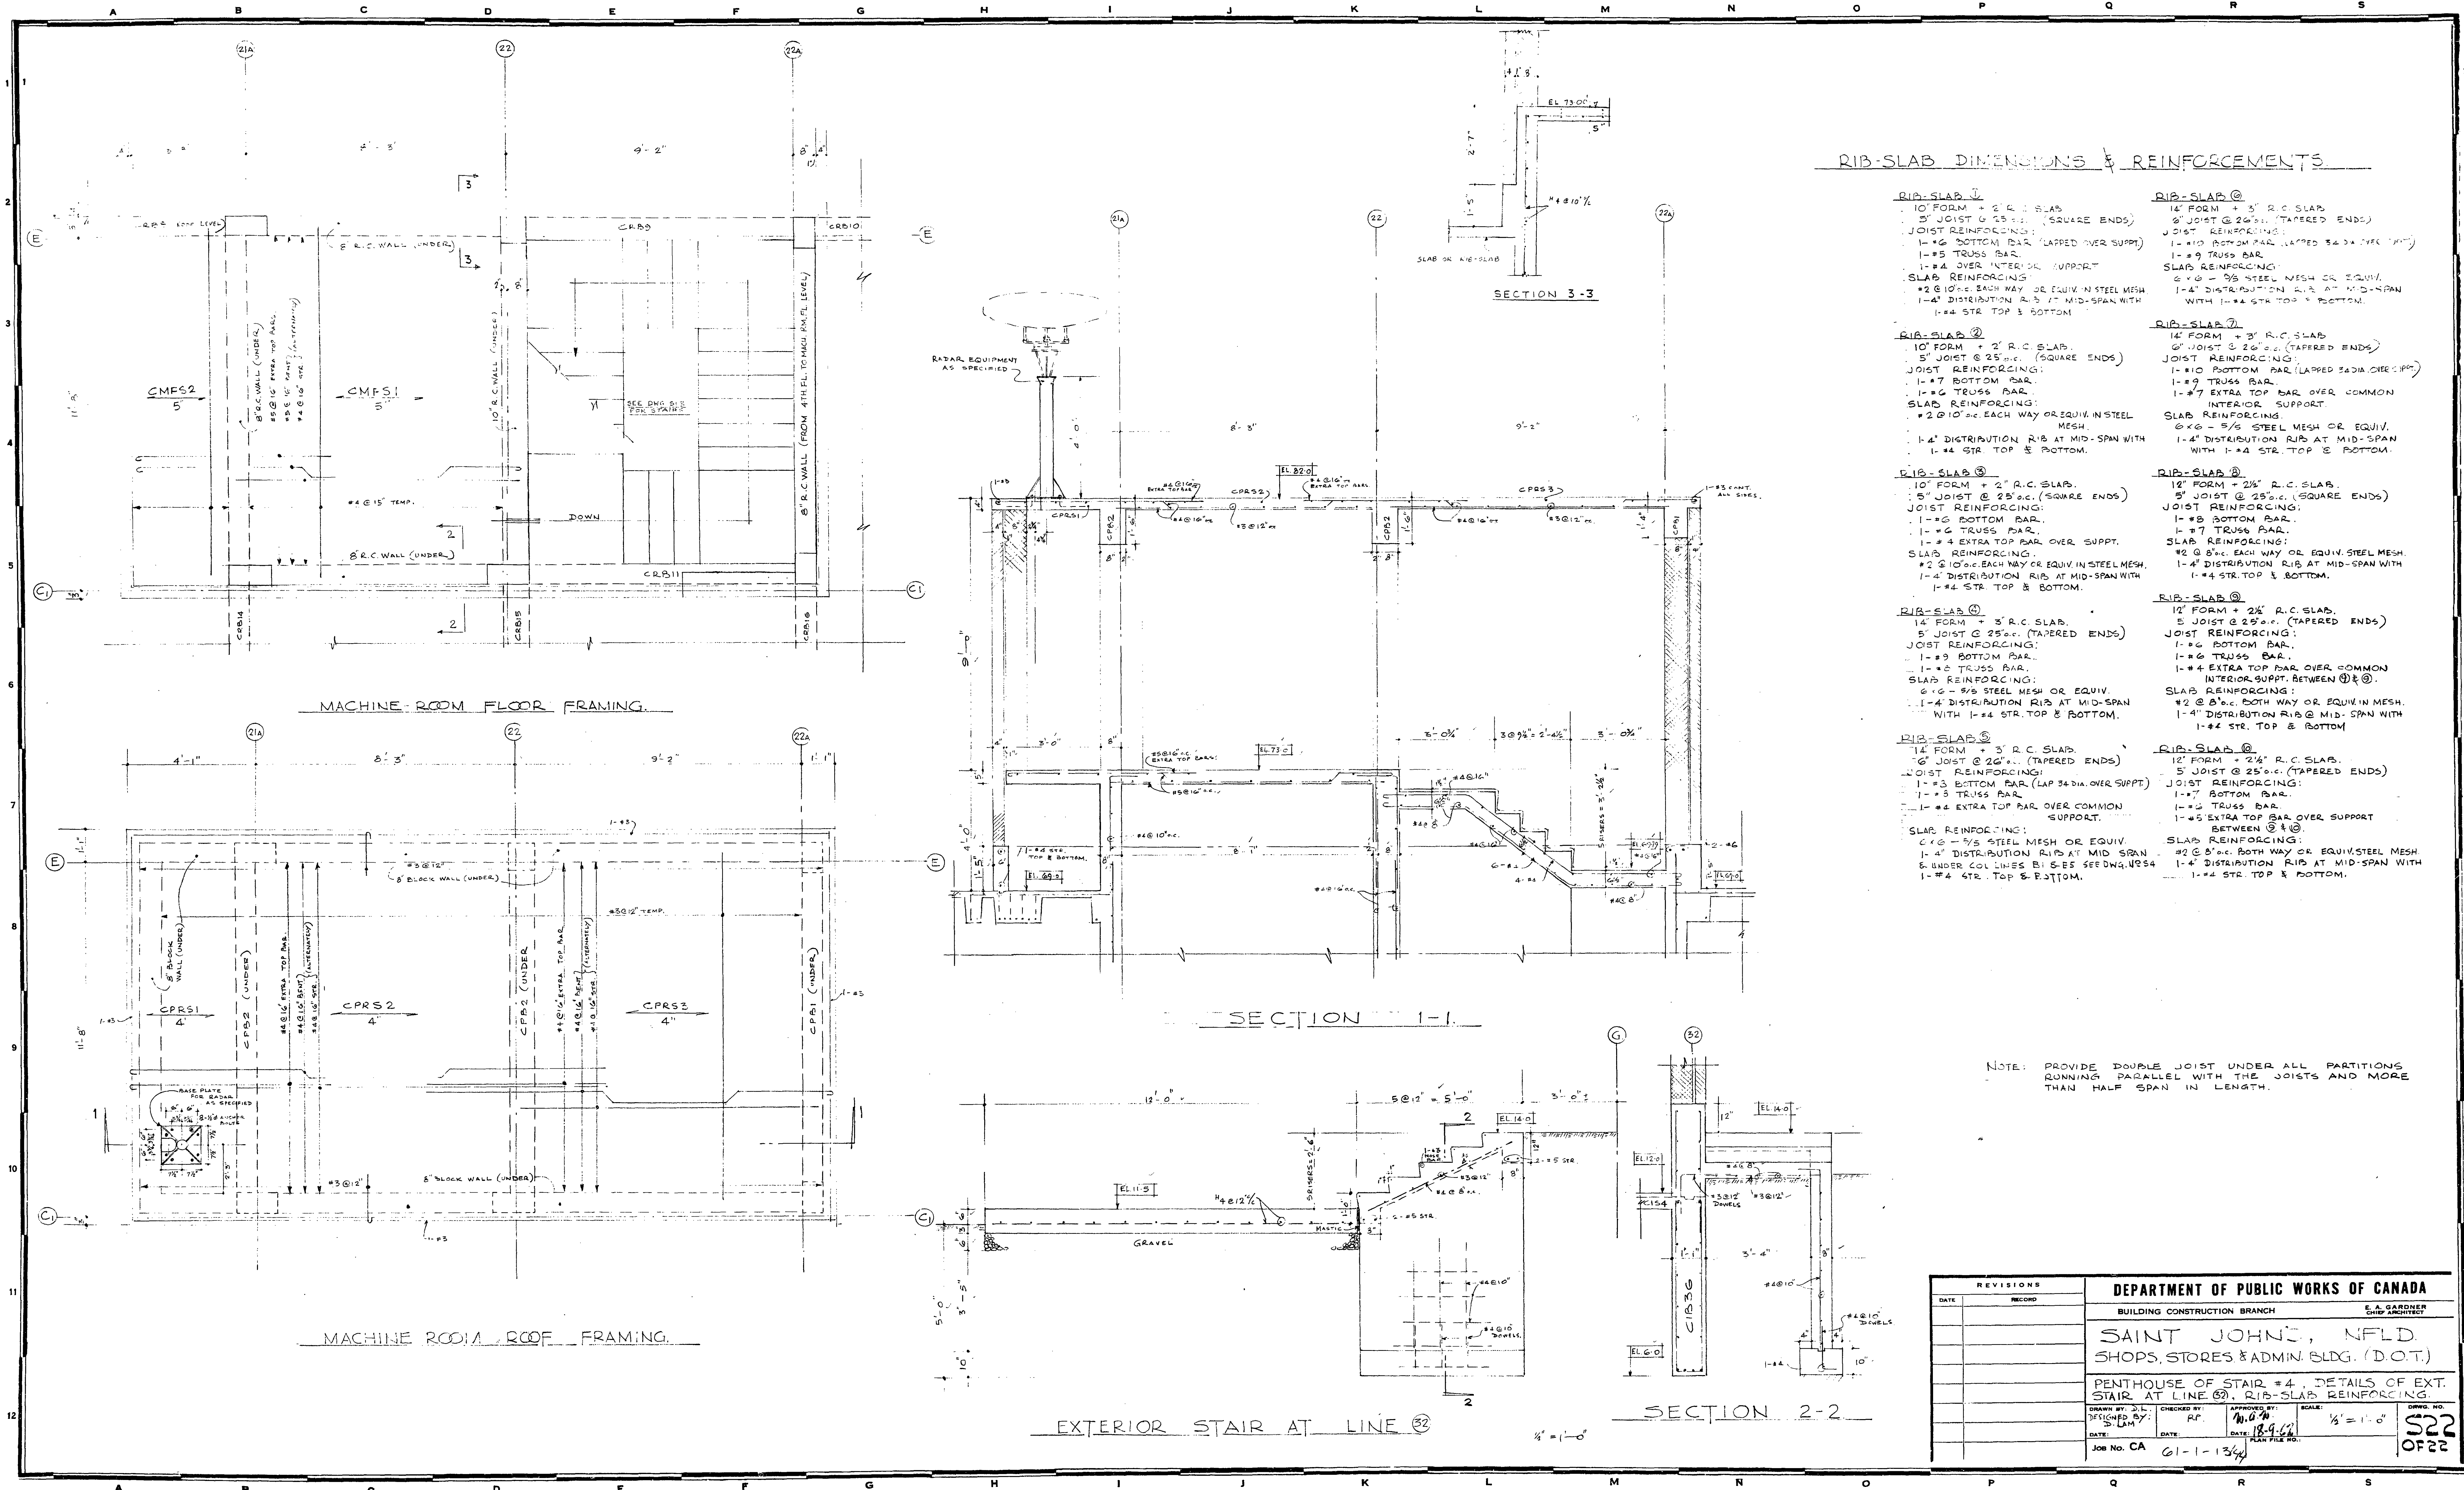

RIB-SLAB DIMENSIONS & REINFORCEMENTS

- RIB-SLAB ①**
- 10' FORM + 2" R.C. SLAB
 - 5" JOIST @ 25" o.c. (SQUARE ENDS)
 - JOIST REINFORCING:
 - 1-#6 BOTTOM BAR (LAPPED OVER SUPPT)
 - 1-#5 TRUSS BAR
 - 1-#4 OVER INTERIOR SUPPORT
 - SLAB REINFORCING:
 - 2 @ 10" o.c. EACH WAY OR EQUIV. STEEL MESH
 - 1-#4 DISTRIBUTION RIB AT MID-SPAN WITH 1-#4 STR. TOP & BOTTOM
- RIB-SLAB ②**
- 10' FORM + 2" R.C. SLAB
 - 5" JOIST @ 25" o.c. (SQUARE ENDS)
 - JOIST REINFORCING:
 - 1-#6 BOTTOM BAR
 - 1-#5 TRUSS BAR
 - 1-#4 EXTRA TOP BAR OVER SUPPT.
 - SLAB REINFORCING:
 - 2 @ 10" o.c. EACH WAY OR EQUIV. STEEL MESH
 - 1-#4 DISTRIBUTION RIB AT MID-SPAN WITH 1-#4 STR. TOP & BOTTOM
- RIB-SLAB ③**
- 10' FORM + 2" R.C. SLAB
 - 5" JOIST @ 25" o.c. (SQUARE ENDS)
 - JOIST REINFORCING:
 - 1-#6 BOTTOM BAR
 - 1-#5 TRUSS BAR
 - 1-#4 EXTRA TOP BAR OVER SUPPT.
 - SLAB REINFORCING:
 - 2 @ 10" o.c. EACH WAY OR EQUIV. STEEL MESH
 - 1-#4 DISTRIBUTION RIB AT MID-SPAN WITH 1-#4 STR. TOP & BOTTOM
- RIB-SLAB ④**
- 10' FORM + 2" R.C. SLAB
 - 5" JOIST @ 25" o.c. (SQUARE ENDS)
 - JOIST REINFORCING:
 - 1-#6 BOTTOM BAR
 - 1-#5 TRUSS BAR
 - 1-#4 EXTRA TOP BAR OVER SUPPT.
 - SLAB REINFORCING:
 - 2 @ 10" o.c. EACH WAY OR EQUIV. STEEL MESH
 - 1-#4 DISTRIBUTION RIB AT MID-SPAN WITH 1-#4 STR. TOP & BOTTOM
- RIB-SLAB ⑤**
- 10' FORM + 2" R.C. SLAB
 - 5" JOIST @ 25" o.c. (SQUARE ENDS)
 - JOIST REINFORCING:
 - 1-#6 BOTTOM BAR
 - 1-#5 TRUSS BAR
 - 1-#4 EXTRA TOP BAR OVER SUPPT.
 - SLAB REINFORCING:
 - 2 @ 10" o.c. EACH WAY OR EQUIV. STEEL MESH
 - 1-#4 DISTRIBUTION RIB AT MID-SPAN WITH 1-#4 STR. TOP & BOTTOM
- RIB-SLAB ⑥**
- 10' FORM + 2" R.C. SLAB
 - 5" JOIST @ 25" o.c. (SQUARE ENDS)
 - JOIST REINFORCING:
 - 1-#6 BOTTOM BAR
 - 1-#5 TRUSS BAR
 - 1-#4 EXTRA TOP BAR OVER SUPPT.
 - SLAB REINFORCING:
 - 2 @ 10" o.c. EACH WAY OR EQUIV. STEEL MESH
 - 1-#4 DISTRIBUTION RIB AT MID-SPAN WITH 1-#4 STR. TOP & BOTTOM
- RIB-SLAB ⑦**
- 10' FORM + 2" R.C. SLAB
 - 5" JOIST @ 25" o.c. (SQUARE ENDS)
 - JOIST REINFORCING:
 - 1-#6 BOTTOM BAR
 - 1-#5 TRUSS BAR
 - 1-#4 EXTRA TOP BAR OVER SUPPT.
 - SLAB REINFORCING:
 - 2 @ 10" o.c. EACH WAY OR EQUIV. STEEL MESH
 - 1-#4 DISTRIBUTION RIB AT MID-SPAN WITH 1-#4 STR. TOP & BOTTOM
- RIB-SLAB ⑧**
- 10' FORM + 2" R.C. SLAB
 - 5" JOIST @ 25" o.c. (SQUARE ENDS)
 - JOIST REINFORCING:
 - 1-#6 BOTTOM BAR
 - 1-#5 TRUSS BAR
 - 1-#4 EXTRA TOP BAR OVER SUPPT.
 - SLAB REINFORCING:
 - 2 @ 10" o.c. EACH WAY OR EQUIV. STEEL MESH
 - 1-#4 DISTRIBUTION RIB AT MID-SPAN WITH 1-#4 STR. TOP & BOTTOM
- RIB-SLAB ⑨**
- 10' FORM + 2" R.C. SLAB
 - 5" JOIST @ 25" o.c. (SQUARE ENDS)
 - JOIST REINFORCING:
 - 1-#6 BOTTOM BAR
 - 1-#5 TRUSS BAR
 - 1-#4 EXTRA TOP BAR OVER SUPPT.
 - SLAB REINFORCING:
 - 2 @ 10" o.c. EACH WAY OR EQUIV. STEEL MESH
 - 1-#4 DISTRIBUTION RIB AT MID-SPAN WITH 1-#4 STR. TOP & BOTTOM
- RIB-SLAB ⑩**
- 10' FORM + 2" R.C. SLAB
 - 5" JOIST @ 25" o.c. (SQUARE ENDS)
 - JOIST REINFORCING:
 - 1-#6 BOTTOM BAR
 - 1-#5 TRUSS BAR
 - 1-#4 EXTRA TOP BAR OVER SUPPT.
 - SLAB REINFORCING:
 - 2 @ 10" o.c. EACH WAY OR EQUIV. STEEL MESH
 - 1-#4 DISTRIBUTION RIB AT MID-SPAN WITH 1-#4 STR. TOP & BOTTOM

NOTE: PROVIDE DOUBLE JOIST UNDER ALL PARTITIONS RUNNING PARALLEL WITH THE JOISTS AND MORE THAN HALF SPAN IN LENGTH.

REVISIONS		DEPARTMENT OF PUBLIC WORKS OF CANADA	
DATE	RECORD	BUILDING CONSTRUCTION BRANCH	E.A. GARDNER CHIEF ARCHITECT
		SAINT JOHN'S, Nfld.	
		SHOPS, STORES & ADMIN. BLDG. (D.O.T.)	
		PENTHOUSE OF STAIR #4, DETAILS OF EXT. STAIR AT LINE 69, RIB-SLAB REINFORCING	
DESIGNED BY	DATE	CHECKED BY	DATE
DATE	DATE	DATE	DATE
JOB NO. CA 61-1-13/44		SCALE 1/8" = 1'-0"	
		S22 OF 22	