


Em. Cy Generator Room

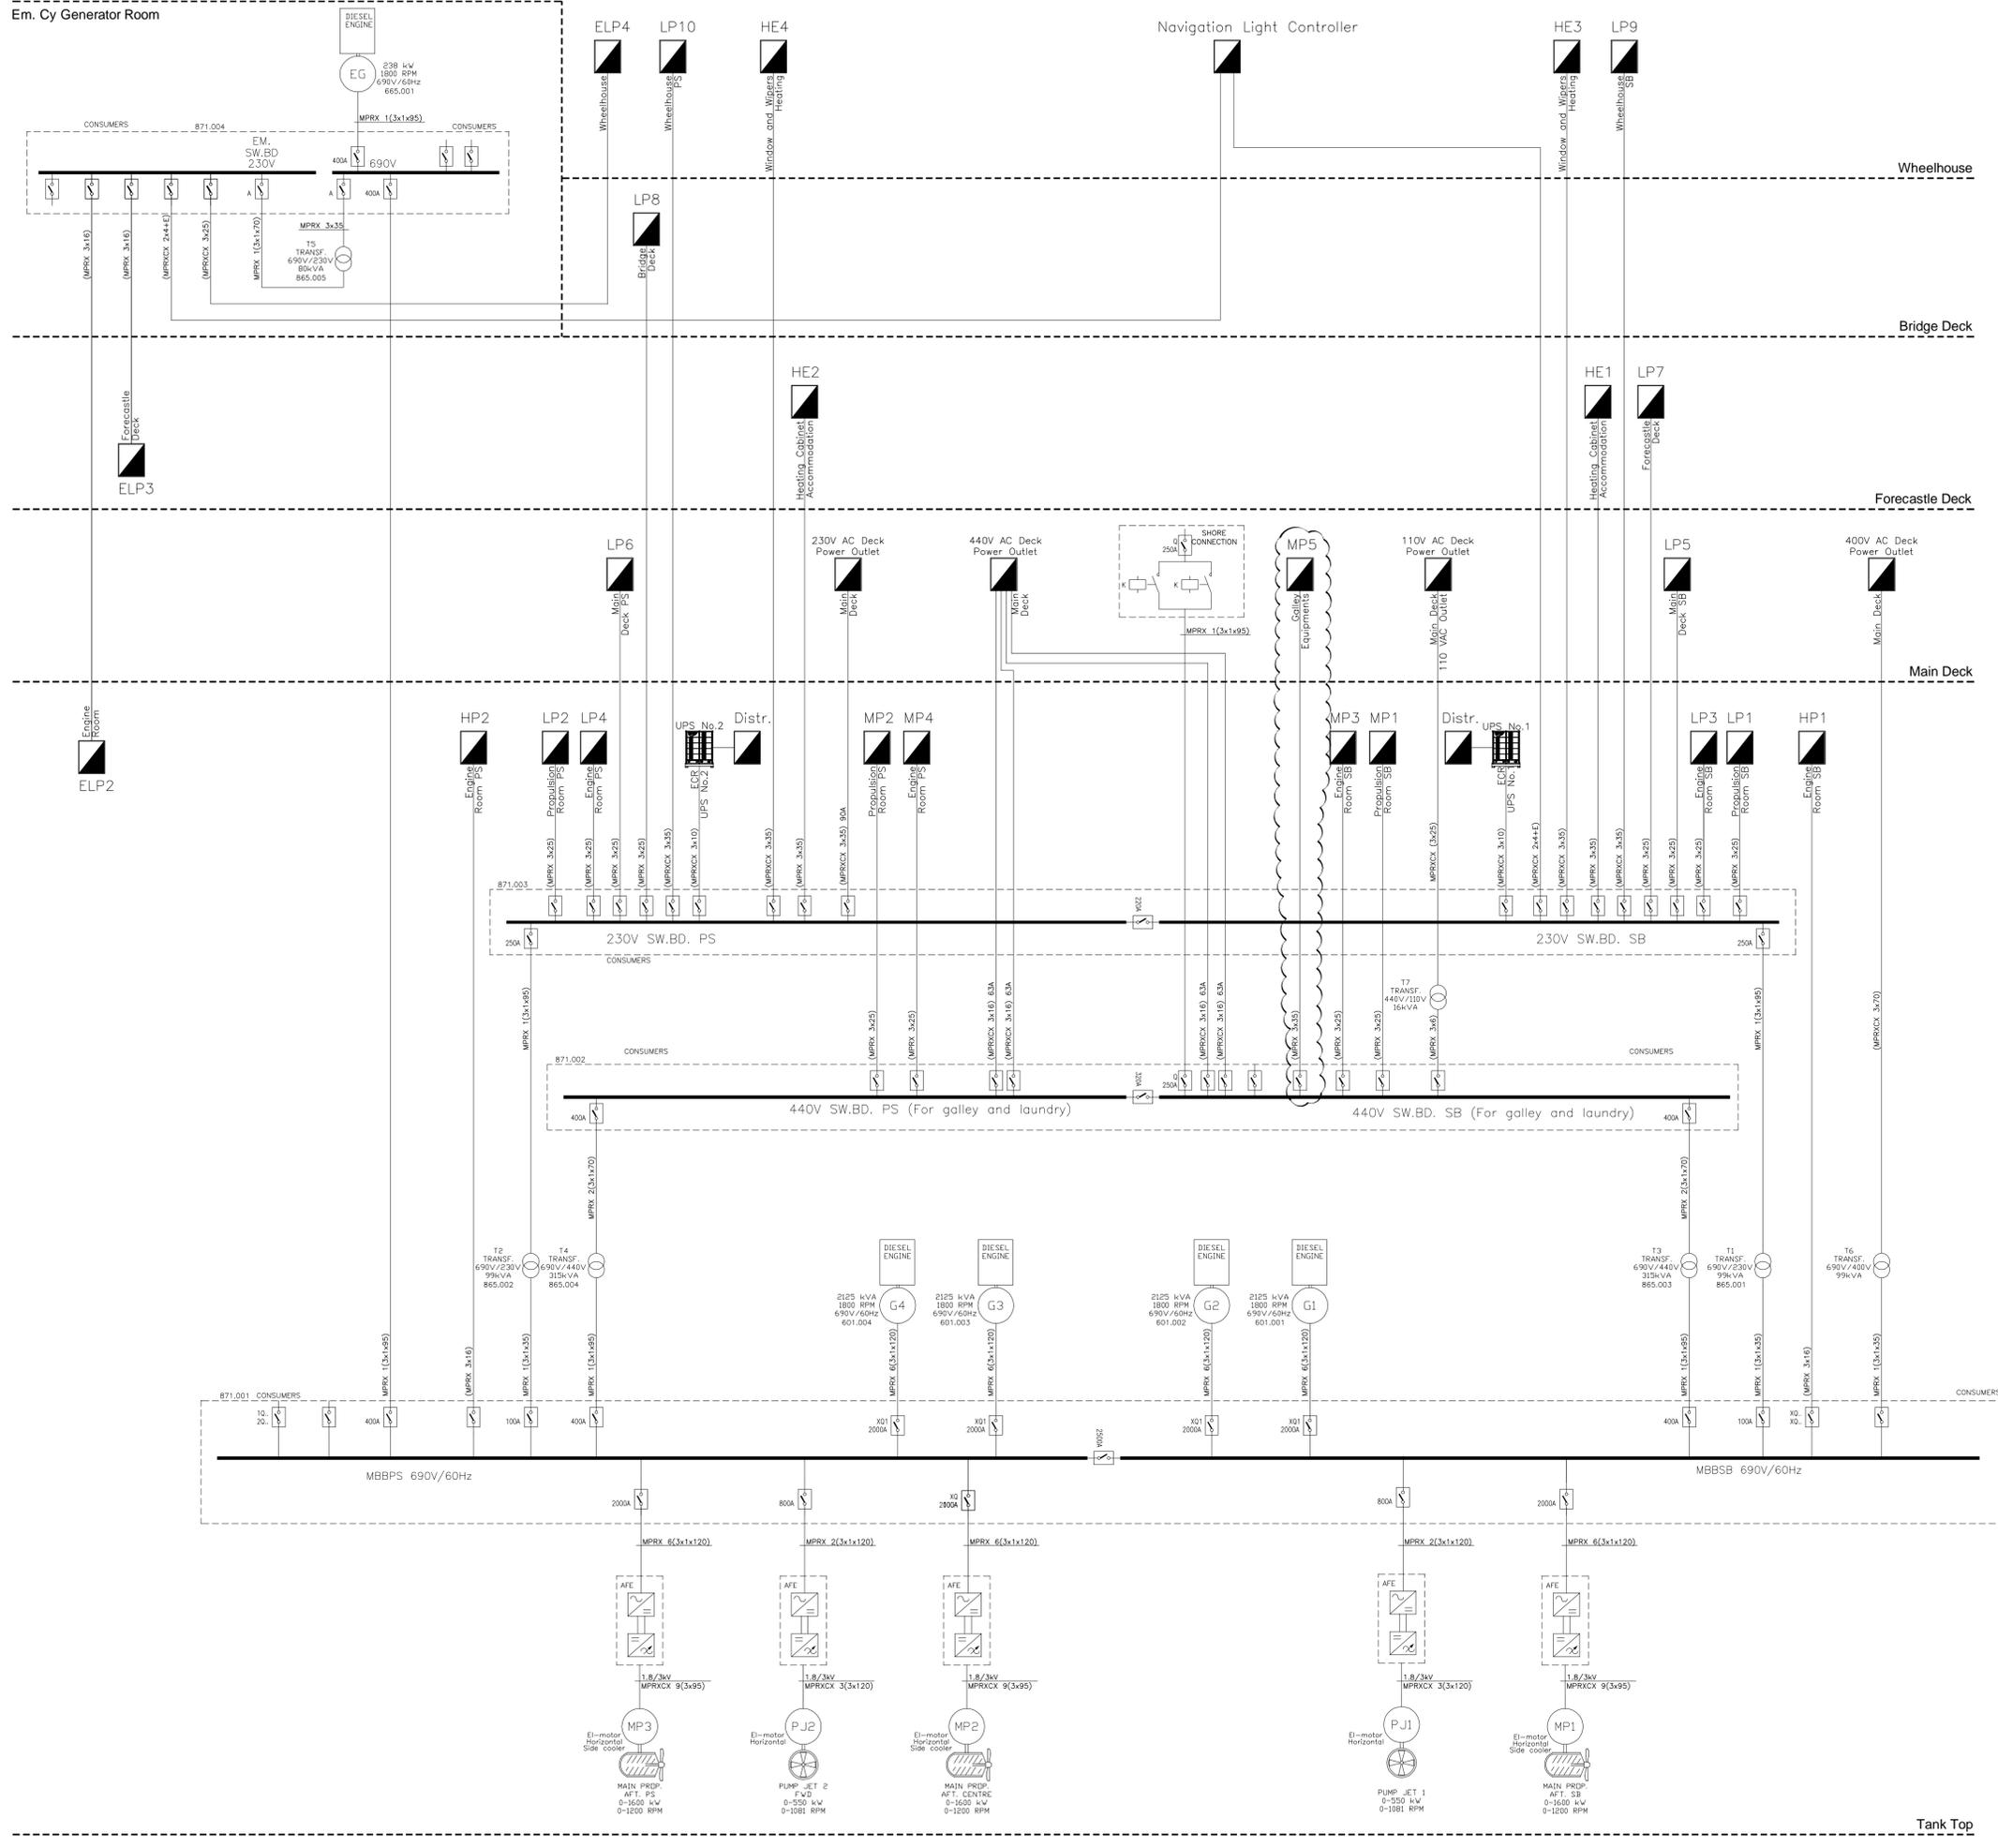

- T1 to T6 Transformers
- LP1 LP1 to LP10
230V AC Normal supply Subdistribution Cabinets
- ELP4 ELP2 to ELP4
230V AC Emergency supply Subdistribution Cabinets
- MP4 MP1 to MP5
440V AC Normal supply Subdistribution Cabinets
- HP1 HP1, HP2
690V AC Normal supply Subdistribution Cabinets
- HE1 HE1 to HE4
230V AC Normal supply Subdistribution Cabinets
Electrical Heating
- Drives

B	As Built. Moved MP5 from SB to PS.	07.07.10	CBG
A	Updated acc. owner comments.	08.01.10	CBG
FILE:	SHEET: 1 of 1	ACCORDING TO INTERNATIONAL LAWS, THIS DRAWING IS THE PROPERTY OF STX Norway Electro AS. THE DRAWING CAN NOT BE MADE PUBLIC, COPIED OR OTHERWISE USED, WITHOUT OUR WRITTEN CONSENT.	
DRAWN: CBG	DATE: 01.10.2009	SCALE: %	DWG. NO. 740-870-070
CHECKED:	DATE:	%	B
VERIFIED:	DATE:	TITLE: Main One Line Diagram 690V, 440V, 230V	
HRD: STX RO Offshore Bralla SA	ADDRESS:	TEL: FAX:	FORW: A1 PROJECT: 78258 DESIG: ARC 104