
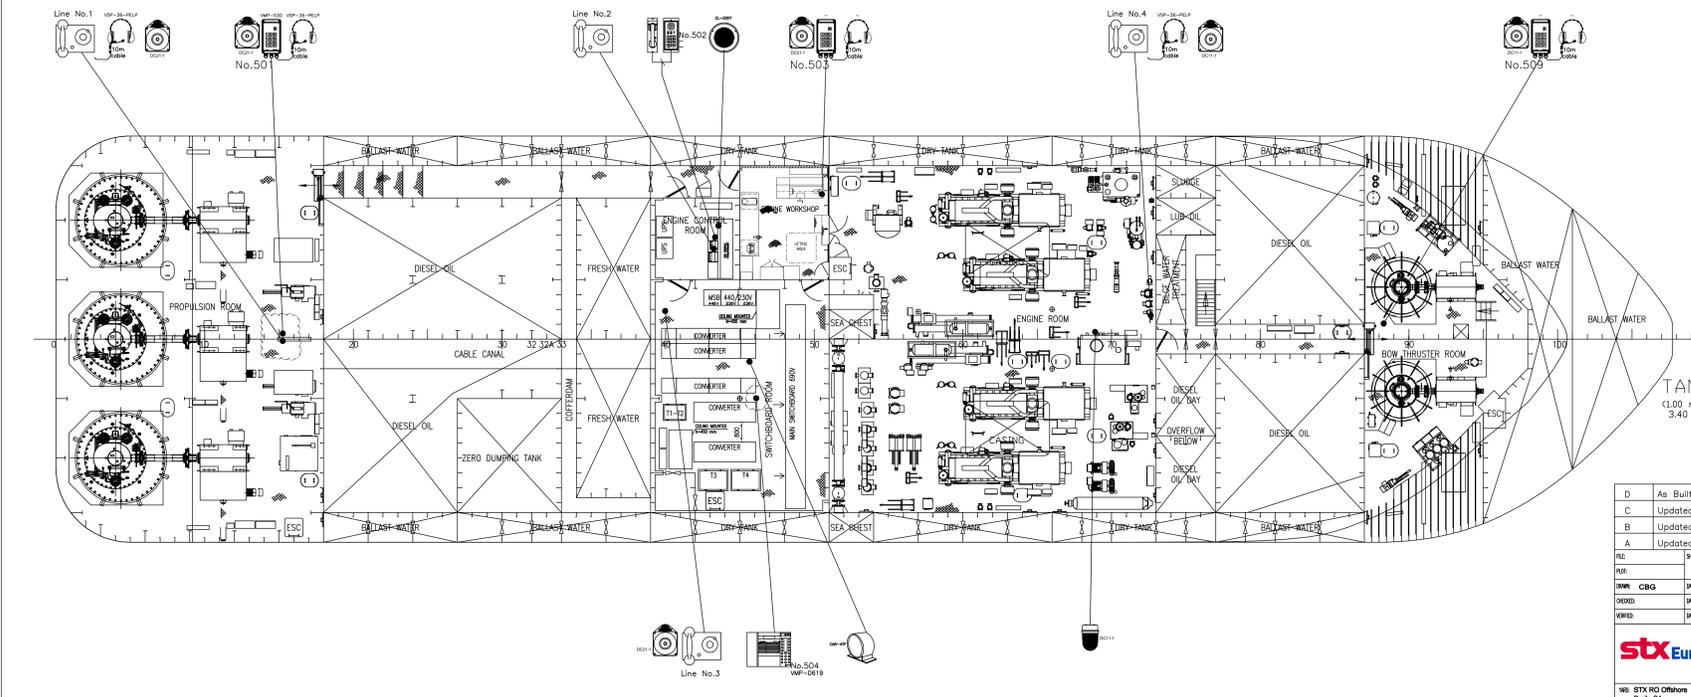
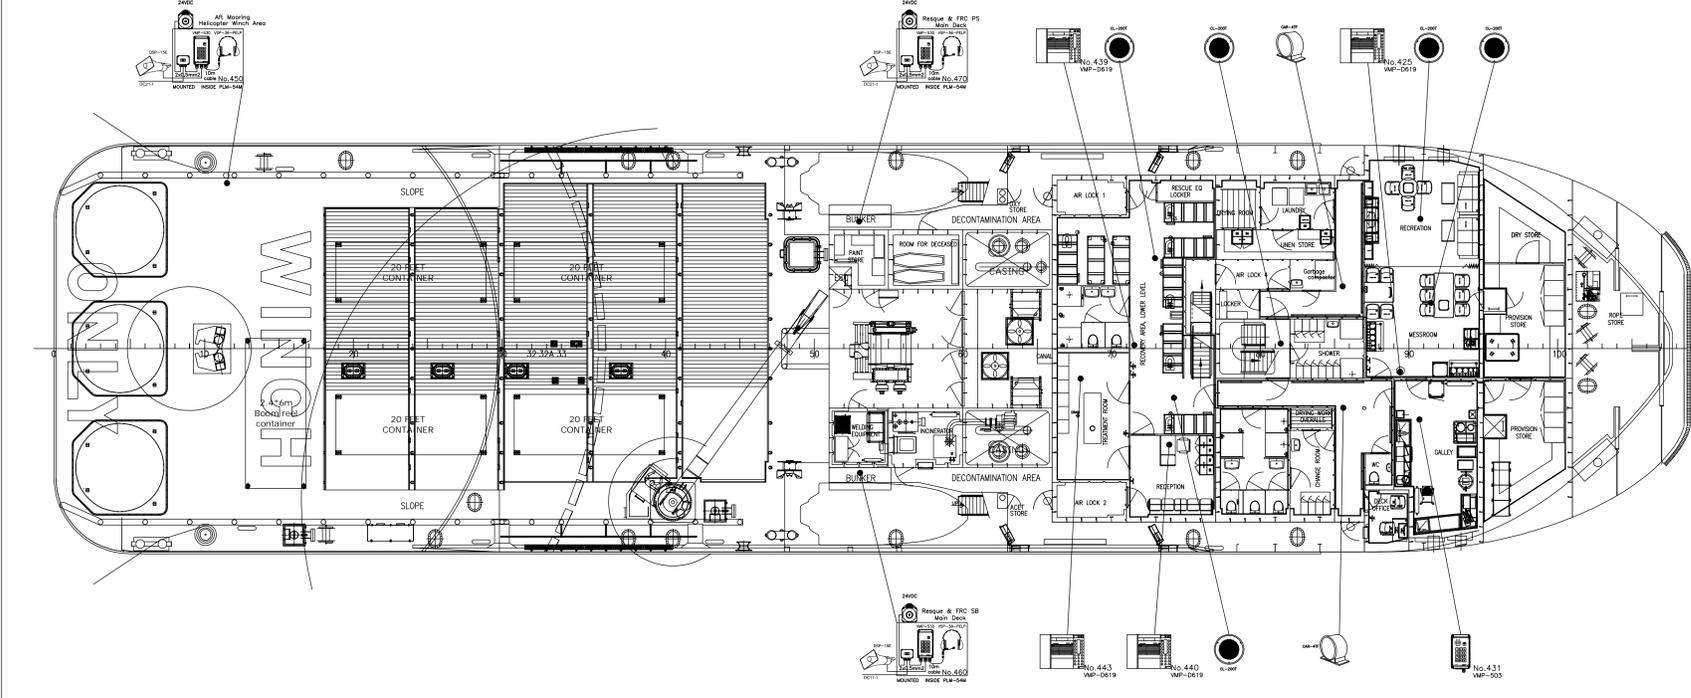
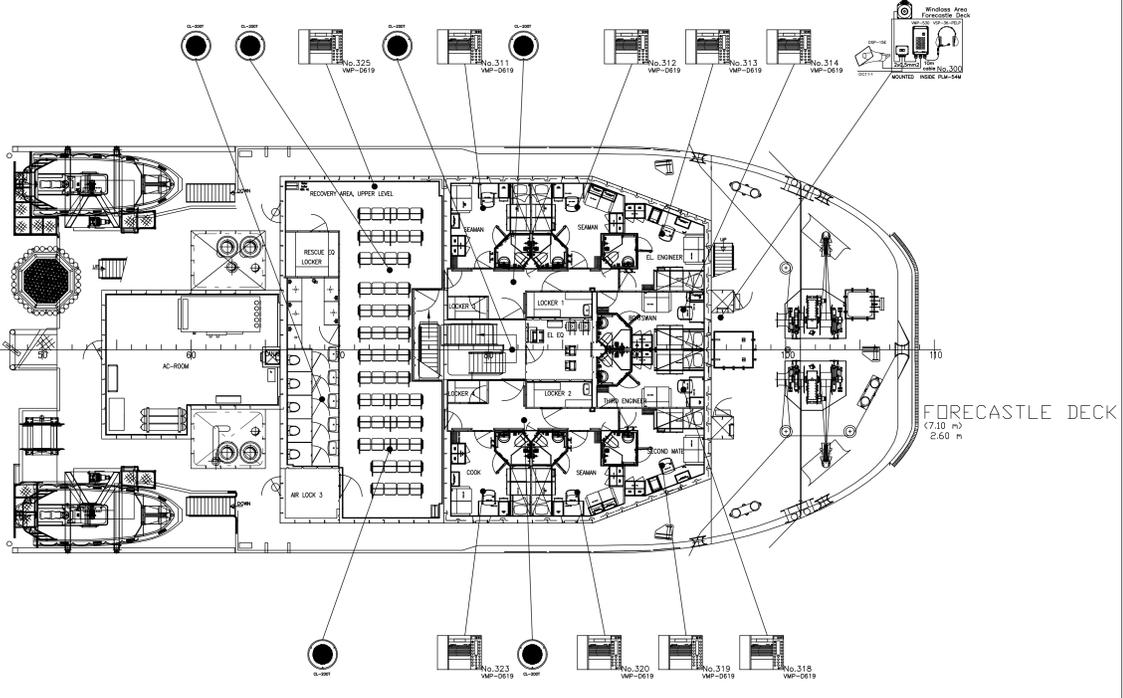
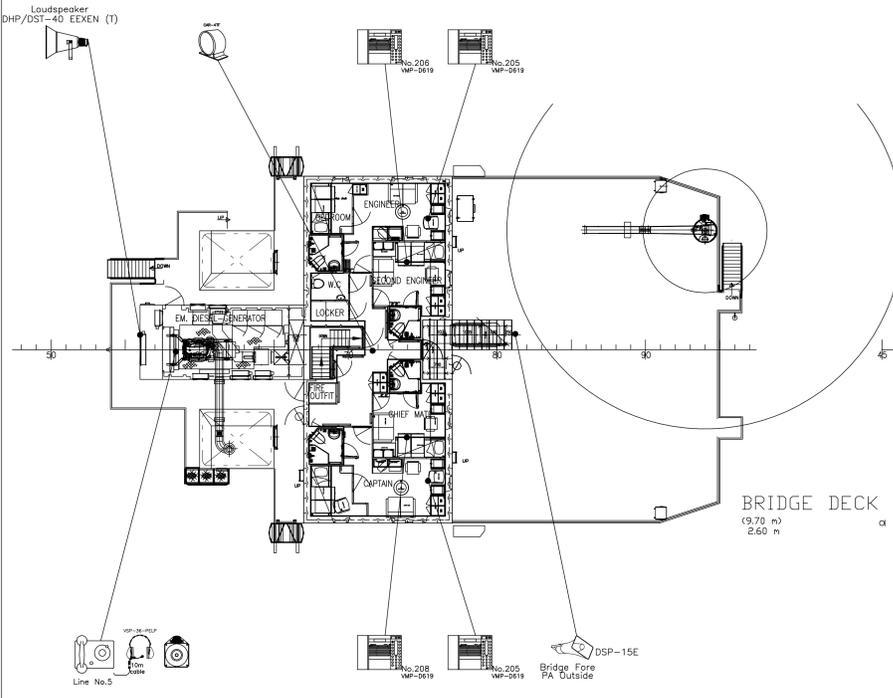


| SYMBOL | QTY | DESCRIPTION | TYPE |
|--------|-----|--|-----------------------|
| | 18 | WALLMOUNTED DESKTOP MOD. USED IN CABINS, MESSROOMS, OFFICES ETC. | VINGTOR VMP-6615 |
| | 5 | PANELMOUNTED MODEL WITH HANDSET USED ON BRIDGE & IN ENG. CONTR. ROOM VINGTOR VMP-430 MOUNTED TOGETHER WITH VMP-221 | VMP-221 |
| | 1 | WALLMOUNTED DESK TOP MOD. WATERPROOF. USED IN GALLEY VINGTOR VMP-503 | VMP-503 |
| | 3 | WATERPROOF WALLMOUNTED TELEPHONE WITH HEADSET. USED IN ENGINE ROOM SPACES ETC. VINGTOR TYPE VMP-530 + VMP-36-PELP | VMP-530 + VMP-36-PELP |
| | 1 | Rotating Light Blue 24VDC Technical Spaces | |
| | 3 | CHASSIS CONTACT SPIN DIN FOR ETC-1-TB W/1M CABLE | |
| | 3 | HAND MICROPHONE W/5 PIN DIN-PLUG | |
| | 4 | RELAYBOX 24V DC OR 220V AC-SIGNAL UNIT-IP-66 IRR3 | |
| | 7 | Combinated Alarm Sound and Blue light for Intercom system 24Vdc Nexus 105 - Klaxon (10000490) | |
| | 14 | CEILING LOUDSPEAKER WITH STEEL FIRE DOME 5W, IP-44 | |
| | 1 | DST-40 EEXen (T) DNH powerful 40W driver unit ATEX approved. Combined with DNH different screens this driver unit will cover large areas. | |
| | 1 | HORN FOR DST-40 EEXen (T), WATERIGHT - IP-67 | |
| | 1 | DSP-15EEXen EX SPEAKER 20 OHM 15W W/2 CAB INLETS. ATEX APPROVED WT IP67 | |
| | 4 | CAR-4TF WALL DOUBLE FACED LOUDSPEAKER, 4W - W/FUSE | |
| | 4 | WATERPROOF WALLMOUNTED TELEPHONE WITH HEADSET PLACED INSIDE COMPOSIT CABINET. USED OUTSIDE VMP-530 + VMP-36-PELP + PLM-54M + DSP-15EEXen + IRR-3. | |
| | 7 | BATTERYLESS TELEPHONE SYSTEM VSP-36-PELP Head Set 10 m for Battery less Telephone Propulsion Room Engine Room Em./Harbour Generator Room | |
| | 3 | VSP-36-PELP Head Set 10 m for Battery less Telephone Propulsion Room Engine Room Em./Harbour Generator Room | |
| | 4 | Combinated Alarm Sound and Green light for Sound Powered Telephone 24Vdc Nexus 105 - Klaxon 6222756(El. No.) Propulsion Room, Saltboard Room, Engine Room Em./Harbour Generator Room | |

Note*

- Combi Alarm Sound and Light Intercom/Calling Blue Color
- Combi Alarm Sound and Light Battery Less Telephones Green Color

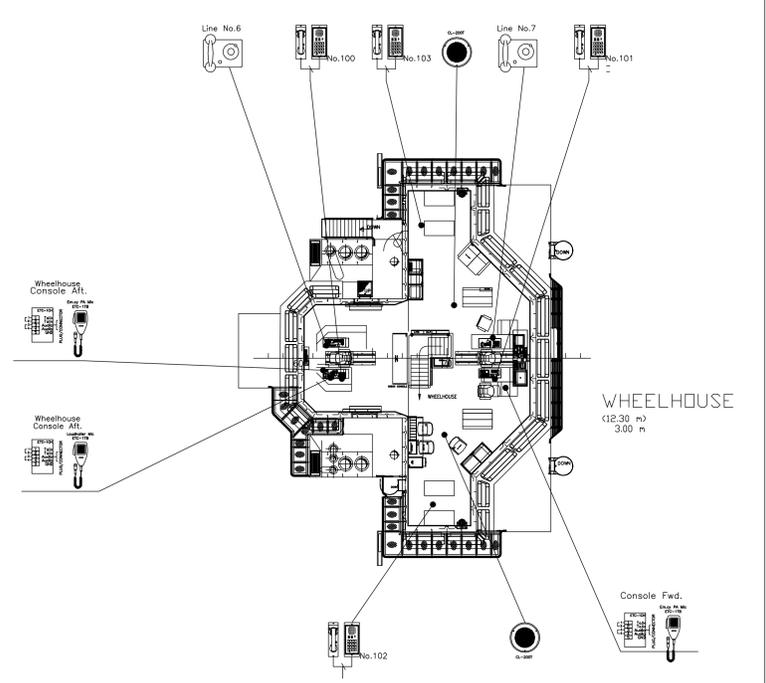

| REV. | DATE | DESCRIPTION | BY |
|------|----------|---------------------------------------|-----|
| D | 21.07.10 | As Built. | CBG |
| C | 04.01.10 | Updated Combi Alarm Type, Updated GA. | CBG |
| B | 08.12.09 | Updated Sound Powered Telephone | CBG |
| A | 23.11.09 | Updated According to owner remarks. | CBG |

| | |
|-----------|--|
| SCALE: | 1:100 |
| PROJECT: | 740-894-085 D |
| CLIENT: | STX Norway Electro AS |
| DESIGNER: | Location of Internal Communication Equipments GA |
| DATE: | 24.07.09 |
| BY: | CBG |
| CHECKED: | |
| APPROVED: | |

| | | | | | |
|-------------------|------|----------------|--------|-------------|-------------------|
| NO. STX-RO Office | BRAS | SE Positioning | NO. A0 | PRGCS 78258 | ISSA Aker ARC 104 |
|-------------------|------|----------------|--------|-------------|-------------------|

BASED ON ARR. DRAWING: 740-101-001_H_General Arrangement.dwg