


ALL PIPES ON WEATHER DECK STAINLESS STEEL (SEE NOTE 5)

COPPER TUBES		STAINLESS STEEL TUBES	
Pipe diameter	Wall thickness	Pipe diameter	Wall thickness
INCH	OD	INCH	OD
ND 15	0.223 x	SS8	1/4" 0.8
ND 20	0.269 x	SS12	3/8" 0.12
ND 25	0.317 x	SS15	1/2" 0.15
ND 32	0.424 x	SS18	1/2" 0.18
ND 40	0.483 x	SS22	3/4" 0.22
ND 50	0.603 x		
ND 65	0.761 x		
ND 80	0.899 x		
ND 100	1.143 x		
ND 125	1.397 x		
ND 150	1.683 x		
ND 200	2.191 x		

ACCORDING TO BV Rules, Pt. C, Ch. 1, Sec 10, Table 6

PIPE ID: 731P xxxxx	PIPE	WALL THICKNESS
PIPE	OD	INCHES
ND 15	0.223 x	3.6
ND 20	0.269 x	4.0
ND 25	0.317 x	4.5
ND 32	0.424 x	4.5
ND 40	0.483 x	4.5
ND 50	0.603 x	6.3
ND 65	0.761 x	6.3
ND 80	0.899 x	8.0
ND 100	1.143 x	8.8
ND 125	1.397 x	8.8
ND 150	1.683 x	10.0
ND 200	2.191 x	12.7

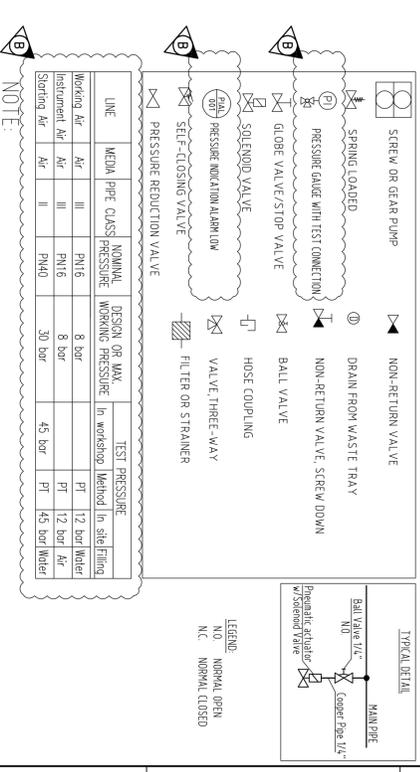

LINE	MEDIA	PIPE CLASS	NOMINAL PRESSURE	DESIGN OR MAX. WORKING PRESSURE	TEST PRESSURE	Method	In situ Filling
Working Air	Air	III	PN16	8 bar	PT	12 bar Water	
Instrument Air	Air	PN16	8 bar	8 bar	PT	12 bar Water	
Starting Air	Air	II	PN40	30 bar	PT	45 bar Water	

**SHIP DESIGN GROUP**

Naval Architects, Marine Engineers, Consultants  
 51 Doghouse Street, 80025 Gdini, Romania  
 Phone: +4 0238 478 672  
 Fax: +4 0230 460 356  
 E-mail: sdg@shipdesigngroup.ro  
 Number of Certificate Holders: 117/999/1994


**STATUS** Date: 2009-11-12

1 FOR PRELIMINARY DESIGN  2 FOR OTHER DESIGN  3 FOR WORKSHOP DESIGN  4 AS DESIGN  5 AS BUILT

**COMPRESSED AIR SYSTEM SCHEME**

Project No: P27032  
 Drawing Number/Revision: 740-731-100  
 Scale: 1:1  
 Date: 2009-09-11  
 Author: A.S. (524821)  
 Checker: S.C. (524821)  
 Date: 2009-09-11

**Aker Arctic**

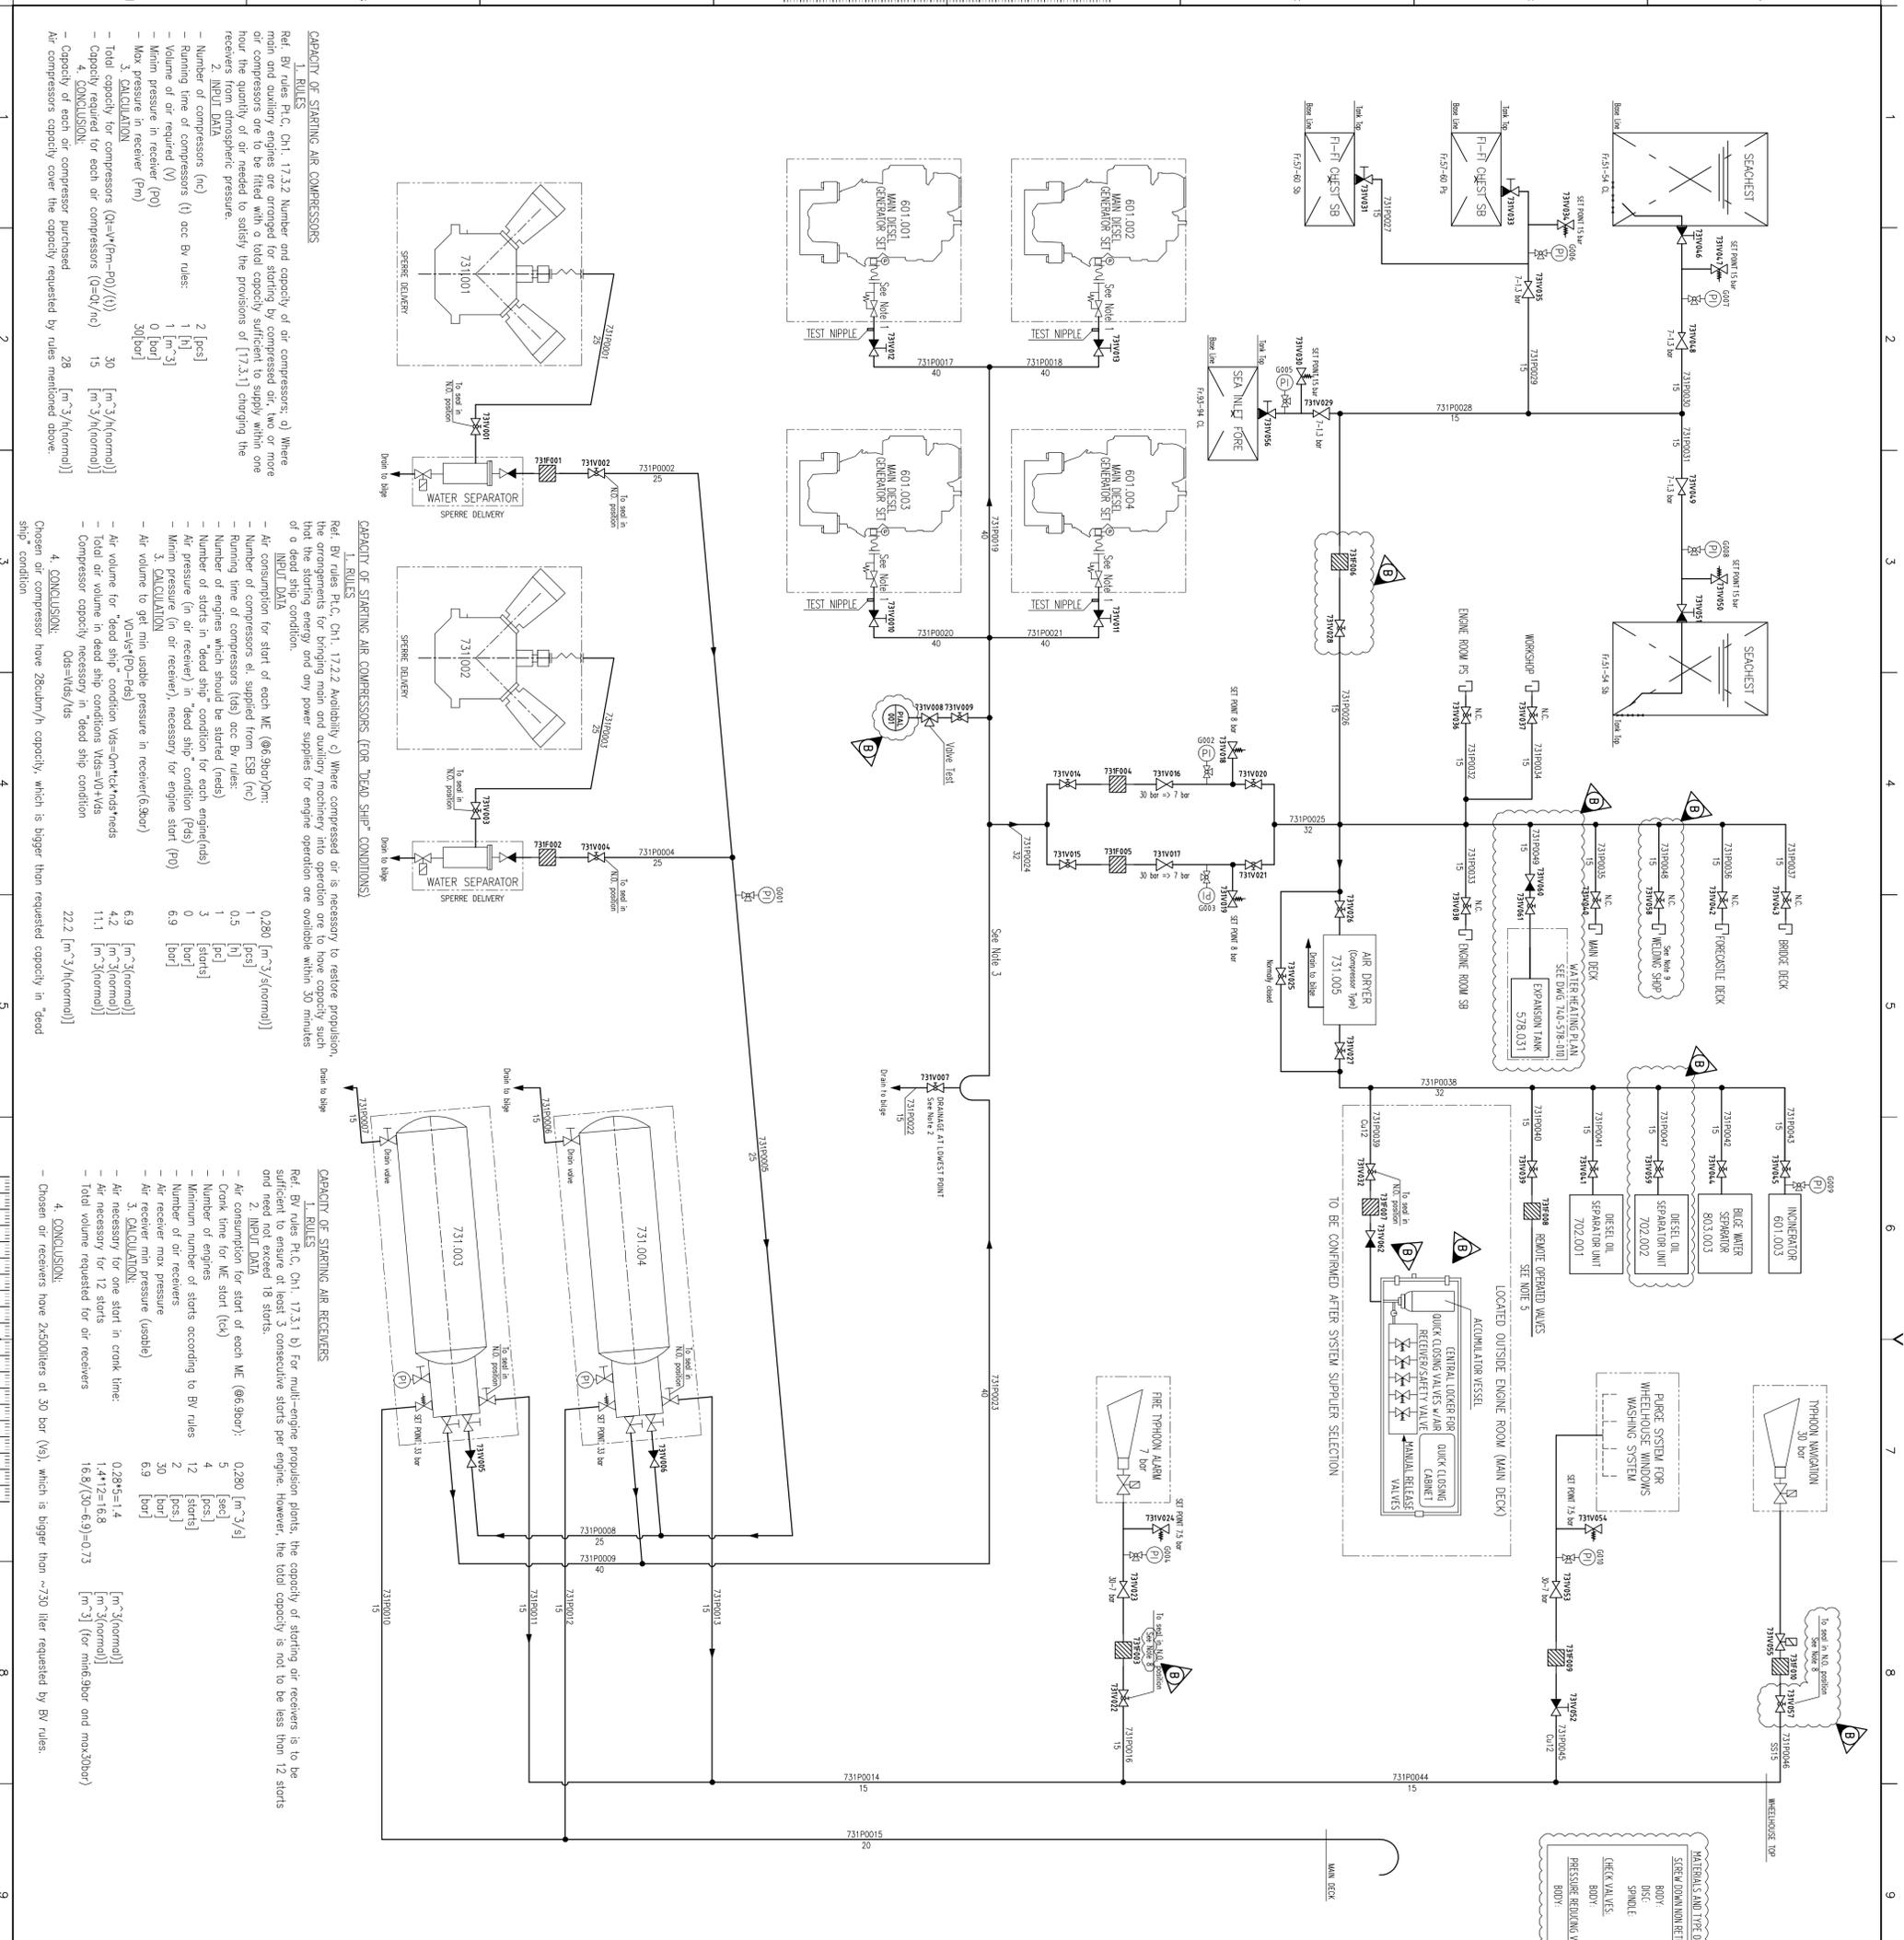

**CAPACITY OF STARTING AIR COMPRESSORS (FOR "DEAD SHIP" CONDITIONS)**

1. RULES  
 Ref: BV rules Pt.C, Ch.1, 17.2.2 Availability (c) Where compressed air is necessary to restore propulsion, the arrangements for bringing main and auxiliary machinery into operation one to have capacity, such that the starting energy and any power supplies for engine operation are available within 30 minutes of a dead ship condition.

INPUT DATA

Ref: BV rules Pt.C, Ch.1, 17.3.1 (b) For multi-engine propulsion plants, the capacity of starting air receivers is to be sufficient to ensure at least 3 consecutive starts per engine. However, the total capacity is not to be less than 12 starts and need not exceed 18 starts.

2. INPUT DATA

Ref: BV rules Pt.C, Ch.1, 17.3.1 (b) For multi-engine propulsion plants, the capacity of starting air receivers is to be sufficient to ensure at least 3 consecutive starts per engine. However, the total capacity is not to be less than 12 starts and need not exceed 18 starts.

3. CALCULATION

Ref: BV rules Pt.C, Ch.1, 17.3.1 (b) For multi-engine propulsion plants, the capacity of starting air receivers is to be sufficient to ensure at least 3 consecutive starts per engine. However, the total capacity is not to be less than 12 starts and need not exceed 18 starts.

4. CONCLUSION

Ref: BV rules Pt.C, Ch.1, 17.3.1 (b) For multi-engine propulsion plants, the capacity of starting air receivers is to be sufficient to ensure at least 3 consecutive starts per engine. However, the total capacity is not to be less than 12 starts and need not exceed 18 starts.