
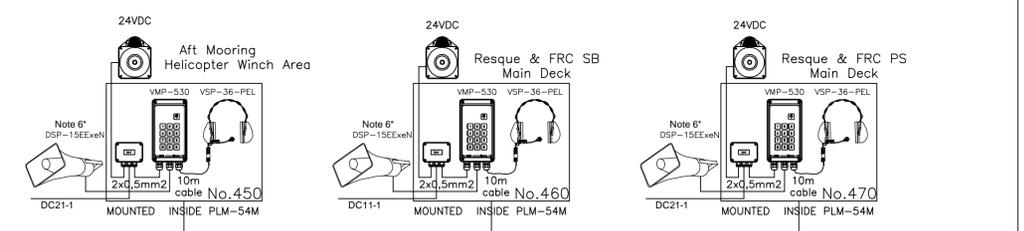


SYMBOL	QTY.	DESCRIPTION TYPE
	18	WALLMOUNTED DESKTOP MOD. USED IN CABINS, MESSROOMS, OFFICES ETC. VINGTOR VMP-D619
	5	PANELMOUNTED MODEL WITH HANDSET USED ON BRIDGE & IN ENG. CONTR. ROOM VINGTOR VMP-430 MOUNTED TOGETHER WITH VMP-221
	1	WALLMOUNTED DESK TOP MOD. WATERPROOF. USED IN GALLEY VINGTOR VMP-503
	3	WATERPROOF WALLMOUNTED TELEPHONE WITH HEADSET. USED IN ENGINE ROOM SPACES ETC. VINGTOR TYPE VMP-530 + VMP-36-PEL
	1	Rotating Light Blue 24VDC Technical Spaces
	3	CHASSIS CONTACT 5PIN DIN FOR ETC-1-TB W/1M CABLE
	3	HAND MICROPHONE W/5 PIN DIN-PLUG
	4	RELAYBOX 24V DC OR 230V AC-SIGNAL UNIT-IP-66 IRR3
	7	Combinated Alarm Sound and Blue light for Intercom system 24Vdc Nexus 105 - Klaxon (10000490)
	14	CEILING LOUDSPEAKER WITH STEEL FIRE DOME 5W, IP-44
	1	DST-40 EEXen (T) DNH powerful 40W driver unit ATEX approved. Combined with DNH different screens this driver unit will cover large areas.
	1	HORN FOR DST-40 EEXen (T). WATER TIGHT - IP-67
	1	DSP-15EEXen EX SPEAKER 20 OHM 15W W/2 CAB INLETS, ATEX APPROVED WT IP67
	4	CAR-4TF WALL DOUBLE FACED LOUDSPEAKER, 4W - W/FUSE
	4	WATERPROOF WALLMOUNTED TELEPHONE WITH HEADSET PLACED INSIDE COMPOSIT CABINET. USED OUTSIDE VMP-530 + VMP-36-PEL + PLM-54M + DSP-15EEXen + IRR-3.

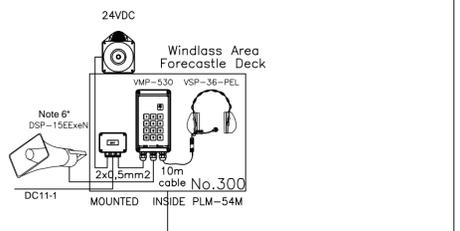

NOTE 1:
SIGNAL FOR FIRE ALARM WILL BE HANDLED BY FIRE ALARM PLANT.

NOTE 2:
SIGNAL FOR GENERAL ALARM (GA) WILL BE HANDLED BY FIRE ALARM PLANT.

NOTE 3:
PUBLIC ANNOUNCEMENT (PA) CALLS CAN BE MADE FROM ONE OF THE FOLLOWING CALL STATIONS:
- BRIDGE CONSOLE AFT;
- BRIDGE CONSOLE FWD;
- Captain Cabin;
- Chief Engineer Cabin;
- Engine Control Room.

NOTE 4:
THERE IS PA-EMERGENCY OVERRIDE FUNCTIONS OF THE GENERAL(GA) AND FIRE ALARM ALARM ON THIS SYSTEM THIS WILL MUTE THE SOUND SIGNALING FROM FIRE ALARM PLANT IN CASE OF A PA ANNOUNCEMENT.

NOTE 5:
PUBLIC ANNOUNCEMENTS ARE DISTRIBUTED THROUGH INTERCOM TELEPHONES IN THE CABINS & PA-LOUDSPEAKERS IN CORRIDORS AND OUTSIDE.

NOTE 6:
All Loudspeakers marked with this note will not broadcast on Em. PA announcement. They will broadcast only on General Call.

PA Groups
General Call: All;
Group Z1: Cabins, Treatment Room,
Group Z2: Accommodation, Corridors;
Group Z3: Technical Spaces;
Group Z4: Outside.

D	As Built.	12.07.10	CBG
C	Changed Combi Alarm Type.	04.01.10	CBG
B	Update power supply for sound and light organs. Added Note 6.	08.09.12	CBG
A	Updated according owner remarks.	23.11.09	CBG

FILE:	SHEET:	ACCORDING TO INTERNATIONAL LAWS, THIS DRAWING IS THE PROPERTY OF STX Norway Electro AS. THE DRAWING CAN NOT BE MADE PUBLIC, COPIED OR OTHERWISE USED, WITHOUT OUR WRITTEN CONSENT.	
FILE:	1 of 1		
DRW:	CBG	DATE:	24.09.09
DESKED:	DATE:	SCALE:	%
VERIFIED:	DATE:	SCALE:	%
		DWG. NO. 740-425-001	
		REV: D	
		STX Norway Electro AS 6280 Sarvik, Norway Tel: +47 70 21 06 00 www.stxeurope.com	
WRD: STX RO Offshore ADDRESS: Bralla SA		TITLE: Intercom System Cable Diagram FORM: A1 PROJECT: 78258 DESIGN: ARC 104	