
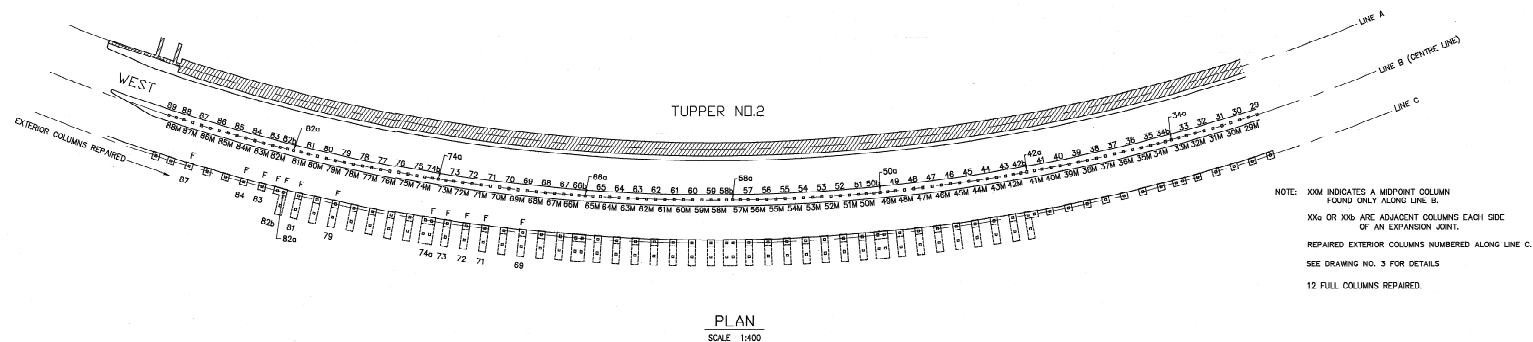
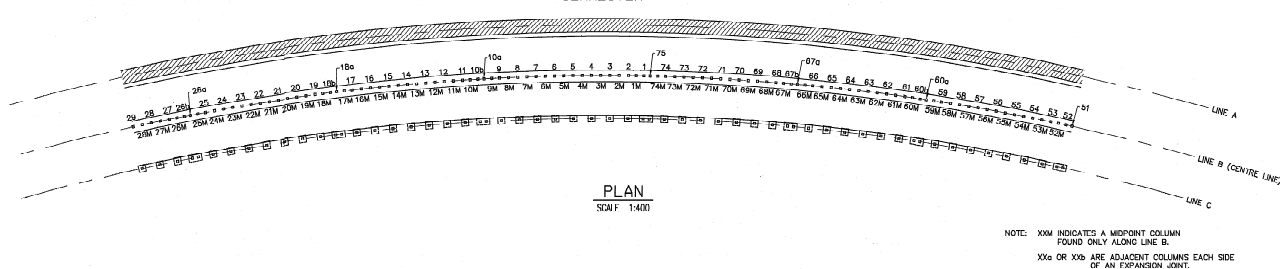


WESTERN REGION
RÉGION DE L'OUESTARCHITECTURAL AND ENGINEERING SERVICES
SERVICES D'ARCHITECTURE ET DE GÉNIETUPPER NO.2 - TUPPER NO.3
CONNECTOR


TUPPER NO.3

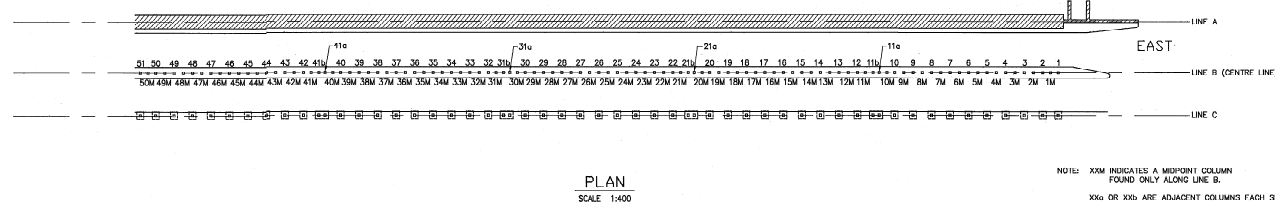

NOTES

1. FOR GENERAL NOTES SEE DWG. NO. 1

revisions date

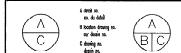
 project
**SNOWSHED
COLUMN REPAIR
1994**
 (AS CONSTRUCTED)
 T.C.H. - GLADIER NATIONAL PARK - B.C.

 drawing
**TUPPER NO. 2, NO. 3
CONNECTOR**
PLANS
 (AS CONSTRUCTED)

designed	W.J. GANSON	checked	
drawn	S.J. CHOUETTE / G.E. ROBERTS	designed	
modified	T.L. RHYASON (94-12-16)	checked	
revised	K.K. SOOD	examined	
approved	G.S. HERBERT	approved	
date		submitted	
Project Manager	Administrateur de projet	Project No.	669112
drawing no.		sheet no.	2 of 5

