

NOTES:


- INTERPRET DIMENSIONS AND TOLERANCES PER ASME Y14.100-2013. INTERPRET DRAWING FORMAT PER CF STD D-01-400-001/SG-000.
- MATERIAL: ASTM A-240 ASME SA-240, 304 STAINLESS STEEL
- REMOVE ALL BURRS AND SHARP EDGES.
- FINISH: FINISH TO BE APPLIED PER MIL-DTL-53072E:
  - STAINLESS STEEL SHALL BE CLEANED IN ACCORDANCE WITH ASTM A380-06.
  - PRE-TREATMENT FOR STAINLESS STEEL SHALL BE PASSIVATION IN ACCORDANCE WITH ASTM A967-05, OR APPROVED EQUIVALENT.
- MARK PART NUMBER "35907-1277703-1" "MFR-XXXXX" PER MIL-STD-130N, WHERE XXXXX IS NSCM (CAGE) CODE OF APPROPRIATE MANUFACTURER AS DIRECTED BY THE PURCHASING AUTHORITY. MARK IN APPROXIMATE LOCATION SHOWN USING EPOXY BASED MARKING INK PER A-A-56032D TYPE III, CHARACTERS TO BE 2.5 ± 0.8 HIGH.
- PART GEOMETRY NOT DETAILED ON THE DRAWING TO BE EXTRACTED FROM ELECTRONIC 3D MODEL USING DRAWING NOTES TO INTERPRET.

**GDMS-C SUGGESTED REDLINES**


**Notes:**

- ECR TO BE INITIATED & IMPLEMENTED BY DSCO TO ACCOMMODATE IMMEDIATE DLCSPPM PROCUREMENT EFFORTS
- REVISION 'A' IS ASSUMED, DWG UPDATES TO BE IMPLEMENTED ON LATEST VERSION AVAILABLE
- DWG UPDATES TO BE IMPLEMENTED ON TDAN VERSION (IF IT EXISTS)

-NO	ITEM NO DE L'ART	IDENTIFYING NO D'IDENTIFICATION	NOMENCLATURE/DESCRIPTION	SPECIFICATION	CODE IDENT CODE D'IDENT
-1					
QTY/QTÉ					
1	1		SEE NOTE 2	SEE NOTE 2	

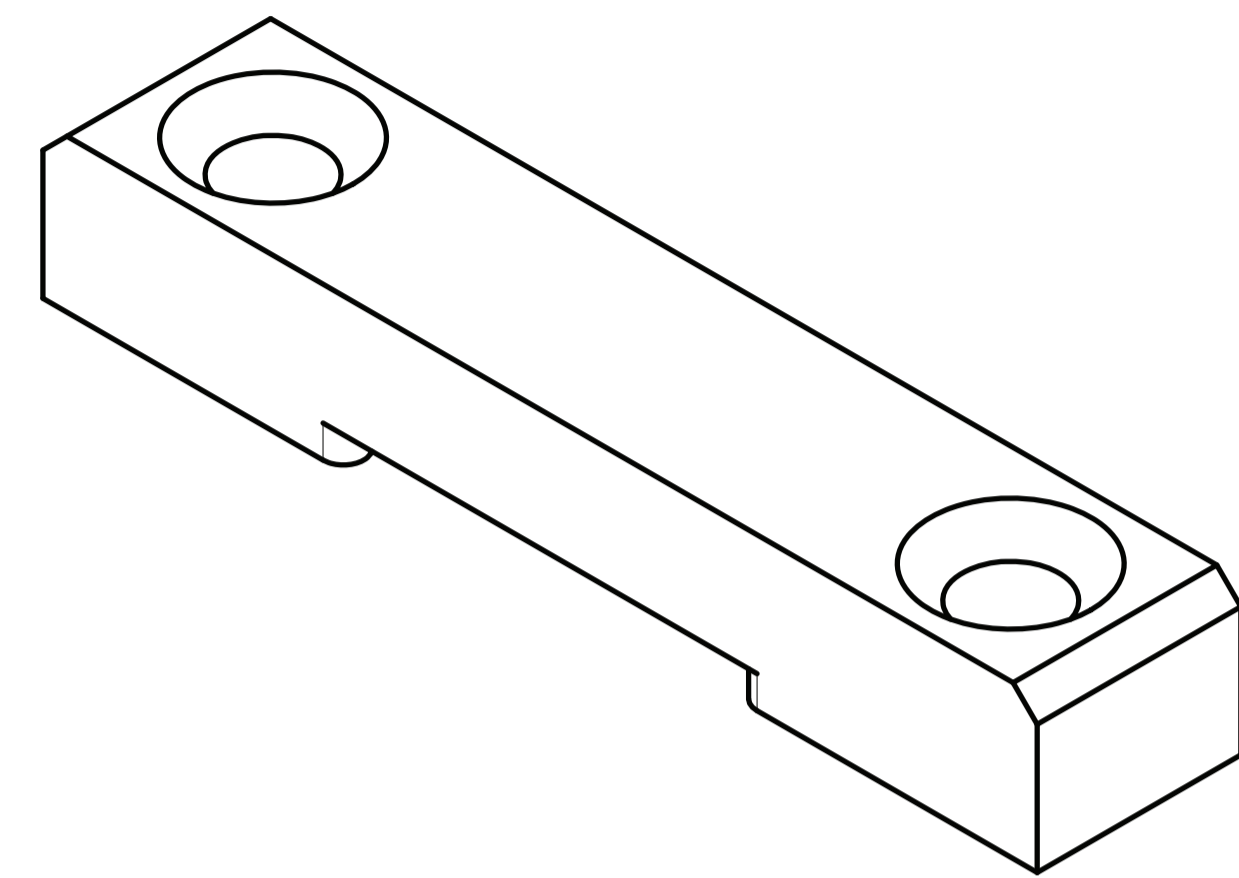


ISOMETRIC VIEW

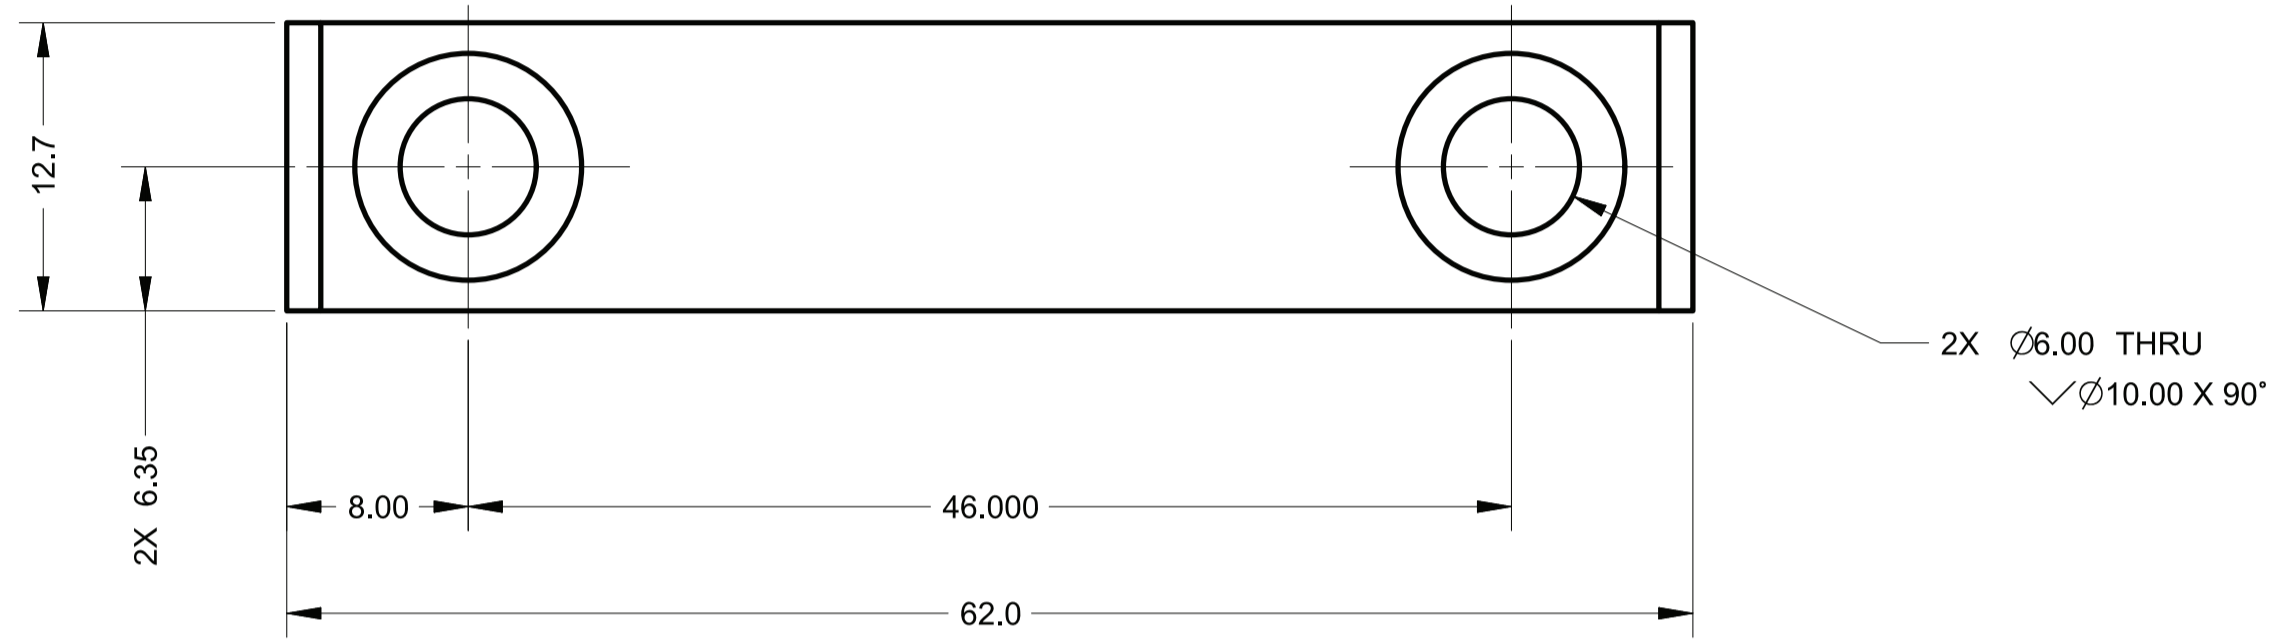


TOP VIEW


ADD MISSING HEIGHT DIMENSION (NOTE: X.XX TOLERANCE IS INTENTIONAL)

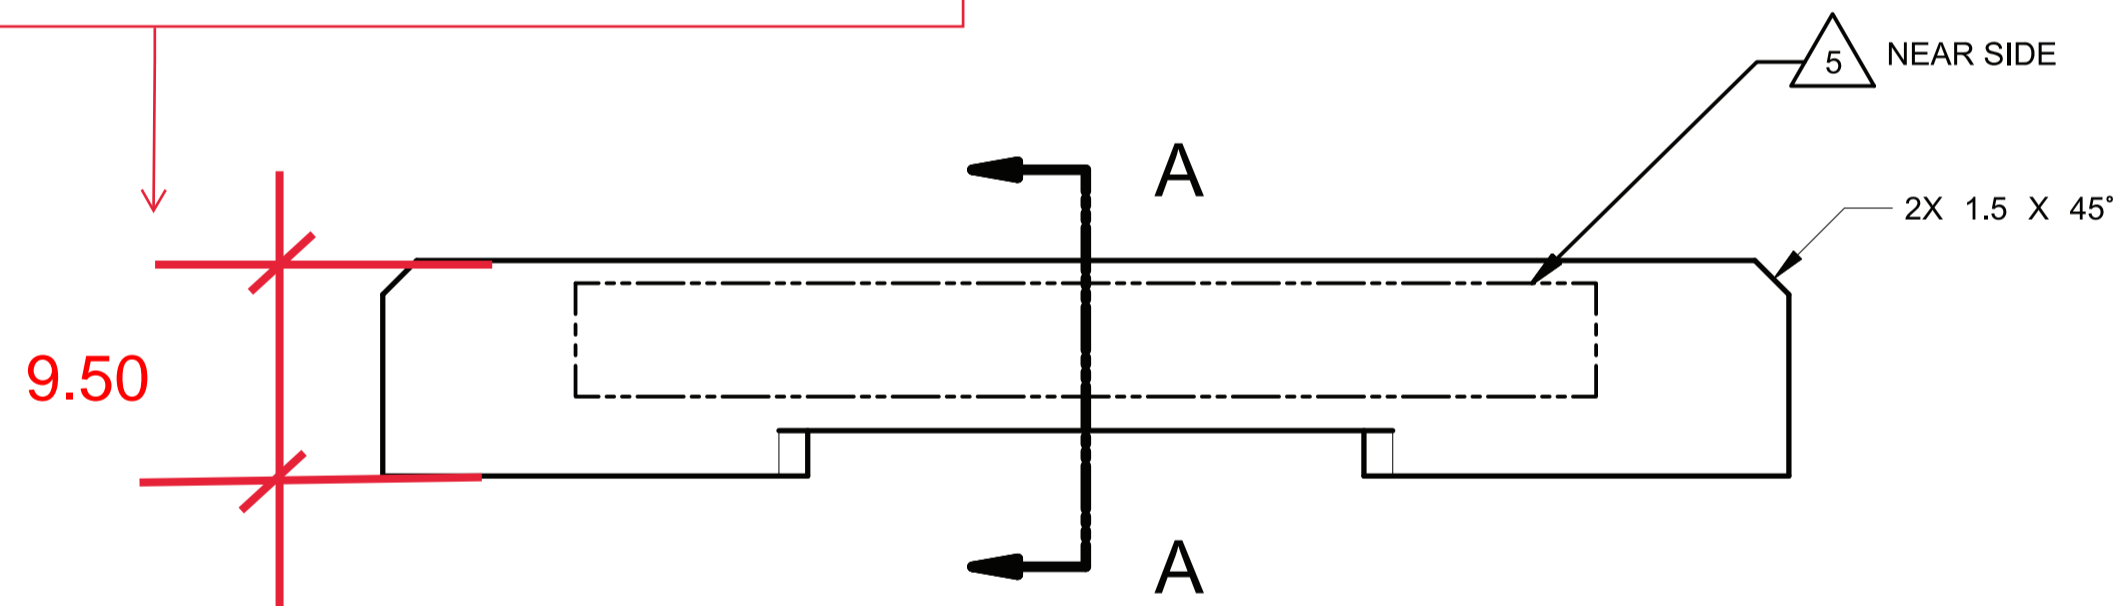

FRONT VIEW

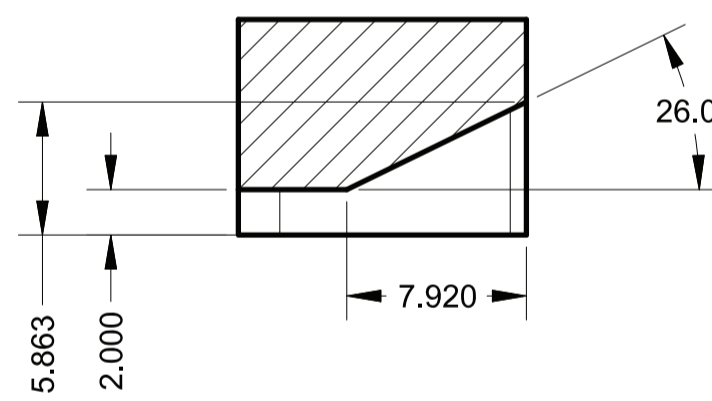

SECTION A-A

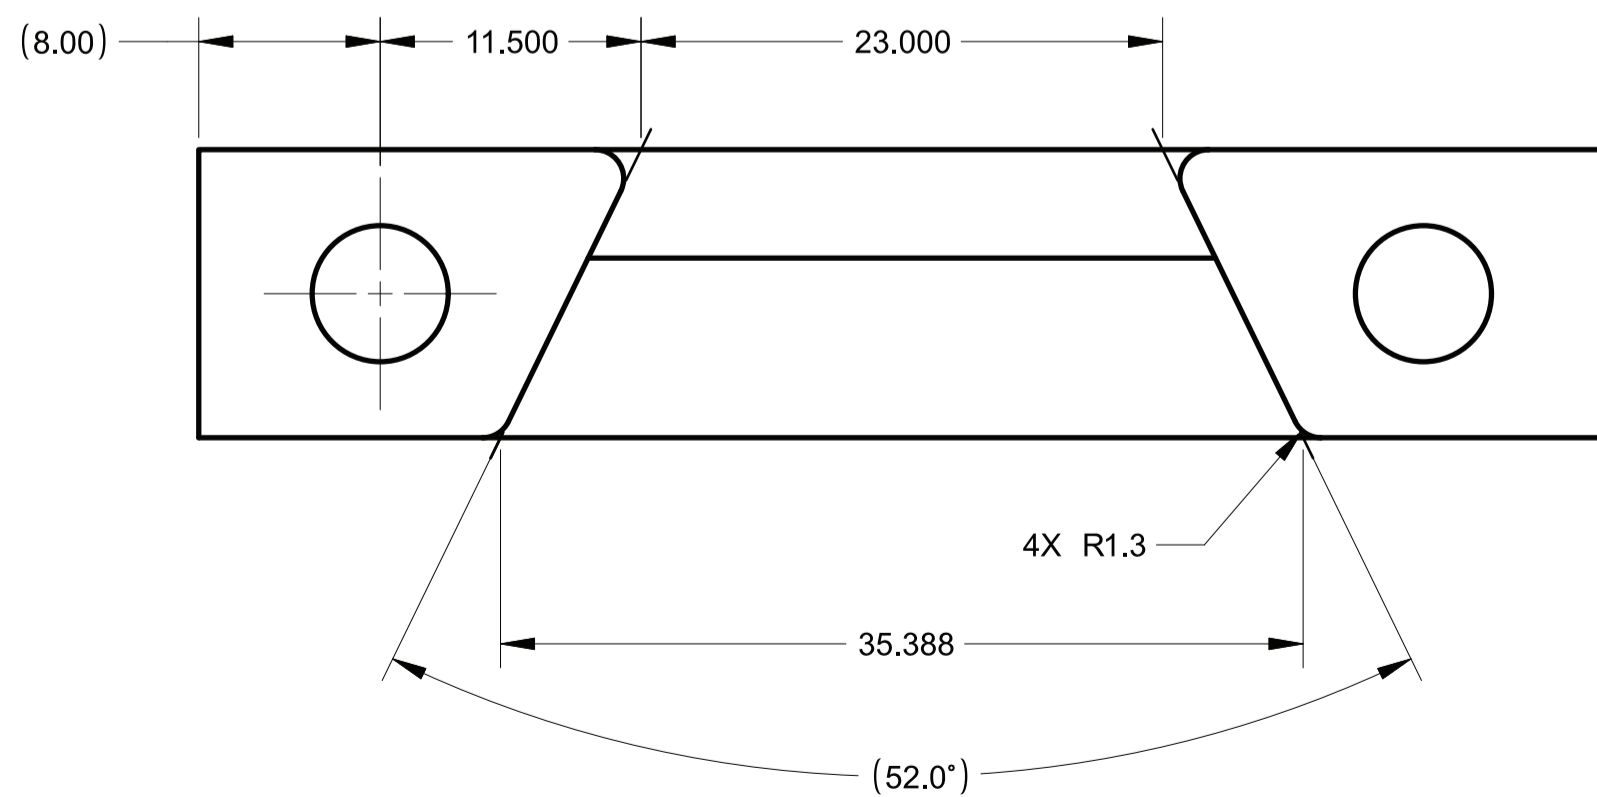

BOTTOM VIEW

UPDATE REV BLOCK: NEEDS TO INCLUDE STEP FILE REVISION NOTE AS DWG CHANGE IS CLERICAL AND DOES NOT IMPACT STEP FILE REVISION.

**A ECR XXXXXX INCORP. (ASSOCIATED STEP FILE REV -)**

SEE SEPARATE ELECTRONIC FILE

THE DEPARTMENT OF NATIONAL DEFENCE DOES NOT WARRANT OR GUARANTEE THE CORRECTNESS OR ACCURACY OF THE INFORMATION CONTAINED IN THIS DOCUMENT FOR OTHER THAN OFFICIAL DEFENCE PURPOSES. THE DEPARTMENT OF NATIONAL DEFENCE DOES NOT GRANT ANY LICENCE, CONVEY ANY INTELLECTUAL PROPERTY RIGHTS, OR GIVE PERMISSION FOR ANY USE IN WHOLE OR IN PART BY ANY RECIPIENT, HOLDER OR USER OF THIS DOCUMENT, AND ANY SUCH PERSON USING THIS DOCUMENT OR THE INFORMATION THEREIN DOES SO AT THEIR OWN RISK.



UNLESS OTHERWISE SPECIFIED/SAUF INDICATION CONTRAIRE:		APPLICATION/USAGE
1. DIMENSIONS ARE IN DIMENSIONS SONT EN MM		M577A3 SOTM
2. TOLERANCES		
FRACTIONS : -		
DECIMALS XXX : 0.130		SCALE/ÉCHELLE
DECIMALES XX : 0.30		NONE
X : 0.8		
ANGLES : 1°		
3. SURFACE FINISH FINIS DE SURFACES		
REV SHEET	INTERPRETATION/INTERPRÉTER	CF STD D-01-400-001/SG-000 LEVEL/NIVEAU 3
REV STATUS OF SHEETS		

- PRODUCTION RELEASE DC14554		18-08-15	MS	KH	A.H.
ZONE	LTR LET	REVISION	DATE	DWN DES	CKD VER
Défense nationale		National Defence	Canada		
DWN/DESS	CKD/VER	INSPLCT/INSPECTÉ	CF APPVL/APP FC		
M.SMOLIS		K.HUI	DSCO 5-3-5		
DESIGN AGENT/CONCEPTION		NSCM/CAOF	APPVL DATE D'APPROB		
3AF83		35907	A1		
TITLE/TITRE		DRAWING NO DU DESSIN			
BRACKET, ALIGNMENT		1277703			
SHEET FEUILLE		1	OF DE		1