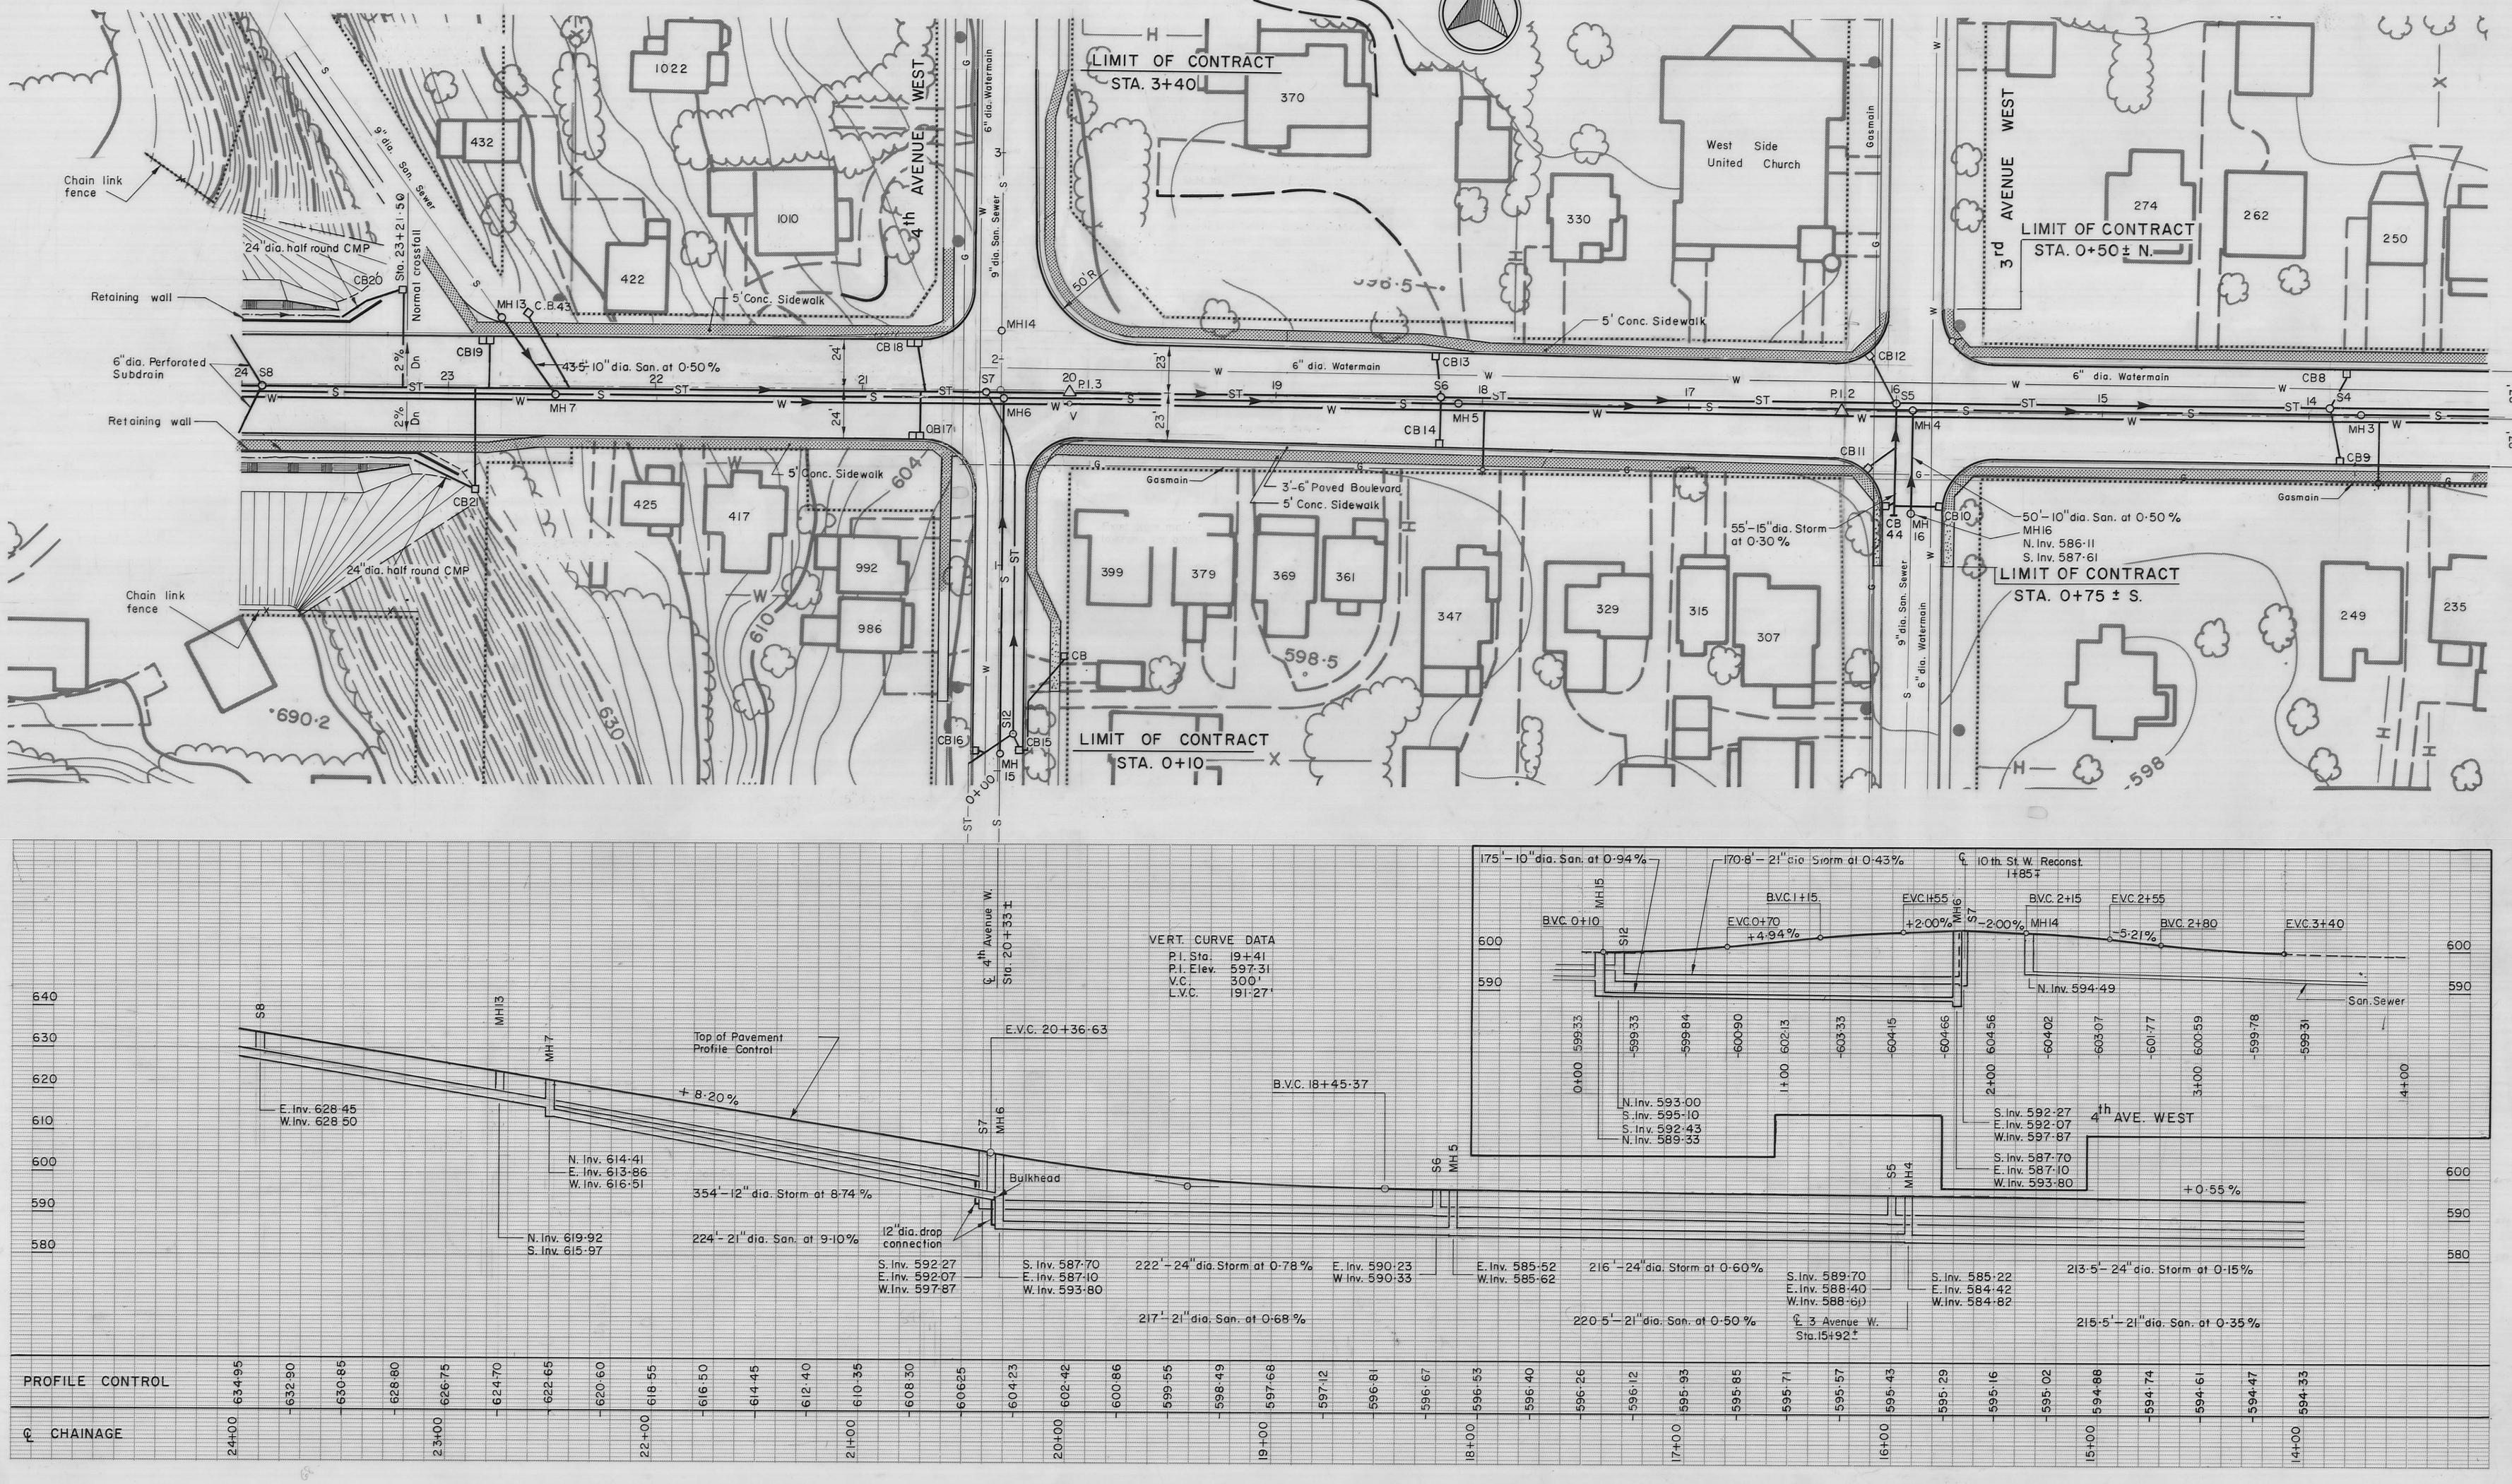

PRINT RECORD		
No.	FOR	DATE
5	DHO Owen Sd	21.6.71
2	DHO London	"
1	DHO Program	"
1	City	"
1	Office	"
2	PUC	28.6.71
2	Bell	"
1	Streetman D.T.C.	3.8.71
1	D.T.C. Dist. O.	3.8.71
1	B.Bell	3.8.71
2	Bedford Gerrard	6.8.71
6	DTC	25.10.71
1	City	"
3	Dagmar	10.1.72
2	Kobold	"
1	City	"
1	PUC	"
1	Bell	"
1	Gas	"
5	DTC	17.01.72
2	Dagmar	25.1.72

LEGEND:

—W—	Watermain	—W—	Watermain
—ST—	Storm Sewer	—ST—	Storm Sewer
—S—	Sanitary Sewer	—S—	Sanitary Sewer
	Sidewalk		Street Allowance

REGISTERED PROFESSIONAL ENGINEER J. T. LONG PROVINCE OF ONTARIO

REGISTERED PROFESSIONAL ENGINEER CIVIL S. A. MILES PROVINCE OF ONTARIO

DAMAS AND SMITH LIMITED
CONSULTING ENGINEERS AND PLANNERS
TORONTO · LONDON · WINNIPEG

REV.	BY	DATE	DESCRIPTION
C	F.M.	13-12-72	'AS CONSTRUCTED'
B	L.P.	21-10-71	EXIST. W/M TO BE LOWERED BY OTHERS
A	C.J.V.	29-7-71	REVIEWED AND MODIFIED

CITY OF OWEN SOUND

TENTH ST. WEST RECONSTRUCTION

PLAN-PROFILE STA. 24+00 TO STA. 14+00

DRAWN F.M. CHECK DB
DATE JUNE 1971
SCALE: VERT. 1" = 20' HORIZ. 1" = 40'
DRAWING No. 6860-Z102

10TH ST. WEST - E. OF 3RD AVE WEST TO 4TH AVE WEST (RECONSTRUCTION)

A-60