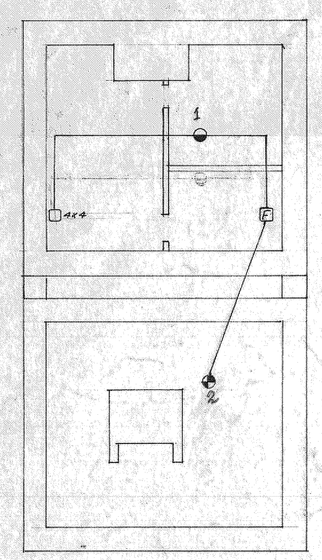

BASEMENT

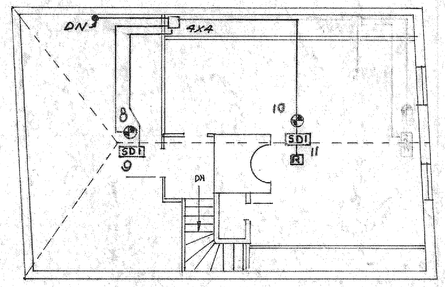

ATTIC

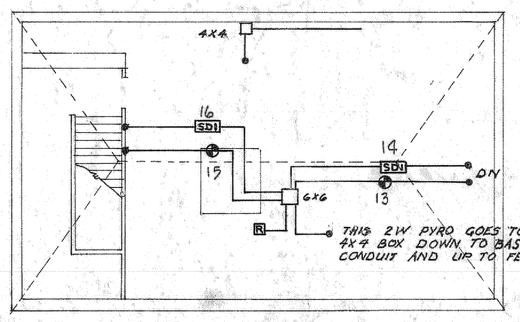

ATTIC

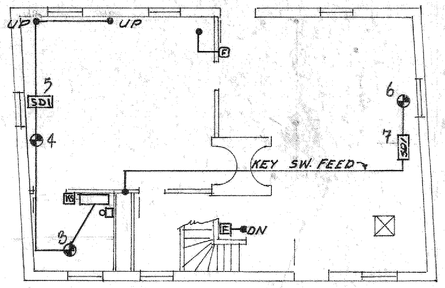

GROUND FLOOR

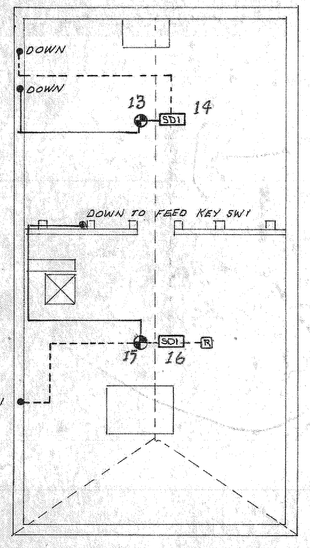

FIRST FLOOR

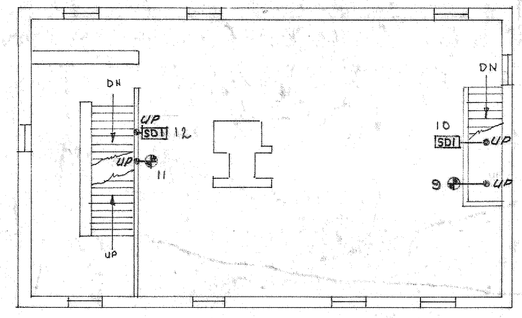

FIRST FLOOR

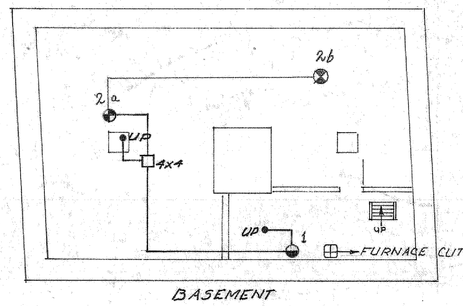

BASEMENT
DE GANNES DE FALAISE HOUSE

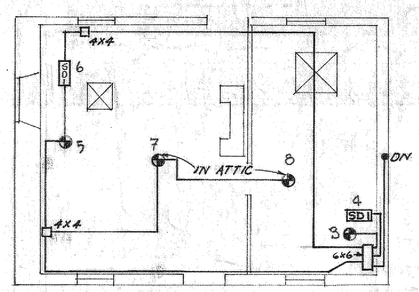

GROUND FLOOR

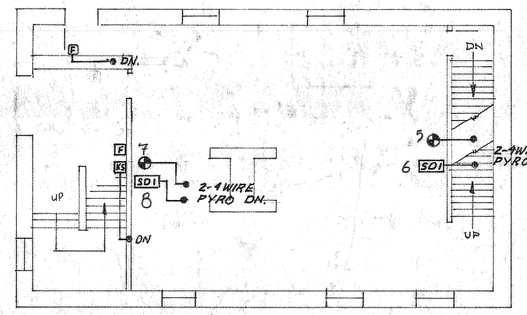

GROUND FLOOR

LEGEND

- AUTOMATIC HEAT DETECTOR 135° FIXED TEMP.
- AUTOMATIC HEAT DETECTOR 135° & RATE OF RISE.
- SD1 AUTOMATIC SMOKE DETECTOR TYPE 1 SURFACE MOUNTED.
- EOL END OF LINE RESISTOR.
- F MANUAL PULL STATION.
- BELL ALARM BELL.
- KS KEY SWITCH.

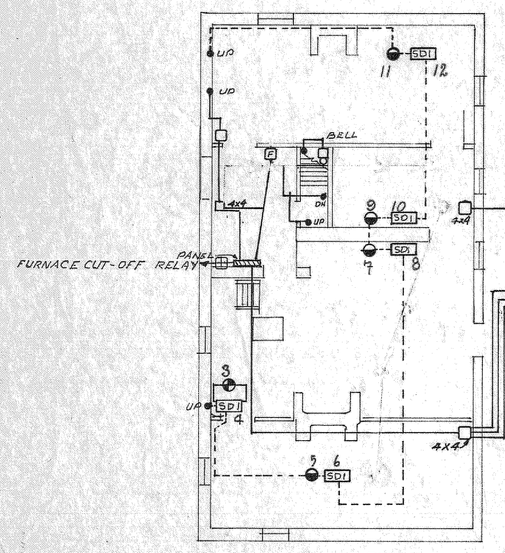

GROUND FLOOR
RODRIGUE HOUSE

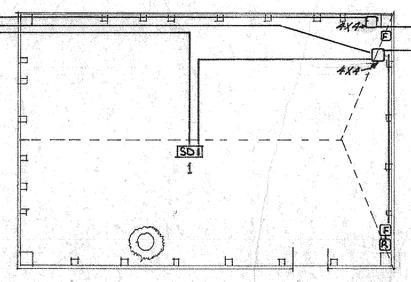

RODRIGUE STOREHOUSE

NOTE.
KEY SWITCH FOR THIS BUILDING IS IN RODRIGUE HOUSE, AT TOP OF STAIRS.

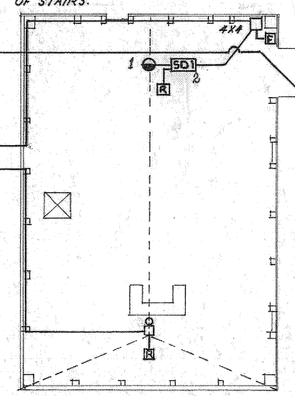

DE LA PERELLE STOREHOUSE.

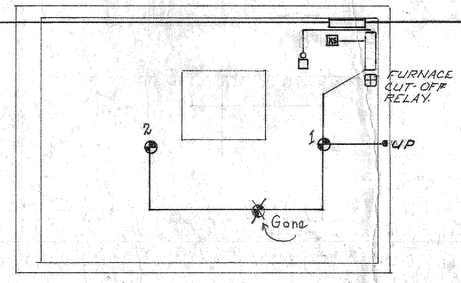

BASEMENT.
DE LA PERELLE HOUSE

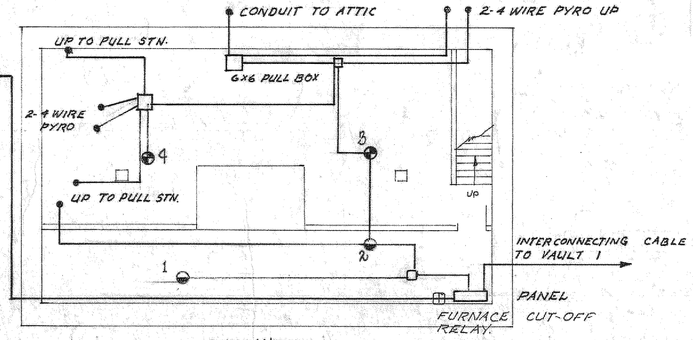

BASEMENT
DUHAGET HOUSE.

DEPARTMENT OF
INDIAN AFFAIRS &
NORTHERN DEVELOPMENT
TECHNICAL SERVICES BRANCH

CANADA

MINISTÈRE DES
AFFAIRES INDIENNES
ET DU NORD CANADIEN
DIRECTION DES SERVICES TECHNIQUES

FORTRESS OF LOUISBOURG
NATIONAL HISTORIC PARK

RECOMMENDED
RESTORATION ARCHITECT

APPROVED & RECOMMENDED
CONSTRUCTION MANAGER

APPROVED & RECOMMENDED
PARKS CANADA DEVELOPMENT

CHECKED FOR HISTORICAL ACCURACY
HEAD OF RESEARCH

revisions	date

A detail no. / détail nº
B location dwg. no. / sur dessin nº
C drawing no. / dessin nº

drawn by / tracé par	scale / échelle
JAK	1/8" = 1'-0"

designed by / établi par

checked by / vérifié par

job captain / chef du projet — date

responsible officer / officier responsable — date

project title / titre du projet

FIRE ALARM SYSTEM BLOCK 17 (AS BUILT)

drawing title / titre du dessin

RODRIGUE HOUSE
RODRIGUE STOREHOUSE
DE GANNES DE FALAISE HOUSE
DE LA PERELLE STOREHOUSE
DE LA PERELLE HOUSE
DUHAGET HOUSE

reference no. / nº de référence: HAFLR 77/PG. 7

dwg no. / dessin nº: 8/18