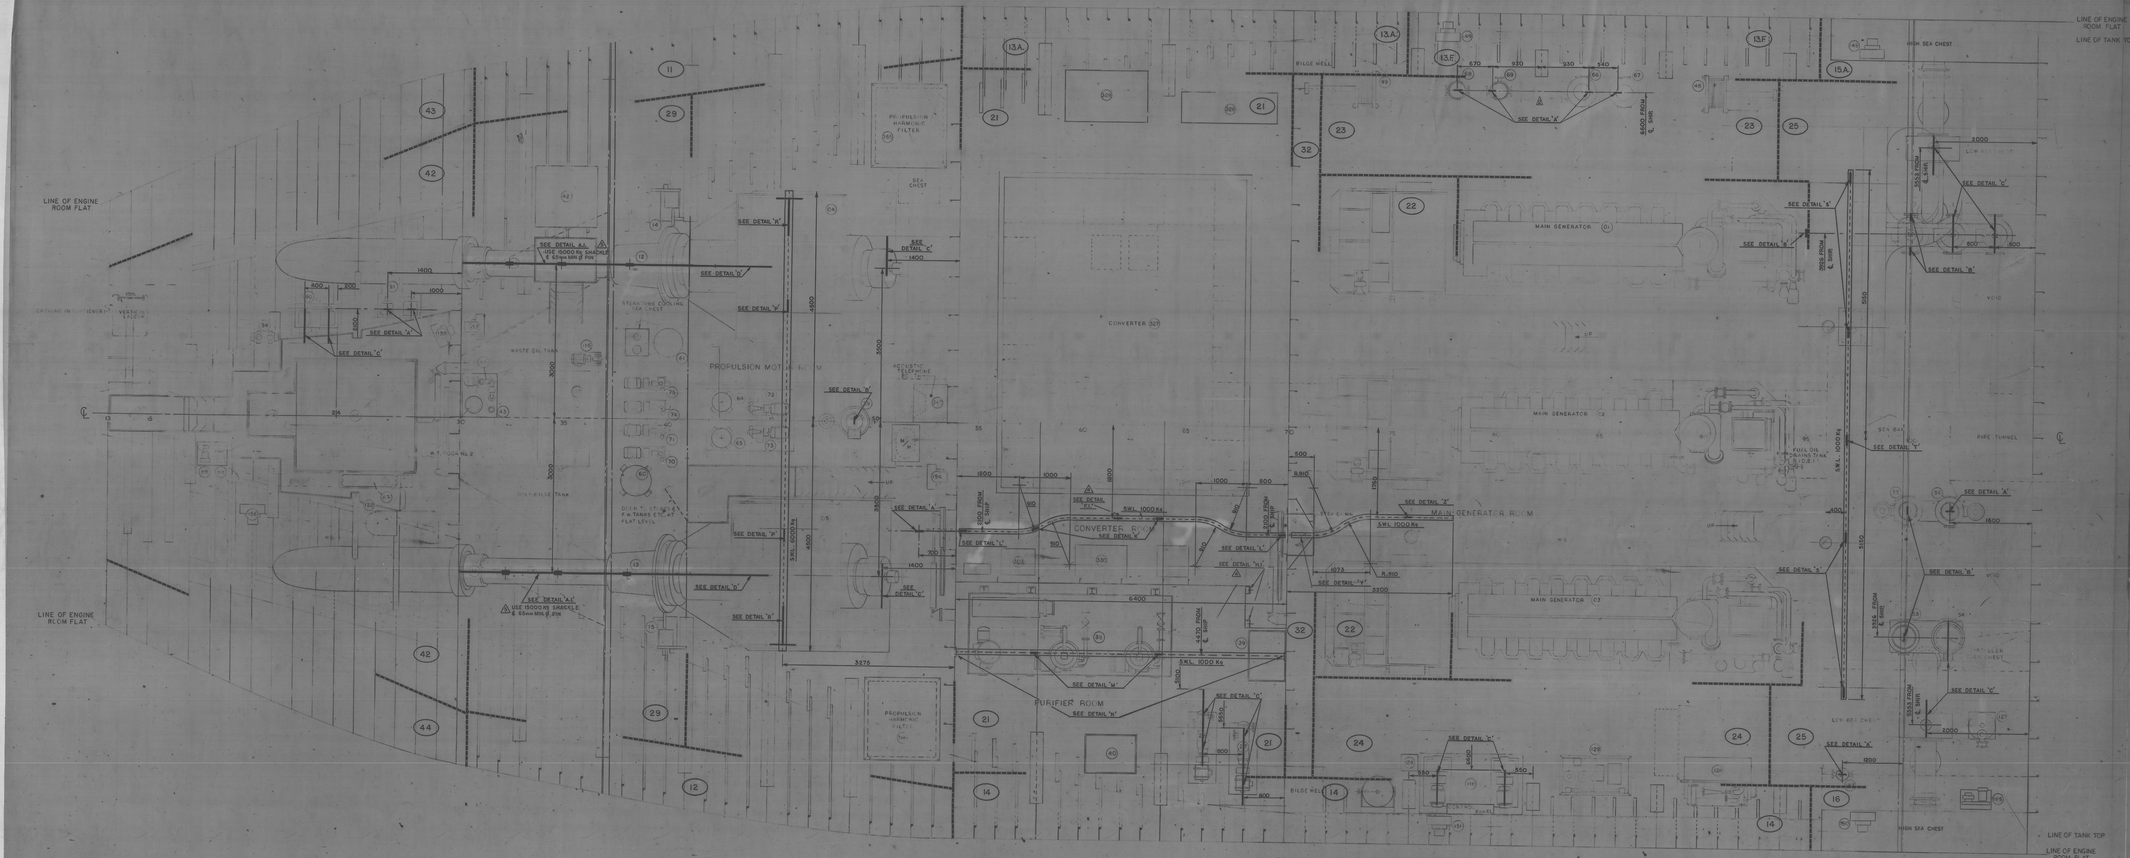

REFERENCE DRAWINGS.

50-00-01
50-00-02
50-00-03
} MACHINERY ARRANGEMENTS.

H-00-04 ENGINE ROOM FLAT.

H-00-05 MAIN DECK.

NOTES.

1. FOR DETAILS SEE SHEET 4 OF 4.
2. ⬭ UNIT BUTTS
3. S.W.L. TO BE PAINTED ON 'I' BEAMS
4. ALL WELDS TO HAVE 4.5mm THROAT WIDTH.

EP-201
05-10-201

DISTRIBUTION					
DEPARTMENT	QTY.	DEPARTMENT	QTY.	DEPARTMENT	QTY.
Director		Chief Engineer		Electrician	
Chief Inspector		Asst. Engineer (Ch.)	1	Engineer	
Engineering Inspectors		Asst. Engineer		Engineer	
BOSS, Lab Insts, Publications	1	Pattern Shop		Pipe Fitter	1
SPATT Shelf	1 W	Blacksmith	1	Machinist Mate	
NAVEC	1	Coppersmith		Machinist	
Technology & Ch.	1	Cutter		Diesel Mechanic	1
Electrical & Ch.	1	Fitter	2	Electric Motor Mechanic	1
Welding Inspector	1	Driller		Engine Mechanic	2

No.	REVISION	BY	DATE
1	POSITIONS ADDED FOR LUGS	D.J.G.	APR/96
2	POSITION OF E.W. COOLING PUMPS LIFTING LUGS CHANGED	KING	NOV-10-94
3	LIFTING BEAM ABOVE SHAFT REVISED	D.J.G.	[illegible]
4	LIFTING BEAM IN CONVERTER ROOM REVISED, STOWAGE ADDED	D.J.G.	[illegible]
5	NOTE ADDED TO TAILSHAFT LIFTING GEAR	C.B.	[illegible]
6	AS FITTED	C.P.	MAR/95

Burrard Yarrows Corporation
SHIPBUILDERS, MARINE ENGINEERS, GENERAL ENGINEERS
Victoria Division: 1919 Store Street, North Vancouver, B.C. and Esquimalt, B.C.
Victoria Division: 1700 Store Street, Victoria, B.C. and Esquimalt, B.C.

DIVISION: VANCOUVER
HULL NOS 2555 JOB No. 56-00
OWNERS CANADIAN COAST GUARD

As-Built/As-Fitted Date	Owner's Rep.			

DRAWN: D.J.G. CHECKED: [illegible] APPROVED: [illegible]

Canadian Coast Guard / Garde côtière canadienne

Vessel Name: TYPE 1100 NAVAIDS TENDER / LIGHT ICEBREAKER

Dwg. Title: ARRANGEMENT AND DETAILS OF LIFTING GEAR

Date: 6-8-94 Scale: As Shown 1/25 Rev. 6

Contractor Dwg. No. or Compressor Sked. No. WEC-96-00-01 (Iss 4)

WEC-4