## SYMBOL SCHEDULE:

- TWO GANG SWITCH
- ONE GANG SWITCH
- DUPLEX RECEPTACLE
- JUNCTION BOX
- POLE
- RECESSED DOWNLIGHT
- WALL MOUNT LUMINAIRE
- RECESSED LUMINAIRE
- STRIP TYPE LUMINAIRE
- SURFACE MOUNT LUMINAIRE
- PHOTOCELL
- UNIT HEATER
- MOTOR CONNECTION C/W DISCONNECT
- EMERGENCY LIGHTING BATTERY BANK C/W DUAL REMOTE
- PANELBOARD




NOTES:

1. TYPICAL TRENCH LAYOUT SHOWN. VARY TRENCH DIMENSIONS TO SUIT ACTUAL CONDUITS.
2. CABLE INSTALLATION TO BE IN ACCORDANCE WITH THE CURRENT EDITION OF THE CANADIAN ELECTRICAL CODE.

2 / E1 TRENCH DETAIL–1
NTS

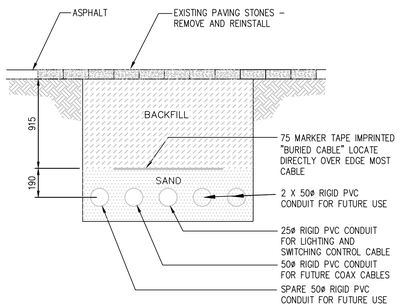


1 / E1 ELECTRICAL SITE PLAN
1:1000

Public Works and Government Services Canada / Travaux publics et Services gouvernementaux Canada

REAL PROPERTY SERVICES
Western Region
SERVICES IMMOBILIERS
Région de l'ouest

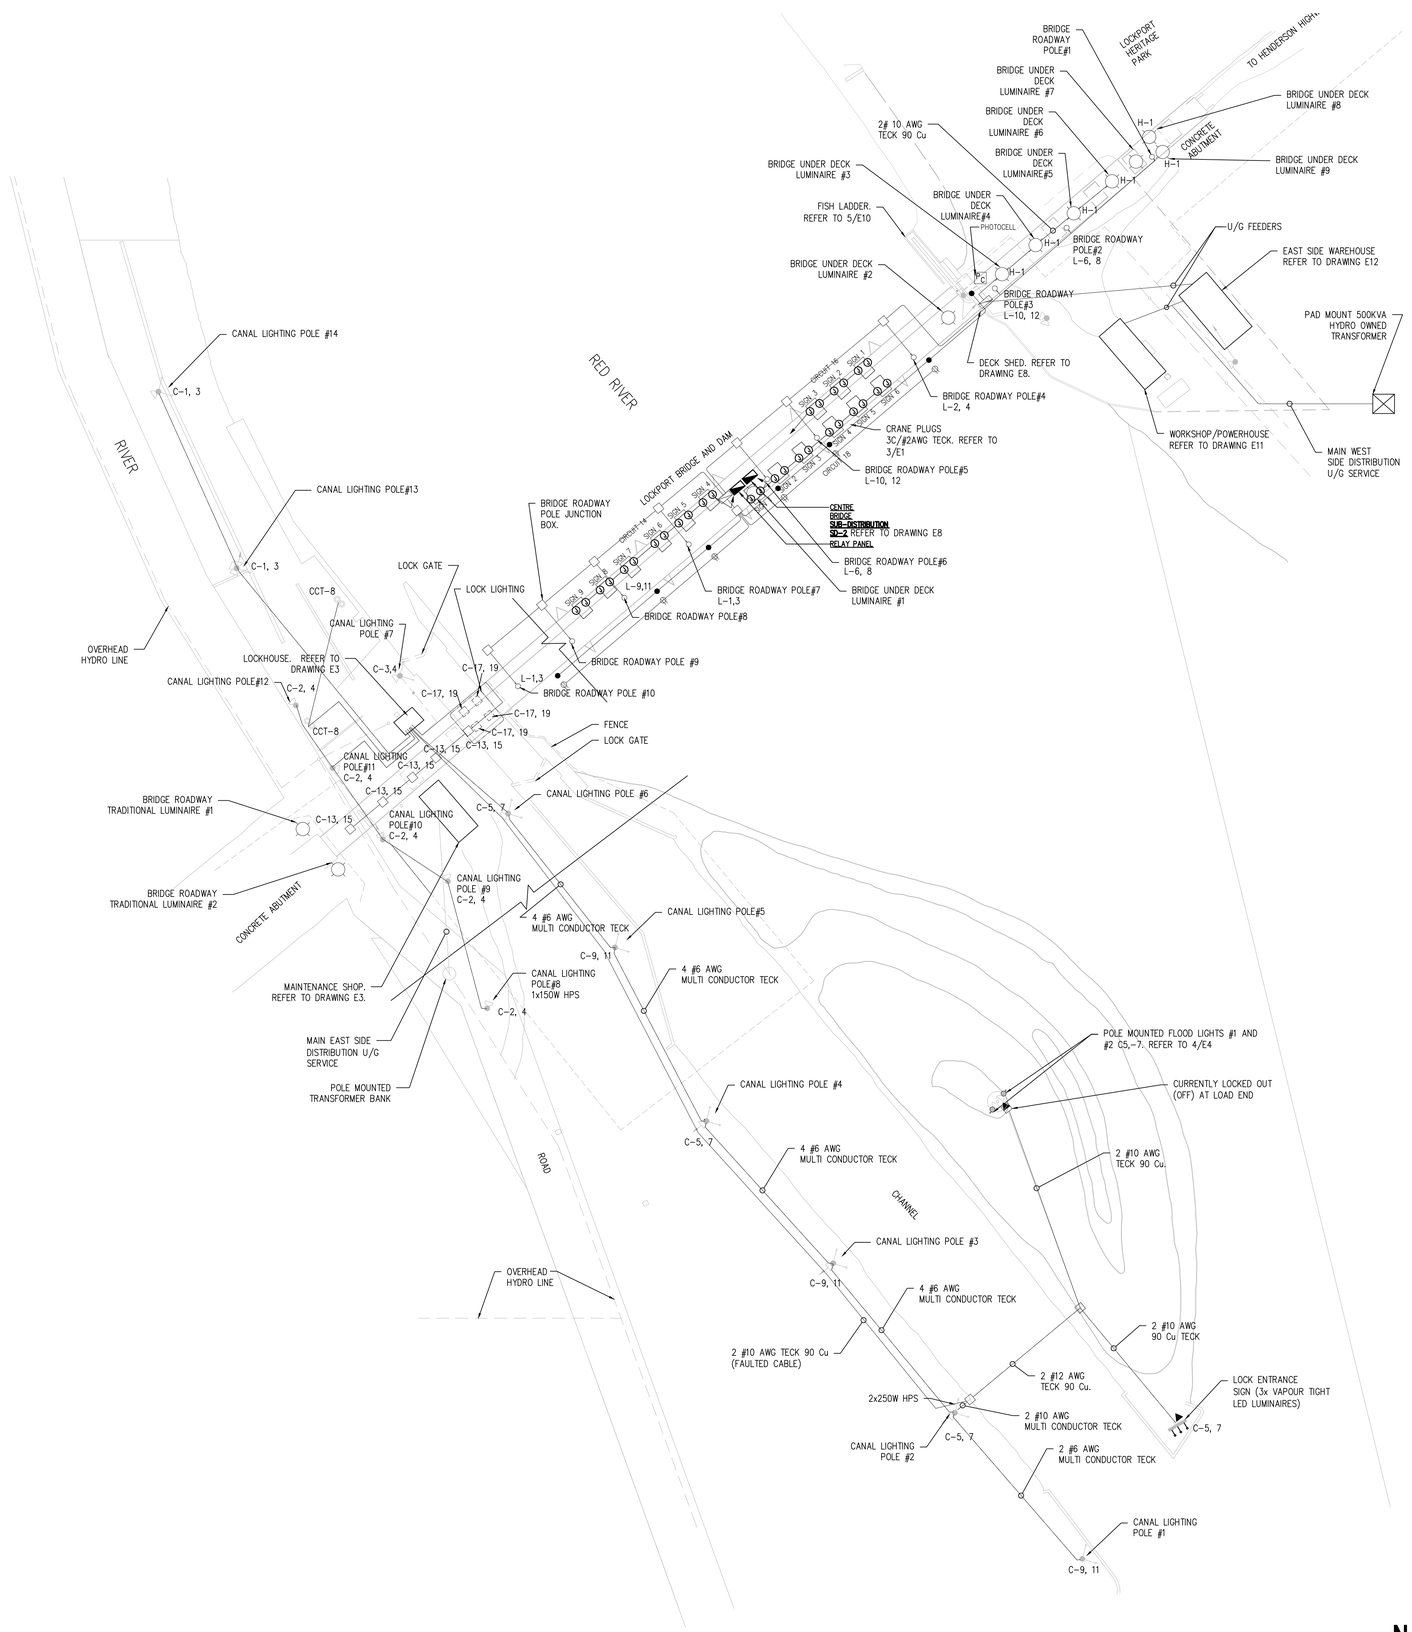


SITE PLAN
N.T.S.

RECORD DRAWING
MAY 2016

**DO NOT SCALE DRAWINGS**

| Revision/Revision | Description/Description | Date/Date |
|---|---|---|
| 0 | RECORD DRAWING | 16/05/20 |

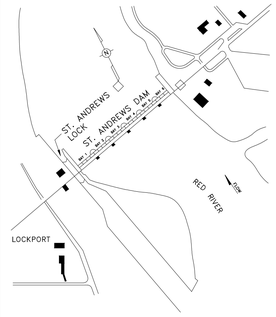Client/client

**ST. ANDREWS LOCK AND DAM**

**ST. ANDREWS, MANITOBA**

Project title/Titre du projet

**ST. ANDREWS LOCK AND DAM**
**ST. ANDREWS, MANITOBA**

**LIGHTING AND ELECTRICAL UPGRADES**

Approved by/Approuve par

Designed by/Concept par

Drawn by/Dessine par

PWGSC Project Manager/Administrateur de Projets TPSGC

PWGSC, Architectural and Engineering Resources Manager/ Ressources Architectural et de Directeur d'ingénierie, TPSGC

Client/client

Drawing title/Titre du dessin

**ELECTRICAL**
**SITE PLAN AND SYMBOL SCHEDULES**

| Project No./No. du projet | Sheet/Feuille | Revision no./ La Révision no. |
|---|---|---|
| R.076331 | E1 OF 16 | 0 |

PWGSC – B1 – 1000X707

0 10 20 30 40 50 60 70 80 90 100mm

E1




1 / E2 BRIDGE SIGN SITE PLAN
1:1000

NOTES:

1. LIGHTING CONTROL PANEL LCP AND MASTER SWITCH STATION ARE LOCATED IN LOCKHOUSE. 25# RIGID PVC CONDUIT IS TERMINATED IN LOCKHOUSE IN JUNCTION BOX AND EXTENDED TO PANEL LCP AND MASTER SWITCH STATION.

2. TYPE A SIGNAL LIGHT IS 12 INCH AMBER LED TRAFFIC BEACON WITH 2 POLE FLASHER WITH MOUNTING HARDWARE AND SEALING KITS.
BODY: ONE PIECE ALUMINUM UNIT WITH INTEGRAL SERRATIONS ON 5° INCREMENTS IN THE END SECTIONS. EACH BODY PROVIDES MOUNTING TERMINAL BLOCKS AND ATTACHING BACKPLATES.
DOOR: ONE PIECE ALUMINUM UNIT WITH STAINLESS STEEL HINGE PINS. THUMBSCREWS HOLD THE DOOR AGAINST THE BODY.
VISOR: ONE PIECE ALUMINUM WITH SLOTTED MOUNTING HOLES. CUTAWAY VISOR.
REFLECTOR: SWING OUT UNIT, ALUMINUM ALZAK FINISH AND SILVERED GLASS.
LENS: GLASS, CONFORMING TO ITE SPECIFICATIONS.
LAMPS: LIGHT EMITTING DIODES (LED).
GASKETS; NEOPRENE.

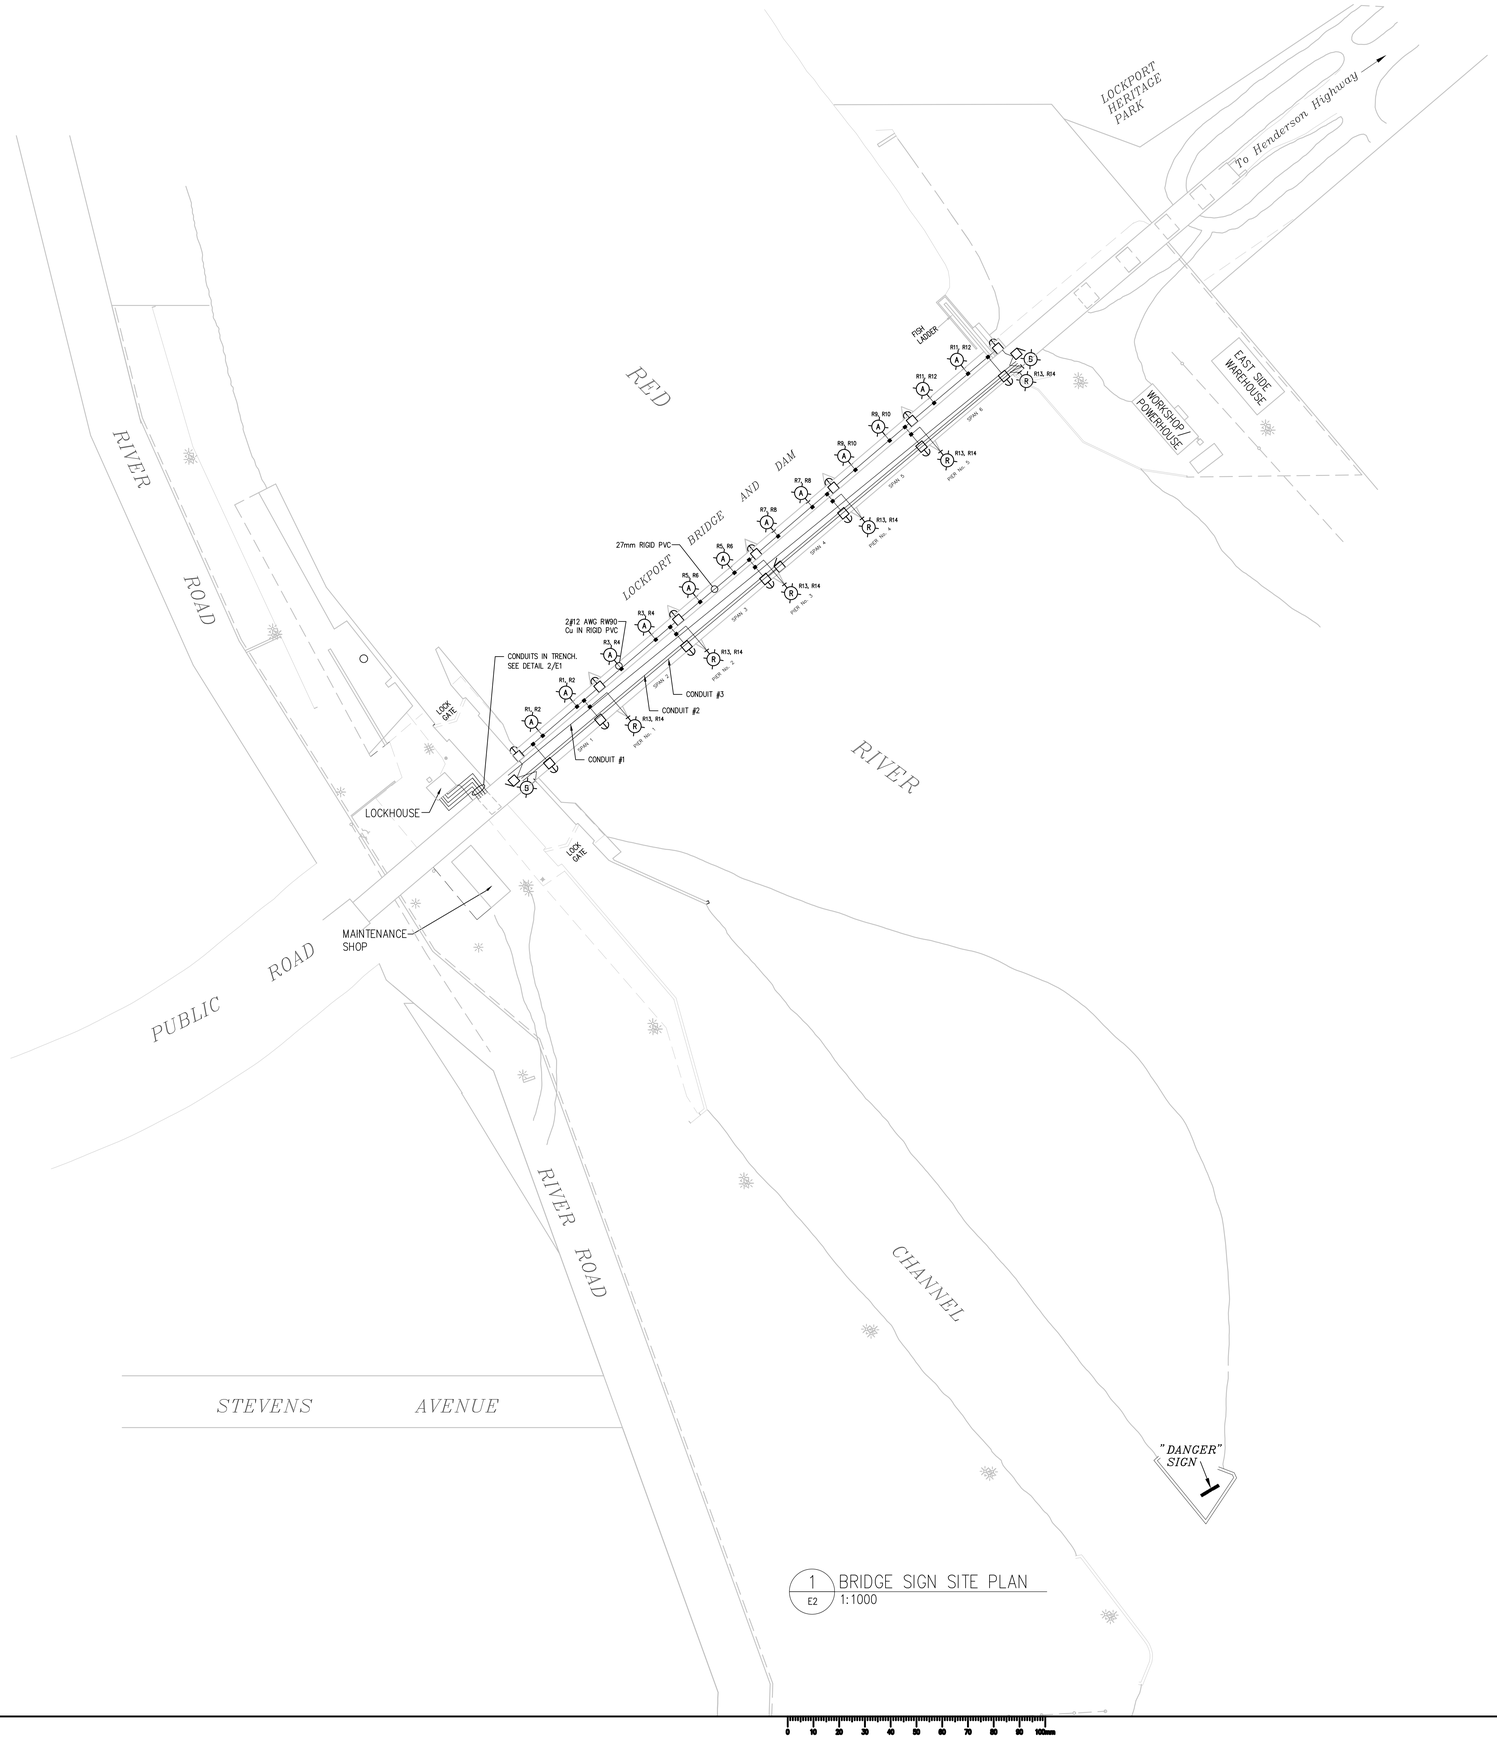3. TYPE R SIGNAL LIGHT IS 12 INCH RED LED TRAFFIC BEACON WITH 2 POLE FLASHER WITH MOUNTING HARDWARE AND SEALING KITS.
BODY: ONE PIECE ALUMINUM UNIT WITH INTEGRAL SERRATIONS ON 5° INCREMENTS IN THE END SECTIONS. EACH BODY PROVIDES FOR MOUNTING TERMINAL BLOCKS AND ATTACHING BACKPLATES.
DOOR: ONE PIECE ALUMINUM UNIT WITH STAINLESS STEEL HINGE PINS. THUMBSCREWS HOLD THE DOOR AGAINST THE BODY.
VISOR: ONE PIECE ALUMINUM WITH SLOTTED MOUNTING HOLES. CUTAWAY VISOR.
REFLECTOR: SWING OUT UNIT, ALUMINUM ALZAK FINISH AND SILVERED GLASS.
LENS: GLASS, CONFORMING TO ITE SPECIFICATIONS.
LAMPS: LIGHT EMITTING DIODES (LED).
GASKETS; NEOPRENE.

4. TYPE A AND TYPE R SIGNAL CONTROLLED THROUGH RELAYS IN RELAY PANEL AND WIRED WITH #12RW90 CONDUCTORS.

5. ALARM SYSTEM CONSISTS OF MUSHROOM HEAD PUSHBUTTONS, TYPE B STROBE LIGHTS AND SIRENS; THE PUSH BUTTONS ACTIVATE THE SIRENS AND STROBE LIGHTS THROUGH A CONTROL INPUT UNIT IN THE RELAY PANEL.
MUSHROOM HEAD PUSHBUTTONS: MOMENTARY CONTACT, 120V. AC, NORMALLY OPEN TYPE WITH RED MUSHROOM HEAD OPERATOR.
TYPE B STROBE LIGHTS: CROUSE-HINDS #VDAS/B, BLUE, 120V, AC., 60 FLASHES PER MINUTE, FOR WET LOCATIONS, SOLID STATE COMPONENTS, CORROSION RESISTANT ALUMINUM, BODY, LEXAN FRESNEL LENS.
SIRENS: EDWARDS #5520-NS, WEATHERPROOF, SOLID STATE, HIGH DECIBEL SOUND OUTPUT.

6. ALL EQUIPMENT AND DEVICES AS INDICATED ARE APPROXIMATE LOCATIONS.

7. CONDUIT IDENTIFICATION: REFER TO SITE PLAN
PULLCORDS IN EMPTY CONDUITS.
CONDUIT #1 – 25# RIGID PVC CONDUIT FROM RELAY CONTROL PANEL ON BRIDGE TO LOCKHOUSE FOR LIGHTING AND SWITCHING CONTROL CABLES.
CONDUIT #2 – 50# RIGID PVC CONDUIT FROM EAST SIDE OF BRIDGE, EAST ABUTMENT TO LOCKHOUSE FOR FUTURE COAX CABLES.
CONDUIT #3 – 50# RIGID PVC CONDUIT FROM EAST SIDE OF BRIDGE, EAST ABUTMENT TO LOCKHOUSE FOR FUTURE USE.

8. CONDUITS INSTALLED ON EXISTING BRIDGE CONDUIT SUPPORT SYSTEM.

Public Works and Government Services Canada / Travaux publics et Services gouvernementaux Canada

REAL PROPERTY SERVICES
Western Region
SERVICES IMMOBILIERS
Région de l'ouest




SITE PLAN
N.T.S.

RECORD DRAWING
MAY 2016

DO NOT SCALE DRAWINGS

| Revision/ Revision | Description/Description | Date/Date |
|---|---|---|
| 0 | RECORD DRAWING | 16/05/20 |

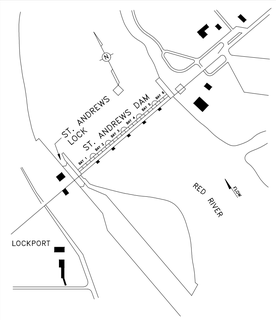Client/client

ST. ANDREWS LOCK AND DAM

ST. ANDREWS, MANITOBA

Project title/Titre du projet
ST. ANDREWS LOCK AND DAM
ST. ANDREWS, MANITOBA

LIGHTING AND ELECTRICAL UPGRADES

Approved by/Approuve par

Designed by/Concept par

Drawn by/Dessine par

PWGSC Project Manager/Administrateur de Projets TPSGC

PWGSC, Architectural and Engineering Resources Manager/ Ressources Architectural et de Directeur d'ingénierie, TPSGC

Client/client

Drawing title/Titre du dessin

BRIDGE SIGN SITE PLAN

| Project No./No. du projet | Sheet/Feuille | Revision no./ La Révision no. |
|---|---|---|
| R.076331 | E2 OF 16 | 0 |

PWGSC – B1 – 1000X707

0 10 20 30 40 50 60 70 80 90 100mm

E2




1 E3 MAINTENANCE SHOP ELECTRICAL LAYOUT
NTS




2 E3 LOCK HOUSE ELECTRICAL LAYOUT
NTS

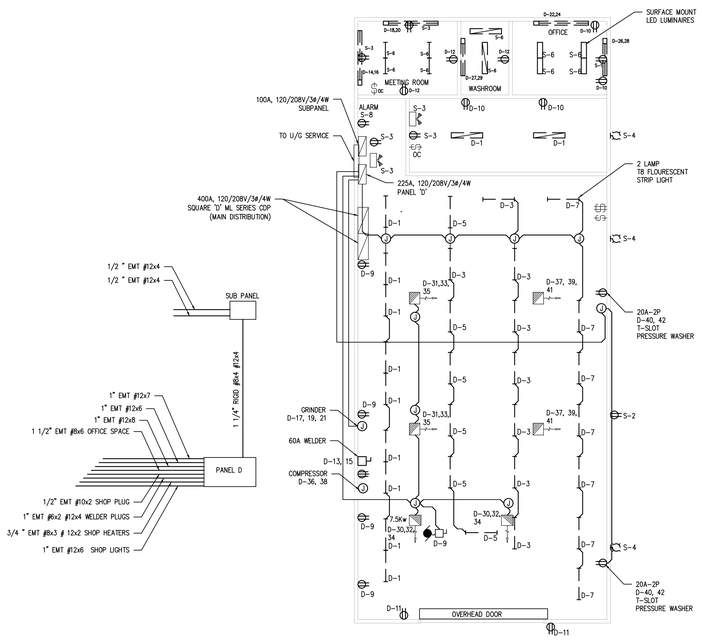


NOTE:
MOST CONDUITS LEAVING TOP OF PANELS DISAPPEAR INTO CEILING

Public Works and Government Services Canada / Travaux publics et Services gouvernementaux Canada

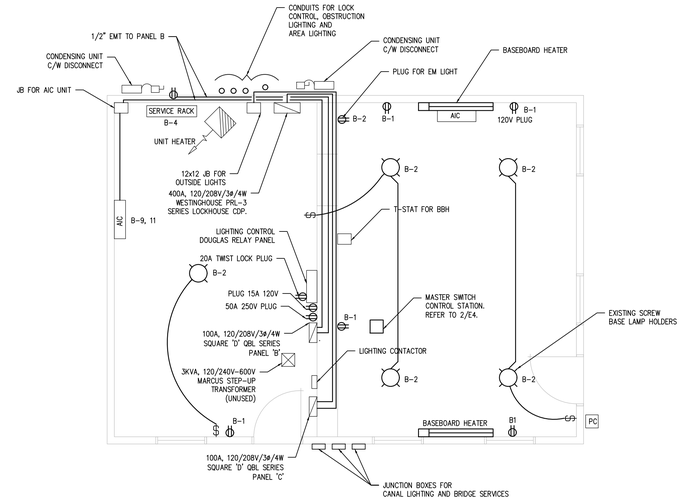REAL PROPERTY SERVICES
Western Region
SERVICES IMMOBILIERS
Région de l'ouest

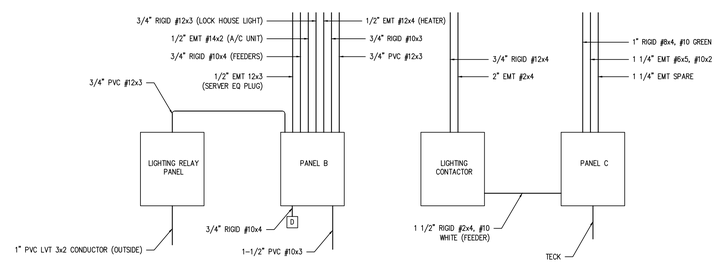


SITE PLAN
N.T.S.

RECORD DRAWING
MAY 2016

DO NOT SCALE DRAWINGS

| Revision/ Révision | Description/Description | Date/Date |
|---|---|---|
| 0 | RECORD DRAWING | 16/05/20 |

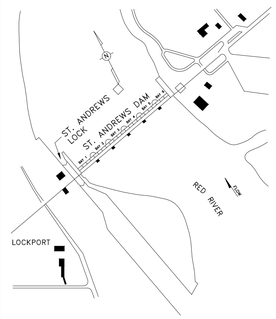Client/client

ST. ANDREWS LOCK AND DAM

ST. ANDREWS, MANITOBA

Project title/Titre du projet
ST. ANDREWS LOCK AND DAM
ST. ANDREWS, MANITOBA

LIGHTING AND ELECTRICAL UPGRADES

Approved by/Approuve par

Designed by/Concept par

Drawn by/Dessine par

PWGSC Project Manager/Administrateur de Projets TPSGC

PWGSC, Architectural and Engineering Resources Manager/ Ressources Architectural et de Directeur d'ingénierie, TPSGC

Client/client

Drawing title/Titre du dessin
MAINTENANCE SHOP AND LOCK HOUSE ELECTRICAL LAYOUT

N

| Project No./No. du projet | Sheet/Feuille | Revision no./ La Révision no. |
|---|---|---|
| R.076331 | E3 OF 16 | 0 |

PWGSC – B1 – 1000X707

0 10 20 30 40 50 60 70 80 90 100mm

E3

## LIGHTING CONTROL PANEL "LCP"

| DESCRIPTION | Circuit Number | Relay Number | Local Switch | Master Switch | T/C Zone | PC Zone |
|---|---|---|---|---|---|---|
| NORTH SPAN 1 – STEADY | 1 | 1 | | | | |
| NORTH SPAN 1 – FLASHING | 1 | 2 | | | | |
| NORTH SPAN 2 – STEADY | 1 | 3 | | | | |
| NORTH SPAN 2 – FLASHING | 1 | 4 | | | | |
| NORTH SPAN 3 – STEADY | 1 | 5 | | | | |
| NORTH SPAN 3 – FLASHING | 1 | 6 | | | | |
| NORTH SPAN 4 – STEADY | 1 | 7 | | | | |
| NORTH SPAN 4 – FLASHING | 1 | 8 | | | | |
| NORTH SPAN 5 – STEADY | 1 | 9 | | | | |
| NORTH SPAN 5 – FLASHING | 1 | 10 | | | | |
| NORTH SPAN 6 – STEADY | 1 | 11 | | | | |
| NORTH SPAN 6 – FLASHING | 1 | 12 | | | | |
| SOUTH – STEADY | 2 | 13 | | | | |
| SOUTH – FLASHING | 2 | 14 | | | | |
| ALARM SYSTEM | 3 | 15 | | | | |
| SPARE RELAY | | 16 | | | | |
| SPARE RELAY | | 17 | | | | |
| SPARE RELAY | | 18 | | | | |
| SPARE RELAY | | 19 | | | | |
| SPARE RELAY | | 20 | | | | |
| SPACE | | 21 | | | | |
| SPACE | | 22 | | | | |
| SPACE | | 23 | | | | |
| SPACE | | 24 | | | | |




1 / E4 FULL 2-WAY LIGHTING CONTROL SCHEMATIC
NTS




2 / E4 MASTER SWITCH CONTROL STATION
NTS

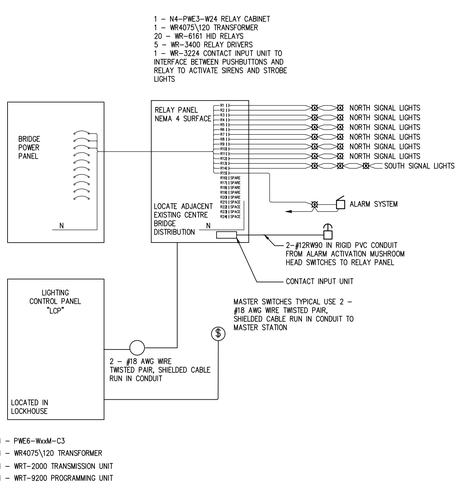


3 / E4 TRENCH DETAIL
NTS

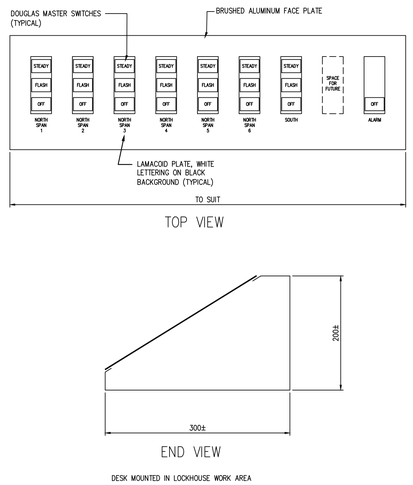


5 / E4 FLOODLIGHT MOUNTING BRACKET
NTS

NOTE:

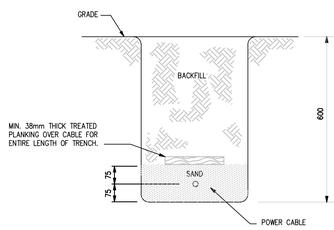REFER TO SCHEDULES ON DRAWING E15 AND E16 FOR LOCATIONS OF FLOODLIGHTS.

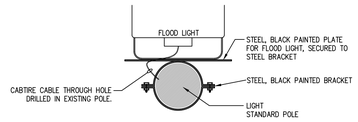


4 / E4 FLAG LIGHTING DETAIL
NTS

N

Public Works and Government Services Canada / Travaux publics et Services gouvernementaux Canada

REAL PROPERTY SERVICES
Western Region
SERVICES IMMOBILIERS
Région de l'ouest

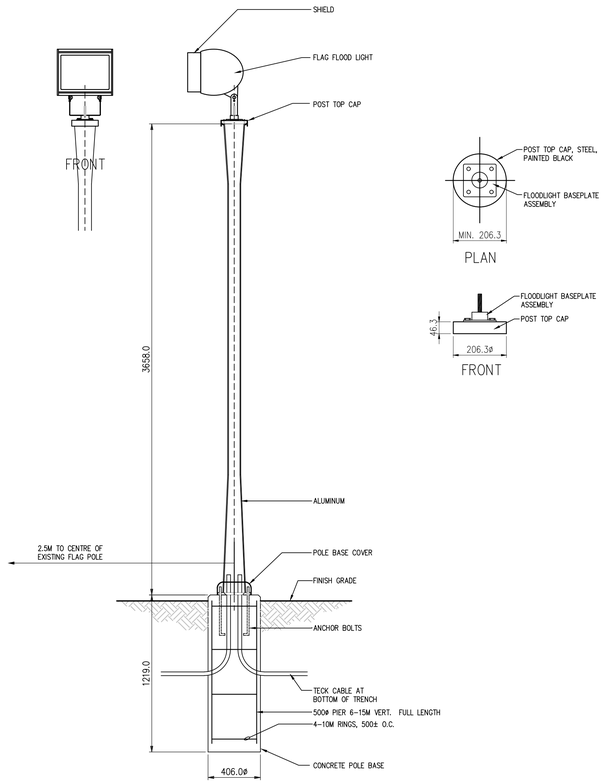RECORD DRAWING
MAY 2016

**DO NOT SCALE DRAWINGS**

| Revision/Revision | Description/Description | Date/Date |
|---|---|---|
| 0 | RECORD DRAWING | 16/05/20 |

Client/client

**ST. ANDREWS LOCK AND DAM**

**ST. ANDREWS, MANITOBA**

Project title/Titre du projet

**ST. ANDREWS LOCK AND DAM**
**ST. ANDREWS, MANITOBA**

**LIGHTING AND ELECTRICAL UPGRADES**

Approved by/Approuve par

Designed by/Concept par

Drawn by/Dessine par

PWGSC Project Manager/Administrateur de Projets TPSGC

PWGSC, Architectural and Engineering Resources Manager/ Ressources Architectural et de Directeur d'Ingénierie, TPSGC

Client/client

Drawing title/Titre du dessin

**EAST SIDE ELECTRICAL DETAILS**

| Project No./No. du projet | Sheet/Feuille | Revision no./ La Révision no. |
|---|---|---|
| R.076331 | E4 OF 16 | - |

PWGSC – B1 – 1000X707




1 / E5 EAST SIDE SINGLE LINE DISTRIBUTION DIAGRAM
NTS

| | VOLTAGE | CURRENT | CABLE |
|---|---|---|---|
| L1 | 346.9V | 29.1A | 3#8RW90 |
| L2 | 353.7V | 29.3A | |
| L3 | 351.6V | 30.8A | |

| | VOLTAGE | CURRENT | CABLE |
|---|---|---|---|
| NO NEUTRAL | | 8.6A L1 | 3#3/0AWG TECK |
| | | 8.1A L2 | |
| | | 7.2A L3 | |

| | VOLTAGE | CURRENT | CABLE |
|---|---|---|---|
| L1 | 348.5V | 3.2A | 3#8AWG TECK |
| L2 | 354.6V | 3.5A | |
| L3 | 352.3V | 1.2A | |
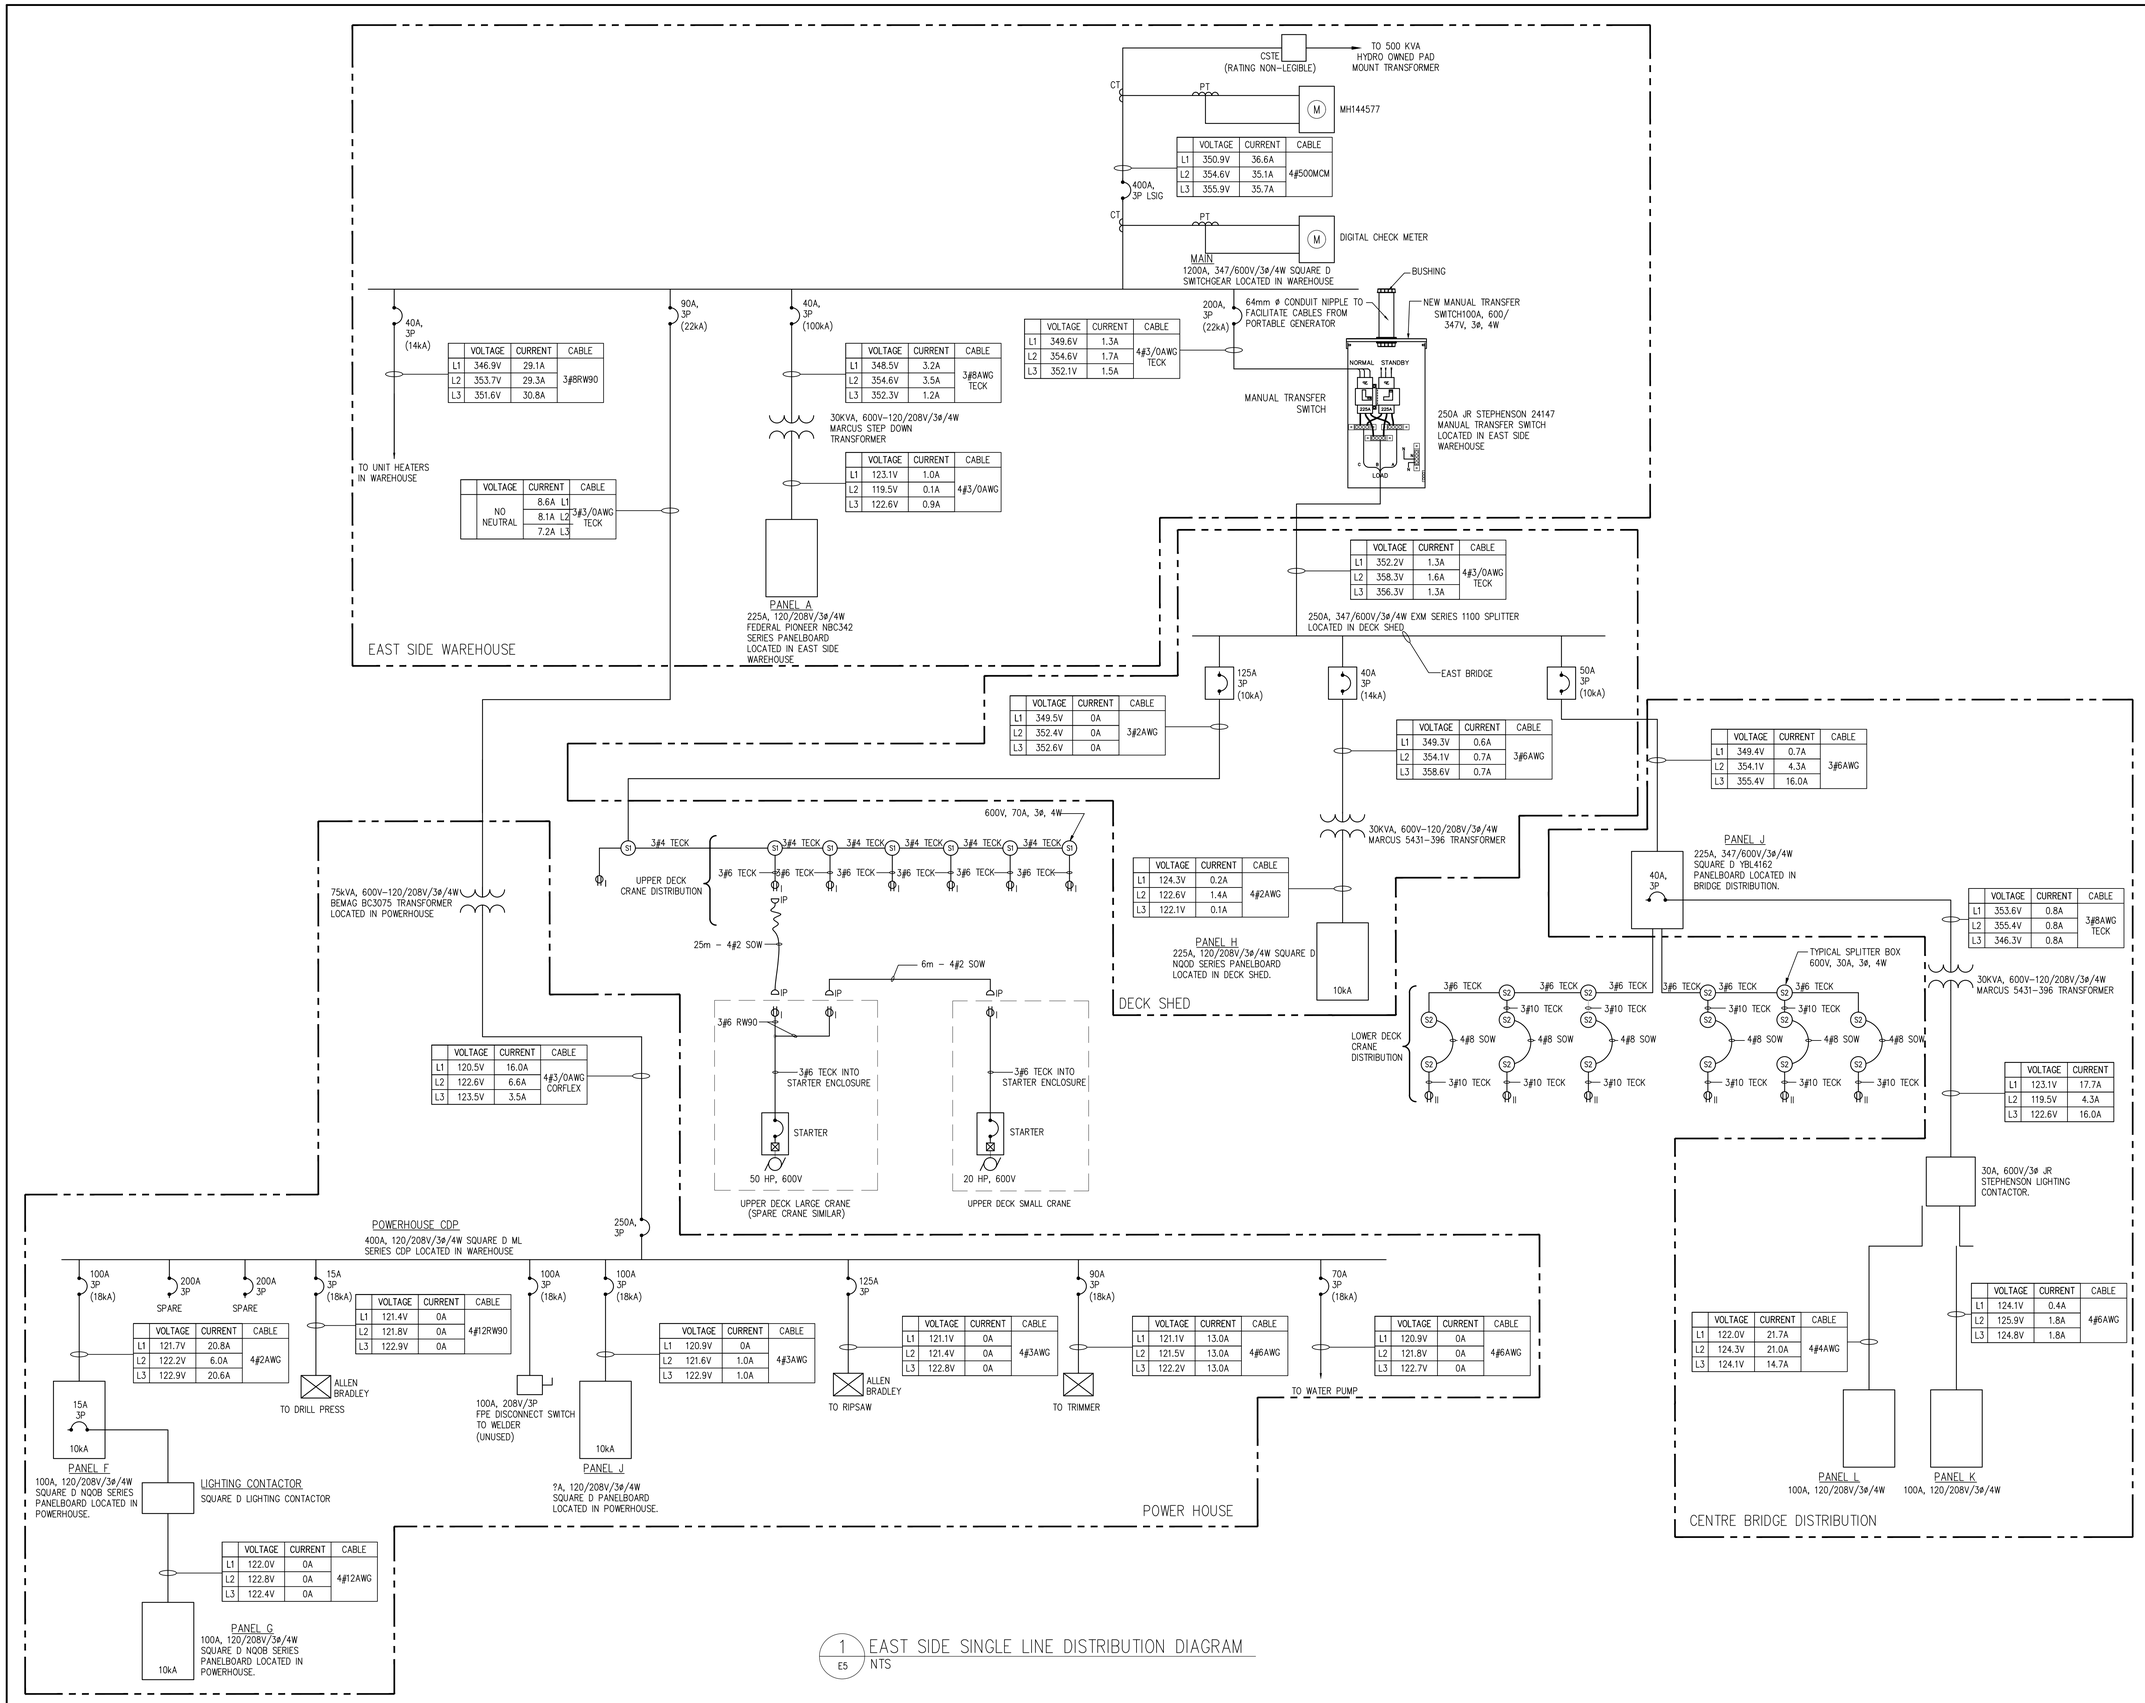
| | VOLTAGE | CURRENT | CABLE |
|---|---|---|---|
| L1 | 123.1V | 1.0A | 4#3/0AWG |
| L2 | 119.5V | 0.1A | |
| L3 | 122.6V | 0.9A | |

| | VOLTAGE | CURRENT | CABLE |
|---|---|---|---|
| L1 | 349.6V | 1.3A | 4#3/0AWG TECK |
| L2 | 354.6V | 1.7A | |
| L3 | 352.1V | 1.5A | |

| | VOLTAGE | CURRENT | CABLE |
|---|---|---|---|
| L1 | 352.2V | 1.3A | 4#3/0AWG TECK |
| L2 | 358.3V | 1.6A | |
| L3 | 356.3V | 1.3A | |

| | VOLTAGE | CURRENT | CABLE |
|---|---|---|---|
| L1 | 349.5V | 0A | 3#2AWG |
| L2 | 352.4V | 0A | |
| L3 | 352.6V | 0A | |

| | VOLTAGE | CURRENT | CABLE |
|---|---|---|---|
| L1 | 349.3V | 0.6A | 3#6AWG |
| L2 | 354.1V | 0.7A | |
| L3 | 358.6V | 0.7A | |

| | VOLTAGE | CURRENT | CABLE |
|---|---|---|---|
| L1 | 349.4V | 0.7A | 3#6AWG |
| L2 | 354.1V | 4.3A | |
| L3 | 355.4V | 16.0A | |

| | VOLTAGE | CURRENT | CABLE |
|---|---|---|---|
| L1 | 124.3V | 0.2A | 4#2AWG |
| L2 | 122.6V | 1.4A | |
| L3 | 122.1V | 0.1A | |

| | VOLTAGE | CURRENT | CABLE |
|---|---|---|---|
| L1 | 353.6V | 0.8A | 3#8AWG TECK |
| L2 | 355.4V | 0.8A | |
| L3 | 346.3V | 0.8A | |

| | VOLTAGE | CURRENT | CABLE |
|---|---|---|---|
| L1 | 120.5V | 16.0A | 4#3/0AWG CORFLEX |
| L2 | 122.6V | 6.6A | |
| L3 | 123.5V | 3.5A | |

| | VOLTAGE | CURRENT |
|---|---|---|
| L1 | 123.1V | 17.7A |
| L2 | 119.5V | 4.3A |
| L3 | 122.6V | 16.0A |

| | VOLTAGE | CURRENT | CABLE |
|---|---|---|---|
| L1 | 121.7V | 20.8A | 4#2AWG |
| L2 | 122.2V | 6.0A | |
| L3 | 122.9V | 20.6A | |

| | VOLTAGE | CURRENT | CABLE |
|---|---|---|---|
| L1 | 121.4V | 0A | 4#12RW90 |
| L2 | 121.8V | 0A | |
| L3 | 122.9V | 0A | |

| | VOLTAGE | CURRENT | CABLE |
|---|---|---|---|
| L1 | 120.9V | 0A | 4#3AWG |
| L2 | 121.6V | 1.0A | |
| L3 | 122.9V | 1.0A | |

| | VOLTAGE | CURRENT | CABLE |
|---|---|---|---|
| L1 | 121.1V | 0A | 4#3AWG |
| L2 | 121.4V | 0A | |
| L3 | 122.8V | 0A | |

| | VOLTAGE | CURRENT | CABLE |
|---|---|---|---|
| L1 | 121.1V | 13.0A | 4#6AWG |
| L2 | 121.5V | 13.0A | |
| L3 | 122.2V | 13.0A | |

| | VOLTAGE | CURRENT | CABLE |
|---|---|---|---|
| L1 | 120.9V | 0A | 4#6AWG |
| L2 | 121.8V | 0A | |
| L3 | 122.7V | 0A | |

| | VOLTAGE | CURRENT | CABLE |
|---|---|---|---|
| L1 | 122.0V | 21.7A | 4#4AWG |
| L2 | 124.3V | 21.0A | |
| L3 | 124.1V | 14.7A | |

| | VOLTAGE | CURRENT | CABLE |
|---|---|---|---|
| L1 | 124.1V | 0.4A | 4#6AWG |
| L2 | 125.9V | 1.8A | |
| L3 | 124.8V | 1.8A | |

| | VOLTAGE | CURRENT | CABLE |
|---|---|---|---|
| L1 | 122.0V | 0A | 4#12AWG |
| L2 | 122.8V | 0A | |
| L3 | 122.4V | 0A | |

Public Works and Government Services Canada / Travaux publics et Services gouvernementaux Canada

REAL PROPERTY SERVICES
Western Region
SERVICES IMMOBILIERS
Région de l'ouest

RECORD DRAWING
MAY 2016

DO NOT SCALE DRAWINGS

| Revision/Revision | Description/Description | Date/Date |
|---|---|---|
| 0 | RECORD DRAWING | 16/05/20 |

Client/client

ST. ANDREWS LOCK AND DAM

ST. ANDREWS, MANITOBA

Project title/Titre du projet

ST. ANDREWS LOCK AND DAM
ST. ANDREWS, MANITOBA

LIGHTING AND ELECTRICAL UPGRADES

Approved by/Approuve par

Designed by/Concept par

Drawn by/Dessine par

PWGSC Project Manager/Administrateur de Projets TPSGC

PWGSC, Architectural and Engineering Resources Manager/Ressources Architectural et de Directeur d'ingénierie, TPSGC

Client/client

Drawing title/Titre du dessin

EAST SIDE SINGLE LINE DISTRIBUTION DIAGRAM

| Project No./No. du projet | Sheet/Feuille | Revision no./La Révision no. |
|---|---|---|
| R.076331 | E5 OF 16 | |

PWGSC – B1 – 1000X707

## PANELBOARD DIRECTORY - EAST SIDE WAREHOUSE

| C | ITEM | MEASURED LOAD | CIRCUIT BREAKER | BREAKER CONDITION | WIRE SIZE | WIRE CONDITION | VOLTAGE |
|---|---|---|---|---|---|---|---|
| 1 | WEST SIDE LIGHTS | 0A | 15A | FUNCTIONAL | #12AWG | GOOD | 122.5V |
| 3 | CENTRE LIGHTS | 0.9A | 15A | FUNCTIONAL | #12AWG | GOOD | 121.5V |
| 5 | EAST SIDE LIGHTS | 1.0A | 15A | FUNCTIONAL | #12AWG | GOOD | 124.5V |
| 7 | 30A RECEPTACLE | 0A | 30A 2P | FUNCTIONAL | #10AWG | GOOD | 122.6V |
| 9 | | 0A | | | #10AWG | GOOD | 121.9V |
| 11 | 30A RECEPTACLE | 0A | 30A 2P | FUNCTIONAL | #10AWG | GOOD | 123.6V |
| 13 | | 0A | | | #10AWG | GOOD | 122.6V |
| 15 | 30A RECEPTACLE | 0A | 30A 2P | FUNCTIONAL | #10AWG | GOOD | 121.6V |
| 17 | | 0A | | | #10AWG | GOOD | 123.8V |
| 19 | 50A WELDER RECEPTACLE | 0A | 50A 2P | FUNCTIONAL | #8AWG | GOOD | 122.7V |
| 21 | | 0A | | | #8AWG | GOOD | 121.6V |
| 23 | | | | | | | |
| 25 | | | | | | | |
| 2 | EXTERIOR LIGHTS WEST EXTERIOR REC | 0A | 15A | FUNCTIONAL | #12AWG | GOOD | 123.0V |
| 4 | SOUTH SIDE INT,EXT.RECS+WEST SIDE RECS | 0A | 15A | FUNCTIONAL | #12AWG | GOOD | 121.8V |
| 6 | EMERG LIGHT/WEST REC'S | 0.1A | 15A | FUNCTIONAL | #12AWG | GOOD | 123.9V |
| 8 | EAST REC'S | 0A | 15A | FUNCTIONAL | #12AWG | GOOD | 123.2V |
| 10 | EAST SIDE REC'S + SOUTH SIDE REC'S | 0A | 15A | FUNCTIONAL | #12AWG | GOOD | 121.7V |
| 12 | NORTH OUTSIDE PLUG | 0A | 15A | FUNCTIONAL | #10AWG | GOOD | 124.0V |
| 14 | BENCH REC | 0A | 15A | FUNCTIONAL | #10AWG | GOOD | 122.6V |
| 16 | COMPRESSOR | 0A | 50A 2P | FUNCTIONAL | #8AWG | GOOD | 121.6V |
| 18 | | 0A | | | #8AWG | GOOD | 124.0V |
| 20 | BACK YARD LIGHTS | 0A | 15A 2P | FUNCTIONAL | #14AWG | GOOD | 122.8V |
| 22 | | 0A | | | #14AWG | GOOD | 121.8V |
| 24 | GARAGE DOOR | 0.1A | 15A | FUNCTIONAL | #14AWG | GOOD | 123.9V |
| 26 | | | | | | | |
| 28 | | | | | | | |
| 30 | | | | | | | |
| 32 | | | | | | | |
| 34 | | | | | | | |
| 36 | | | | | | | |
| 38 | | | | | | | |
| 40 | | | | | | | |
| 42 | | | | | | | |
| | | | | | 225A, 120/208V/3ø/4W | | |

## PANEL F - POWERHOUSE

| C | ITEM | MEASURED LOAD | CIRCUIT BREAKER | BREAKER CONDITION | WIRE SIZE | WIRE CONDITION | VOLTAGE |
|---|---|---|---|---|---|---|---|
| 1 | FURNACE WEST | 10A | 15A | FUNCTIONAL | #12AWG | GOOD | 119.7V |
| 3 | FURNACE EAST | 0.1A | 20A | FUNCTIONAL | #12AWG | GOOD | 120.0V |
| 5 | LUMBER SHED (DELETED) | 0A | 20A | FUNCTIONAL | #12AWG | GOOD | 122.2V |
| 7 | 20A REC WEST WALL | 0A | 20A 2P | FUNCTIONAL | #8AWG | GOOD | 119.6V |
| 9 | | 0A | | | #8AWG | GOOD | 120.4V |
| 11 | EMERGENCY LIGHTING REC | 0A | 15A | FUNCTIONAL | #14AWG | GOOD | 121.8V |
| 13 | LIGHTS | 5.0A | 15A | FUNCTIONAL | #12AWG | GOOD | 119.6V |
| 15 | LIGHTS | 5.8A | 15A | FUNCTIONAL | #12AWG | GOOD | 120.1V |
| 17 | LIGHTS | 5.8A | 15A | FUNCTIONAL | #12AWG | GOOD | 122.0V |
| 19 | RECEPTACLE EAST WALL | 0A | 15A | FUNCTIONAL | #12AWG | GOOD | 119.2V |
| 21 | RECEPTACLE EAST WALL | 0A | 15A | FUNCTIONAL | #12AWG | GOOD | 120.3V |
| 23 | RECEPTACLE EAST WALL | 0A | 20A | FUNCTIONAL | #12AWG | GOOD | 121.7V |
| 25 | RECEPTACLE EAST WALL | 0.5A | 15A | FUNCTIONAL | #12AWG | GOOD | 119.6V |
| 27 | HEAT TRACE (WELL PUMP) | 0.1A | 15A | FUNCTIONAL | #12AWG | GOOD | 120.5V |
| 29 | PRESSURE TANK | 0.1A | 15A | FUNCTIONAL | #12AWG | GOOD | 121.7V |
| 2 | LIGHTING CONTACTOR (FEEDS SUB PANEL G) | 0A | 15A 3P | FUNCTIONAL | #12AWG | GOOD | 119.5V |
| 4 | | 0A | | | #12AWG | GOOD | 120.6V |
| 6 | | 0A | | | #12AWG | GOOD | 121.6V |
| 8 | *LINE SIDE BREAKER METAL FATIGUED* | | | POOR | | | |
| 10 | NORTH WALL PL#2 | 0.1A | 15A | FUNCTIONAL | #12AWG | GOOD | 120.6V |
| 12 | SUB PANEL K | 0.2A | 30A 2P | FUNCTIONAL | #10AWG | GOOD | 121.7V |
| 14 | | 6.1A | | | #10AWG | GOOD | 119.8V |
| 16 | PARKING LOT PLUGS | 0A | 15A | FUNCTIONAL | #12AWG | GOOD | 121.0V |
| 18 | PARKING LOT PLUGS | 0A | 15A | FUNCTIONAL | #12AWG | GOOD | 121.5V |
| 20 | SHEAR | 0.1A | 15A 3P | FUNCTIONAL | #12AWG | GOOD | 119.8V |
| 22 | | 0A | | | #12AWG | GOOD | 121.0V |
| 24 | | 0A | | | #12AWG | GOOD | 121.3V |
| 26 | NORTH WALL PLUG | 0A | 15A | FUNCTIONAL | #12AWG | GOOD | 119.8V |
| 28 | WEST WALL PLUG | 0A | 15A 2P | FUNCTIONAL | #12AWG | GOOD | 121.0V |
| 30 | WEST WALL PLUG | 0A | | | #12AWG | GOOD | 121.2V |
| | | | | | 225A, 120/208V/3ø/4W | | |

## PANEL G - POWERHOUSE NO LOAD

| C | ITEM | MEASURED LOAD | CIRCUIT BREAKER | BREAKER CONDITION | WIRE SIZE | WIRE CONDITION |
|---|---|---|---|---|---|---|
| 1 | AREA LIGHTS | 0A | 15A, 2P | FUNCTIONAL | #12AWG | GOOD |
| 3 | AREA LIGHTS | 0A | | | #12AWG | GOOD |
| 5 | AREA LIGHTS | 0A | 15A, 2P | FUNCTIONAL | #12AWG | GOOD |
| 7 | AREA LIGHTS | 0A | | | #12AWG | GOOD |
| 9 | SPACE | | | | | |
| 11 | SPACE | | | | | |
| 2 | SPACE | | | | | |
| 4 | SPACE | | | | | |
| 6 | SPACE | | | | | |
| 8 | SPACE | | | | | |
| 10 | SPACE | | | | | |
| 12 | SPACE | | | | | |
| | | | | | 100A, 120/208V/3ø/4W | |

## PANELBOARD DIRECTORY - H - DECK SHED

| C | ITEM | MEASURED LOAD | CIRCUIT BREAKER | BREAKER CONDITION | WIRE SIZE | WIRE CONDITION | VOLTAGE |
|---|---|---|---|---|---|---|---|
| 1 | UNDER ROAD/PHOTOCELL/ FISH LADDER | 0A | 30A | FUNCTIONAL | #10AWG | GOOD | 124V |
| 3 | SPACE | | | | | | |
| 5 | CONTACTOR (UNUSED) | 0A | 15A 2P | FUNCTIONAL | #12AWG | GOOD | 122.8V |
| 7 | | 0A | | | #12AWG | GOOD | 122.0V |
| 9 | DECK SHED LIGHTS | 1.4A | 15A | FUNCTIONAL | #12AWG | GOOD | 122.0V |
| 11 | OUTDOOR PLUG | 0A | 15A | FUNCTIONAL | #12AWG | GOOD | 122.1V |
| 2 | PANEL PLUG | 0A | 15A | FUNCTIONAL | #12AWG | GOOD | 123.7V |
| 4 | 20A TWIST LOCK PANEL PLUG | 0A | 15A 3P | FUNCTIONAL | #12AWG | GOOD | 123.2V |
| 6 | | 0A | | | #12AWG | GOOD | 121.3V |
| 8 | | 0A | | | #12AWG | GOOD | 121.6V |
| 10 | PARK LIGHTS (TWO POLES) | 0.1A | 15A 2P | FUNCTIONAL | #12AWG | GOOD | 122.2V |
| 12 | | 0.1A | | | #12AWG | GOOD | 121.5V |
| | | | | | 225A, 120/208V/3ø/4W | | |

## PANEL K - POWERHOUSE

| C | ITEM | MEASURED LOAD | CIRCUIT BREAKER | BREAKER CONDITION | WIRE SIZE | WIRE CONDITION | VOLTAGE |
|---|---|---|---|---|---|---|---|
| 1 | LUNCH RM MIC. FR, LUNCH+OFFICE LTS, HALL RECS | 4.1A | 15A | FUNCTIONAL | #12AWG | GOOD | 121.2V |
| 2 | BACK LTS, EMD LTS, S. WALL REC'S | 2.0A | 15A | FUNCTIONAL | #12AWG | GOOD | 121.2V |
| 3 | | | | | | | |
| 4 | | | | | | | |
| 5 | OFFICE REC'S | 0.2A | 15A | FUNCTIONAL | #14AWG | GOOD | 123.4V |
| 6 | OUTSIDE PLUGS | 0A | 15A | FUNCTIONAL | #12AWG | GOOD | 123.4V |
| 7 | | | | | | | |
| 8 | | | | | | | |
| | | | | | 100A, 120/208V/3ø/4W | | |

## MAIN CDP - POWERHOUSE

| C | ITEM | MEASURED LOAD | CIRCUIT BREAKER | BREAKER CONDITION | WIRE SIZE | WIRE CONDITION |
|---|---|---|---|---|---|---|
| 1 | PANEL F | 20.8A | 100A 3P | FUNCTIONAL | #2AWG | GOOD |
| 3 | | 6.0A | | | #2AWG | GOOD |
| 5 | | 20.6A | | | #2AWG | GOOD |
| 7 | SPARE | | 200A 3P | FUNCTIONAL | | |
| 9 | | | | | | |
| 11 | | | | | | |
| 13 | SPARE | | 200A 3P | FUNCTIONAL | | |
| 15 | | | | | | |
| 17 | | | | | | |
| 19 | DRILL PRESS | 0A | 15A 3P | FUNCTIONAL | #12AWG | GOOD |
| 21 | | 0A | | | #12AWG | GOOD |
| 23 | | 0A | | | #12AWG | GOOD |
| 25 | WELDER | 0A | 100A 3P | FUNCTIONAL | #3AWG | GOOD |
| 27 | | 0A | | | #3AWG | GOOD |
| 29 | | 0A | | | #3AWG | GOOD |
| 2 | PANEL J | 0A | 100A 3P | FUNCTIONAL | #3AWG | GOOD |
| 4 | | 1.0A | | | #3AWG | GOOD |
| 6 | | 1.0A | | | #3AWG | GOOD |
| 8 | RIP SAW | 0A | BREAKER SIZE UNKNOWN | FUNCTIONAL | #3AWG | GOOD |
| 10 | | 0A | | | #3AWG | GOOD |
| 12 | | 0A | | | #3AWG | GOOD |
| 14 | SPACE | | | | | |
| 16 | | | | | | |
| 18 | | | | | | |
| 20 | TRIMMER | 13.0A | 90A 3P | FUNCTIONAL | #6AWG | GOOD |
| 22 | | 13.0A | | | #6AWG | GOOD |
| 24 | | 13.0A | | | #6AWG | GOOD |
| 26 | WATER PUMP | 0A | 70A 3P | FUNCTIONAL | #6AWG | GOOD |
| 28 | | 0A | | | #6AWG | GOOD |
| 30 | | 0A | | | #6AWG | GOOD |
| | | | | | 400A, 120/208V/3ø/4W | |

Public Works and Government Services Canada / Travaux publics et Services gouvernementaux Canada

REAL PROPERTY SERVICES
Western Region
SERVICES IMMOBILIERS
Région de l'ouest

RECORD DRAWING
MAY 2016

**DO NOT SCALE DRAWINGS**

| Revision/ Revision | Description/Description | Date/Date |
|---|---|---|
| 0 | RECORD DRAWING | 16/05/20 |

Client/client

**ST. ANDREWS LOCK AND DAM**

**ST. ANDREWS, MANITOBA**

Project title/Titre du projet

**ST. ANDREWS LOCK AND DAM**
**ST. ANDREWS, MANITOBA**

**LIGHTING AND ELECTRICAL UPGRADES**

Approved by/Approuve par

Designed by/Concept par

Drawn by/Dessine par

PWGSC Project Manager/Administrateur de Projets TPSGC

PWGSC, Architectural and Engineering Resources Manager/ Ressources Architectural et de Directeur d'Ingénierie, TPSGC

Client/client

Drawing title/Titre du dessin

**EAST SIDE ELECTRICAL PANELBOARD SCHEDULES-1**

| Project No./No. du projet | Sheet/Feuille | Revision no./ La Révision no. |
|---|---|---|
| R.076331 | E6 OF 16 | 0 |

PWGSC – B1 – 1000X707

## PANELBOARD DIRECTORY - K - BRIDGE CENTRE DISTRIBUTION

| C | ITEM | MEASURED LOAD | CIRCUIT BREAKER | BREAKER CONDITION | WIRE SIZE | WIRE CONDITION | VOLTAGE |
|---|---|---|---|---|---|---|---|
| 1 | UNKNOWN | 0.8A | 15A | ORIGINAL BREAKER | #12AWG | GOOD | 124.0V |
| 3 | UNKNOWN | 0.4A/1.2A | A-15A/B-15A | ORIGINAL BREAKER | 2x#12AWG | GOOD | 126.3V/126.0V |
| 5 | UNKNOWN | 1.8A | 15A | ORIGINAL BREAKER | #12AWG | GOOD | 125.3V |
| 7 | UNKNOWN | | 50A 3P | ORIGINAL BREAKER (SPARE) | | | |
| 9 | UNKNOWN | | | | | | |
| 11 | UNKNOWN | | | | | | |
| 2 | UNKNOWN | | 30A 3P | ORIGINAL BREAKER (SPARE) | | | |
| 4 | UNKNOWN | | | | | | |
| 6 | UNKNOWN | | | | | | |
| 8 | UNKNOWN | 0.8A | 15A | ORIGINAL BREAKER | #4AWG | GOOD | 124.3V |
| 10 | UNKNOWN | 0.8A | 15A | ORIGINAL BREAKER | #4AWG | GOOD | 124.1V |
| 12 | UNKNOWN | 0.8A | A-15A/B-15A | ORIGINAL BREAKER | 2x#12AWG | GOOD | 0.0V/125.2V |
| | | | | | 225A, 120/208V/3ø/4W | | |

## PANELBOARD DIRECTORY - L - BRIDGE CENTRE DISTRIBUTION

| C | ITEM | MEASURED LOAD | CIRCUIT BREAKER | BREAKER CONDITION | WIRE SIZE | WIRE CONDITION | VOLTAGE |
|---|---|---|---|---|---|---|---|
| 1 | BRIDGE LIGHTS | 2.8A | 15A 2P | ORIGINAL BREAKER | #8AWG | FAIR | 122.4V |
| 3 | | 1.8A | | | #8AWG | FAIR | 124.7V |
| 5 | BRIDGE LIGHTS | 1.2A | 15A 2P | ORIGINAL BREAKER | #8AWG | FAIR | 124.0V |
| 7 | | 1.2A | | | #8AWG | FAIR | 122.6V |
| 9 | BRIDGE LIGHTS | | 15A 2P | ORIGINAL BREAKER | #8AWG | FAIR | 124.9V |
| 11 | | | | | #8AWG | FAIR | 124.1V |
| 13 | SPARE | | 30A 3P | ORIGINAL BREAKER | | | |
| 15 | | | | | | | |
| 17 | | | | | | | |
| 19 | SPACE | 2.8A | | | | | |
| 2 | BRIDGE LIGHTS | 3.8A | 15A 2P | ORIGINAL BREAKER | #8AWG | POOR | 123.0V |
| 4 | | 3.8A | | | #8AWG | POOR | 125.2V |
| 6 | BRIDGE LIGHTS | 2.9A | 15A 2P | ORIGINAL BREAKER | #8AWG | POOR | 124.5V |
| 8 | | 2.9A | | | #8AWG | POOR | 123.1V |
| 10 | BRIDGE LIGHTS | | 15A 2P | ORIGINAL BREAKER | #8AWG | POOR | 125.2V |
| 12 | | | | | #8AWG | POOR | 124.5V |
| 14 | SIGN LIGHTS N.W. | 12.8A | 20A | ORIGINAL BREAKER | #10AWG | POOR | 122.8V |
| 16 | SIGN LIGHTS N.E. | 11.8A | 15A | ORIGINAL BREAKER | #10AWG | POOR | 125.3V |
| 18 | SIGN LIGHTS SOUTH | 7.5A | 20A | ORIGINAL BREAKER | #10AWG | POOR | 125.3V |
| 20 | SPACE | | | | | | |
| | | | | | 100A, 120/208V/3ø/4W | | |

## PANEL J - POWERHOUSE

| C | ITEM | MEASURED LOAD | CIRCUIT BREAKER | BREAKER CONDITION | WIRE SIZE | WIRE CONDITION | VOLTAGE |
|---|---|---|---|---|---|---|---|
| 1 | 20A, 3ø PLUG EAST WALL | 0A | 20A 3P | ORIGINAL BREAKER | #12AWG | GOOD | 122.1V |
| 3 | | 0A | | | #12AWG | GOOD | 124.0V |
| 5 | | 0A | | | #12AWG | GOOD | 119.9V |
| 7 | SPLIT PLUG EAST WALL | 0A | 20A 2P | ORIGINAL BREAKER | #12AWG | GOOD | 121.9V |
| 9 | | 0A | | | #12AWG | GOOD | 123.5V |
| 11 | GRINDER | 0A | 15A 3P | ORIGINAL BREAKER | #12AWG | GOOD | 119.5V |
| 13 | | 0A | | | #12AWG | GOOD | 121.7V |
| 15 | | 0A | | | #12AWG | GOOD | 123.4V |
| 17 | LUNCH ROOM N. WALL REC/HOT WATER TANK | 0A | A-15A/B-15A | ORIGINAL BREAKER | 2x#12AWG | GOOD | 119.4V/119.3V |
| 19 | A/C | 0A | 20A 2P | ORIGINAL BREAKER | #12AWG | GOOD | 121.6V |
| 21 | | 0A | | | #12AWG | GOOD | 123.6V |
| 23 | WELDER PLUG EAST WALL | 0A | 50A 2P | ORIGINAL BREAKER | #8AWG | GOOD | 119.7V |
| 25 | | 0A | | | #8AWG | GOOD | 121.7V |
| 27 | PLANER PLUG | 0A | 40A 2P | ORIGINAL BREAKER | #10AWG | GOOD | 123.1V |
| 29 | | 0A | | | #10AWG | GOOD | 119.6V |
| 2 | SHAPER | 0A | 20A 3P | ORIGINAL BREAKER | #12AWG | GOOD | 121.9V |
| 4 | | 0A | | | #12AWG | GOOD | 123.3V |
| 6 | | 0A | | | #12AWG | GOOD | 119.5V |
| 8 | FEEDER | 0A | 15A 3P | ORIGINAL BREAKER | #12AWG | GOOD | 121.2V |
| 10 | | 0A | | | #12AWG | GOOD | 122.9V |
| 12 | | 0A | | | #12AWG | GOOD | 118.7V |
| 14 | AIR COMPRESSOR | 0A | 30A 3P | ORIGINAL BREAKER | #12AWG | GOOD | 121.2V |
| 16 | | 0A | | | #12AWG | GOOD | 122.4V |
| 18 | | 0A | | | #12AWG | GOOD | 118.7V |
| 20 | DUST COLLECTOR #1 | 0.6A | 30A 3P | ORIGINAL BREAKER | #12AWG | GOOD | 120.5V |
| 22 | | 0.6A | | | #12AWG | GOOD | 122.3V |
| 24 | | 0A | | | #12AWG | GOOD | 119.0V |
| 26 | DUST COLLECTOR #2 | 0.5A | 30A 3P | ORIGINAL BREAKER | #12AWG | GOOD | 121.4V |
| 28 | | 0.5A | | | #12AWG | GOOD | 123.3V |
| 30 | | 0A | | | #12AWG | GOOD | 120.0V |
| | | | | | 225A, 347/600V/3ø/4W | | |

NOTES:
1. CCT'S #27,29 #14,16,18 #20,22,24 #26,28,30 HAVE WIRING THAT DOES NOT MEET MINIMUM CODE REQUIREMENTS FOR AMPACITY.

## PANELBOARD DIRECTORY - J - BRIDGE CENTRE DISTRIBUTION

| C | ITEM | MEASURED LOAD | CIRCUIT BREAKER | BREAKER CONDITION | WIRE SIZE | WIRE CONDITION | VOLTAGE |
|---|---|---|---|---|---|---|---|
| 1 | | | | | | | |
| 2 | | | | | | | |
| 3 | | | | | | | |
| 4 | | | | | | | |
| 5 | | | | | | | |
| 6 | TRANSFORMER | 0.8A | 40A 3P | ORIGINAL BREAKER | #8AWG | GOOD | |
| 7 | | 0.8A | | | #8AWG | GOOD | |
| 8 | | 0.8A | | | #8AWG | GOOD | |
| 9 | | | | | | | |
| 10 | | | | | | | |
| 11 | | | | | | | |
| 12 | | | | | | | |
| 13 | HOIST PLUGS | 0A | 30A 3P | ORIGINAL BREAKER | #6AWG | GOOD | 355.5V |
| 14 | | 0A | | | #6AWG | GOOD | 355.7V |
| 15 | | 0A | | | #6AWG | GOOD | 345.5V |
| 16 | | | | | | | |
| 17 | | | | | | | |
| 29 | HOIST PLUGS | 0A | 30A 3P | ORIGINAL BREAKER | #6AWG | GOOD | 354.7V |
| 30 | | 0A | | | #6AWG | GOOD | 355.7V |
| 31 | | 0A | | | #6AWG | GOOD | 344.8V |
| 32 | | | | | | | |
| 33 | | | | | | | |
| 34 | | | | | | | |
| | | | | | 225A, 120/208V/3ø/4W | | |

Public Works and Government Services Canada / Travaux publics et Services gouvernementaux Canada

REAL PROPERTY SERVICES
Western Region
SERVICES IMMOBILIERS
Région de l'ouest

RECORD DRAWING
MAY 2016

DO NOT SCALE DRAWINGS

| Revision/Revision | Description/Description | Date/Date |
|---|---|---|
| 0 | RECORD DRAWING | 16/05/20 |

Client/client

**ST. ANDREWS LOCK AND DAM**

**ST. ANDREWS, MANITOBA**

Project title/Titre du projet
ST. ANDREWS LOCK AND DAM
ST. ANDREWS, MANITOBA

**LIGHTING AND ELECTRICAL UPGRADES**

Approved by/Approuve par

Designed by/Concept par

Drawn by/Dessine par

PWGSC Project Manager/Administrateur de Projets TPSGC

PWGSC, Architectural and Engineering Resources Manager/ Ressources Architectural et de Directeur d'ingénierie, TPSGC

Client/client

Drawing title/Titre du dessin

**EAST SIDE ELECTRICAL PANELBOARD SCHEDULES-2**

| Project No./No. du projet | Sheet/Feuille | Revision no./La Révision no. |
|---|---|---|
| R.076331 | E7 OF 16 | 0 |

PWGSC – B1 – 1000X707




1 / E8 CENTRE BRIDGE SUB-DISTRIBUTION
NTS




5 / E8 TYPE S1 SPLITTER BOX AND CABLE THROUGH DETAIL
NTS

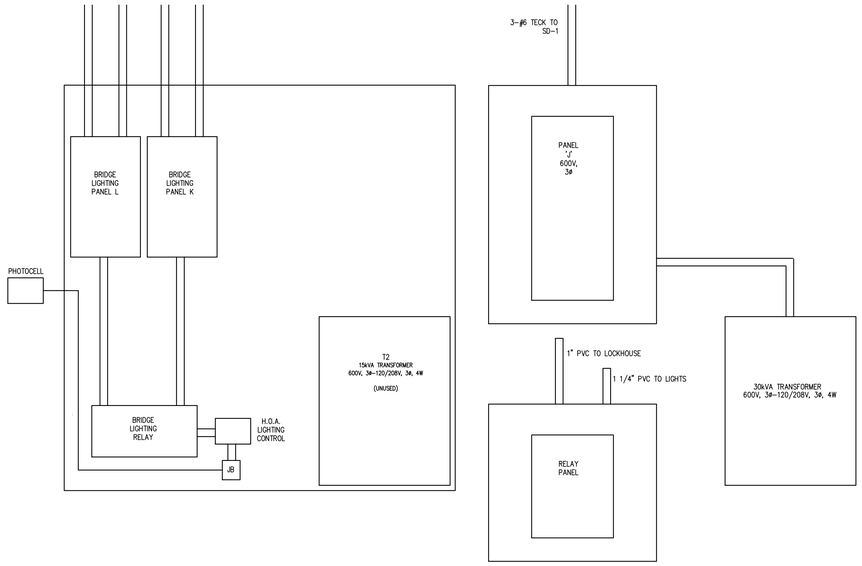


4 / E8 SERVICES LAYOUT
NTS

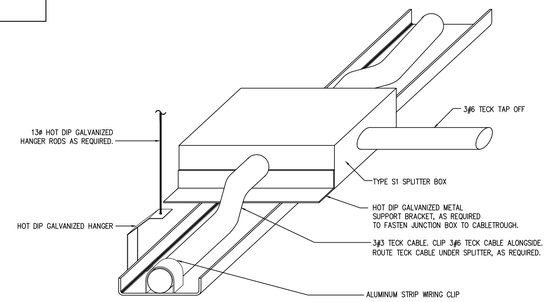


2 / E8 EAST BRIDGE DECK SUB-DISTRIBUTION
NTS

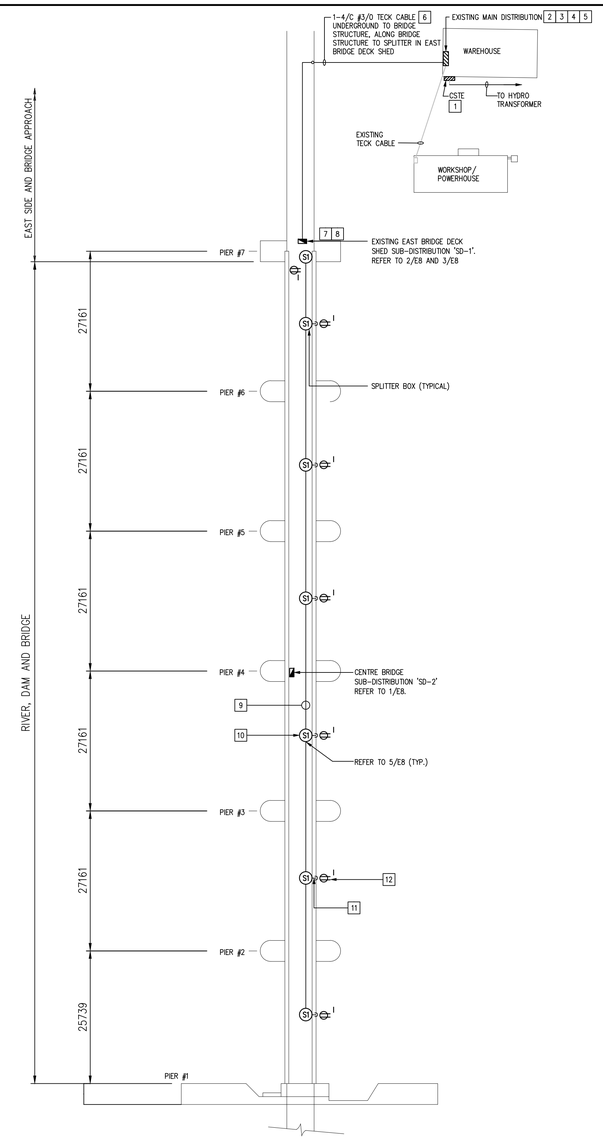


3 / E8 DECK SHED BRIDGE WEST-EAST
NTS

NOTES:

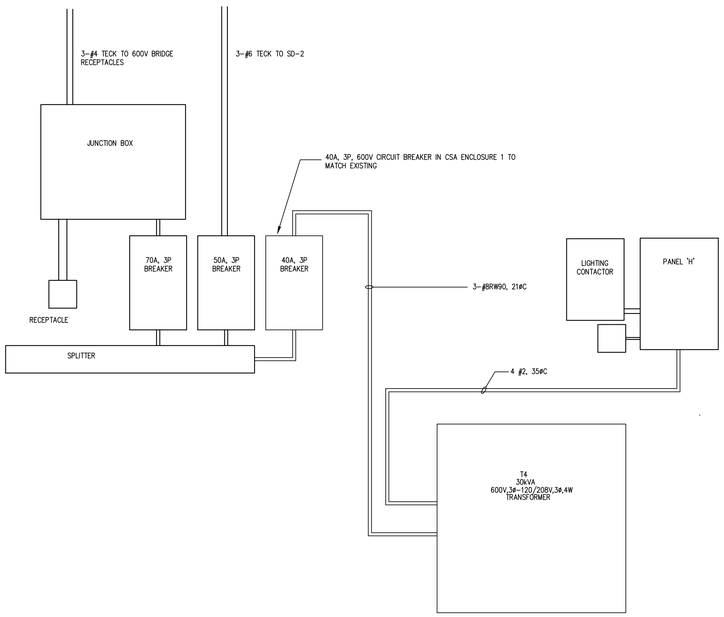2 4-1/C #600 MCM RW90 CONDUCTORS IN 100# CONDUIT FROM CSTE TO MAIN DISTRIBUTION.

3 EXISTING 600V, 400A, 3P SQUARE 'D' TYPE MXL BREAKER.

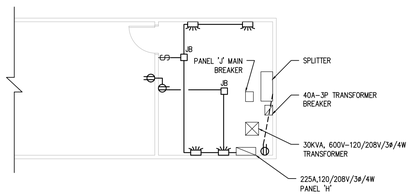4 EXISTING 600V, 200A, 3P SQUARE 'D' TYPE KA SUB-BREAKER IN DISTRIBUTION SECTION OF MAIN DISTRIBUTION.

5 EXISTING 600V, 250A, 3P MANUAL TRANSFER SWITCH WITH 600V, 225A, 3P BREAKERS.

6 EXISTING 4/C #3/0 TECK CABLE FROM NEW 225A, 3P SUB BREAKER (EAST BRIDGE DECK SUB-DISTRIBUTION) TO 250A, 4P SPLITTER IN EAST BRIDGE DECK SHED.

7 EXISTING 600V, 250A, 4P SPLITTER.

8 EXISTING 600V, 125A, 3P ENCLOSED CIRCUIT BREAKER.

9 EXISTING 3/C #1 TECK CABLES FROM 125A, 3P BREAKER (ITEM #8) IN EAST BRIDGE DECK SHED TO SPLITTER BOXES S1 (ITEM #10) AND FROM SPLITTER BOXES (S1) TO RECEPTACLES (ITEM #12).

10 EXISTING SPLITTER BOXES WITH INTERNAL BARRIER.

11 EXISTING 3/C #6 TECK FROM SPLITTER BOXES (S1) TO RECEPTACLES.

12 EXISTING 600V, 100A, 4P GROUNDING RECEPTACLES.

N

Public Works and Government Services Canada / Travaux publics et Services gouvernementaux Canada

REAL PROPERTY SERVICES
Western Region
SERVICES IMMOBILIERS
Région de l'ouest

RECORD DRAWING
MAY 2016

DO NOT SCALE DRAWINGS

| Revision/ Revision | Description/Description | Date/Date |
|---|---|---|
| 0 | RECORD DRAWING | 16/05/20 |

Client/client

ST. ANDREWS LOCK AND DAM

ST. ANDREWS, MANITOBA

Project title/Titre du projet
ST. ANDREWS LOCK AND DAM
ST. ANDREWS, MANITOBA

LIGHTING AND ELECTRICAL UPGRADES

Approved by/Approuve par

Designed by/Concept par

Drawn by/Dessine par

PWGSC Project Manager/Administrateur de Projets TPSGC

PWGSC, Architectural and Engineering Resources Manager/ Ressources Architectural et de Directeur d'ingénierie, TPSGC

Client/client

Drawing title/Titre du dessin

DECK SHED ELECTRICAL LAYOUT AND DISTRIBUTION DIAGRAM AND CENTRE BRIDGE DISTRIBUTION DIAGRAM AND SERVICES LAYOUT

| Project No./No. du projet | Sheet/Feuille | Revision no./ La Révision no. |
|---|---|---|
| R.076331 | E8 OF 16 | 0 |

PWGSC – B1 – 1000X707

0 10 20 30 40 50 60 70 80 90 100mm

E8




ALL ASSEMBLY AND SIGN FIXTURE MOUNTING MATERIALS SHALL BE GALVANIZED STEEL, INCLUDING BOLTS, WASHERS, STEEL PLATES, TUBING ETC.

1 / E9 SIGN LIGHTING FIXTURE MOUNTING ASSEMBLY
1:500




3 / E9 BRIDGE SOUTH SIDE SIGN LIGHTING
NTS

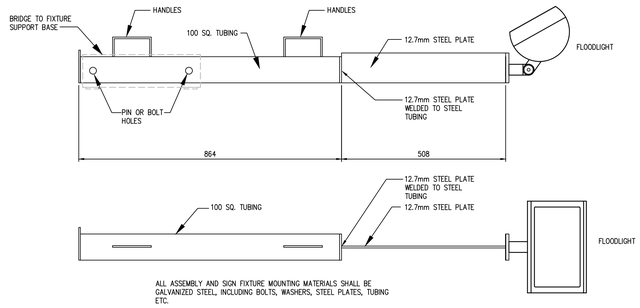TYPICAL FOR SIGNS 1 TO 6 AS INDICATED ON SOUTH ELEVATION.

MOUNT JUNCTION BOXES ON STEEL BRIDGE STRUCTURE AND WIRE FLOODLIGHTS WITH MINIMUM 2/C #12 CABTIRE CABLES.

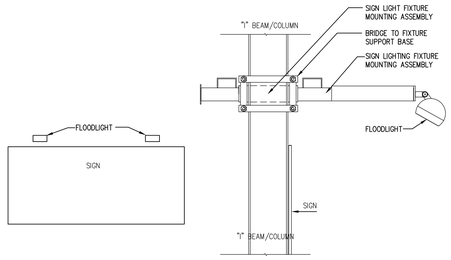


2 / E9 SIGN LIGHTING CONTROL SCHEMATIC
NTS




4 / E9 BRIDGE NORTH SIDE SIGN LIGHTING
NTS

TYPICAL FOR SIGNS 1 TO 9 AS INDICATED ON NORTH ELEVATION.

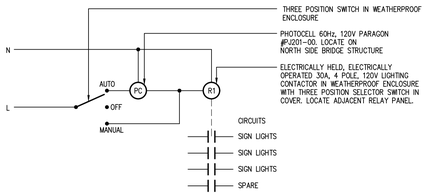


5 / E9 SIGN LIGHT FIXTURE MOUNTING ASSEMBLY
NTS

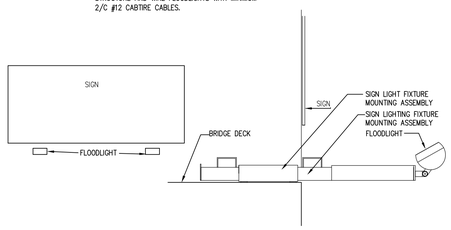


6 / E9 BRIDGE TO FIXTURE SUPPORT BASE
NTS

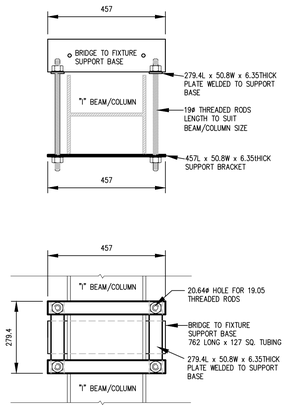


7 / E9 SOUTH ELEVATION
1:500

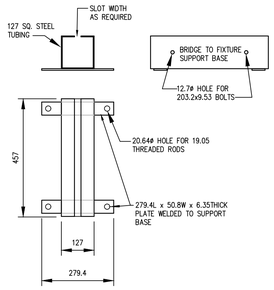


8 / E9 NORTH ELEVATION
1:500

N

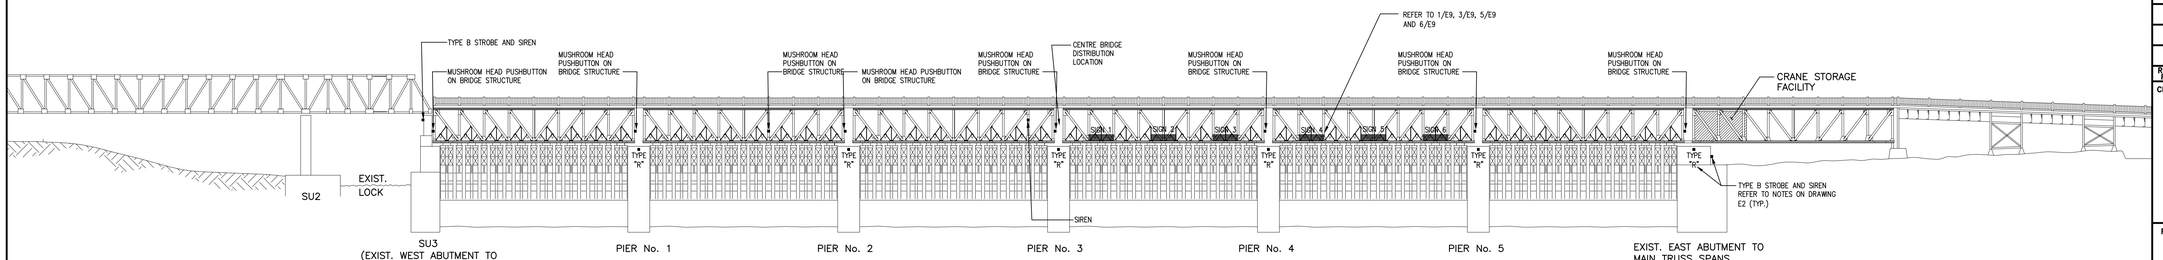Public Works and Government Services Canada / Travaux publics et Services gouvernementaux Canada

REAL PROPERTY SERVICES
Western Region
SERVICES IMMOBILIERS
Région de l'ouest

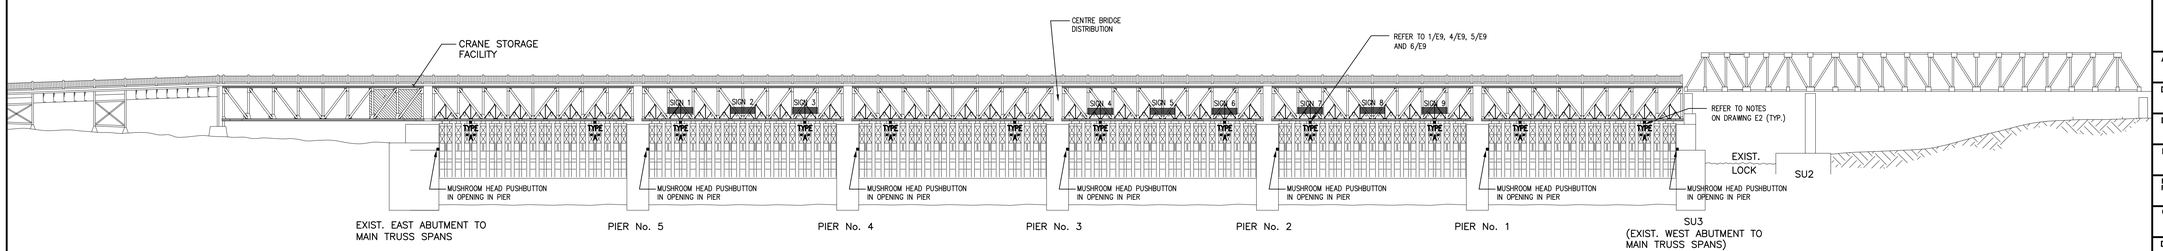


SITE PLAN
N.T.S.

RECORD DRAWING
MAY 2016

DO NOT SCALE DRAWINGS

| Revision/ Revision | Description/Description | Date/Date |
|---|---|---|
| 0 | RECORD DRAWING | 16/05/20 |

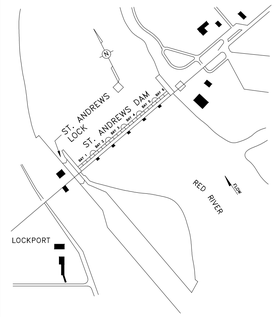Client/client

ST. ANDREWS LOCK AND DAM

ST. ANDREWS, MANITOBA

Project title/Titre du projet

ST. ANDREWS LOCK AND DAM
ST. ANDREWS, MANITOBA

LIGHTING AND ELECTRICAL UPGRADES

Approved by/Approuve par

Designed by/Concept par

Drawn by/Dessine par

PWGSC Project Manager/Administrateur de Projets TPSGC

PWGSC, Architectural and Engineering Resources Manager/ Ressources Architectural et de Directeur d'ingénierie, TPSGC

Client/client

Drawing title/Titre du dessin

SOUTH AND NORTH ELEVATION, BRIDGE SIGN LIGHTING AND DETAILS

| Project No./No. du projet | Sheet/Feuille | Revision no./ La Révision no. |
|---|---|---|
| R.076331 | E9 OF 16 | 0 |

PWGSC – B1 – 1000X707

0 10 20 30 40 50 60 70 80 90 100mm

E9




1 E10 POLE ELEVATION
NTS




2 E10 BASE DETAIL
NTS

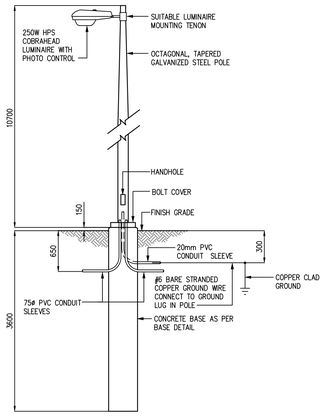


3 E10 TRENCH DETAIL
NTS

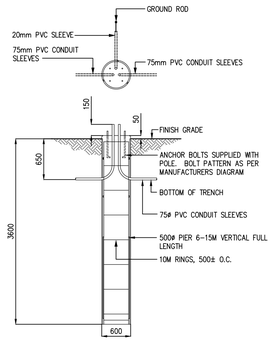


NOTE:
1. REFER TO DETAIL 1/E1 AND 1/E2 FOR DETAILS. THIS DETAIL SHOWS TYPICAL WORK ON THE UPPER AND LOWER DECK LEVELS.

4 E10 BRIDGE SECTION
NTS

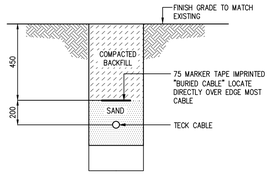


5 E10 FISH LADDER DETAIL
NTS

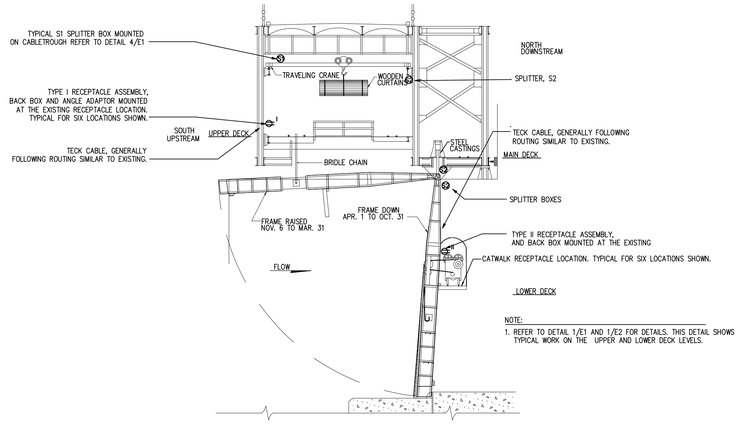Public Works and Government Services Canada / Travaux publics et Services gouvernementaux Canada

REAL PROPERTY SERVICES
Western Region
SERVICES IMMOBILIERS
Région de l'ouest

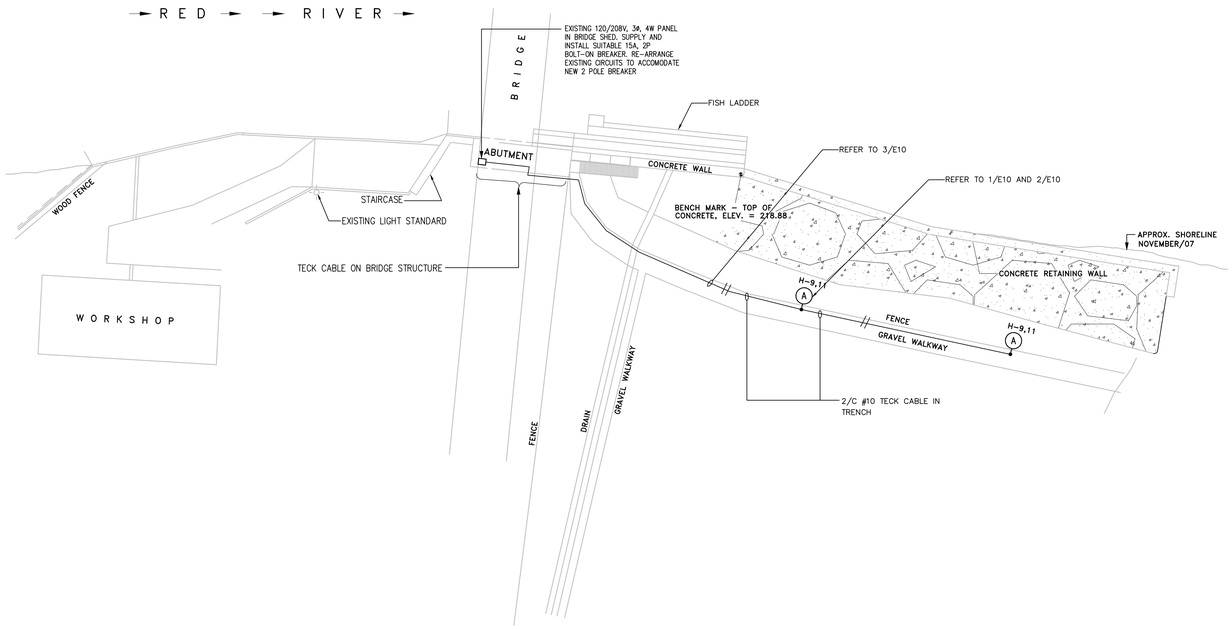


SITE PLAN
N.T.S.

RECORD DRAWING
MAY 2016

DO NOT SCALE DRAWINGS

| Revision/Revision | Description/Description | Date/Date |
|---|---|---|
| 0 | RECORD DRAWING | 16/05/20 |

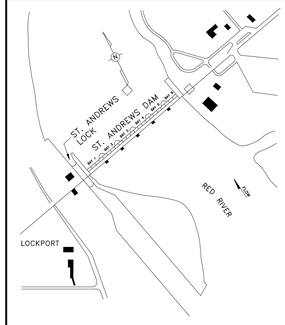Client/client

ST. ANDREWS LOCK AND DAM

ST. ANDREWS, MANITOBA

Project title/Titre du projet
ST. ANDREWS LOCK AND DAM
ST. ANDREWS, MANITOBA

LIGHTING AND ELECTRICAL UPGRADES

Approved by/Approuve par

Designed by/Concept par

Drawn by/Dessine par

PWGSC Project Manager/Administrateur de Projets TPSGC

PWGSC, Architectural and Engineering Resources Manager/ Ressources Architectural et de Directeur d'ingénierie, TPSGC

Client/client

Drawing title/Titre du dessin

FISH LADDER DETAIL, BRIDGE SECTION AND DETAILS

N

| Project No./No. du projet | Sheet/Feuille | Revision no./ La Révision no. |
|---|---|---|
| R.076331 | E10 OF 16 | 0 |

PWGSC – B1 – 1000X707

0 10 20 30 40 50 60 70 80 90 100mm




1 / E11 WORKSHOP/POWER HOUSE FLOOR PLAN
1:100




1. PANEL Y1; 100A, 3P
2. PANEL Y2; 100A, 3P
3. 200A, 3P - SPARE
4. RIP SAW; 125A, 3P (25HP)
5. 200A, 3P; SPARE
6. SPACE
7. DRILL PRESS; 15A, 3P (2HP)
8. TRIMMER; 90A, 3P (15HP)
9. WELDER; 100A, 2P
10. WATER PUMP; 70A, 3P (15HP)
11. MAIN BREAKER; 250A, 3P

3 / E11 WORKSHOP/POWERHOUSE MAIN DISTRIBUTION MD-1
1:100

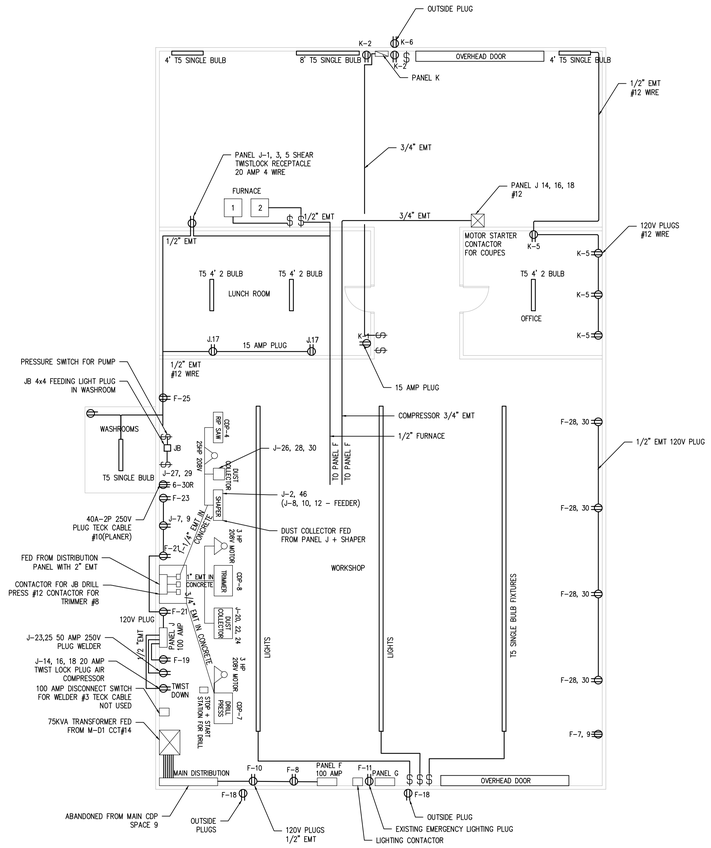


2 / E11 WORKSHOP/POWER HOUSE PIPE FILL
NTS

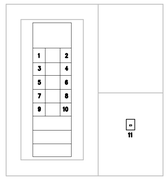N

Public Works and Government Services Canada
Travaux publics et Services gouvernementaux Canada

REAL PROPERTY SERVICES
Western Region
SERVICES IMMOBILIERS
Région de l'ouest

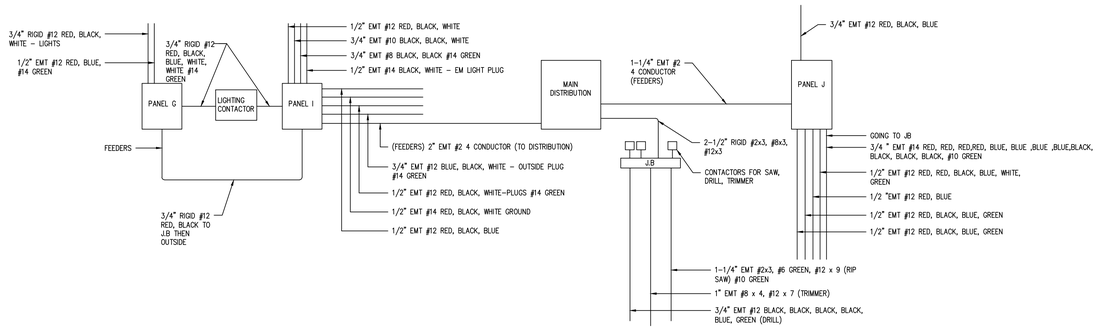


SITE PLAN
N.T.S.

RECORD DRAWING
MAY 2016

DO NOT SCALE DRAWINGS

| Revision/ Revision | Description/Description | Date/Date |
|---|---|---|
| 0 | RECORD DRAWING | 16/05/20 |

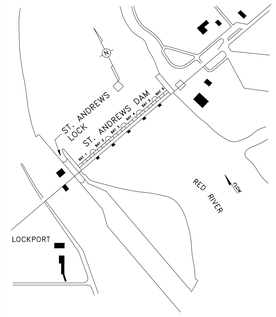Client/client

ST. ANDREWS LOCK AND DAM

ST. ANDREWS, MANITOBA

Project title/Titre du projet

ST. ANDREWS LOCK AND DAM
ST. ANDREWS, MANITOBA

LIGHTING AND ELECTRICAL UPGRADES

Approved by/Approuve par

Designed by/Concept par

Drawn by/Dessine par

PWGSC Project Manager/Administrateur de Projets TPSGC

PWGSC, Architectural and Engineering Resources Manager/ Ressources Architectural et de Directeur d'ingénierie, TPSGC

Client/client

Drawing title/Titre du dessin

WORKSHOP POWER HOUSE FLOOR PLAN AND WORKSHOP/POWER HOUSE PIPE FILL

| Project No./No. du projet | Sheet/Feuille | Revision no./ La Révision no. |
|---|---|---|
| R.076331 | E11 OF 16 | 0 |

PWGSC – B1 – 1000X707

0 10 20 30 40 50 60 70 80 90 100mm




1 / E12 EAST SIDE WAREHOUSE FLOOR PLAN
1:50




2 / E12 PIPE FILL
NTS

N

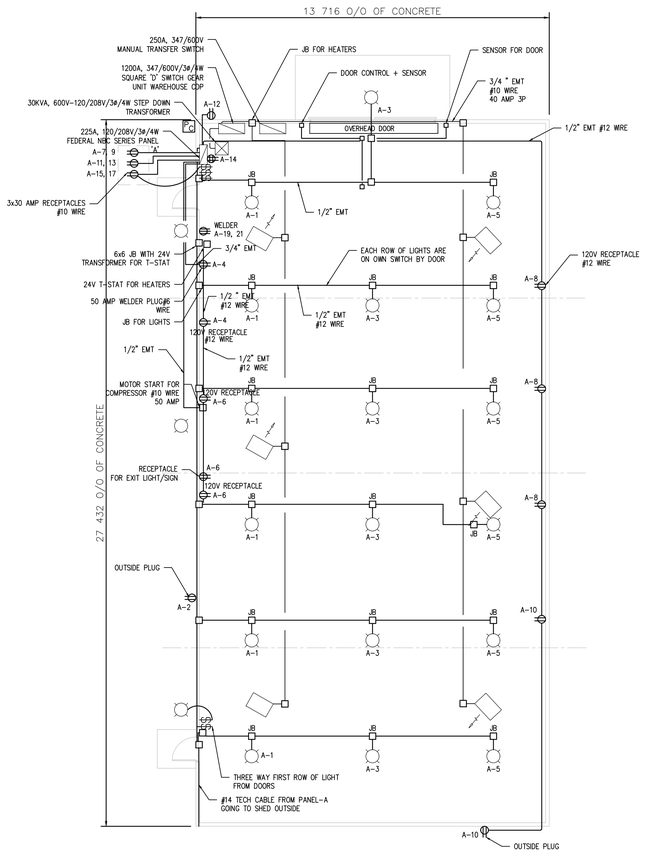Public Works and Government Services Canada / Travaux publics et Services gouvernementaux Canada

REAL PROPERTY SERVICES
Western Region
SERVICES IMMOBILIERS
Région de l'ouest

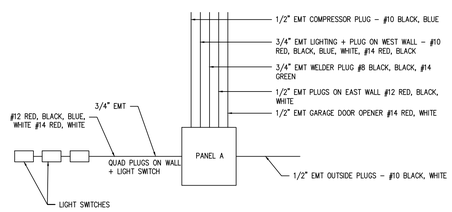


*SITE PLAN*
*N.T.S.*

RECORD DRAWING
MAY 2016

DO NOT SCALE DRAWINGS

| Revision/ Revision | Description/Description | Date/Date |
|---|---|---|
| 0 | RECORD DRAWING | 16/05/20 |

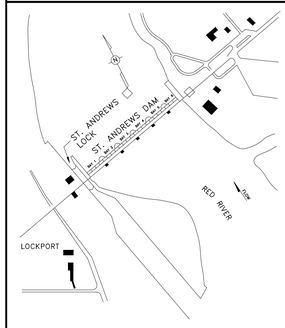Client/client

**ST. ANDREWS LOCK AND DAM**

**ST. ANDREWS, MANITOBA**

Project title/Titre du projet
ST. ANDREWS LOCK AND DAM
ST. ANDREWS, MANITOBA

**LIGHTING AND ELECTRICAL UPGRADES**

Approved by/Approuve par

Designed by/Concept par

Drawn by/Dessine par

PWGSC Project Manager/Administrateur de Projets TPSGC

PWGSC, Architectural and Engineering Resources Manager/ Ressources Architectural et de Directeur d'Ingénierie, TPSGC

Client/client

Drawing title/Titre du dessin

**EAST SIDE WAREHOUSE FLOOR PLAN, PIPE FILL AND EAST SIDE ELECTRICAL SCHEMATIC**

| Project No./No. du projet | Sheet/Feuille | Revision no./ La Révision no. |
|---|---|---|
| R.076331 | E12 OF 16 | 0 |

PWGSC – B1 – 1000X707

0 10 20 30 40 50 60 70 80 90 100mm

E12




1 / E13 WEST SIDE SINGLE LINE DISTRIBUTION DIAGRAM
NTS

PWGSC – B1 – 1000X707

Public Works and Government Services Canada / Travaux publics et Services gouvernementaux Canada

REAL PROPERTY SERVICES
Western Region
SERVICES IMMOBILIERS
Région de l'ouest

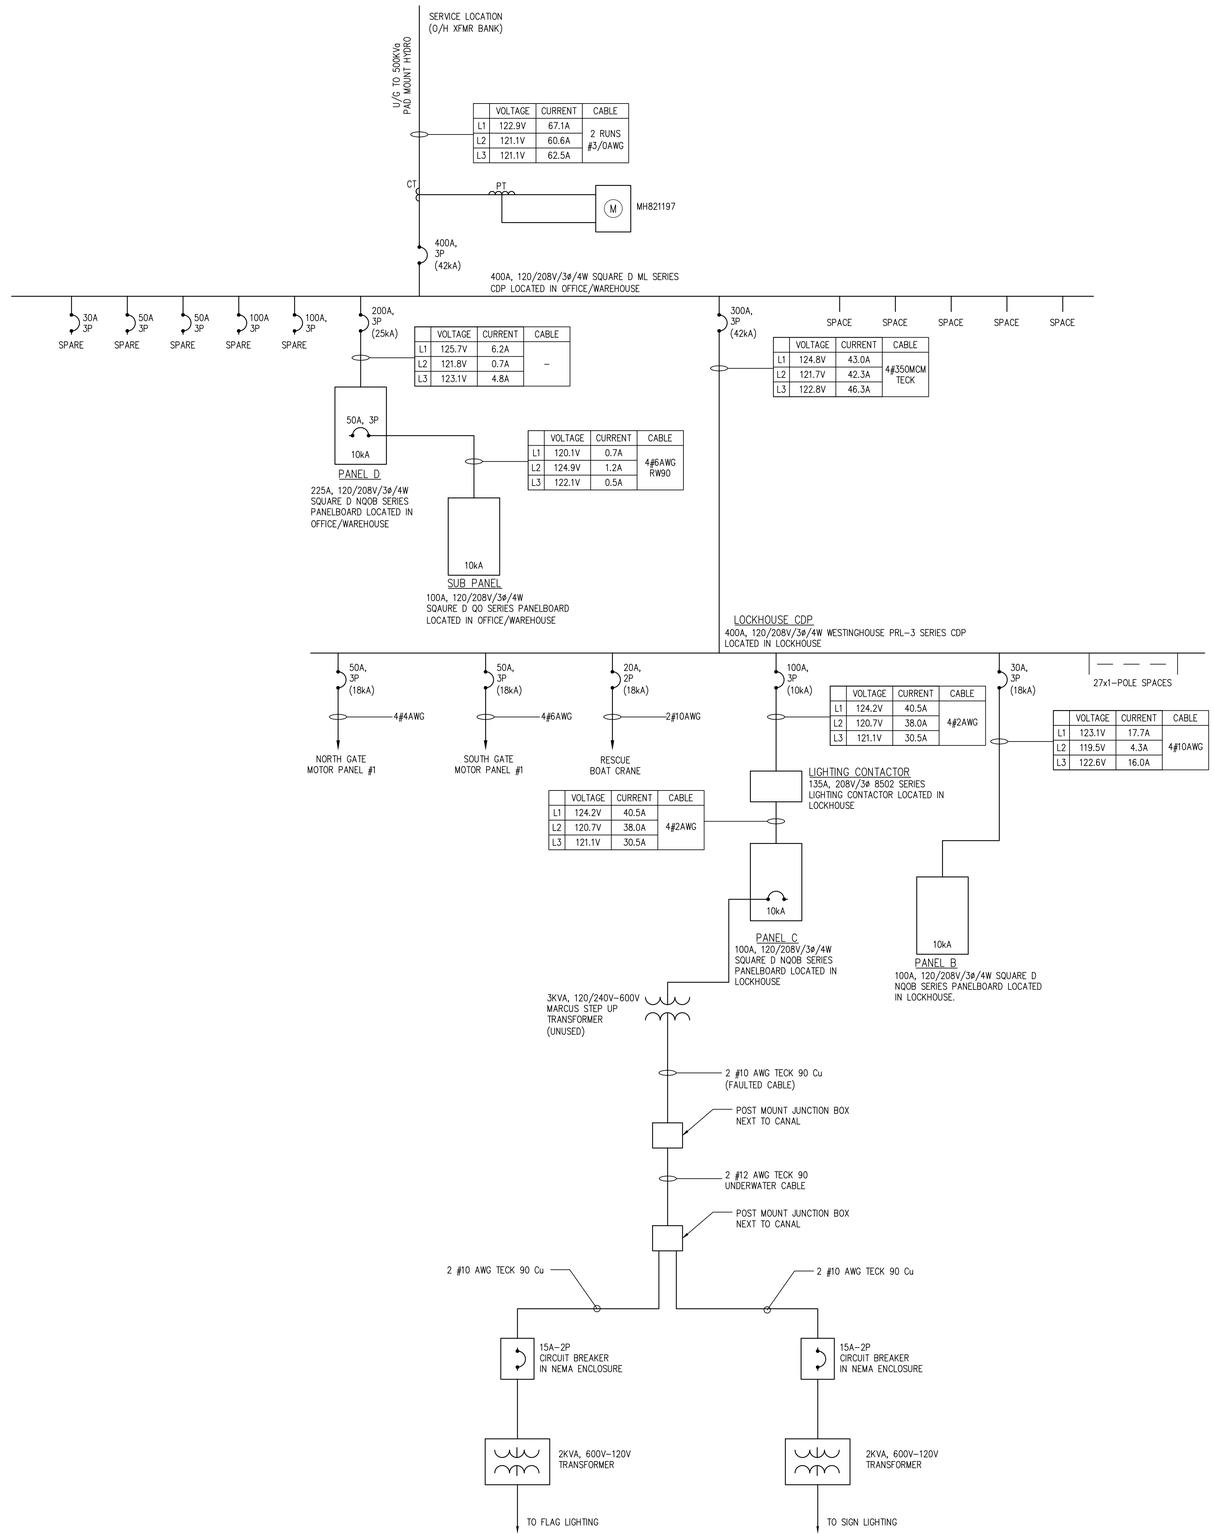RECORD DRAWING
MAY 2016

**DO NOT SCALE DRAWINGS**

| Revision/Revision | Description/Description | Date/Date |
|---|---|---|
| 0 | RECORD DRAWING | 16/05/20 |

Client/client

**ST. ANDREWS LOCK AND DAM**

**ST. ANDREWS, MANITOBA**

Project title/Titre du projet
ST. ANDREWS LOCK AND DAM
ST. ANDREWS, MANITOBA

**LIGHTING AND ELECTRICAL UPGRADES**

Approved by/Approuve par

Designed by/Concept par

Drawn by/Dessine par

PWGSC Project Manager/Administrateur de Projets TPSGC

PWGSC, Architectural and Engineering Resources Manager/Ressources Architectural et de Directeur d'ingénierie, TPSGC

Client/client

Drawing title/Titre du dessin

**WEST SIDE**
**SINGLE LINE DISTRIBUTION DIAGRAM**

| Project No./No. du projet | Sheet/Feuille | Revision no./La Révision no. |
|---|---|---|
| R.076331 | E13 OF 16 | 0 |

## PANELBOARD DIRECTORY - B - LOCKHOUSE

| C | ITEM | MEASURED LOAD | CIRCUIT BREAKER | BREAKER CONDITION | WIRE SIZE | WIRE CONDITION |
|---|---|---|---|---|---|---|
| 1 | LOCKHOUSE PLUGS | 1.8A | 15A | FUNCTIONAL | #12AWG | GOOD |
| 3 | OFFICE A/C | 0.2A | 15A | FUNCTIONAL | #12AWG | GOOD |
| 5 | LIGHTING CONTROLS | 0A (BREAKER OFF) | 15A | FUNCTIONAL | #12AWG | GOOD |
| 7 | HUMIDITY FAN | 1.0A | 15A | FUNCTIONAL | 2x#12AWG | GOOD |
| 9 | BACKROOM A/C | 0.2A | 20A 2P | FUNCTIONAL | #14AWG | GOOD |
| 11 | | 0.2A | | | #14AWG | GOOD |
| 2 | LOCKHOUSE LIGHTS | 2.8A | 15A | FUNCTIONAL | #12AWG | GOOD |
| 4 | EQUIPMENT RACK | 4.3A/0.2A | 15A | FUNCTIONAL | #12AWG | GOOD |
| 6 | UNIT HEATERS | 16.1A | 15A | FUNCTIONAL | #12AWG | GOOD |
| 8 | OFFICE BASEBOARD HEATERS | 13.7A | 20A 2P | FUNCTIONAL | #12AWG | GOOD |
| 10 | | 13.7A | | | #12AWG | GOOD |
| 12 | NOT IN USE | 0A | 15A | FUNCTIONAL | #12AWG | GOOD |
| | | | | | 100A, 120/208V/3ø/4W | |

## PANELBOARD DIRECTORY - C - LOCKHOUSE

| C | ITEM | MEASURED LOAD | CIRCUIT BREAKER | BREAKER CONDITION | WIRE SIZE | WIRE CONDITION |
|---|---|---|---|---|---|---|
| 1 | LIGHTS, NORTH SIDE 2 POLES | 10.5A | 30A 2P | FUNCTIONAL | #6AWG | GOOD |
| 3 | | 10.5A | | | #6AWG | GOOD |
| 5 | LIGHTS, NORTH SIDE 3 POLES | 13.8A | 30A 2P | FUNCTIONAL | #6AWG | GOOD |
| 7 | | 12.0A | | | #6AWG | GOOD |
| 9 | LIGHTS, SOUTH SIDE 3 POLES | 12.4A | 20A 2P | FUNCTIONAL | #6AWG | GOOD |
| 11 | | 12.4A | | | #6AWG | GOOD |
| 13 | BRIDGE LIGHTS | 4.5A | 15A 2P | FUNCTIONAL | #8AWG | GOOD |
| 15 | | 4.5A | | | #8AWG | GOOD |
| 17 | LIGHTS OVER LOCKS UNDER BRIDGE (4 LUMINAIRES) | 7.3A | 15A 2P | FUNCTIONAL | #8AWG | GOOD |
| 19 | | 7.2A | | | #8AWG | GOOD |
| 2 | LIGHTS ALONG RIVER ROAD (5 POLES) | 16.0A | 20A 2P | FUNCTIONAL | #6AWG | GOOD |
| 4 | | 16.1A | | | #6AWG | GOOD |
| 6 | SPARE | | 30A | FUNCTIONAL | | |
| 8 | RANGE LIGHTS | 1.3A | 15A | FUNCTIONAL | #12AWG | GOOD |
| 10 | SPARE | | 15A | FUNCTIONAL | | |
| 12 | SPACE | | | | | |
| 14 | SPACE | | | | | |
| 16 | SPACE | | | | | |
| 18 | SPACE | | | | | |
| 20 | SPACE | | | | | |
| | NOTES:<br>1. VOLTAGE DROP TO 'DO NOT ENTER' SIGN ON ISLAND IS SHARED WITH CIRCUITS #2,4. VOLTAGE DROP AT SIGN IS CCT#2 – 121.2V; CCT#4 – 118.7V. | | | | 100A, 120/208V/3ø/4W | |

## PANELBOARD DIRECTORY - D - MAINTENANCE SHOP

| C | ITEM | MEASURED LOAD | CIRCUIT BREAKER | BREAKER CONDITION | WIRE SIZE | WIRE CONDITION |
|---|---|---|---|---|---|---|
| 1 | WEST SHOP LIGHTS + HALLWAYS LIGHTS | 5.8A | 15A | FUNCTIONAL | #12AWG | GOOD |
| 3 | CENTRE SHOP LIGHTS | 4.5A | 15A | FUNCTIONAL | #10AWG | POOR |
| 5 | CENTRE SHOP LIGHTS | 4.0 | 15A | FUNCTIONAL | #10AWG | POOR |
| 7 | EAST SHOP LIGHTS | 4.5A | 15A | FUNCTIONAL | #10AWG | POOR |
| 9 | GARAGE DOOR | NOT IN USE | 15A | FUNCTIONAL | #10AWG/#14AWG | POOR |
| 11 | SOUTH WALL PLUG/OUTSIDE | 0A (BREAKER OFF) | 15A | FUNCTIONAL | #10AWG | POOR |
| 13 | WELDER | 0.1A | 60A 2P | FUNCTIONAL | #6AWG | POOR |
| 15 | | 0.1A | | | #6AWG | POOR |
| 17 | GRINDER | 0.1A | 15A 3P | FUNCTIONAL | #10AWG | POOR |
| 19 | | 0.1A | | | #10AWG | POOR |
| 21 | | 0.1A | | | #10AWG | POOR |
| 23 | WELL PUMP | 0.1A | 20A | FUNCTIONAL | #12AWG | GOOD |
| 25 | HOT WATER TANK | 0.1A | 15A | FUNCTIONAL | #10AWG | POOR |
| 27 | WASHROOM BASEBOARD | 0.1A | 15A 2P | FUNCTIONAL | #10AWG | GOOD |
| 29 | | 0.2A | | | #10AWG | GOOD |
| 31 | WEST CEILING HEATERS (x2) | 28.8A | 40A 3P | FUNCTIONAL | #8AWG | GOOD |
| 33 | | 30.3A | | | #8AWG | GOOD |
| 35 | | 30.6A | | | #8AWG | GOOD |
| 37 | EAST CEILING HEATERS (x2) | 29.4A | 40A 3P | FUNCTIONAL | #8AWG | GOOD |
| 39 | | 29.8A | | | #8AWG | GOOD |
| 41 | | 30.5A | | | #8AWG | GOOD |
| 2 | SUB PANEL | 0.6A | 50A 3P | FUNCTIONAL | #6AWG | GOOD |
| 4 | | 1.4A | | | #6AWG | GOOD |
| 6 | | 0.7A | | | #6AWG | GOOD |
| 8 | SOUTH/EAST OFFICE PLUG | 0.1A | 15A | FUNCTIONAL | #10AWG | POOR |
| 10 | N. OFFICE PLUGS + HALLWAY PLUGS | 0.2A | 15A | FUNCTIONAL | #10AWG | POOR |
| 12 | SOUTH LOUNGE PLUGS | 0.1A | 15A | FUNCTIONAL | #10AWG | POOR |
| 14 | WEST LOUNGE BASEBOARD | 6.6A | 15A 2P | FUNCTIONAL | #10AWG | POOR |
| 16 | | 6.8A | | | #10AWG | POOR |
| 18 | NORTH LOUNGE BASEBOARD | 6.8A | 15A 2P | FUNCTIONAL | #10AWG | POOR |
| 20 | | 7.0A | | | #10AWG | POOR |
| 22 | NORTH OFFICE BASEBOARD | 7.2A | 15A 2P | FUNCTIONAL | #10AWG | POOR |
| 24 | | 7.3A | | | #10AWG | POOR |
| 26 | EAST OFFICE BASEBOARD | 6.9A | 15A 2P | FUNCTIONAL | #10AWG | GOOD |
| 28 | | 7.0A | | | #10AWG | GOOD |
| 30 | SOUTH CEILING HEATERS (x2) | 29.3A | 40A 3P | FUNCTIONAL | #8AWG | GOOD |
| 32 | | 30.4A | | | #8AWG | GOOD |
| 34 | | 30.6A | | | #8AWG | GOOD |
| 36 | COMPRESSOR | 0.1A | 30A 2P | FUNCTIONAL | #12AWG | GOOD |
| 38 | | 0.2A | | | #12AWG | GOOD |
| 40 | PRESSURE WASHER | 0.1A | 20A 2P | FUNCTIONAL | #12AWG | GOOD |
| 42 | | 0.1A | | | #12AWG | GOOD |
| | | | | | 225A, 120/208V/3ø/4W | |

## LOCKHOUSE CDP - LOCKHOUSE

| C | ITEM | MEASURED LOAD | CIRCUIT BREAKER | BREAKER CONDITION | WIRE SIZE | WIRE CONDITION |
|---|---|---|---|---|---|---|
| 1 | NORTH GATE MOTOR PANEL | 0.1A | 50A 3P | FUNCTIONAL | #4AWG | GOOD |
| 3 | | 0.1A | | | #4AWG | GOOD |
| 5 | | 0.1A | | | #4AWG | GOOD |
| 7 | SOUTH GATE MOTOR PANEL | 0.1A | 50A 3P | FUNCTIONAL | #6AWG | GOOD |
| 9 | | 0.1A | | | #6AWG | GOOD |
| 11 | | 0.1A | | | #6AWG | GOOD |
| 13 | RESCUE BOAT CRANE | 0.1A | 20A 3P | FUNCTIONAL | #10AWG | GOOD |
| 15 | | 0.1A | | | #10AWG | GOOD |
| 17 | | | | | | |
| 19 | | | | | | |
| 2 | PANEL B | 17.5A | 30A 3P | FUNCTIONAL | #10AWG | GOOD |
| 4 | | 18.2A | | | #10AWG | GOOD |
| 6 | | 16.1A | | | #10AWG | GOOD |
| 8 | PANEL C | 41.9A | 100A 3P | FUNCTIONAL | #2AWG | GOOD |
| 10 | | 41.4A | | | #2AWG | GOOD |
| 12 | | 30.8A | | | #2AWG | GOOD |
| 14 | | | | | | |
| 16 | | | | | | |
| | | | | | 400A, 120/208V/3ø/4W | |

## SUB PANEL - MAINTENANCE SHOP

| C | ITEM | MEASURED LOAD | CIRCUIT BREAKER | BREAKER CONDITION | WIRE SIZE | WIRE CONDITION |
|---|---|---|---|---|---|---|
| 1 | OFFICE COMPUTER PLUG | 0.5A | 15A | FUNCTIONAL | #12AWG | GOOD |
| 3 | EMERGENCY LIGHTS + LOUNGE PLUGS | 0.1A | 15A | FUNCTIONAL | #12AWG | GOOD |
| 5 | AIR CONDITIONER | 0.1A | 20A 2P | FUNCTIONAL | #10AWG | GOOD |
| 7 | | 0.1A | | | #10AWG | GOOD |
| 9 | ROADWAY GATE | 0.1A | 40A 2P | FUNCTIONAL | #12AWG | GOOD |
| 11 | | 0.1A | | | #12AWG | GOOD |
| 2 | EAST OUTSIDE WALL PLUG | 0.1A | 15A | FUNCTIONAL | #12AWG | GOOD |
| 4 | LIGHTS IN OFFICE + OUTSIDE | 1.2A | 15A | FUNCTIONAL | #12AWG | GOOD |
| 6 | LOUNGE + WASHROOM LIGHTS | 0.6A | 15A | FUNCTIONAL | #12AWG | GOOD |
| 8 | | | | | | |
| 10 | | | | | | |
| 12 | | | | | | |
| | NOTES:<br>1. PANEL COVER HAS BEEN FLIPPED.<br>2. CCT#9,11 – WIRING FROM PANEL TO JUNCTION BOX IS TOO SMALL. #12's ARE INSTALL AND CODE REQUIRES #8's. JUNCTION BOX TO GATE ARE SIZED CORRECTLY. | | | | 100A, 120/208V/3ø/4W | |

Public Works and Government Services Canada / Travaux publics et Services gouvernementaux Canada

REAL PROPERTY SERVICES
Western Region
SERVICES IMMOBILIERS
Région de l'ouest

RECORD DRAWING
MAY 2016

DO NOT SCALE DRAWINGS

| Revision/Revision | Description/Description | Date/Date |
|---|---|---|
| 0 | RECORD DRAWING | 16/05/20 |

Client/client

**ST. ANDREWS LOCK AND DAM**

**ST. ANDREWS, MANITOBA**

Project title/Titre du projet

ST. ANDREWS LOCK AND DAM
ST. ANDREWS, MANITOBA

**LIGHTING AND ELECTRICAL UPGRADES**

Approved by/Approuve par

Designed by/Concept par

Drawn by/Dessine par

PWGSC Project Manager/Administrateur de Projets TPSGC

PWGSC, Architectural and Engineering Resources Manager/ Ressources Architectural et de Directeur d'ingénierie, TPSGC

Client/client

Drawing title/Titre du dessin

**WEST SIDE ELECTRICAL PANELBOARD SCHEDULES**

| Project No./No. du projet | Sheet/Feuille | Revision no./La Révision no. |
|---|---|---|
| R.076331 | E14 OF 16 | 0 |

PWGSC – B1 – 1000X707

## APPENDIX A - West Side Distribution Existing Condition

**Warehouse**

| Tag | Item | Manufacturer | Catalogue Number | Description | Location | Condition | Additional Comments |
|---|---|---|---|---|---|---|---|
| No Tag' | Main Distribution | Square D | S/N V938800-J1 | 400A, 120/208V/3P/4W c/w 400A Main Breaker | Maintenance Shop | Fair | Distribution is beginning to show signs of rust. |
| Panel D | Panelboard | Square D | | 225A, 120/208V/3P/4W | Maintenance Shop | Good | Updated, typewritten panelboard directory should be provided for clarity |
| No Tag' | Panelboard | Square D | QO312ML-1 | 100A, 120/208V/3P/4W | Maintenance Shop | Good | Missing Tag (Sub-Panel per panel D directory). |
| Lockhouse CDP | Panelboard | Eaton Cutler Hammer | PRL-3 | 400A, 120/208V/3P/4W | Lockhouse | Good | Missing lamacoid for Rescue Boat Crane breaker. (Indicated in permanent marker). |
| Panel B | Panelboard | Square D | QBL412-T2 | 100A, 120/208V/3P/4W | Lockhouse | Good | Updated, typewritten panelboard directory should be provided for clarity |
| Panel C | Panelboard | Square D | QBL420-T2 | 100A, 120/208V/3P/4W | Lockhouse | Good | Updated, typewritten panelboard directory should be provided for clarity |
| No Tag' | Transformer Step-Up | Marcus | S/N 3747-602 | 3kVA, 120/240V-600V/1P/3W | Lockhouse | Fair | Transformer is currently unused due to fault in underground line for island lighting. |
| Lighting Contactor | Contactor | Square D | Class 8502 Type FG2 | 135A, 208V/3P | Lockhouse | Fair | Enclosure is beginning to show signs of rust. |

## APPENDIX B - Partial East Side Distribution Existing Condition

**Warehouse**

| Tag | Item | Manufacturer | Catalogue Number | Description | Location | Condition | Additional Comments |
|---|---|---|---|---|---|---|---|
| Main | Switchgear | Square D | S/N 17031058-006 14076 | 1200A, 347/600V/3P/4W | Warehouse | Good | |
| T3 | Transformer Step Down | Marcus | S/N 5430-396 | 30kVA, 600V-120/208V/3P/4W | Warehouse | Good | |
| Panel A | Panelboard | Federal Pioneer | NBC342 | 225A, 120/208V/3P/4W | Warehouse | Good | |
| No Tag' | Manual Transfer Switch | JR Stephenson | S/N 24147 | 250A, 347/600V/3P/4W | Warehouse | Good | Missing Generator Connection Lugs. Missing Nameplate. |
| No Tag' | Splitter | EXM | 1100 T3203 | 225A, 600V | Deck Shed | Good | |
| Crane Plugs | Circuit Breaker | Square D | Enclosed Circuit Breaker Interrupter | 125A-3P | Deck Shed | Good | Missing Nameplate. (Current tag written in permanent marker). |
| Panel J | Circuit Breaker | Square D | Enclosed Circuit Breaker Interrupter | 50A-3P | Deck Shed | Good | Nameplate could be clarified |
| Transformer T4, 30kVA | Circuit Breaker | Square D | Enclosed Circuit Breaker Interrupter | 40A-3P | Deck Shed | Good | |
| Transformer T4, 30kVA | Transformer Step Down | Marcus | S/N 5431-396 | 30kVA, 600V-120/208V/3P/4W | Deck Shed | Good | |
| Panel H | Panelboard | Square D | NQOD Series | 225A, 120/208V/3P/4W | Deck Shed | Good | Missing panelboard directory |
| Panel J | Panelboard | Square D | YBL4162 | 225A, 347/600/3P/4W | Bridge Distribution | Fair | Panelboard is in good condition however enclosure is showing signs of rust and corrosion. |
| No Tag' | Transformer Step Down | Unknown | Unknown | 30kVA, 600V-120/208V/3P/4W | Bridge Distribution | Good | Transformer is housed in a secondary galvanized steel enclosure. No signs of corrosion or rust were observed. |
| No Tag' | Lighting Contactor | JR Stephenson | 67607 | 30A, 600V/3P | Bridge Distribution | Good | |
| Panel L | Panelboard | Square D | QBL-420 | 100A, 120/208V/3P/4W | Bridge Distribution | Poor | Missing Nameplate. (Current tag written in permanent marker). Significant rust and corrosion was observed. |
| Panel K | Panelboard | Square D | NQOD412L100CU | 100A, 120/208V/3P/4W | Bridge Distribution | Poor | Missing Nameplate. (Current tag is written in permanent marker). Missing panelboard directory. Significant rust and corrosion was observed. |
| Transformer T2 | Transformer | Marcus | 4329-396 | 15kVA | Bridge Distribution | N/A | Transformer is currently not being used. |
| No Tag' | Relay Panel | Douglas | | | Bridge Distribution | Fair | Relays are in good condition however enclosure is showing signs of rust and corrosion. |

## APPENDIX C - Bridge Roadway Lighting Existing Condition

**Roadway Pole Mounted Luminaires**

| Item | Luminaire type | Luminaire Condition | Lamp Type | Lamp Wattage | Lamp Condition | Pole Type | Pole Condition | Base Type | Base Condition | Additional Comments |
|---|---|---|---|---|---|---|---|---|---|---|
| Pole #1 | Cobra Head | Good | HPS | 250W | Non-Functional | Galvanized Steel Round Tapered 30' | Good | 4-Bolt Fastened to Structure of Bridge | Good | Pole mounted luminaire overall condition is good, showing little to no signs of rust or corrosion with the exception of the lamp, which is likely burnt out. |
| Pole #2 | Cobra Head | Good | HPS | 250W | Functional | Galvanized Steel Round Tapered 30' | Good | 4-Bolt Fastened to Structure of Bridge | Good | Pole mounted luminaire overall condition is good, showing little to no signs of rust or corrosion. |
| Pole #3 | Cobra Head | Good | HPS | 250W | Functional | Galvanized Steel Round Tapered 30' | Good | 4-Bolt Fastened to Structure of Bridge | Good | Pole mounted luminaire overall condition is good, showing little to no signs of rust or corrosion. |
| Pole #4 | Cobra Head | Good | HPS | 250W | Functional | Galvanized Steel Round Tapered 30' | Good | 4-Bolt Fastened to Structure of Bridge | Good | Pole mounted luminaire overall condition is good, showing little to no signs of rust or corrosion. |
| Pole #5 | Cobra Head | Good | HPS | 250W | Functional | Galvanized Steel Round Tapered 30' | Good | 4-Bolt Fastened to Structure of Bridge | Good | Pole mounted luminaire overall condition is good, showing little to no signs of rust or corrosion. |
| Pole #6 | Cobra Head | Good | HPS | 250W | Functional | Galvanized Steel Round Tapered 30' | Good | 4-Bolt Fastened to Structure of Bridge | Good | Pole mounted luminaire overall condition is good, showing little to no signs of rust or corrosion. |
| Pole #7 | Cobra Head | Good | HPS | 250W | Functional | Galvanized Steel Round Tapered 30' | Good | 4-Bolt Fastened to Structure of Bridge | Good | Pole mounted luminaire overall condition is good, showing little to no signs of rust or corrosion. |
| Pole #8 | Cobra Head | Good | HPS | 250W | Functional | Galvanized Steel Round Tapered 30' | Good | 4-Bolt Fastened to Structure of Bridge | Good | Pole mounted luminaire overall condition is good, showing little to no signs of rust or corrosion. |
| Pole #9 | Cobra Head | Good | HPS | 250W | Non-Functional | Galvanized Steel Round Tapered 30' | Good | 4-Bolt Fastened to Structure of Bridge | Good | Pole mounted luminaire overall condition is good, showing little to no signs of rust or corrosion with the exception of the lamp, which is likely burnt out. |
| Pole #10 | Cobra Head | Good | HPS | 250W | Functional | Galvanized Steel Round Tapered 30' | Good | 4-Bolt Fastened to Structure of Bridge | Good | Pole mounted luminaire overall condition is good, showing little to no signs of rust or corrosion. |

**Bridge Roadway Canopy Mounted Luminaires**

| Item | Luminaire Type | Luminaire Condition | Lamp Type | Lamp Wattage | Lamp Condition | Additional Comments |
|---|---|---|---|---|---|---|
| Luminaire #1 | Surface Mount Canopy | Good | HPS | 250W | Functional | Canopy luminaire overall condition is good, showing little to no signs of rust or corrosion |
| Luminaire #2 | Surface Mount Canopy | Good | HPS | 250W | Functional | Canopy luminaire overall condition is good, showing little to no signs of rust or corrosion |
| Luminaire #3 | Surface Mount Canopy | Good | HPS | 250W | Functional | Canopy luminaire overall condition is good, showing little to no signs of rust or corrosion |
| Luminaire #4 | Surface Mount Canopy | Good | HPS | 250W | Functional | Canopy luminaire overall condition is good, showing little to no signs of rust or corrosion |
| Luminaire #5 | Surface Mount Canopy | Good | HPS | 250W | Functional | Canopy luminaire overall condition is good, showing little to no signs of rust or corrosion |

**Bridge Roadway Traditional Luminaires**

| Item | Luminaire Type | Luminaire Condition | Lamp Type | Lamp Wattage | Lamp Condition | Additional Comments |
|---|---|---|---|---|---|---|
| Luminaire #1 | Traditional Pole Mounted | Good | HPS | 250W | Functional | Canopy luminaire overall condition is good, showing little to no signs of rust or corrosion |
| Luminaire #2 | Traditional Pole Mounted | Good | HPS | 250W | Functional | Canopy luminaire overall condition is good, showing little to no signs of rust or corrosion |

## APPENDIX D - Canal Lighting Existing Condition

**Poles Along Canal**

| Item | Luminaire type | Luminaire Condition | Lamp Type | Lamp Wattage | Lamp Condition | Pole Type | Pole Condition | Base Type | Base Condition | Additional Comments |
|---|---|---|---|---|---|---|---|---|---|---|
| Pole #1 | 2x Cobra Heads | Good | HPS | CH - 250W | Functional | 30' Painted Steel Round Tapered | Fair | 4-Bolt fastened to concrete pile | Good | Pole mounted luminaire overall condition is fair, the poles are showing signs of rust and corrosion and the paint is peeling |
| Pole #2 | 2x Cobra Heads + Flood Light | Good | HPS | CH - 250W/F - 150W | Functional | 30' Painted Steel Round Tapered | Fair | 4-Bolt fastened to concrete pile | Good | Pole mounted luminaire overall condition is fair, the poles are showing signs of rust and corrosion and the paint is peeling |
| Pole #3 | 2x Cobra Heads + Flood Light | Good | HPS | CH - 250W/F - 150W | Functional | 30' Painted Steel Round Tapered | Fair | 4-Bolt fastened to concrete pile | Good | Pole mounted luminaire overall condition is fair, the poles are showing signs of rust and corrosion and the paint is peeling |
| Pole #4 | 2x Cobra Heads + Flood Light | Good | HPS | CH - 250W/F - 150W | Functional | 30' Painted Steel Round Tapered | Fair | 4-Bolt fastened to concrete pile | Good | Pole mounted luminaire overall condition is fair, the poles are showing signs of rust and corrosion and the paint is peeling |
| Pole #5 | 2x Cobra Heads | Good | HPS | CH - 250W | Functional | 30' Painted Steel Round Tapered | Fair | 4-Bolt fastened to concrete pile | Good | Pole mounted luminaire overall condition is fair, the poles are showing signs of rust and corrosion and the paint is peeling |
| Pole #6 | 2x Cobra Heads + Flood Light | Good | HPS | CH - 250W/F - 150W | Functional | 30' Painted Steel Round Tapered | Fair | 4-Bolt fastened to concrete pile | Good | Pole mounted luminaire overall condition is fair, the poles are showing signs of rust and corrosion and the paint is peeling |
| Pole #7 | 2x Cobra Heads + Flood Light | Good | HPS | CH - 250W/F - 150W | Functional | 30' Painted Steel Round Tapered | Fair | 4-Bolt fastened to concrete pile | Good | Pole mounted luminaire overall condition is fair, the poles are showing signs of rust and corrosion and the paint is peeling |
| Pole #8 | Flood Light | Good | HPS | F - 150W | Functional | 30' Painted Steel Round Tapered | Fair | 4-Bolt fastened to concrete pile | Good | Pole mounted luminaire overall condition is fair, the poles are showing signs of rust and corrosion and the paint is peeling |
| Pole #9 | Flood Light | Good | HPS | F - 150W | Functional | 30' Painted Steel Round Tapered | Fair | 4-Bolt fastened to concrete pile | Good | Pole mounted luminaire overall condition is fair, the poles are showing signs of rust and corrosion and the paint is peeling |
| Pole #10 | Flood Lights | Good | HPS | F - 150W | Functional | 30' Painted Steel Round Tapered | Fair | 4-Bolt fastened to concrete pile | Good | Pole mounted luminaire overall condition is fair, the poles are showing signs of rust and corrosion and the paint is peeling |
| Pole #11 | 2x Flood Light | Good | HPS | F - 150W | Functional | 30' Painted Steel Round Tapered | Fair | 4-Bolt fastened to concrete pile | Good | Pole mounted luminaire overall condition is fair, the poles are showing signs of rust and corrosion and the paint is peeling |
| Pole #12 | Flood Light | Good | HPS | F-150W | Functional | 30' Painted Steel Round Tapered | Fair | 4-Bolt fastened to concrete pile | Good | Pole mounted luminaire overall condition is fair, the poles are showing signs of rust and corrosion and the paint is peeling |
| Pole #13 | 2x Cobra Heads + 3x Flood Lights | Good | HPS | CH - 250W/F - 150W | Functional | 30' Painted Steel Round Tapered | Fair | 4-Bolt fastened to concrete pile | Good | Pole mounted luminaire overall condition is fair, the poles are showing signs of rust and corrosion and the paint is peeling |
| Pole #14 | 2x Cobra Heads + Flood Light | Good | HPS | CH - 250W/F-150W | Functional | 30' Painted Steel Round Tapered | Fair | 4-Bolt fastened to concrete pile | Good | Pole mounted luminaire overall condition is fair, the poles are showing signs of rust and corrosion and the paint is peeling |

**Lock Lighting**

| Item | Luminaire Type | Luminaire Condition | Lamp Type | Lamp Wattage | Lamp Condition | Additional Comments |
|---|---|---|---|---|---|---|
| Luminaire #1 | Surface Mount Canopy | Good | HPS | 400W | Functional | Canopy luminaire overall condition is good, showing little to no signs of rust or corrosion |
| Luminaire #2 | Surface Mount Canopy | Good | HPS | 400W | Functional | Canopy luminaire overall condition is good, showing little to no signs of rust or corrosion |
| Luminaire #3 | Surface Mount Canopy | Good | HPS | 400W | Functional | Canopy luminaire overall condition is good, showing little to no signs of rust or corrosion |
| Luminaire #4 | Surface Mount Canopy | Good | HPS | 400W | Functional | Canopy luminaire overall condition is good, showing little to no signs of rust or corrosion |

## APPENDIX E - Lock Entrance Sign and Flag Lighting Existing Condition

**Lock Entrance Sign**

| Item | Luminaire Type | Luminaire Condition | Lamp Type | Lamp Wattage | Lamp Condition | Additional Comments |
|---|---|---|---|---|---|---|
| Luminaire #1 | Marine type | Good | LED | Unknown | Functional | |
| Luminaire #2 | Marine type | Good | LED | Unknown | Functional | |
| Luminaire #3 | Marine type | Good | LED | Unknown | Functional | |

**Flag Lighting**

| Item | Luminaire Type | Luminaire Condition | Lamp Type | Lamp Wattage | Lamp Condition | Additional Comments |
|---|---|---|---|---|---|---|
| Luminaire #1 | Pole Mounted Flood Light | Good | HPS | 250W | Unknown | Luminaire is currently non-functional due to fault in underground line. |
| Luminaire #2 | Pole Mounted Flood Light | Good | HPS | 250W | Unknown | Luminaire is currently non-functional due to fault in underground line. |


Public Works and Government Services Canada / Travaux publics et Services gouvernementaux Canada

REAL PROPERTY SERVICES
Western Region
SERVICES IMMOBILIERS
Région de l'ouest

RECORD DRAWING
MAY 2016

DO NOT SCALE DRAWINGS

| Revision/ Revision | Description/Description | Date/Date |
|---|---|---|
| 0 | RECORD DRAWING | 16/05/20 |

Client/client

ST. ANDREWS LOCK AND DAM

ST. ANDREWS, MANITOBA

Project title/Titre du projet
ST. ANDREWS LOCK AND DAM
ST. ANDREWS, MANITOBA

LIGHTING AND ELECTRICAL UPGRADES

Approved by/Approuve par

Designed by/Concept par

Drawn by/Dessine par

PWGSC Project Manager/Administrateur de Projets TPSGC

PWGSC, Architectural and Engineering Resources Manager/ Ressources Architectural et de Directeur d'ingénierie, TPSGC

Client/client

Drawing title/Titre du dessin

EXISTING CONDITION SPREADSHEET -1/2

| Project No./No. du projet | Sheet/Feuille | Revision no./ La Révision no. |
|---|---|---|
| R.076331 | E15 OF 16 | 0 |

PWGSC – B1 – 1000X707

## APPENDIX F - Bridge Under Deck Lighting Existing Condition

| Item | Luminaire Type | Luminaire Condition | Lamp Type | Lamp Wattage | Lamp Condition | Additional Comments |
|---|---|---|---|---|---|---|
| Luminaire #1 | Surface Mount Canopy | Good | HPS | 150W | Functional | |
| Luminaire #2 | Surface Mount Canopy | Good | HPS | 150W | Functional | |
| Luminaire #3 | Surface Mount Canopy | Good | HPS | 150W | Functional | |
| Luminaire #4 | Surface Mount Canopy | Good | HPS | 150W | Functional | |
| Luminaire #5 | Surface Mount Canopy | Good | HPS | 150W | Functional | |
| Luminaire #6 | Surface Mount Canopy | Good | HPS | 150W | Functional | |
| Luminaire #7 | Surface Mount Canopy | Good | HPS | 150W | Functional | |
| Luminaire #8 | Surface Mount Canopy | Good | HPS | 150W | Functional | |
| Luminaire #9 | Surface Mount Canopy | Good | HPS | 150W | Functional | |

## APPENDIX G - East Side Warehouse Lighting Existing Condition

| Item | Luminaire Type | Luminaire Condition | Lamp Type | Lamp Wattage | Lamp Condition | Additional Comments |
|---|---|---|---|---|---|---|
| Luminaire #1 | Ceiling Mounted Low Bay | Good | HPS | 150W | Functional | Luminaires were being retrofitted with new 19W LED screw base lamps at time of site visit on January 13th, 2016. |
| Luminaire #2 | Ceiling Mounted Low Bay | Good | HPS | 150W | Functional | |
| Luminaire #3 | Ceiling Mounted Low Bay | Good | HPS | 150W | Functional | |
| Luminaire #4 | Ceiling Mounted Low Bay | Good | HPS | 150W | Functional | |
| Luminaire #5 | Ceiling Mounted Low Bay | Good | HPS | 150W | Functional | |
| Luminaire #6 | Ceiling Mounted Low Bay | Good | HPS | 150W | Functional | |
| Luminaire #7 | Ceiling Mounted Low Bay | Good | HPS | 150W | Functional | |
| Luminaire #8 | Ceiling Mounted Low Bay | Good | HPS | 150W | Functional | |
| Luminaire #9 | Ceiling Mounted Low Bay | Good | HPS | 150W | Functional | |
| Luminaire #10 | Ceiling Mounted Low Bay | Good | HPS | 150W | Functional | |
| Luminaire #11 | Ceiling Mounted Low Bay | Good | HPS | 150W | Functional | |
| Luminaire #12 | Ceiling Mounted Low Bay | Good | HPS | 150W | Functional | |
| Luminaire #13 | Ceiling Mounted Low Bay | Good | HPS | 150W | Functional | |
| Luminaire #14 | Ceiling Mounted Low Bay | Good | HPS | 150W | Functional | |
| Luminaire #15 | Ceiling Mounted Low Bay | Good | HPS | 150W | Functional | |
| Luminaire #16 | Ceiling Mounted Low Bay | Good | HPS | 150W | Functional | |
| Luminaire #17 | Ceiling Mounted Low Bay | Good | HPS | 150W | Functional | |


Public Works and Government Services Canada
Travaux publics et Services gouvernementaux Canada

REAL PROPERTY SERVICES
Western Region
SERVICES IMMOBILIERS
Région de l'ouest


RECORD DRAWING
MAY 2016

DO NOT SCALE DRAWINGS

| Revision/Revision | Description/Description | Date/Date |
|---|---|---|
| 0 | RECORD DRAWING | 16/05/20 |

Client/client

ST. ANDREWS
LOCK AND DAM

ST. ANDREWS, MANITOBA

Project title/Titre du projet
ST. ANDREWS LOCK AND DAM
ST. ANDREWS, MANITOBA

LIGHTING AND
ELECTRICAL UPGRADES

Approved by/Approuve par

Designed by/Concept par

Drawn by/Dessine par

PWGSC Project Manager/Administrateur de Projets TPSGC

PWGSC, Architectural and Engineering Resources Manager/
Ressources Architectural et de Directeur d'ingénierie, TPSGC

Client/client

Drawing title/Titre du dessin

EXISTING CONDITION
SPREADSHEET 2/2

| Project No./No. du projet | Sheet/Feuille | Revision no./La Révision no. |
|---|---|---|
| R.076331 | E16 OF 16 | 0 |

PWGSC – B1 – 1000X707

0 10 20 30 40 50 60 70 80 90 100mm