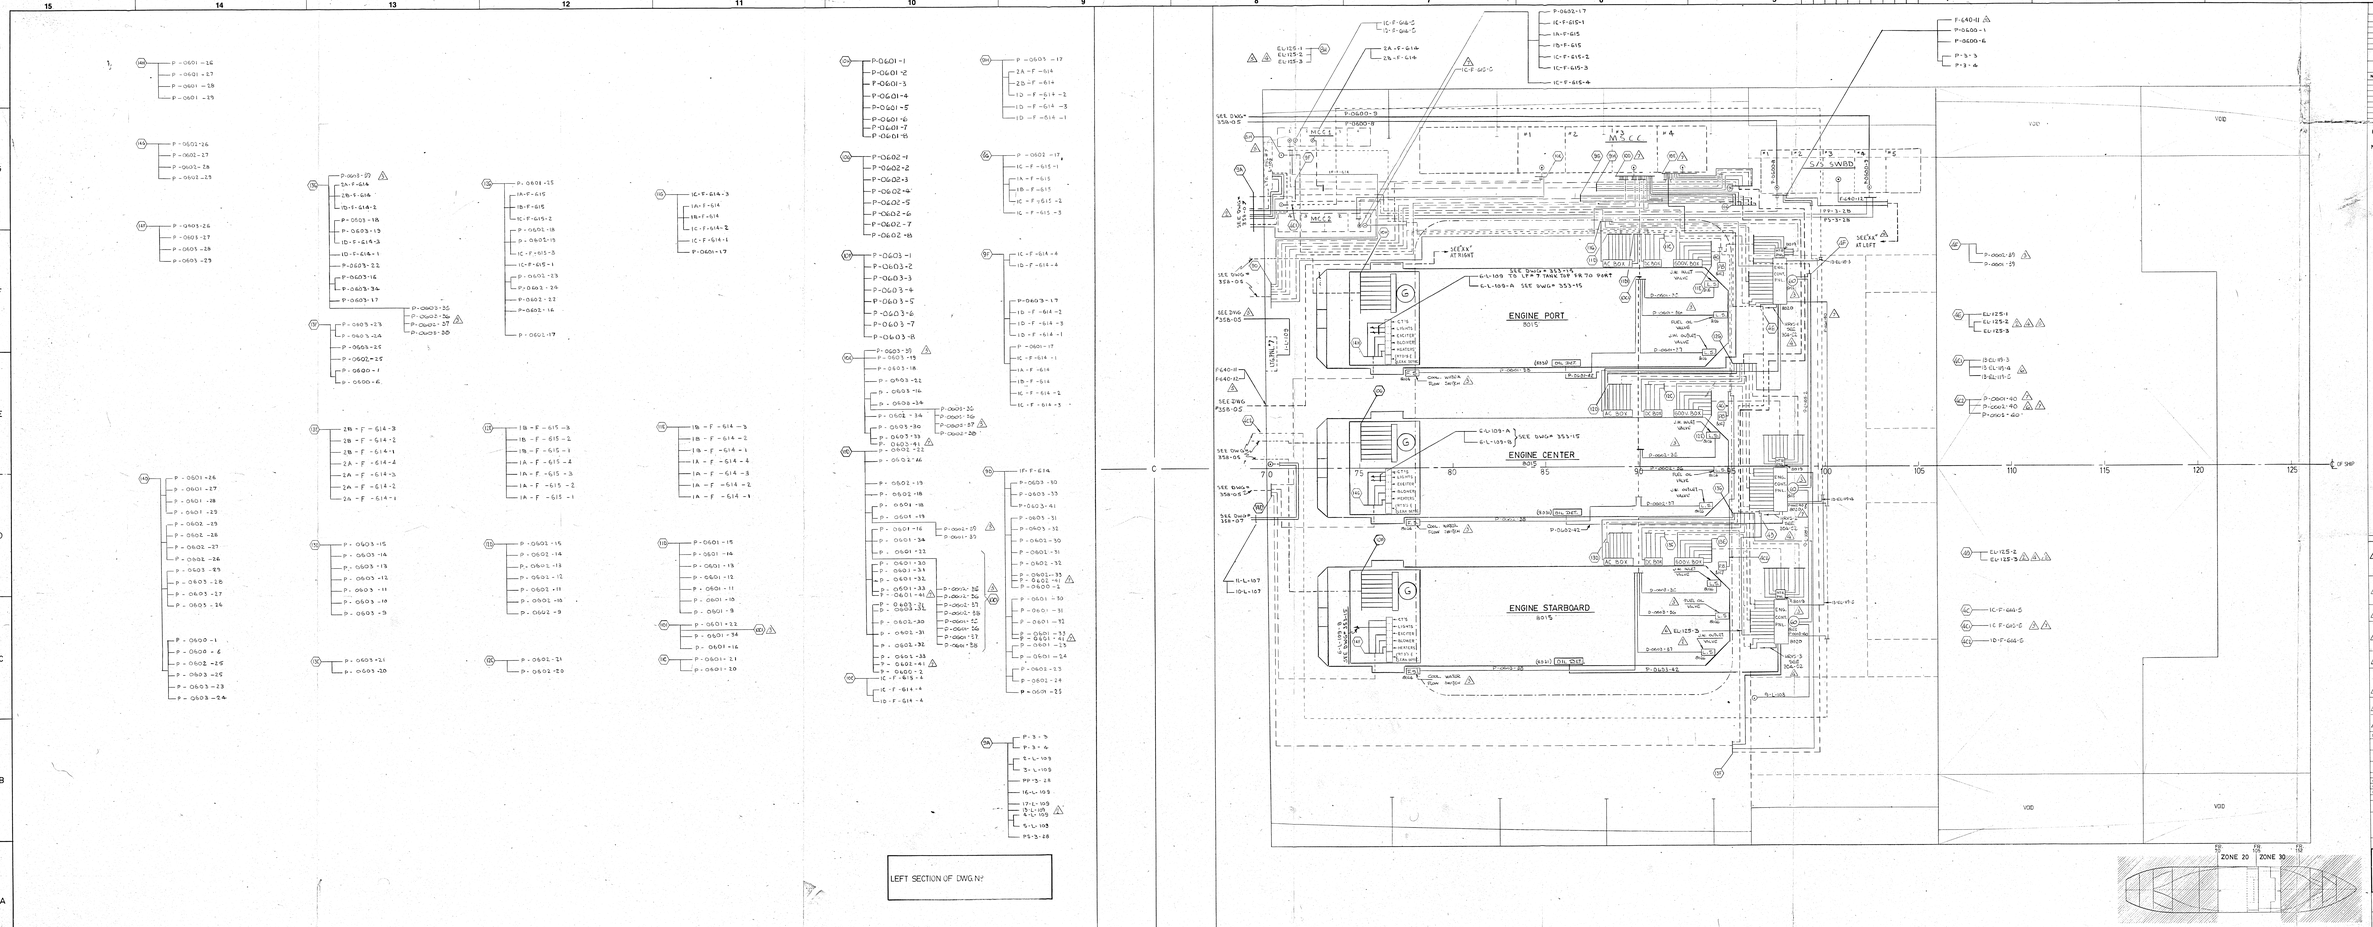

IMPUTATION DES COUTS/COST CHARGES

QR	JT	DESCRIPTION

REFERENCES

NO	TITRE/TITLE	DESSIN/DWG	F/SH

POUR MATERIEL VOIR/FOR MATERIAL REFER TO:

NOTES:

NO	ZN	ZONE	DESCRIPTION	PAR/BY	DATE
A			AS BUILT (UP TO 442)		
			ADDED SYSTEMS AT ELEV. 7.5	J.M.	86-8-18
			EL. 10.5 " " EL. 27.5		
			J.M. P-0601-17 & P-0602-16		
			J.M. P-0601-41 & P-0602-40		
			(P-0603-41 & P-0603-42)		
			J.M. REV. NO. 1 TO 442 ADDED		
			REMOVED SYSTEMS AND ADDED		
			P-0601-40 & P-0602-40		
			(3) NO. 1 & 2 F.O. ENGINES (C/I) (F/F)		

REVISIONS

APPROBATIONS/APPROVALS

	SOUMIS/SUB.	APP.	REV.	REV.	REV.	REV.	REV.
CLIENT							
SOCOTA							
PROP/OWN.	JEGSTF/MJ.S.						

MARINE INDUSTRIE LIMITEE
SOREL, P.Q. CANADA

TYPE 1100 NAVAIDS TENDER/LIGHT ICEBREAKER

PROPULSION SYSTEM
TANK TOP
BETWEEN FR. 70 & 126

DESIGN		CONT. NO	DESSIN DWG		
DRAWN		450	358-08	A	
CHECKED		451		1	
APPR.		SCALE 1:50		1	