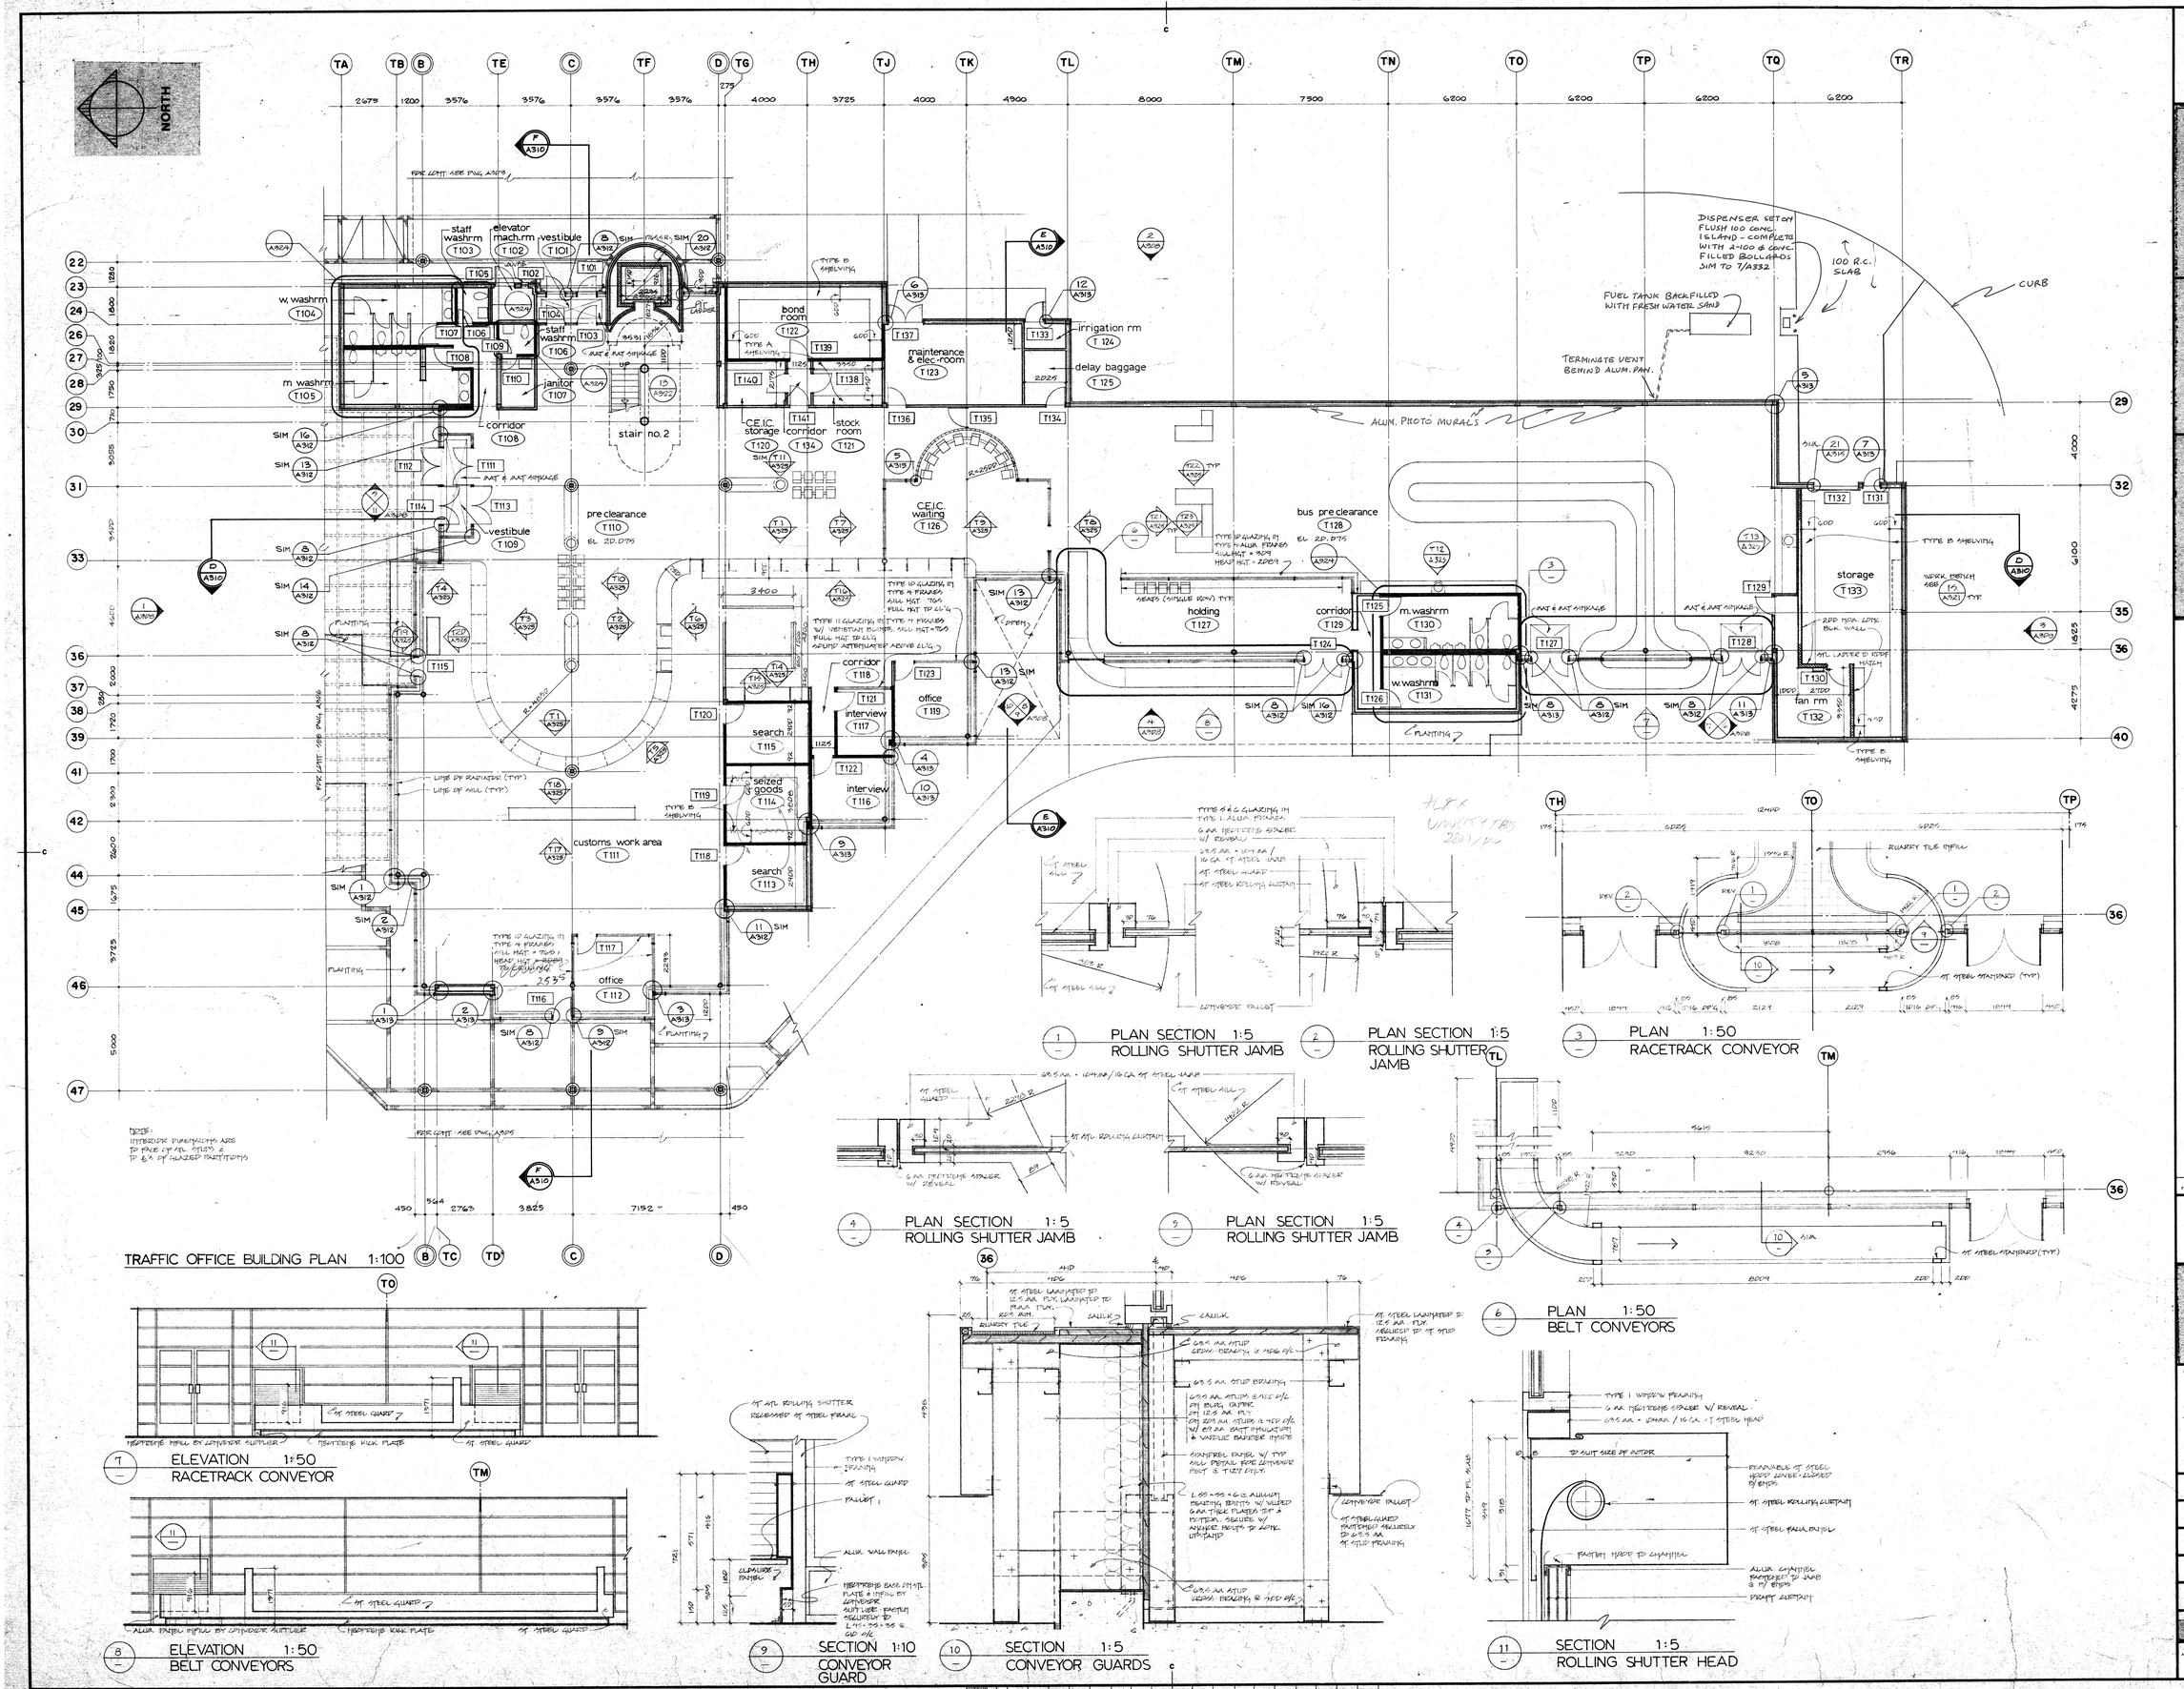

Public Works Canada / Travaux publics Canada

PACIFIC REGION

Architects

Toby Russell Buckwell & Partners, Architects

Consultants

- Transportation and Site: Underwood McLellan Ltd.
- Structural and Mechanical: McKenzie Snowball Skalbania & Associates Ltd.
- Electrical: AME Engineering Ltd.
- Landscape: Justice Webb and Vincent Ltd.

Key Plan

REGISTERED ARCHITECTS TOBY RUSSELL BUCKWELL & PARTNERS BRITISH COLUMBIA

AS BUILT

This drawing has been revised to show this building "As Built" and must be signed by the Contractor.

Date | Signature

revisions | date

A detail no. / no. du détail
B location drawing no. / sur dessin no.
C drawing no. / dessin no.

project | projet

PACIFIC HIGHWAY BORDER CROSSING

Phase: 3

drawing | dessin

TRAFFIC OFFICE BLDG.
FLOOR PLAN
PLAN DETAILS

designed tsa. | conçu
date
drawn MT | dessiné
date
reviewed PDM | examiné
date June 26/84
approved | approuvé
date
Tender K.R. Gelhede, PWC Project Manager | Soumission, Administrateur de projets TPC
project number 087501 | no. du projet
drawing no. A 304 | no. du dessin

PWC AO