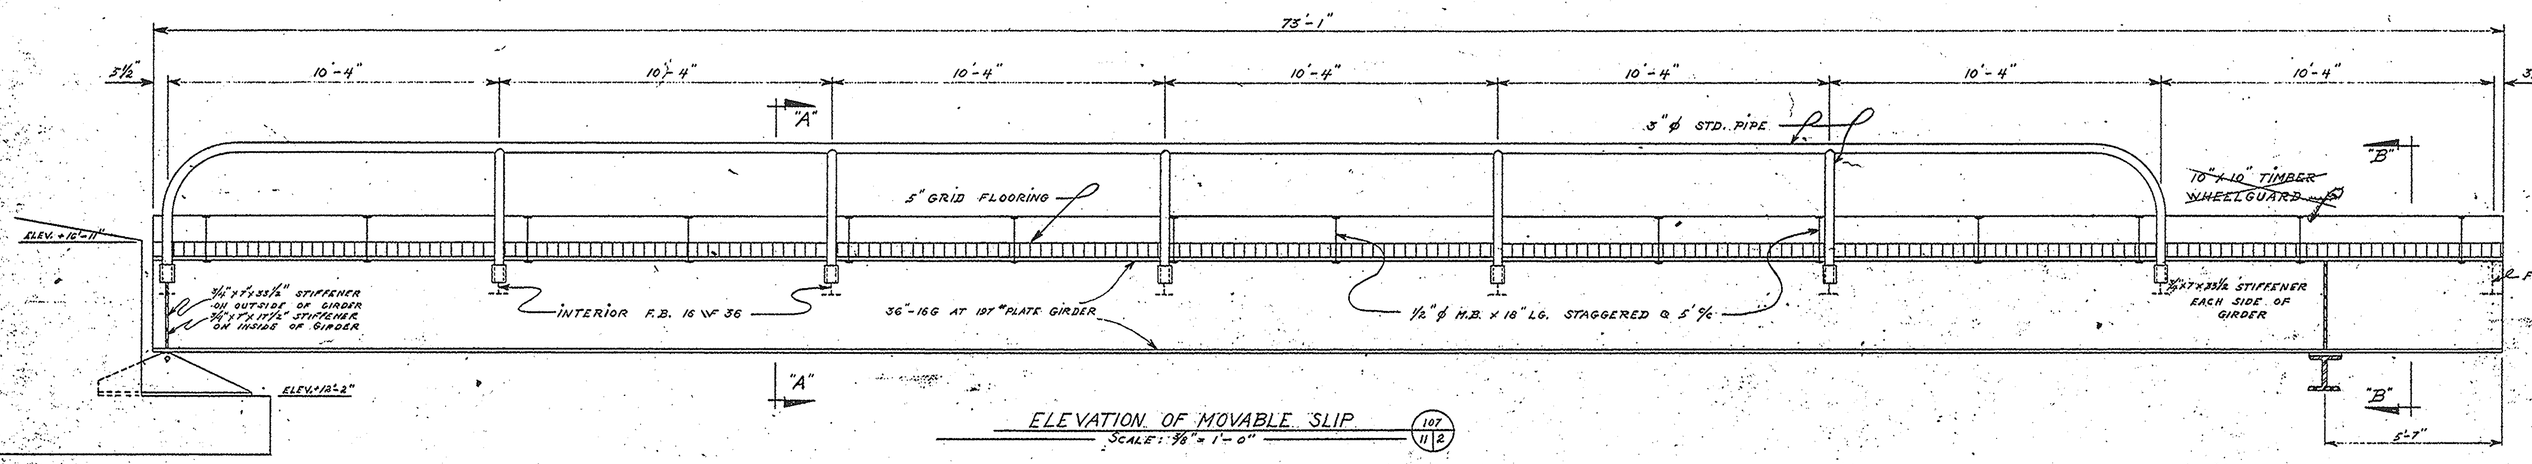

ELEVATION OF MOVABLE SLIP (107 / 11 | 2)
SCALE: ⅜" = 1'-0"

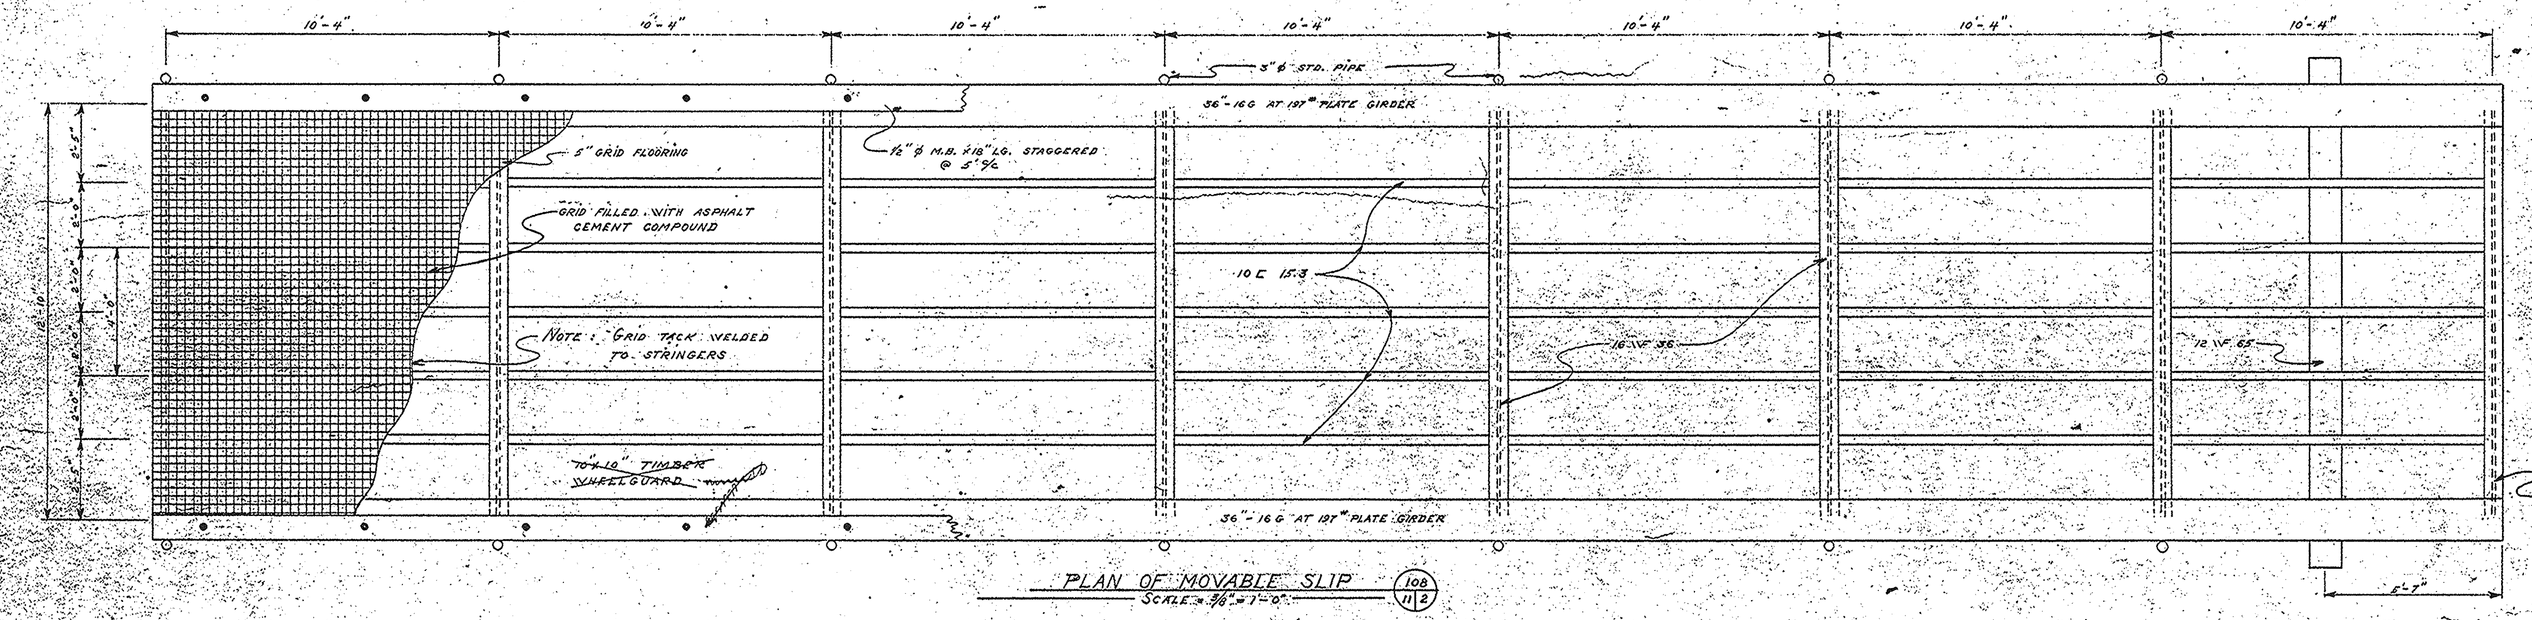

PLAN OF MOVABLE SLIP (108 / 11 | 2)
SCALE: ⅜" = 1'-0"

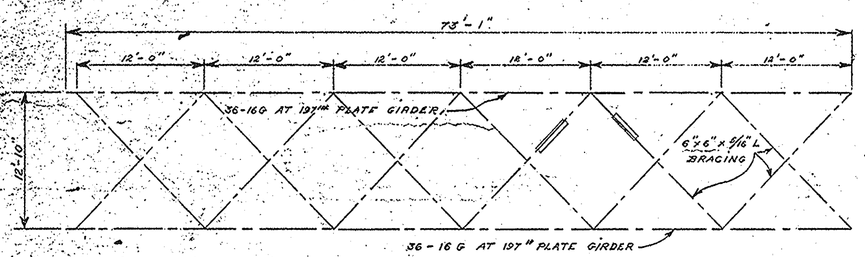

NOTE: BRACES WELDED TO UPPER SIDE OF LOWER FLANGE OF 36" MEMBER

WIND BRACING (109 / 11 | 11)
SCALE: 1/8" = 1'-0"

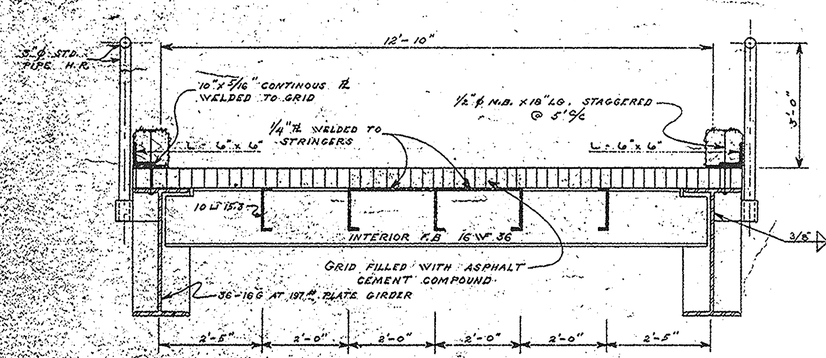

DETAIL OF HAND RAIL CONNECTION (112 / 11 | 11)
SCALE: 3" = 1'-0"

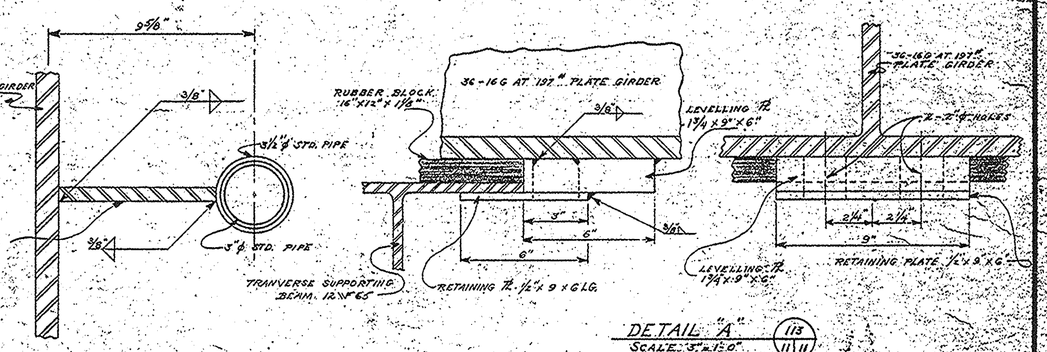

DETAIL "A" (113 / 11 | 11)
SCALE: 3" = 1'-0"

SECTION "A-A" (110 / 11 | 11)
SCALE: ½" = 1'-0"

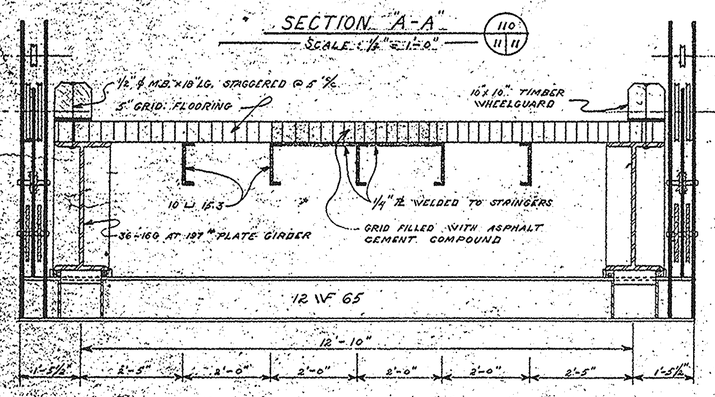

SECTION "B-B" (111 / 11 | 11)
SCALE: ½" = 1'-0"

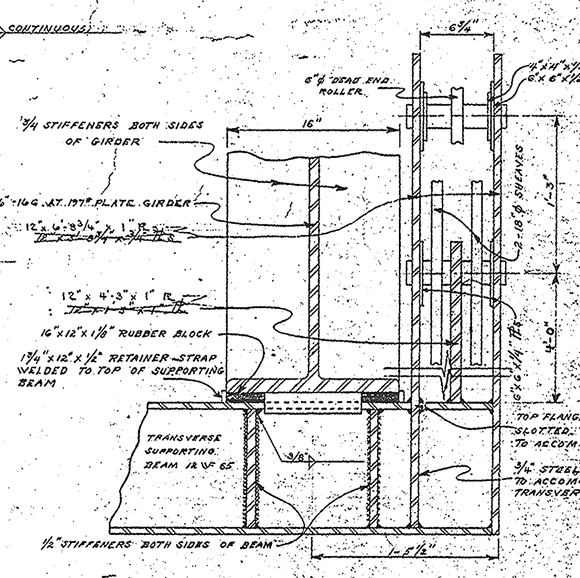

DETAIL OF SUPPORTING BEAM (114 / 11 | 11)
SCALE: 1½" = 1'-0"
SEE DETAIL Nº 1, DWG. 1/1

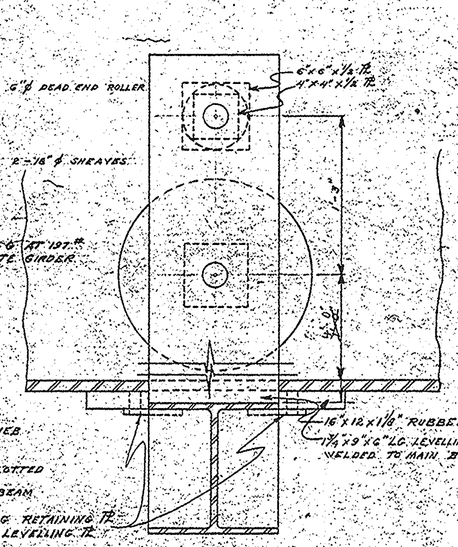

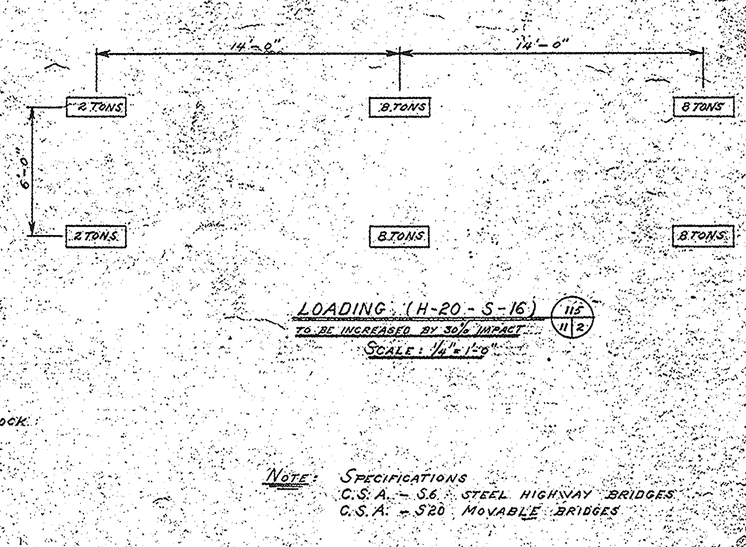

LOADING (H-20-S-16) (115 / 11 | 2)
TO BE INCREASED BY 30% IMPACT
SCALE: 1/4" = 1'-0"

NOTE: SPECIFICATIONS
C.S.A. - S.6 STEEL HIGHWAY BRIDGES
C.S.A. - S.20 MOVABLE BRIDGES

DPW 700A

Department of Public Works | Ministère des Travaux publics

HENARD, MARSAN & THIBEAULT
CONSULTING ENGINEERS
36 OUEST, ST-GERMAIN, ROUYN, QUE.

A. detail no. / détail nº
B. location / emplacement
C. dwg. no. / feuille nº

date: 2 SEPT 1965 — revisions: REVISED DESIGN

AS BUILT

Job title: / Titre du projet:
MATANE, MATAPEDIA, PATAPEDIA, QUE.
HARBOUR IMPROVEMENTS
PHASE "C" WHARVES

Drawing title: / Titre du dessin:
MOVABLE SLIP

designed by / conçu par: ... date: JAN. 30 1965
drawn by / dessiné par: C.P. date: JAN 30 1965
reviewed by / examiné par: ... date: 2/3/65
approved by / approuvé par: ... date: 2/3/65
job number / nº du projet: C.A. M-17-10
dwg. no. / feuille nº: 11 OF 12

D-0072