REINFORCING STEEL BARS SCHEDULE (49/52)

PANELS

NUMBERS	QUANTITY	X	Y	Z	Z-Y	QUANTITY	SIZE	LENGTH	OF BARS	TYPE	BENDING	WEIGHT
A	3/2	15'-0"	15'-0"									
	2											
B	3/2	15'-0"	15'-0"									
	1											
C	3/2	15'-0"	15'-0"									
	2											
D	1	17'-4"	15'-0"									
X	3	15'-0"	15'-0"	2'-5"	1'-10"							
X	1	15'-0"	15'-0"	2'-5"	1'-10"							
X	4	15'-0"	15'-0"	2'-5"	1'-10"							
X	2	15'-0"	15'-0"	2'-5"	1'-10"							
I	2	15'-0"	15'-0"	2'-5"	1'-10"							
	CANCELLED											
J	1	15'-0"	15'-0"									
JX	1	0'-0" to 5'-5½"	0'-0" to 15'-0"	2'-5"	1'-10"							
K	2	10'-6"	15'-0"									
L	1	5'-5½" to 10'-11"	15'-0"	2'-5"								
M	1	10'-11" to 16'-4½"	15'-0"	2'-5"	1'-10"							
N	1	17'-4"	15'-0"	1'-2"	1'-10"							
O	3	17'-4"	15'-0"									
P	1	17'-4"	15'-0"	1'-10"	1'-10"							
Q	2	17'-4"	15'-0"	1'-2"								
R	15	17'-4"	15'-0"									
S	8	17'-4"	15'-0"	1'-10"								
T	4	13'-8"	15'-0"	1'-2"								
U	2	8'-0"	15'-0"	1'-2"	1'-10"							
V	1	9'-4"	15'-0"									
VX	1	5'-5"	15'-0"	1'-2"	1'-10"							
TR	1	13'-8"	15'-0"	1'-2"								
QX	1	17'-4"	15'-0"	1'-2"								
	CANCELLED											
W	1	17'-4"	15'-0"	1'-10"	1'-10"							
X	2	18'-2"	15'-0"	1'-10"	2'-5"							
Y	36	18'-2"	15'-0"	1'-10"								
Z	2	18'-2"	15'-0"	1'-10"	1'-10"							

NOTE:
ADDITIONAL 25% OF REINFORCING STEEL IN FRONT PANELS (MARGINAL WHARF)

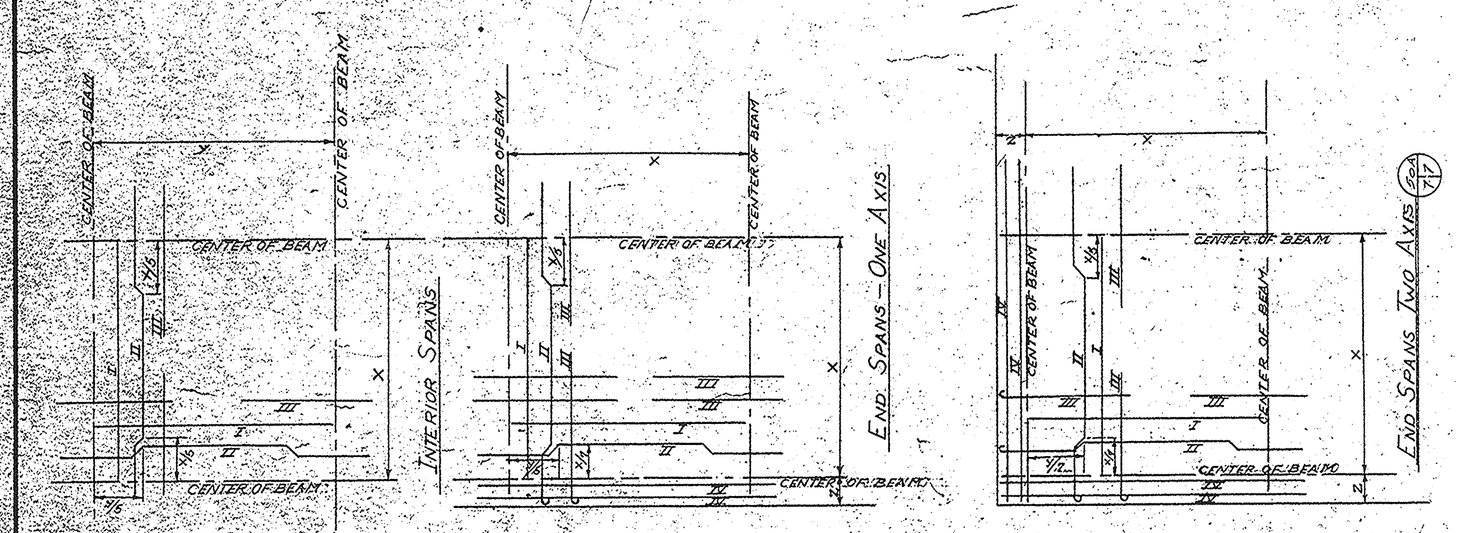

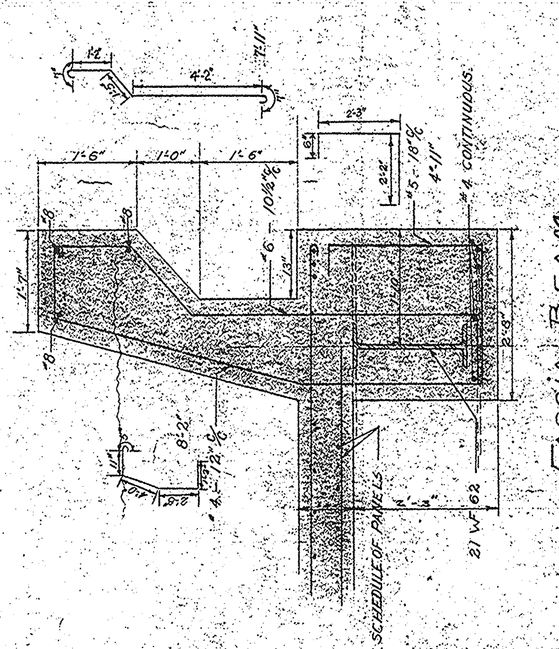

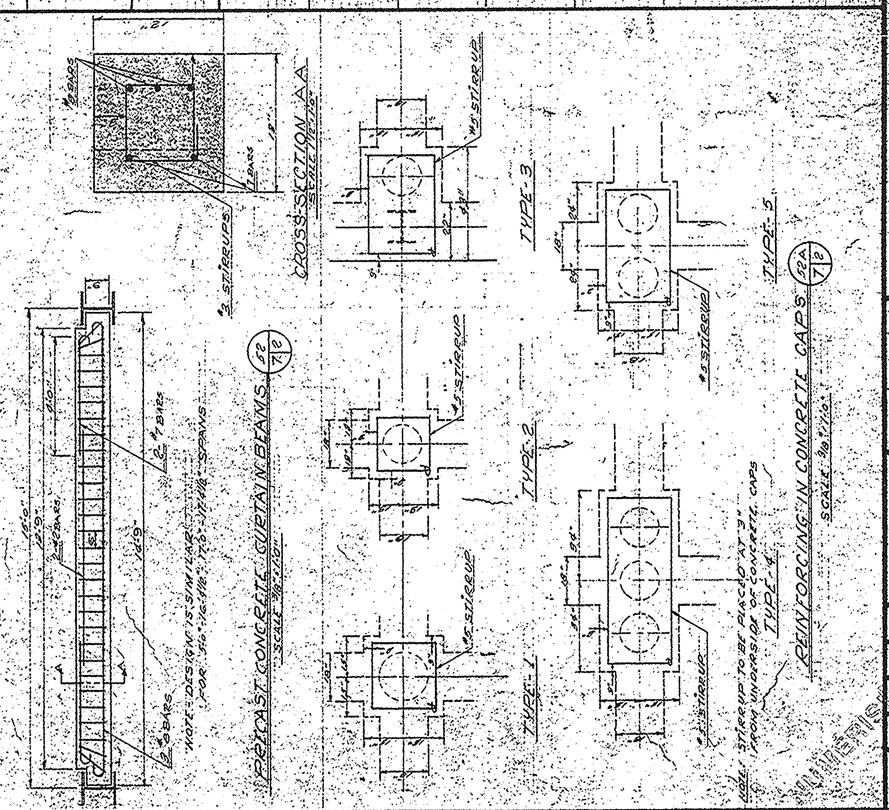

Department of Public Works | Ministère des Travaux publics

MENARD, MARSAN & THIBEAULT
CONSULTING ENGINEERS
88 OUEST, ST-GERMAIN, RIMOUSKI, QUE.

A. detail no. / B. location dwg. no. / C. dwg. no. — détail no. / sur feuille no. / feuille no.

date: 5 SEPT. 1968 — revisions: GENERAL

AS BUILT

Job title: — Titre du projet:
MATANE, MATANEDIA-MATANE, QUE.
HARBOUR IMPROVEMENTS
PHASE "C" WHARVES
AND WHARVES

Drawing title: — Titre du dessin:
REINFORCING STEEL SCHEDULE AND DETAILS

designed by: / conçu par: L. McL. — date
drawn by: / dessiné par: — date
reviewed by: / examiné par: — date
approved by: / approuvé par: — date

job number: / no du projet: C.A. M-17-10 — dwg. no. / feuille no. 7 of 15

DPW 700A