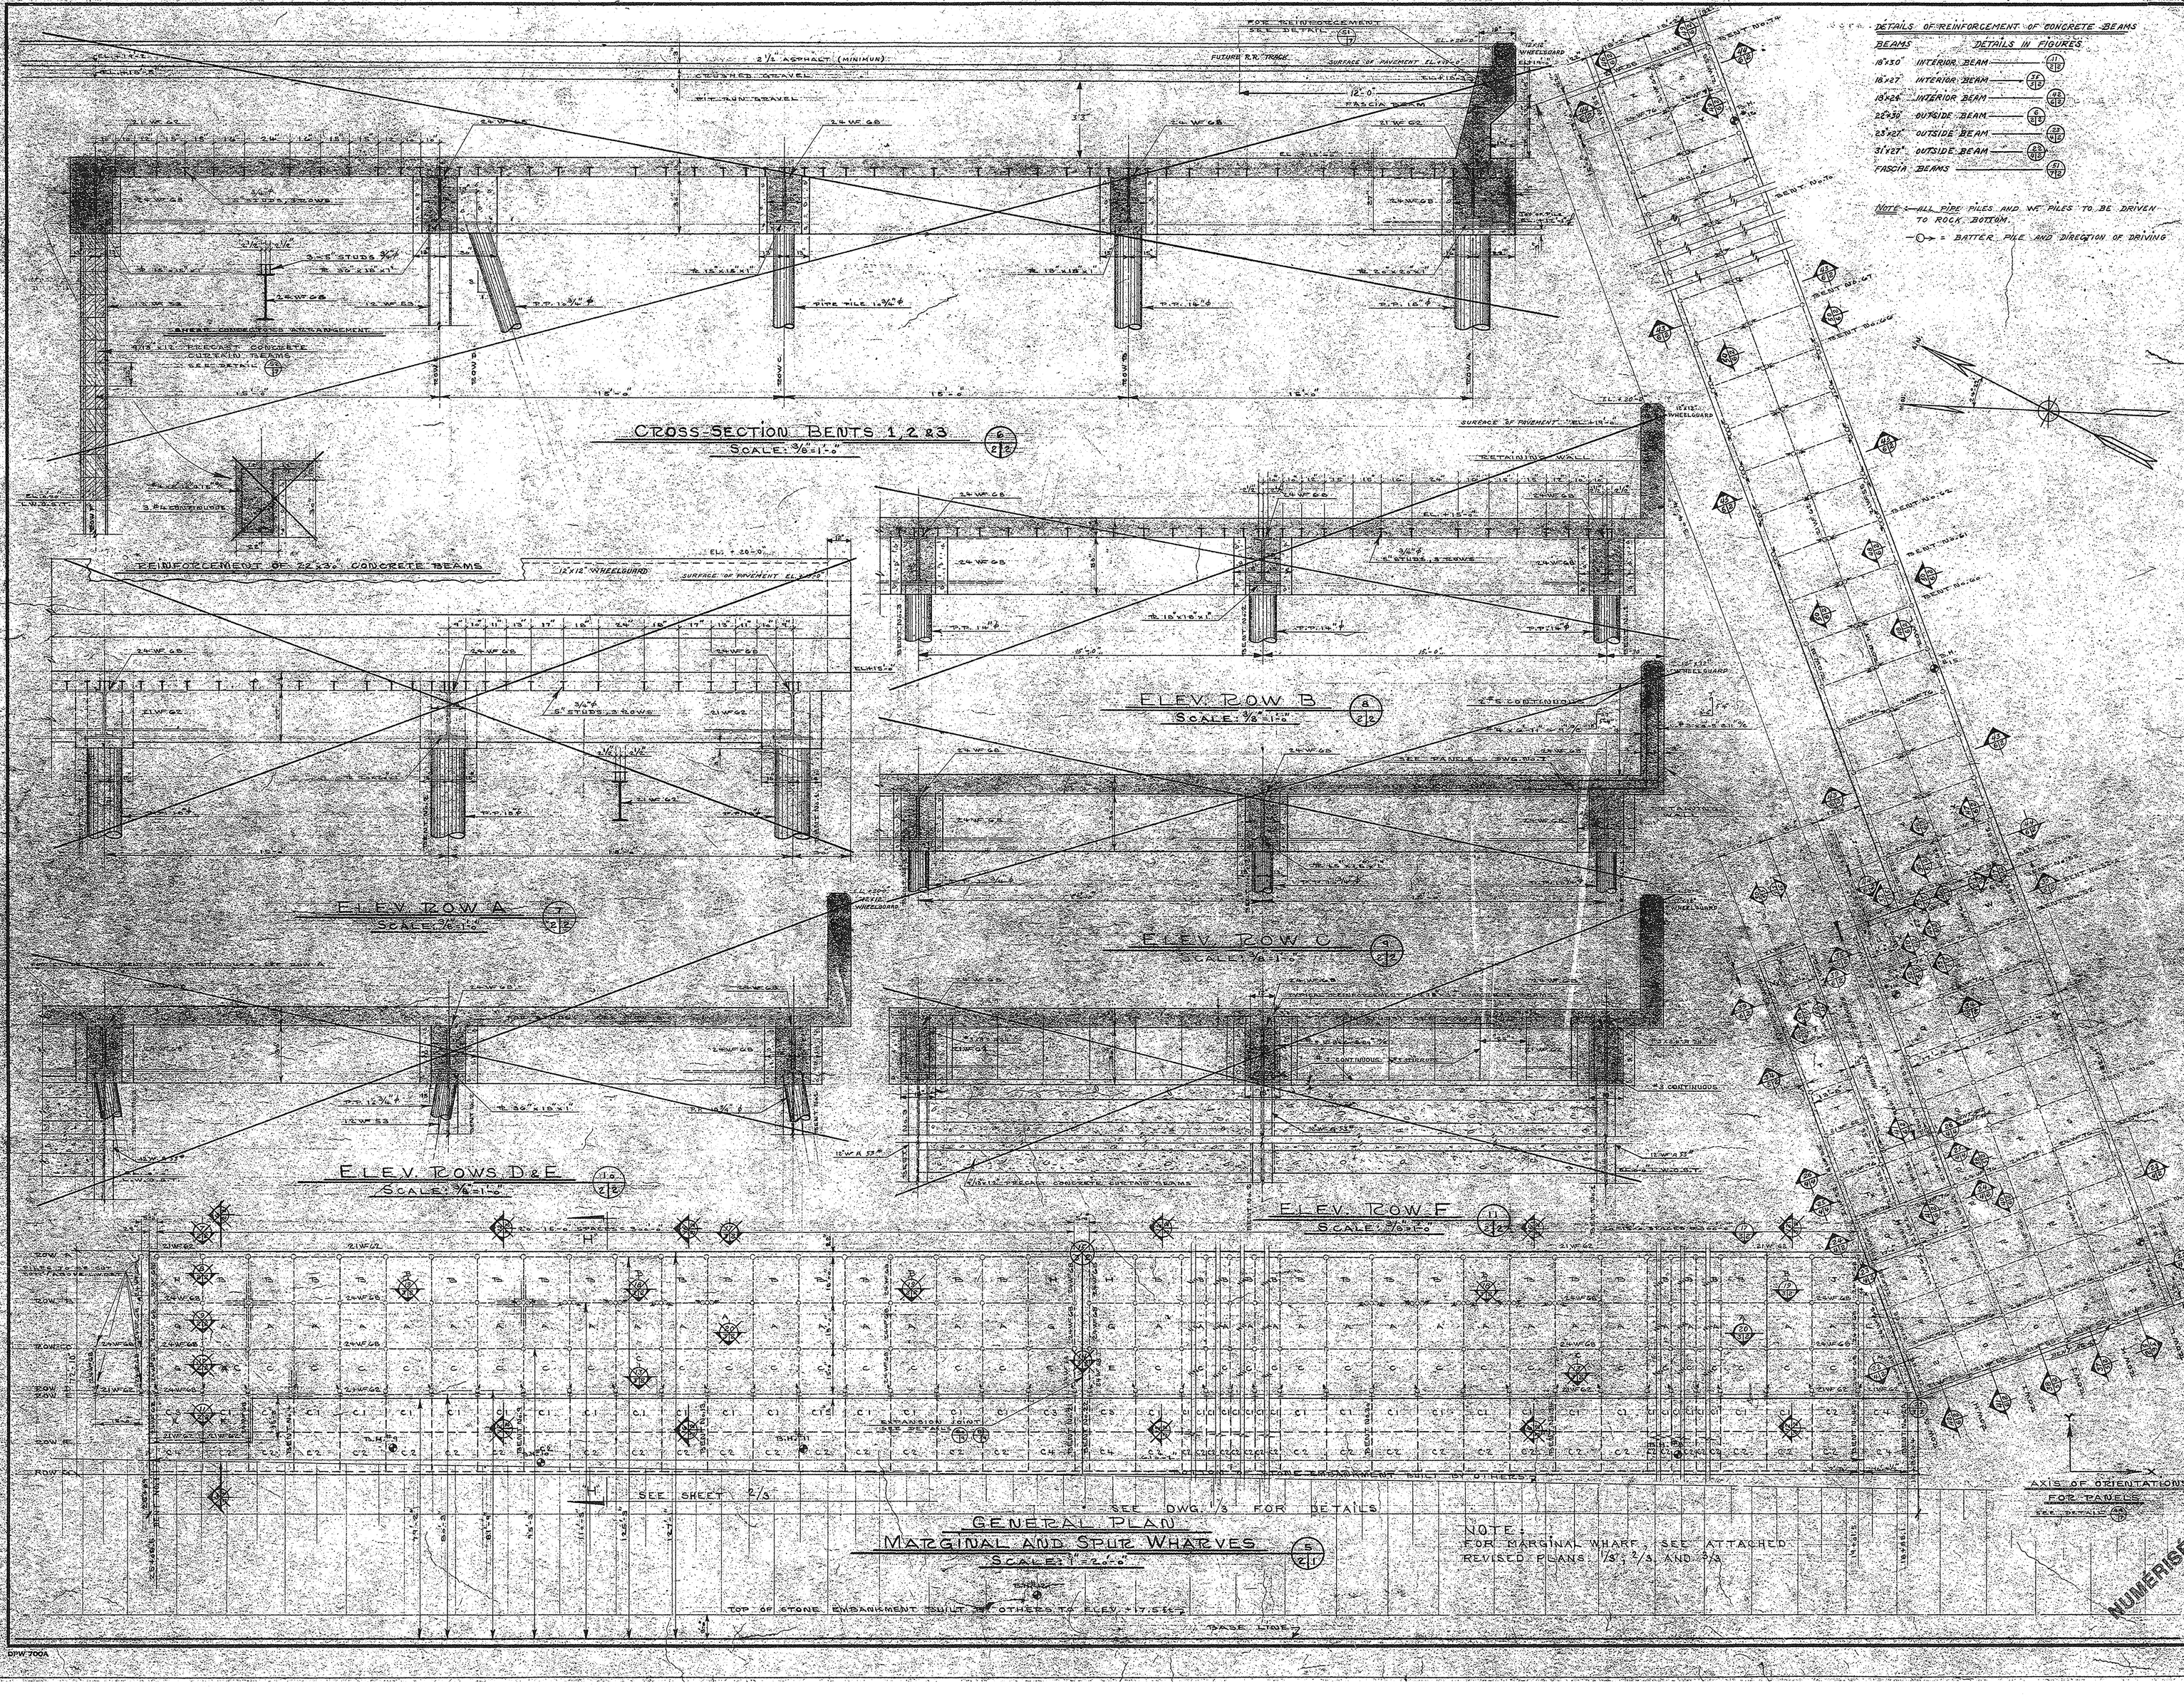

DETAILS OF REINFORCEMENT OF CONCRETE BEAMS

BEAMS	DETAILS IN FIGURES
18"x30" INTERIOR BEAM	11/2 2/2
18"x27" INTERIOR BEAM	3F/2 2/2
18"x24" INTERIOR BEAM	4E/2 2/2
22"x30" OUTSIDE BEAM	6/2 2/2
23"x27" OUTSIDE BEAM	2F/2 2/2
31"x27" OUTSIDE BEAM	2G/2 2/2
FASCIA BEAMS	5I/2 2/2

NOTE: ALL PIPE PILES AND W.F. PILES TO BE DRIVEN TO ROCK BOTTOM.

—O→ = BATTER PILE AND DIRECTION OF DRIVING

Department of Public Works | Ministère des Travaux publics

MENARD, MARSAN & THIBEAULT
CONSULTING ENGINEERS
88 OUEST, ST-GERMAIN, RIMOUSKI, QUE.

A. detail no. / B. location / C. dwg. no. — détail no / sur feuille no / feuille no

date 5 SEPT. 1968 — revisions GENERAL

AS BUILT

Job title: / Titre du projet:
MATANE, MATAPEDIA-MATANE, QUE.
HARBOUR IMPROVEMENTS
PHASE "C" WHARVES

Drawing title: / Titre du dessin:
GENERAL PLAN
MARGINAL & SPUR WHARVES AND CROSS-SECTIONS

designed by: / conçu par: L. McL. — date JANUARY 1968
drawn by: / dessiné par: R. D. — date JAN. 1968
reviewed by: / examiné par: — date
approved by: / approuvé par: — date 29/10/68
job number / no du projet: C.A. M-17-10
dwg. no. / FEUILLE no 2 of 15

D.00