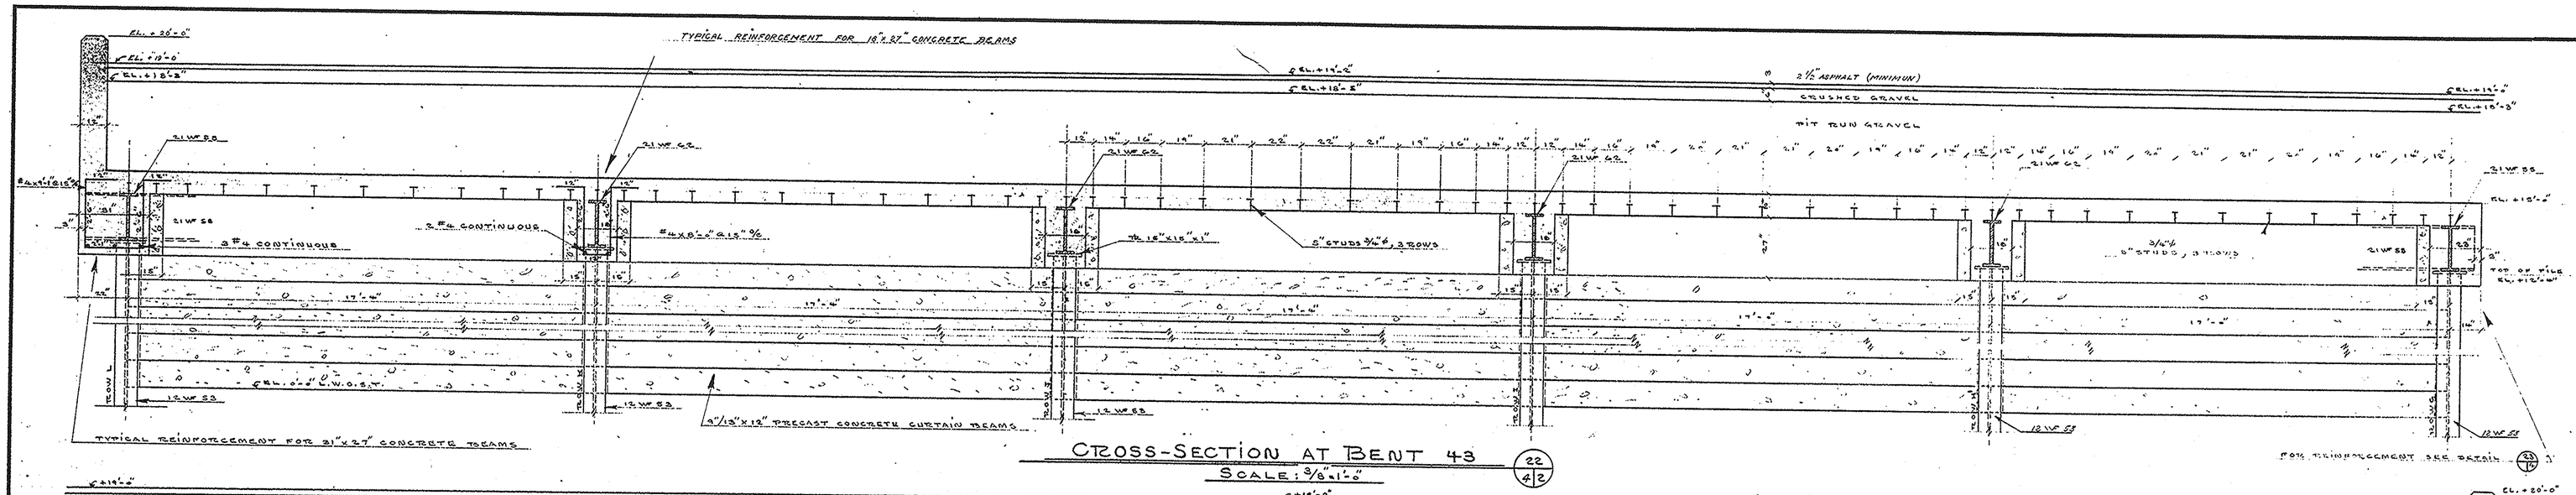

CROSS-SECTION AT BENT 43

SCALE: 3/8"=1'-0" (22/4/2)

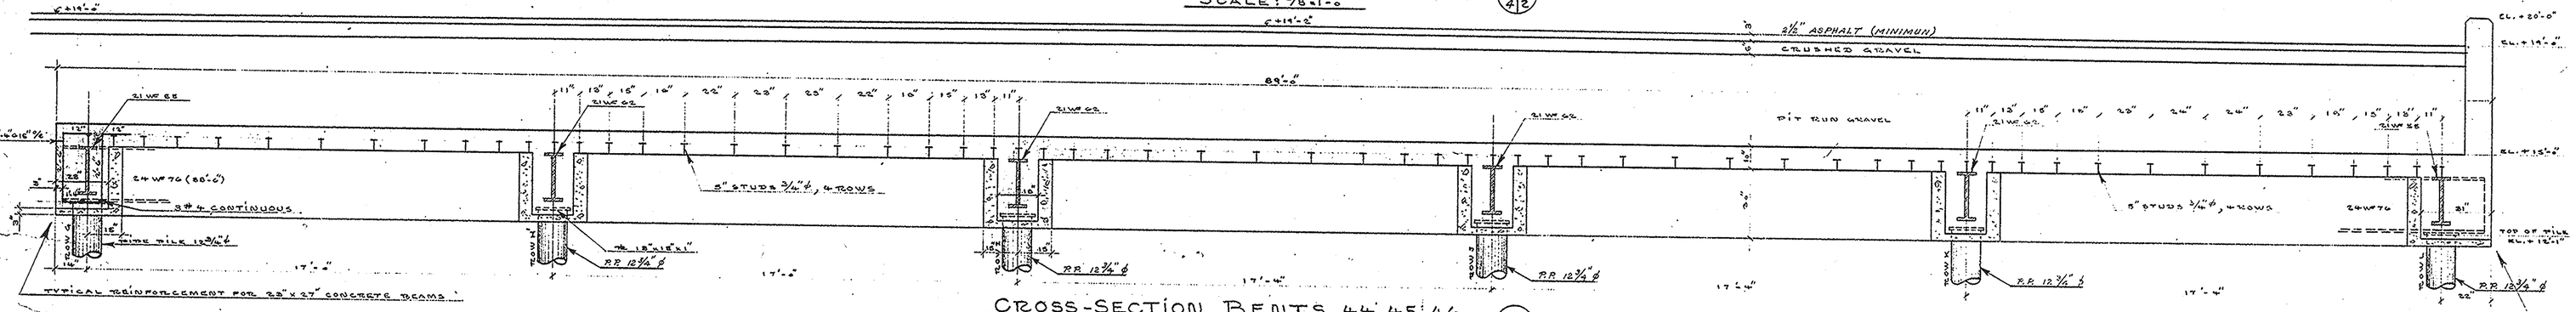

CROSS-SECTION BENTS 44, 45, 46

SCALE: 3/8"=1'-0" (23/4/2)

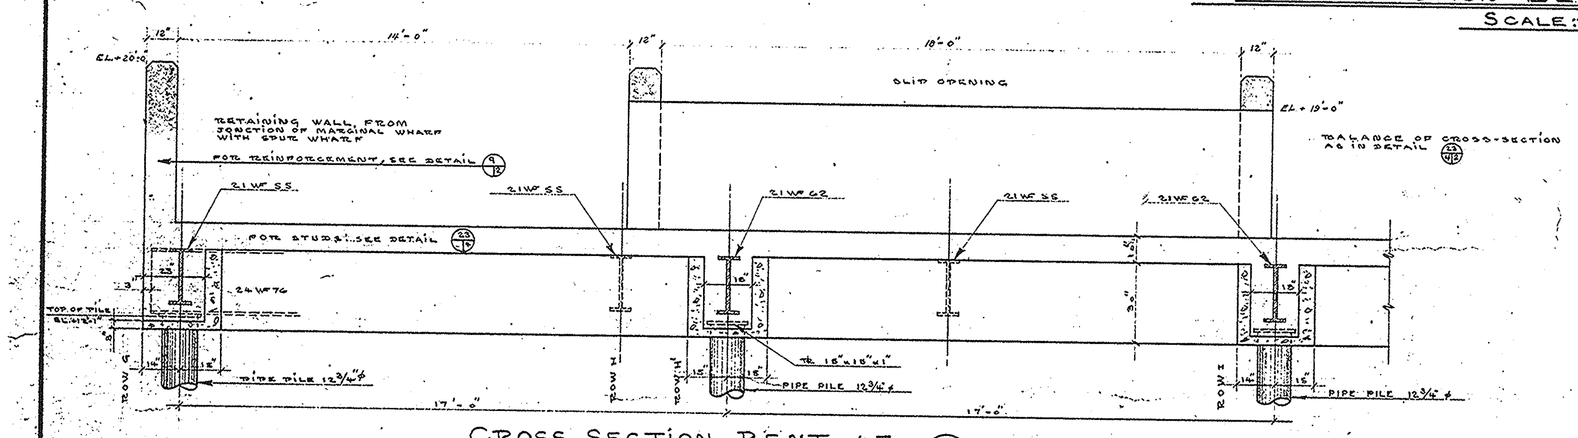

CROSS-SECTION BENT 47

SCALE: 3/8"=1'-0" (24/4/2)

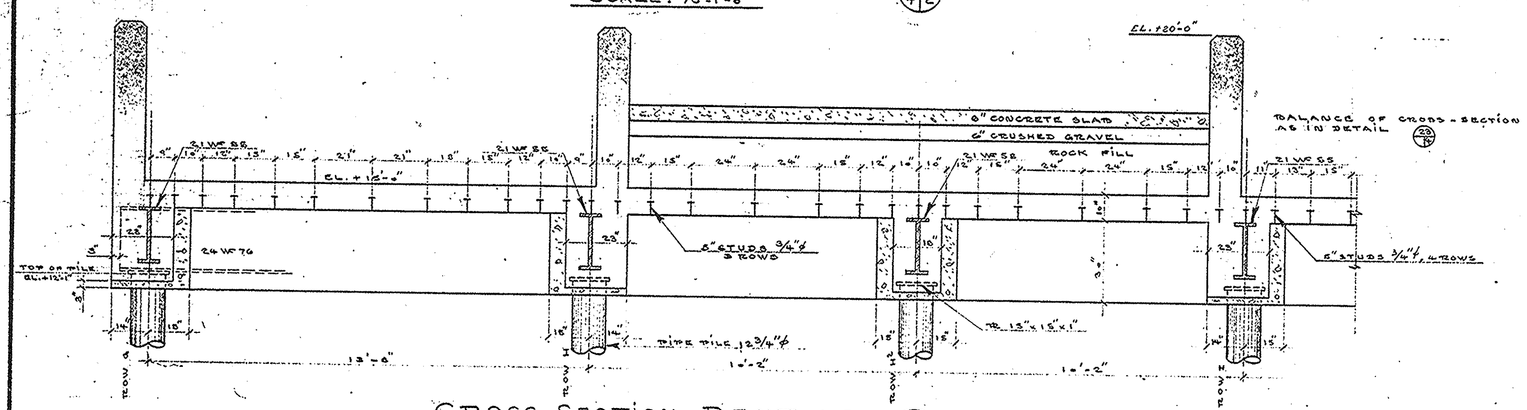

CROSS-SECTION BENT 48

SCALE: 3/8"=1'-0" (25/4/4)

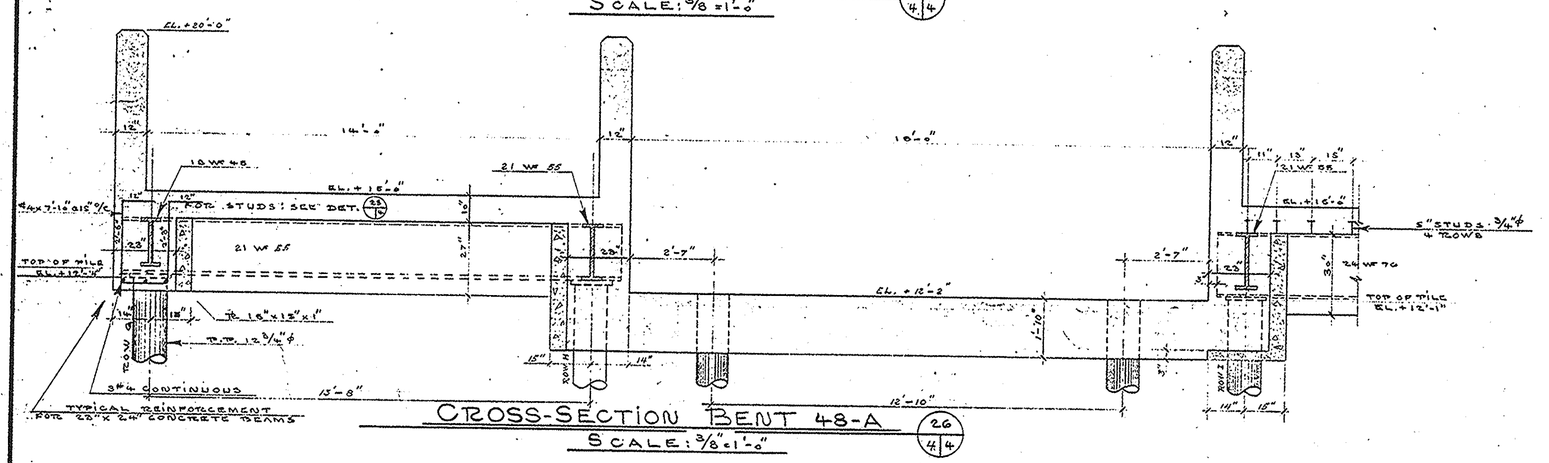

CROSS-SECTION BENT 48-A

SCALE: 3/8"=1'-0" (26/4/4)

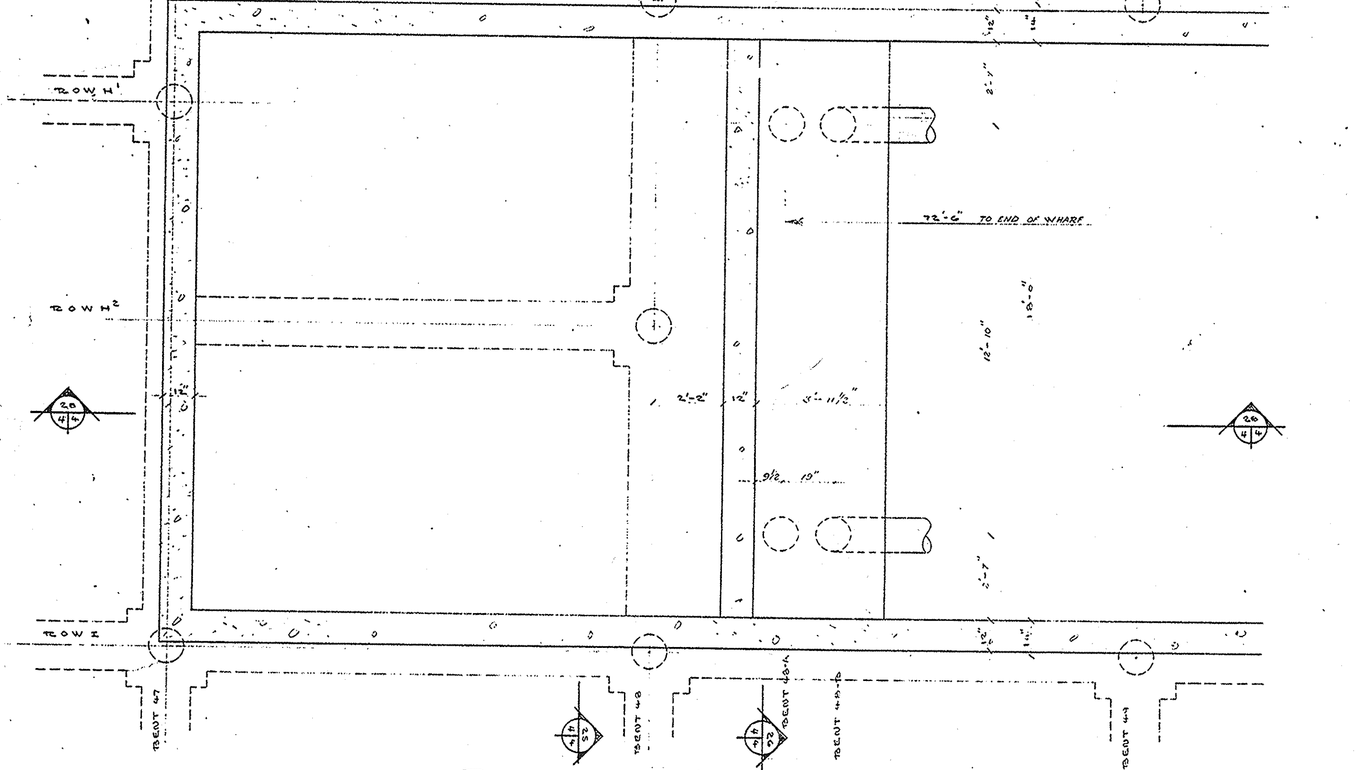

PLAN OF SLIP OPENING

SCALE: 3/8"=1'-0" (27/4/2)

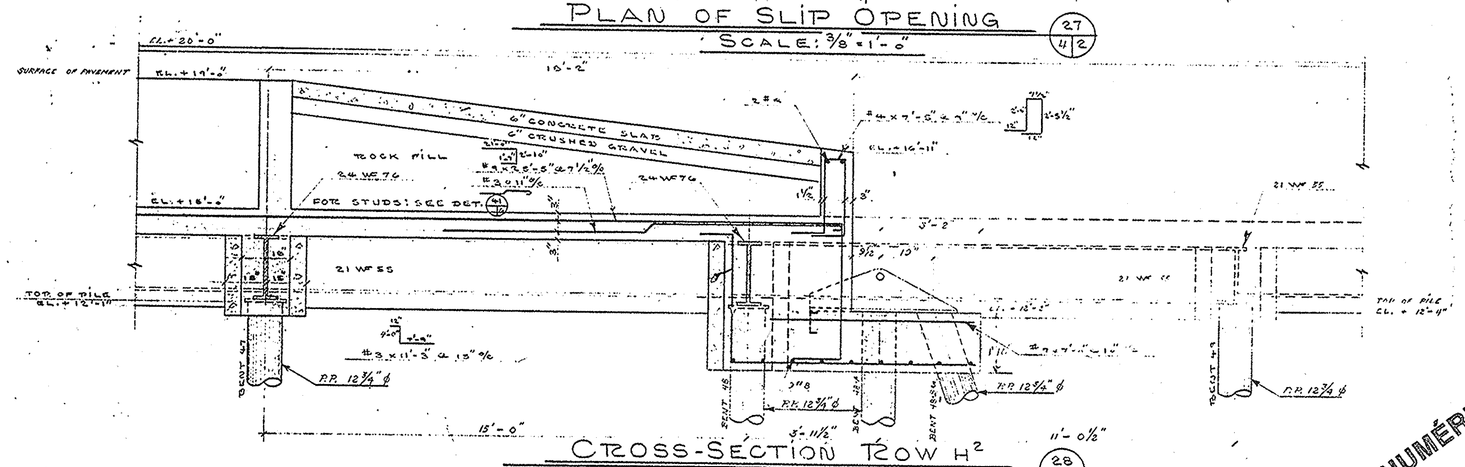

CROSS-SECTION TROW H2

SCALE: 3/8"=1'-0" (28/4/4)

NUMÉRISÉ

AS BUILT

Department of Public Works | Ministère des Travaux publics

MENARD, MARSAN & THIBEAULT
CONSULTING ENGINEERS
88 QUEST, ST-GERMAIN, RIMOUSKI, QUE.

A. detail no. / détail nº
B. location dwg. no. / sur feuille no
C. dwg. no. / feuille no

date: 5 SEPT. 1968
revisions: GENERAL

Job title: / Titre du projet:
MATANE, MATAPEDIA-MATANE, QUE.
HARBOUR IMPROVEMENTS
PHASE "C" WHARVES

Drawing title: / Titre du dessin:
CROSS-SECTIONS OF SUPERSTRUCTURE

designed by: / conçu par: L. Mc. L. — date: JAN. 31, 1969
drawn by: / dessiné par: R. D. — date: JAN. 31, 1969
reviewed by: / examiné par: — date:
approved by: / approuvé par: — date: 28/2/69

job number / nº du projet: C.A. M-17-10
dwg. no. / feuille nº: 4 of 15

DPW 700A