


DECK 3
FOCSLE DECK

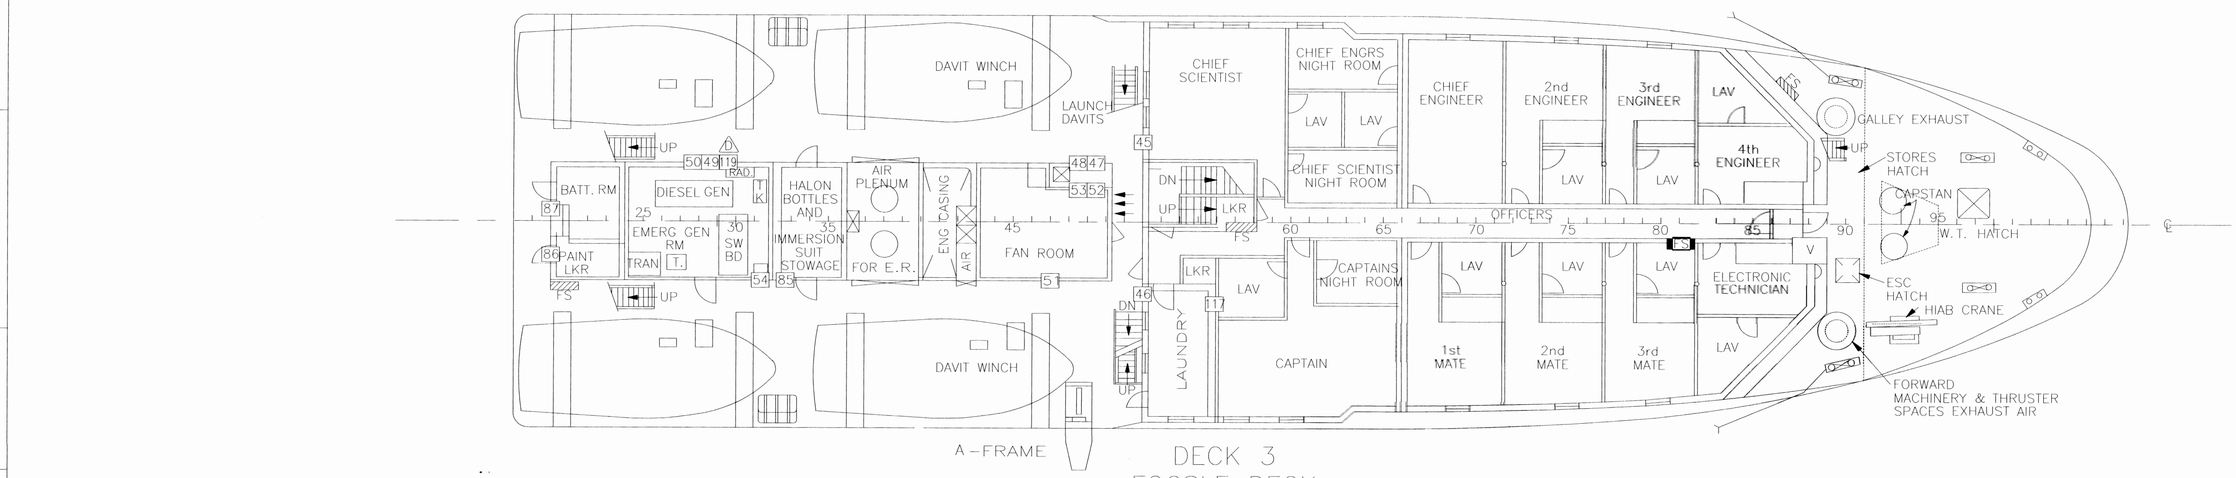


DECK 2
UPPER DECK

NOTE: TRANSIT 125 EXISTING BUT NOT MARKED ON DWGS(STBD HALL TO INCIN. RM.)

"AS-BUILT"

| Rev. No. | Zone | Revisions | App'd/App'n | Date |
|---|---|---|---|---|
| App'd/App'n | | | | |
| Date | | | | |

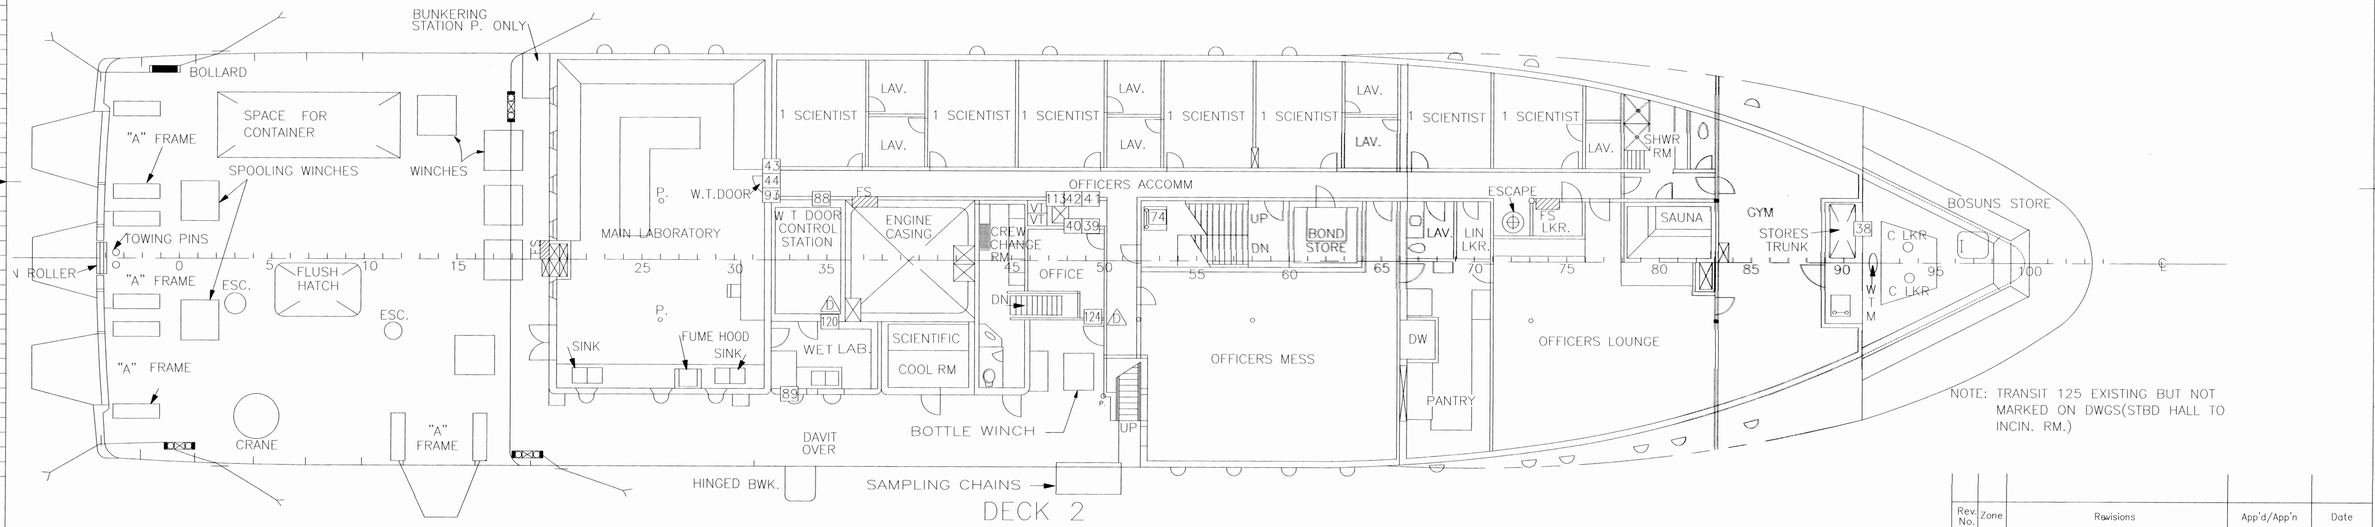Contractor/Entrepeneur
VANCOUVER SHIPYARDS
Vancouver Shipyards Co. Ltd.,
50 Pemberton Avenue,
North Vancouver, BC,
V7P 2R2.
Tel: (604) 988-6361.
Fax: (604) 990-3294.

Contractor Drg. No. / Entrepreneur dess. N° 05034-E-012

GOVERNMENT OF CANADA
DEPARTMENT OF FISHERIES AND OCEANS

Vessel / Navire: JOHN P. TULLY

Drg. Title / Dess. titre: CABLE TRANSIT SURVEY

| Dwn. / Dess. | Ckd. / Ver. | App'd / App'n |
|---|---|---|
| BEH | RGH | CME |

Date: 02/01/08 | Scale/Échelle: NTS | Sheet/Feuille 3 Of/De 4

C.C.G. Drg. No. / G.C.C. dess. N° | Rev. D

| Dwg No. de dess | Title/Titre |
|---|---|
| Reference Dwgs/Dess Reference | |