

Appendix A

Copy of Notice to the Minister - permission to proceed under the
Navigation
Protection Act (NPA)



Navigation Protection Program
PO Box 42
Moncton, NB E1C 8K6

Your file

Our file
8200-95-2028

February 15, 2017

Fisheries and Oceans Canada, Small Craft Harbours
Maritimes and Gulf Region
343 Universite Avenue
PO Box 5030
Moncton, NB E1C 9B6

RE: Notice to the Minister\permission to proceed under the *Navigation Protection Act* for a Wharf, located at 44° 36' 40.95" N x 063° 29' 50.21" W, Eastern Passage, Halifax Harbour, Halifax Regional Municipality, in the Province of Nova Scotia

The Minister of Transport has determined that your work is not likely to substantially interfere with navigation.

Therefore, your work is permitted under the NPA s.9(1) Alteration, and you may proceed pursuant to the attached plan(s) in accordance with the following terms and conditions:

1. During construction, a cautionary buoy must be placed as near as practical to the construction area, and will carry the following:
 - a. radar reflector;
 - b. 2nm amber light displaying characteristic (FI) 4S from dusk to dawn and during periods of reduced visibility.
2. Advise the Notice to Shipping office (Sydney) at (902) 564-7751 or toll-free 1-800-686-8676 sufficiently in advance of commencement of work and when deploying and removing the cautionary buoys in order to allow for appropriate Notices to Shipping/Mariners action.
3. As built plans or a document signed and stamped by the project engineer attesting to the work being completed as per the NPA authorized plan shall be sent upon completion of the project to the Hydrographic Data Centre, Canadian Hydrographic Service and to the Navigation Protection Program nppatl-ppnatl@tc.gc.ca.

This permission relates only to the effect of your work on navigation under the NPA and does not grant any rights related to the ownership of the bed of the waterway.

It is the owner's responsibility to comply with any other applicable laws and regulations.

Please note that the NPA, amongst other obligations, requires the owner to immediately notify the Minister if his work causes or is likely to cause serious or imminent danger to navigation and take reasonable measures to remediate the danger to navigation (section 12 of the NPA).

Should you have any questions, please do not hesitate to contact our office in Moncton by phone at (506) 851-3113, by fax at (506) 851-7542 or by e-mail at NPPATL-PPNATL@tc.gc.ca.


Respectfully,



Stuart Lane
Officer
Navigation Protection Program
Programs Group
Transport Canada
Atlantic Region

Attachment(s)

cc: CHS
PWGSC

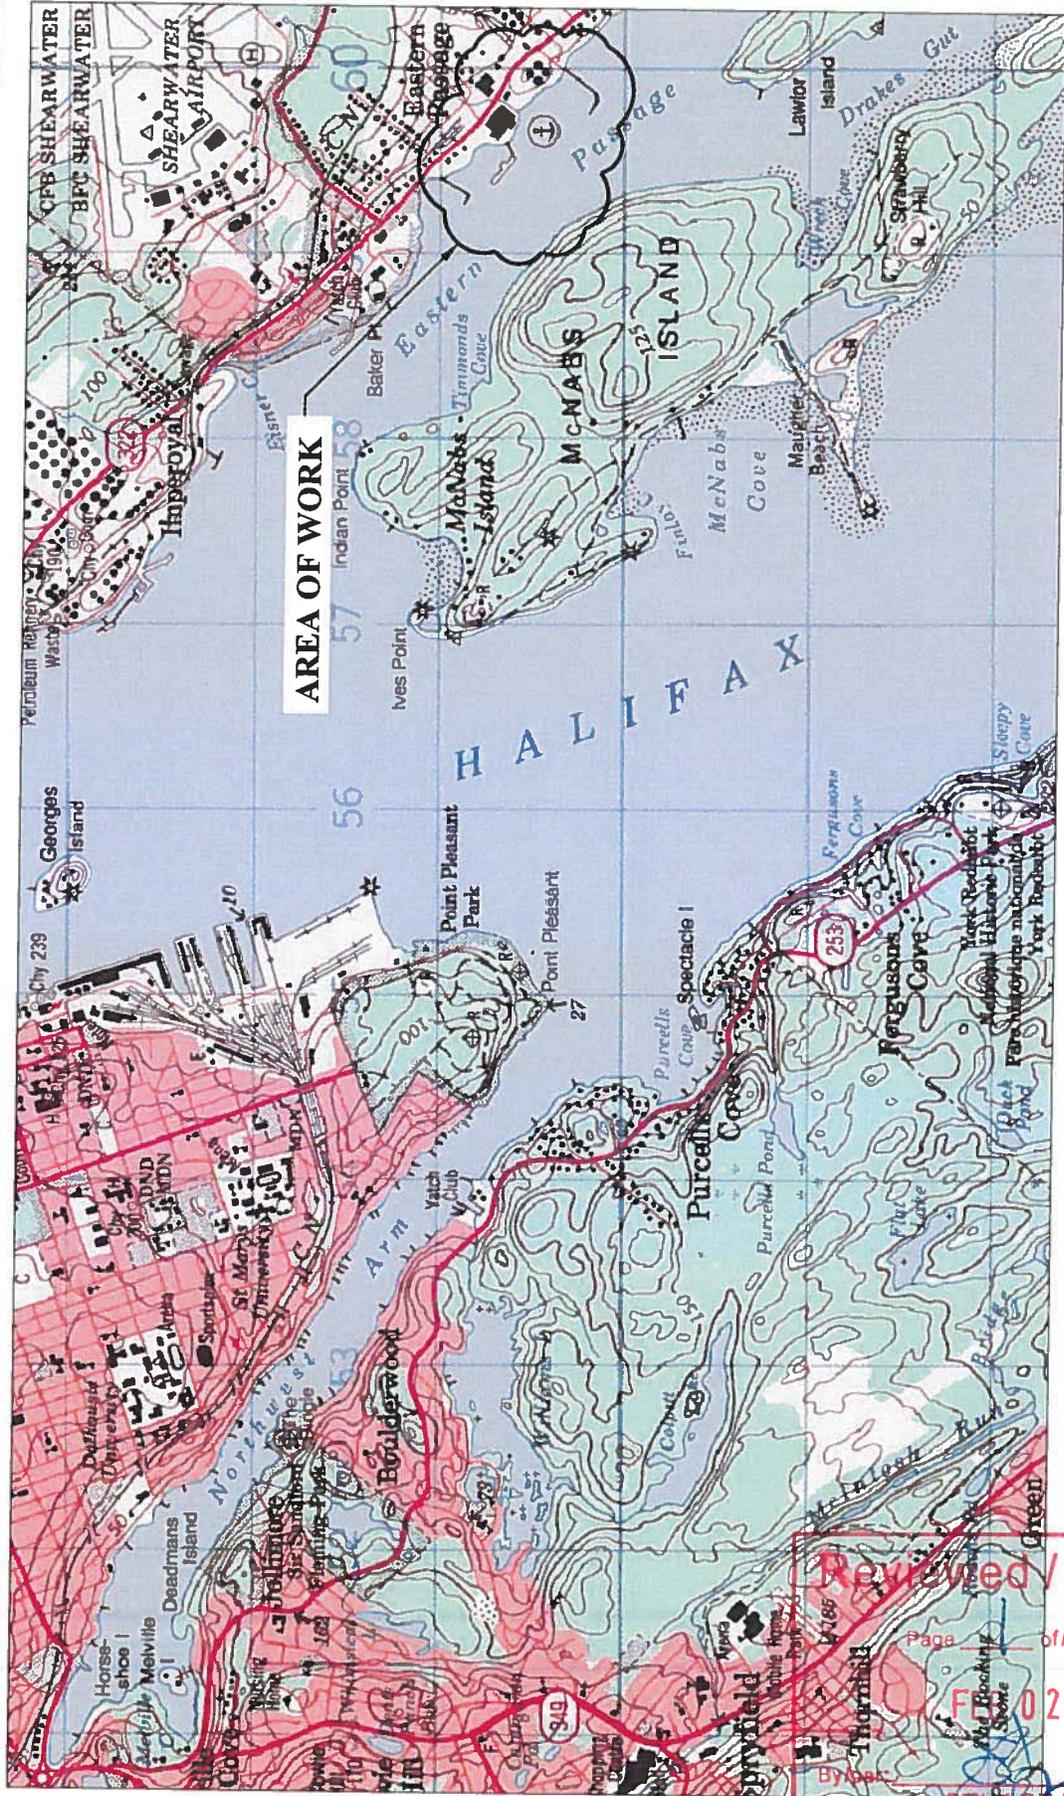

AREA OF WORK

designed	conçu	date
drawn	dessiné	date
approved	approuvé	date
no. du projet		no. du dessin
drawing no.		FIG 1

Drawing title	Titre du dessin	
HARBOUR LOCATION		
project	projet	
N.P.P. DFO - SCH		
EASTERN PASSAGE (1098) HALIFAX COUNTY, NS		

Travaux publics et Services gouvernementaux Canada	Submission
Administrateur de projets TPSGC	
PWGSC Project Manager	
PWGSC L1 (2004)	

Reviewed / Examiné


Page _____ of _____

Feb 02 2016

STUART LAM

Navigation Protection Program /
Programme de protection de la navigation

E-DRM/GDD-E

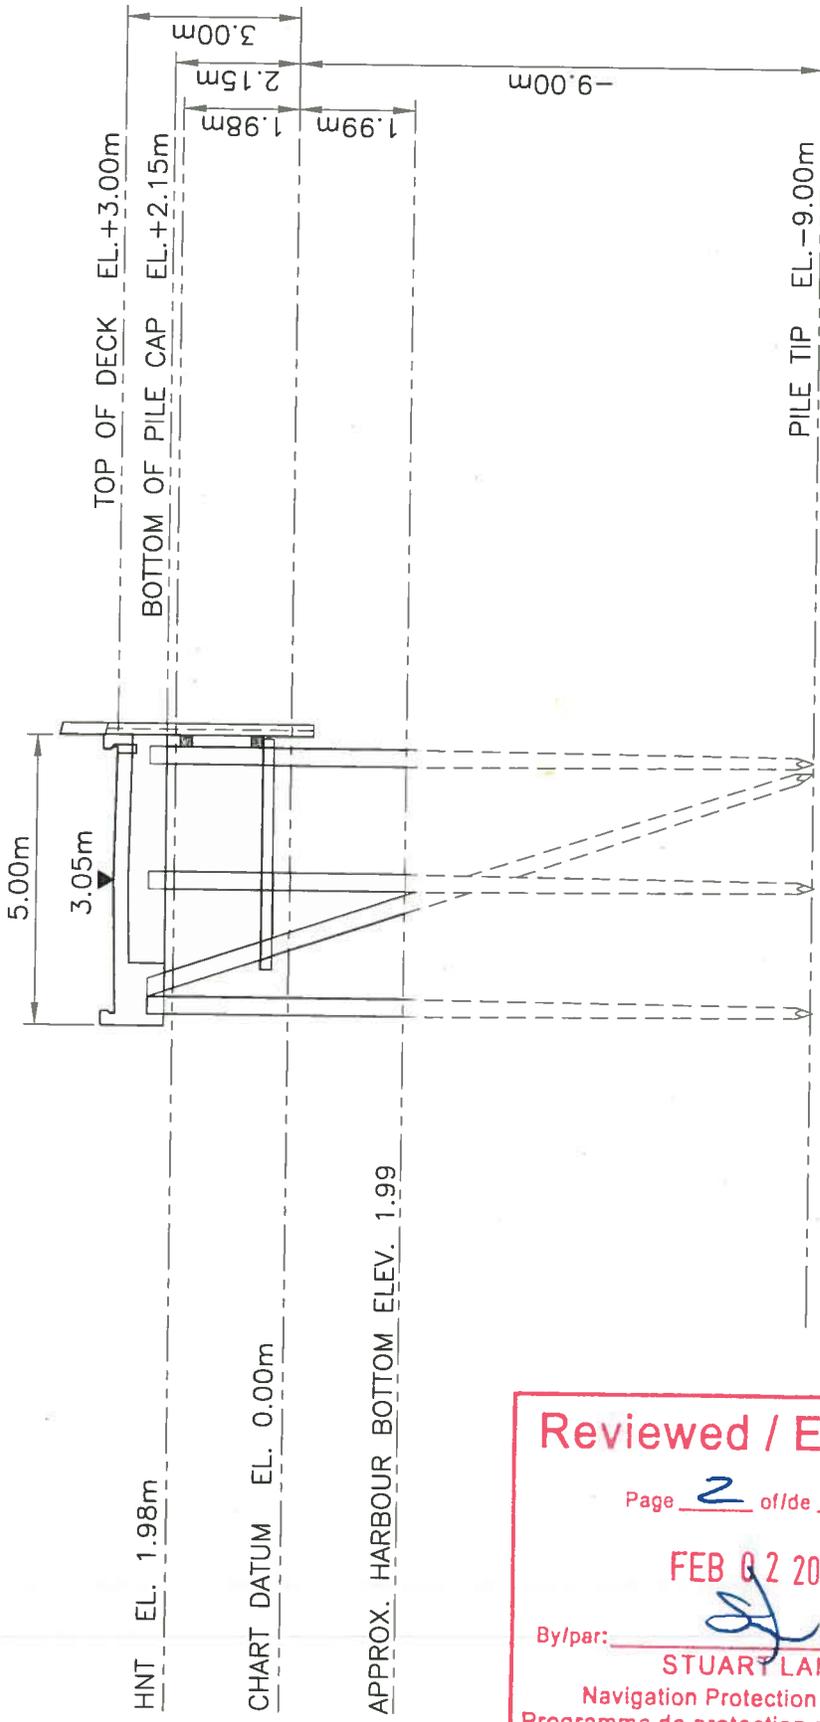

SECTION A

SCALE : 1:125



Reviewed / Examiné
 Page 2 of de 3
FEB 02 2017
 By/par: [Signature]
STUART LANE
 Navigation Protection Program /
 Programme de protection de la navigation

Public Works and Government Services Canada	Travaux publics et Services gouvernementaux Canada	project N.P.P. DFO - SCH		Titre du dessin SECTION A	designed conçu	date date
		project EASTERN PASSAGE - 1098 HALIFAX COUNTY, NS		Drawing title SECTION THRU WHARF EXTENSION	drawn dessiné TM	approved approuvé date Sept. 2016
Tender PWGSC Project Manager		Submission Administrateur de projets TPSSGC		no. du projet 2	drawing no. 2	no. du dessin

