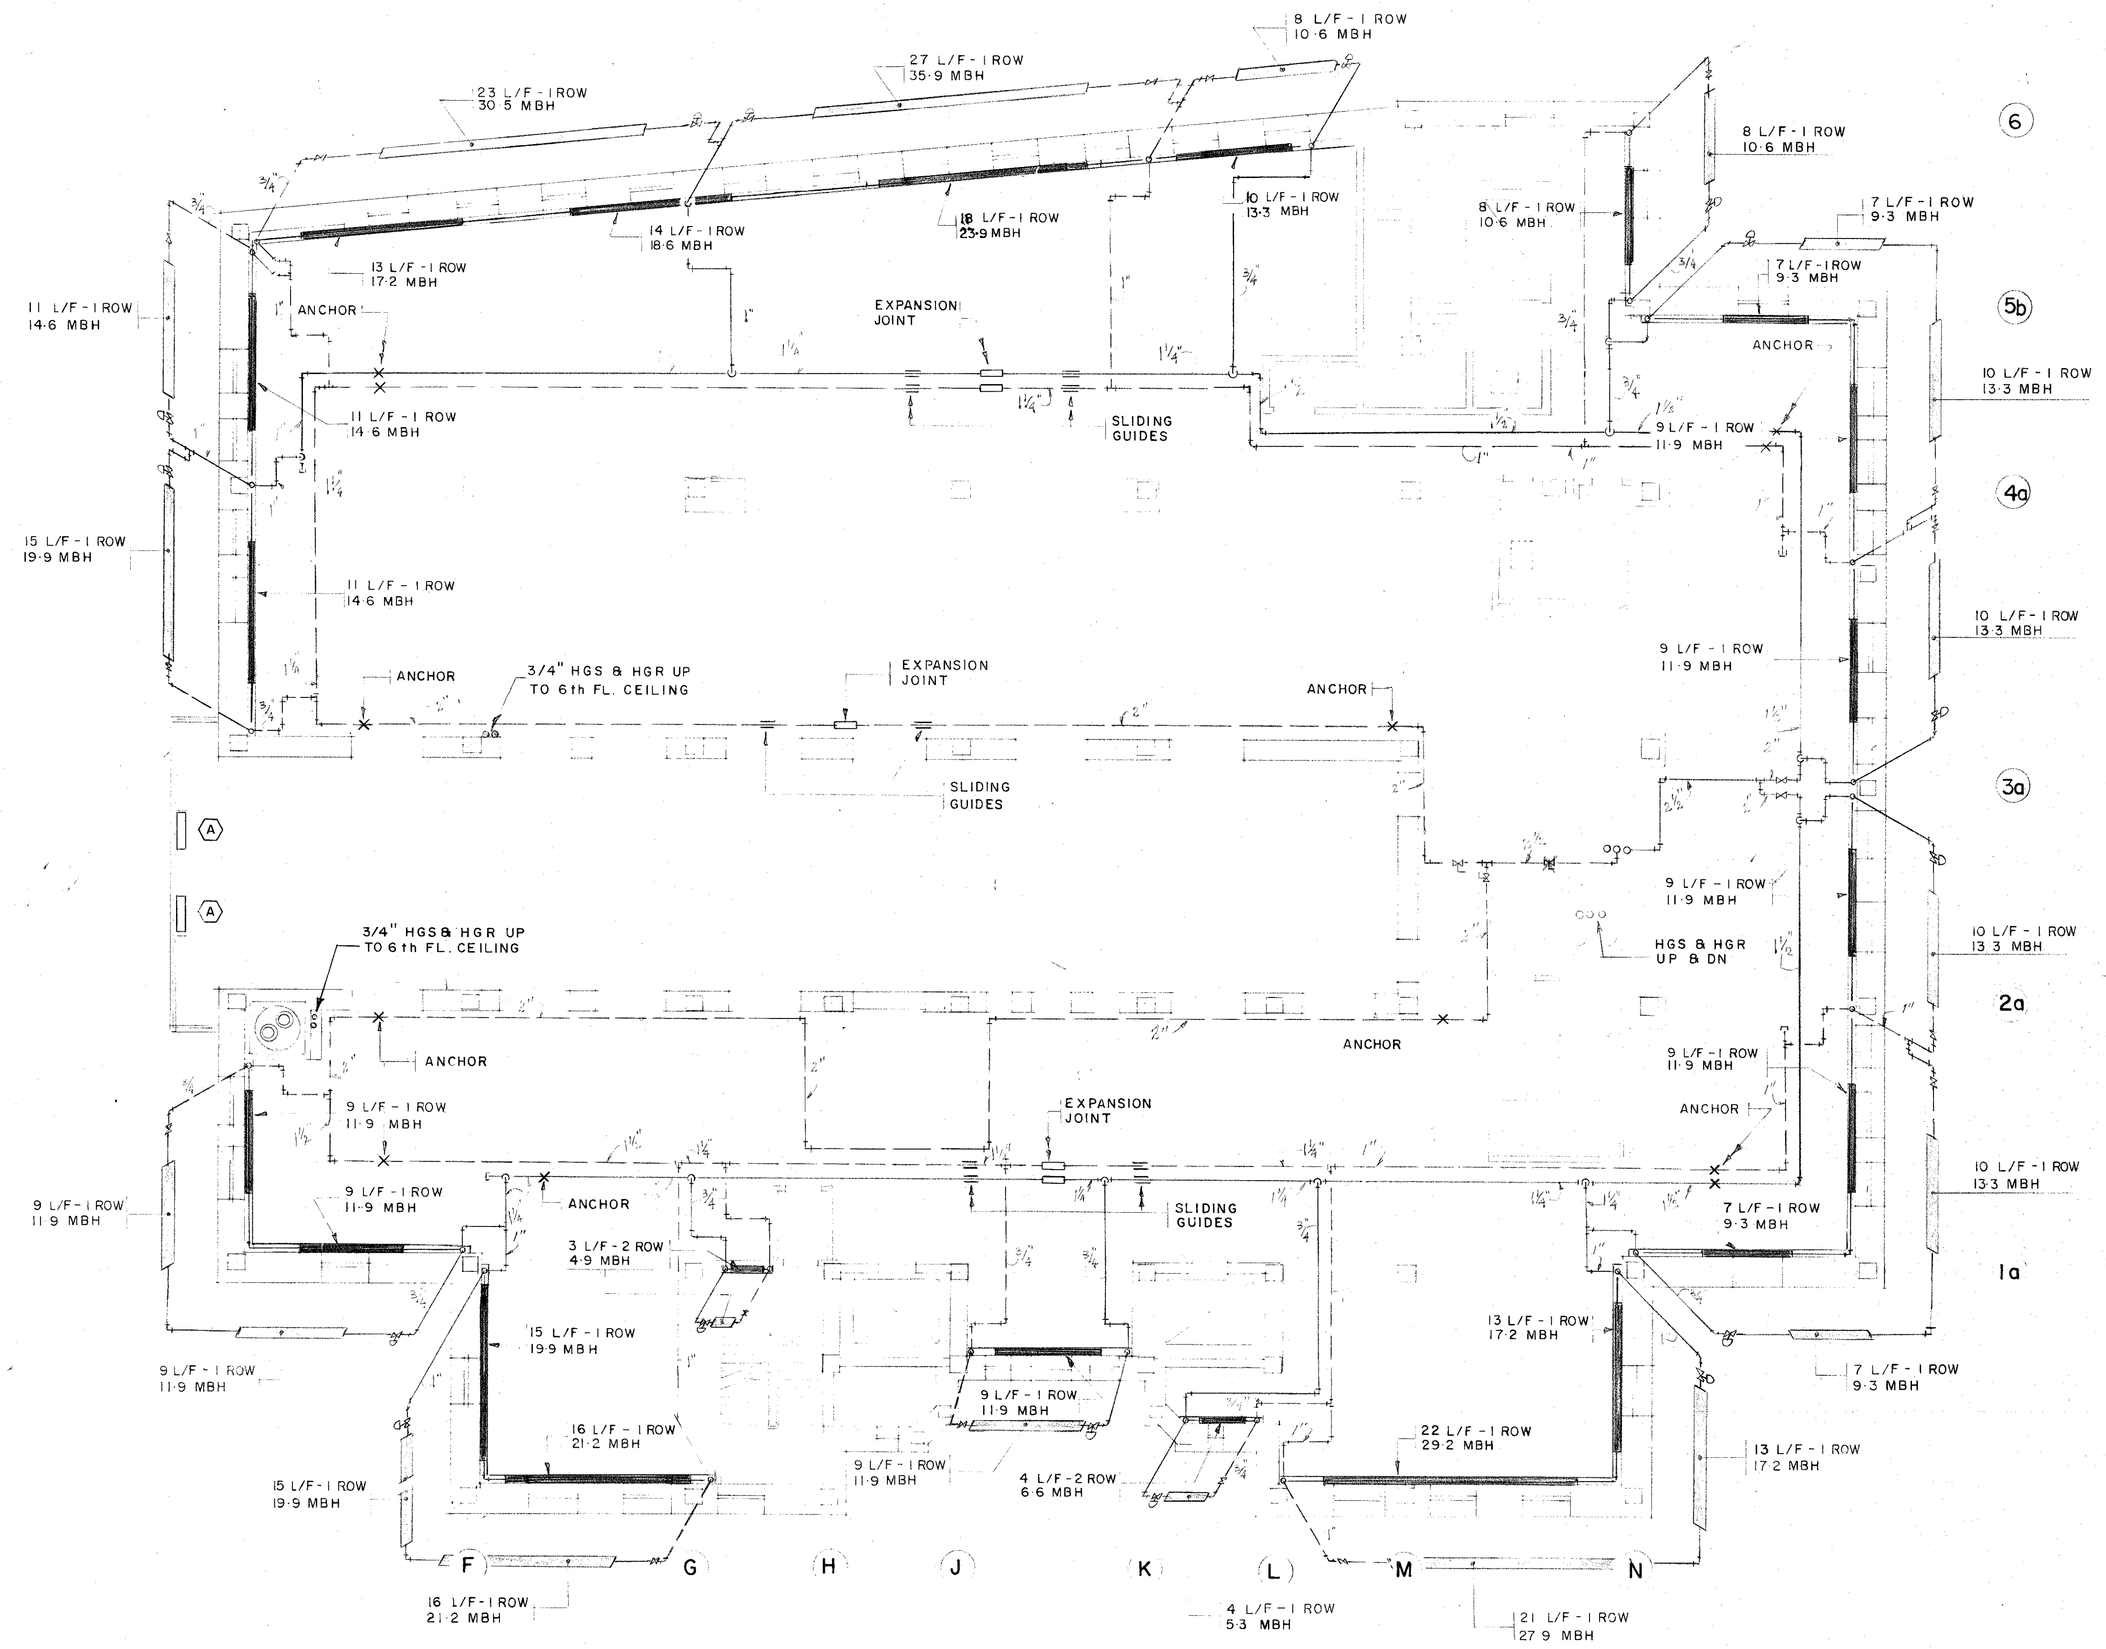

FIFTH FLOOR PLAN

SCALE 1/8" = 1'-0"

WESTERN PLUMBING & HEATING LIMITED

92/03/4

AS BUILT DRAWING

Public Works Canada / Travaux publics Canada

revisions | date

A detail no. / no. du détail
B location drawing no. / sur dessin no.
C drawing no. / dessin no.

project / projet
G.O.C.B.
BEDFORD ROW
HALIFAX, N.S.

drawing / dessin
FIFTH FLOOR PLAN

HEATING

designed / conçu: P. DUMARESQ
date
drawn / dessiné: L. DEVEAU
date
reviewed / examiné: 92/05/15
date
approved / approuvé
date
Tender / Soumission
PWC Project Manager / Administrateur de projets TPC
project number / no. du projet: 614362
drawing no. / no. du dessin: MH-7

PWC BI