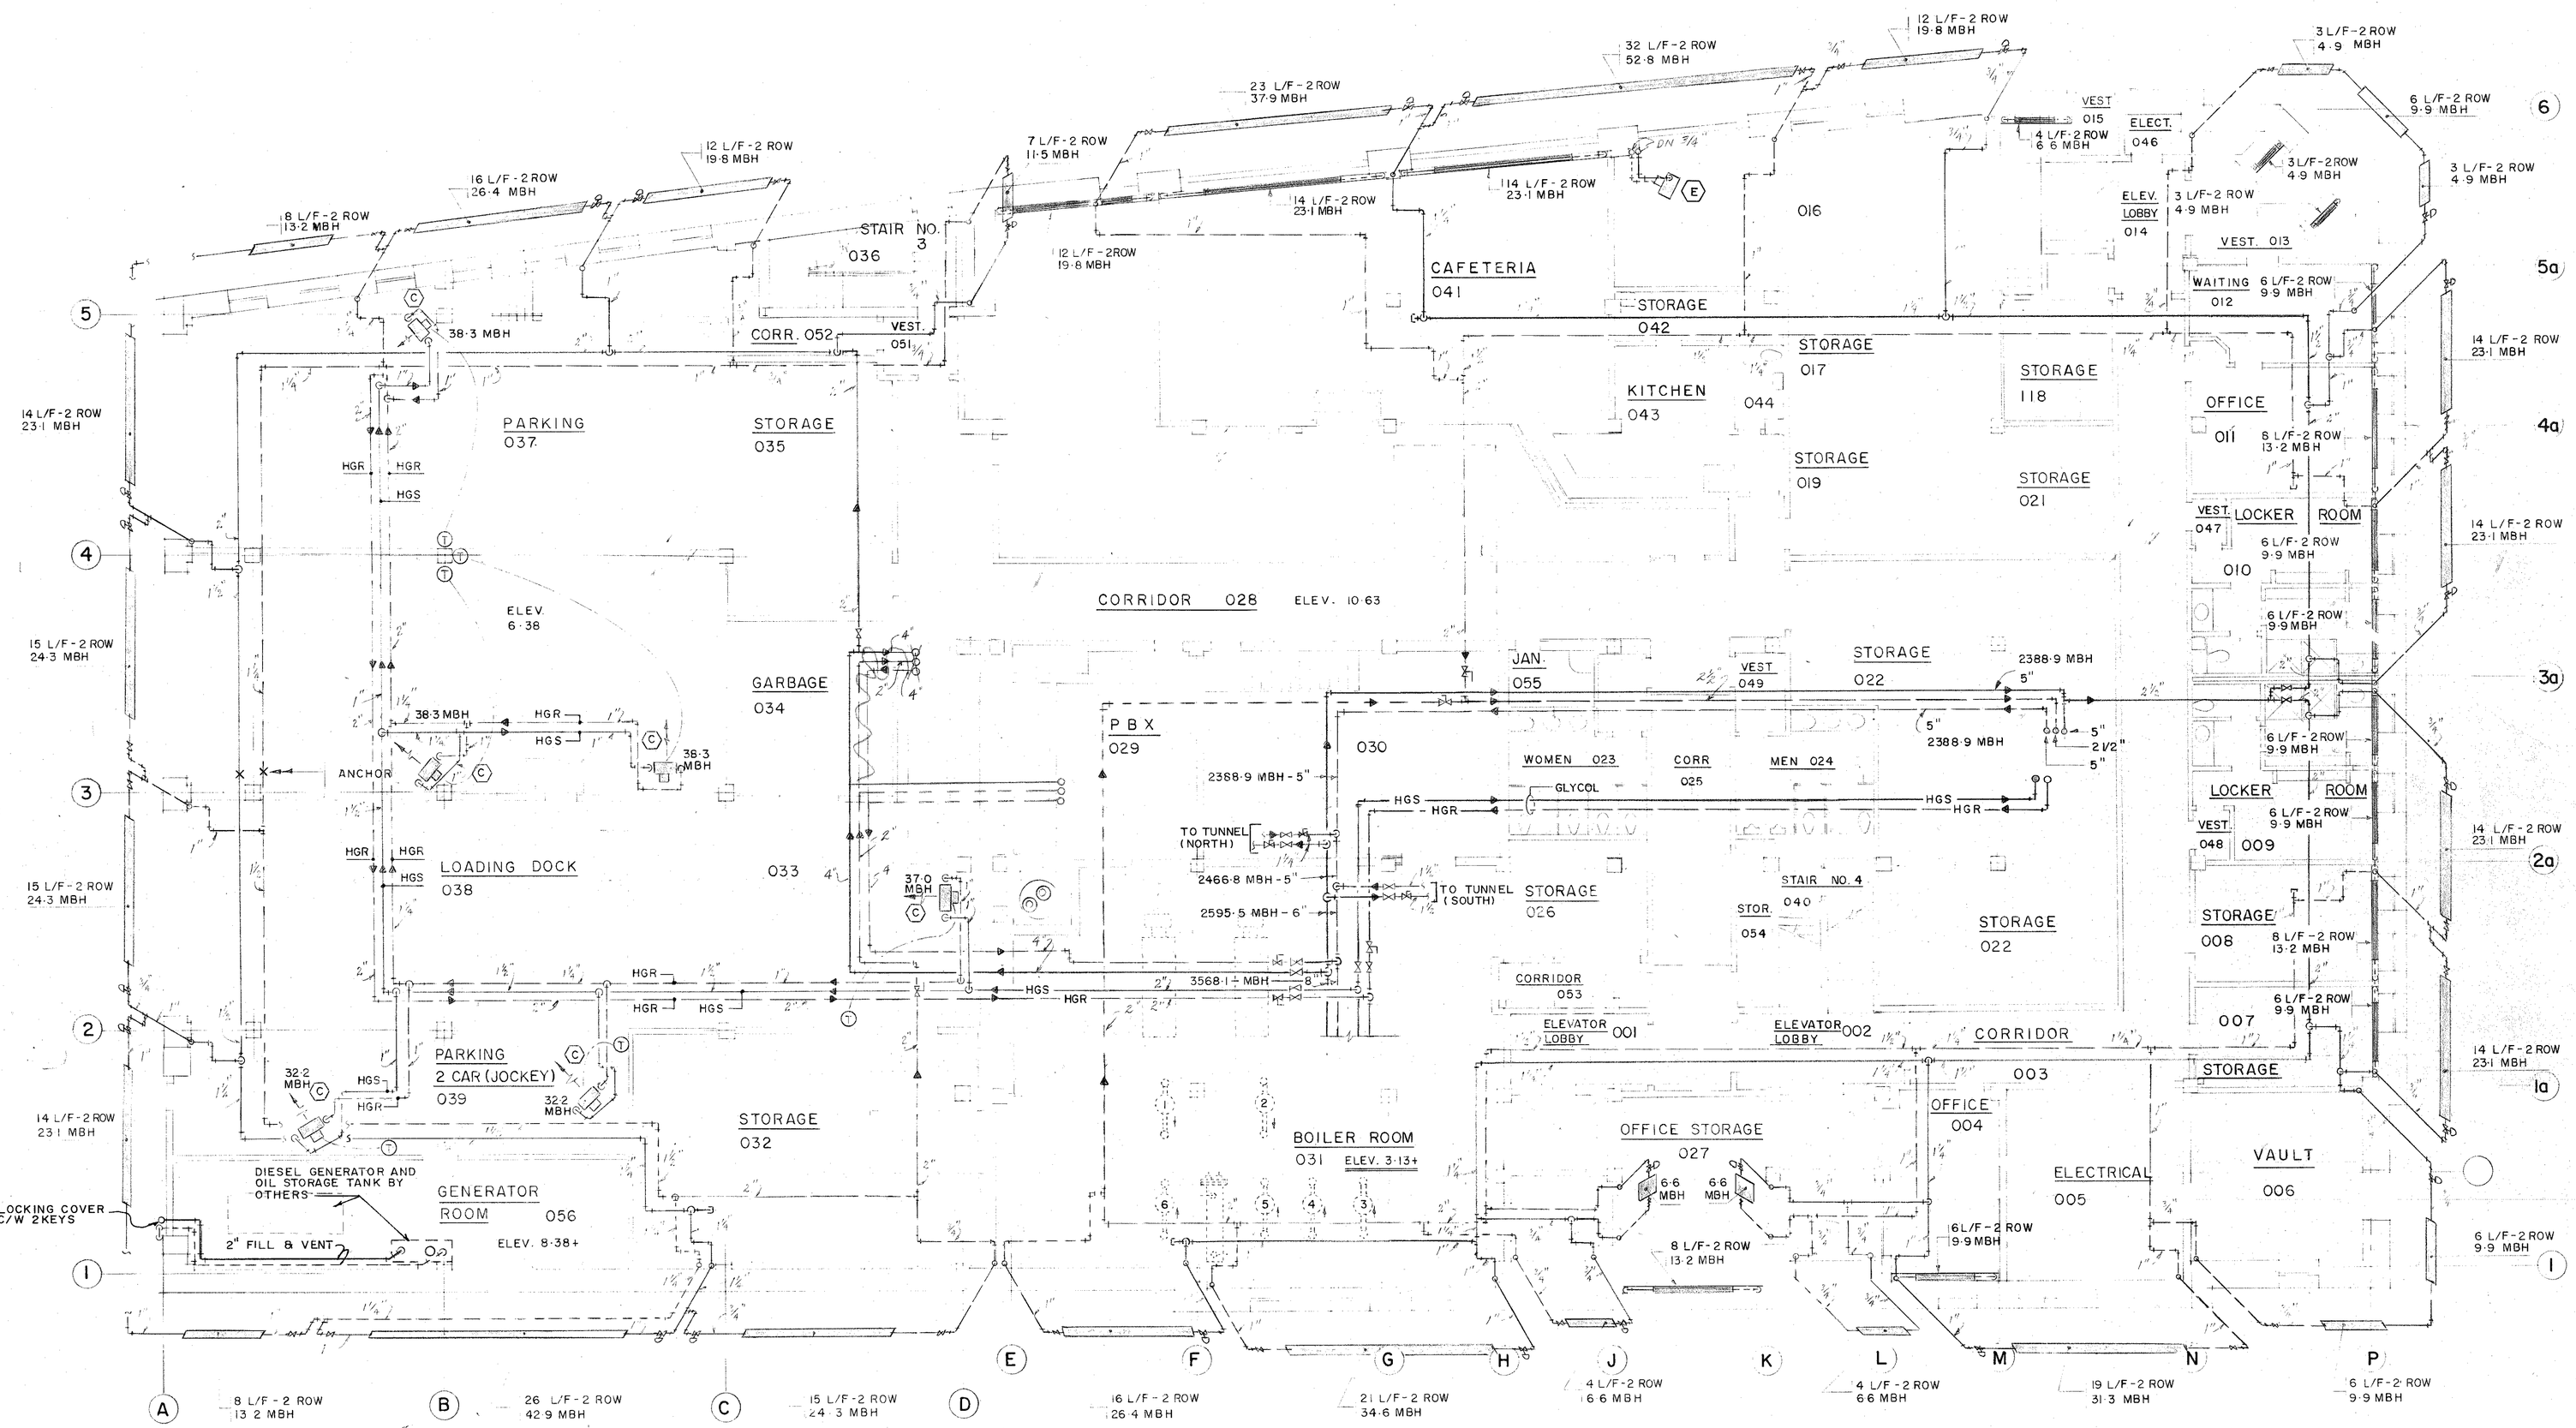

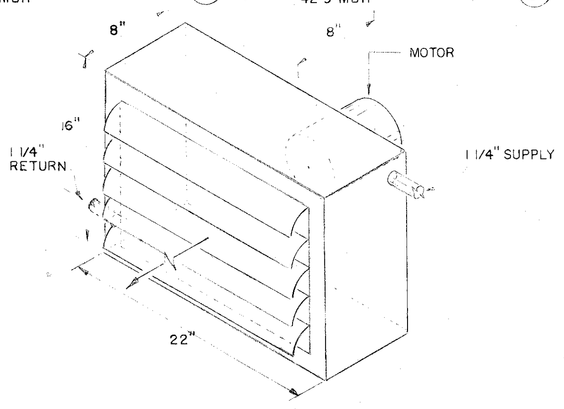

UNIT HEATER DETAIL (TYPICAL)

N.T.S.

BASEMENT FLOOR PLAN

SCALE 1/8" = 1'-0"

WESTERN PLUMBING & HEATING LIMITED

92/03/4

AS BUILT DRAWING

Public Works Canada / Travaux publics Canada

revisions | date

A detail no. no. du détail
B location drawing no. sur dessin no.
C drawing no. dessin no.

project / projet
G.O.C.B.
BEDFORD ROW
HALIFAX, N.S.

drawing / dessin
BASEMENT FLOOR PLAN
HEATING

designed P. DUMARESQ conçu
date
drawn L. DEVEAU dessiné
date
reviewed examiné
date 91/05/10
approved approuvé
date
Tender Soumission
PWC Project Manager Administrateur de projets TPC
project number 614362 no. du projet
drawing no. MH-2 no. du dessin