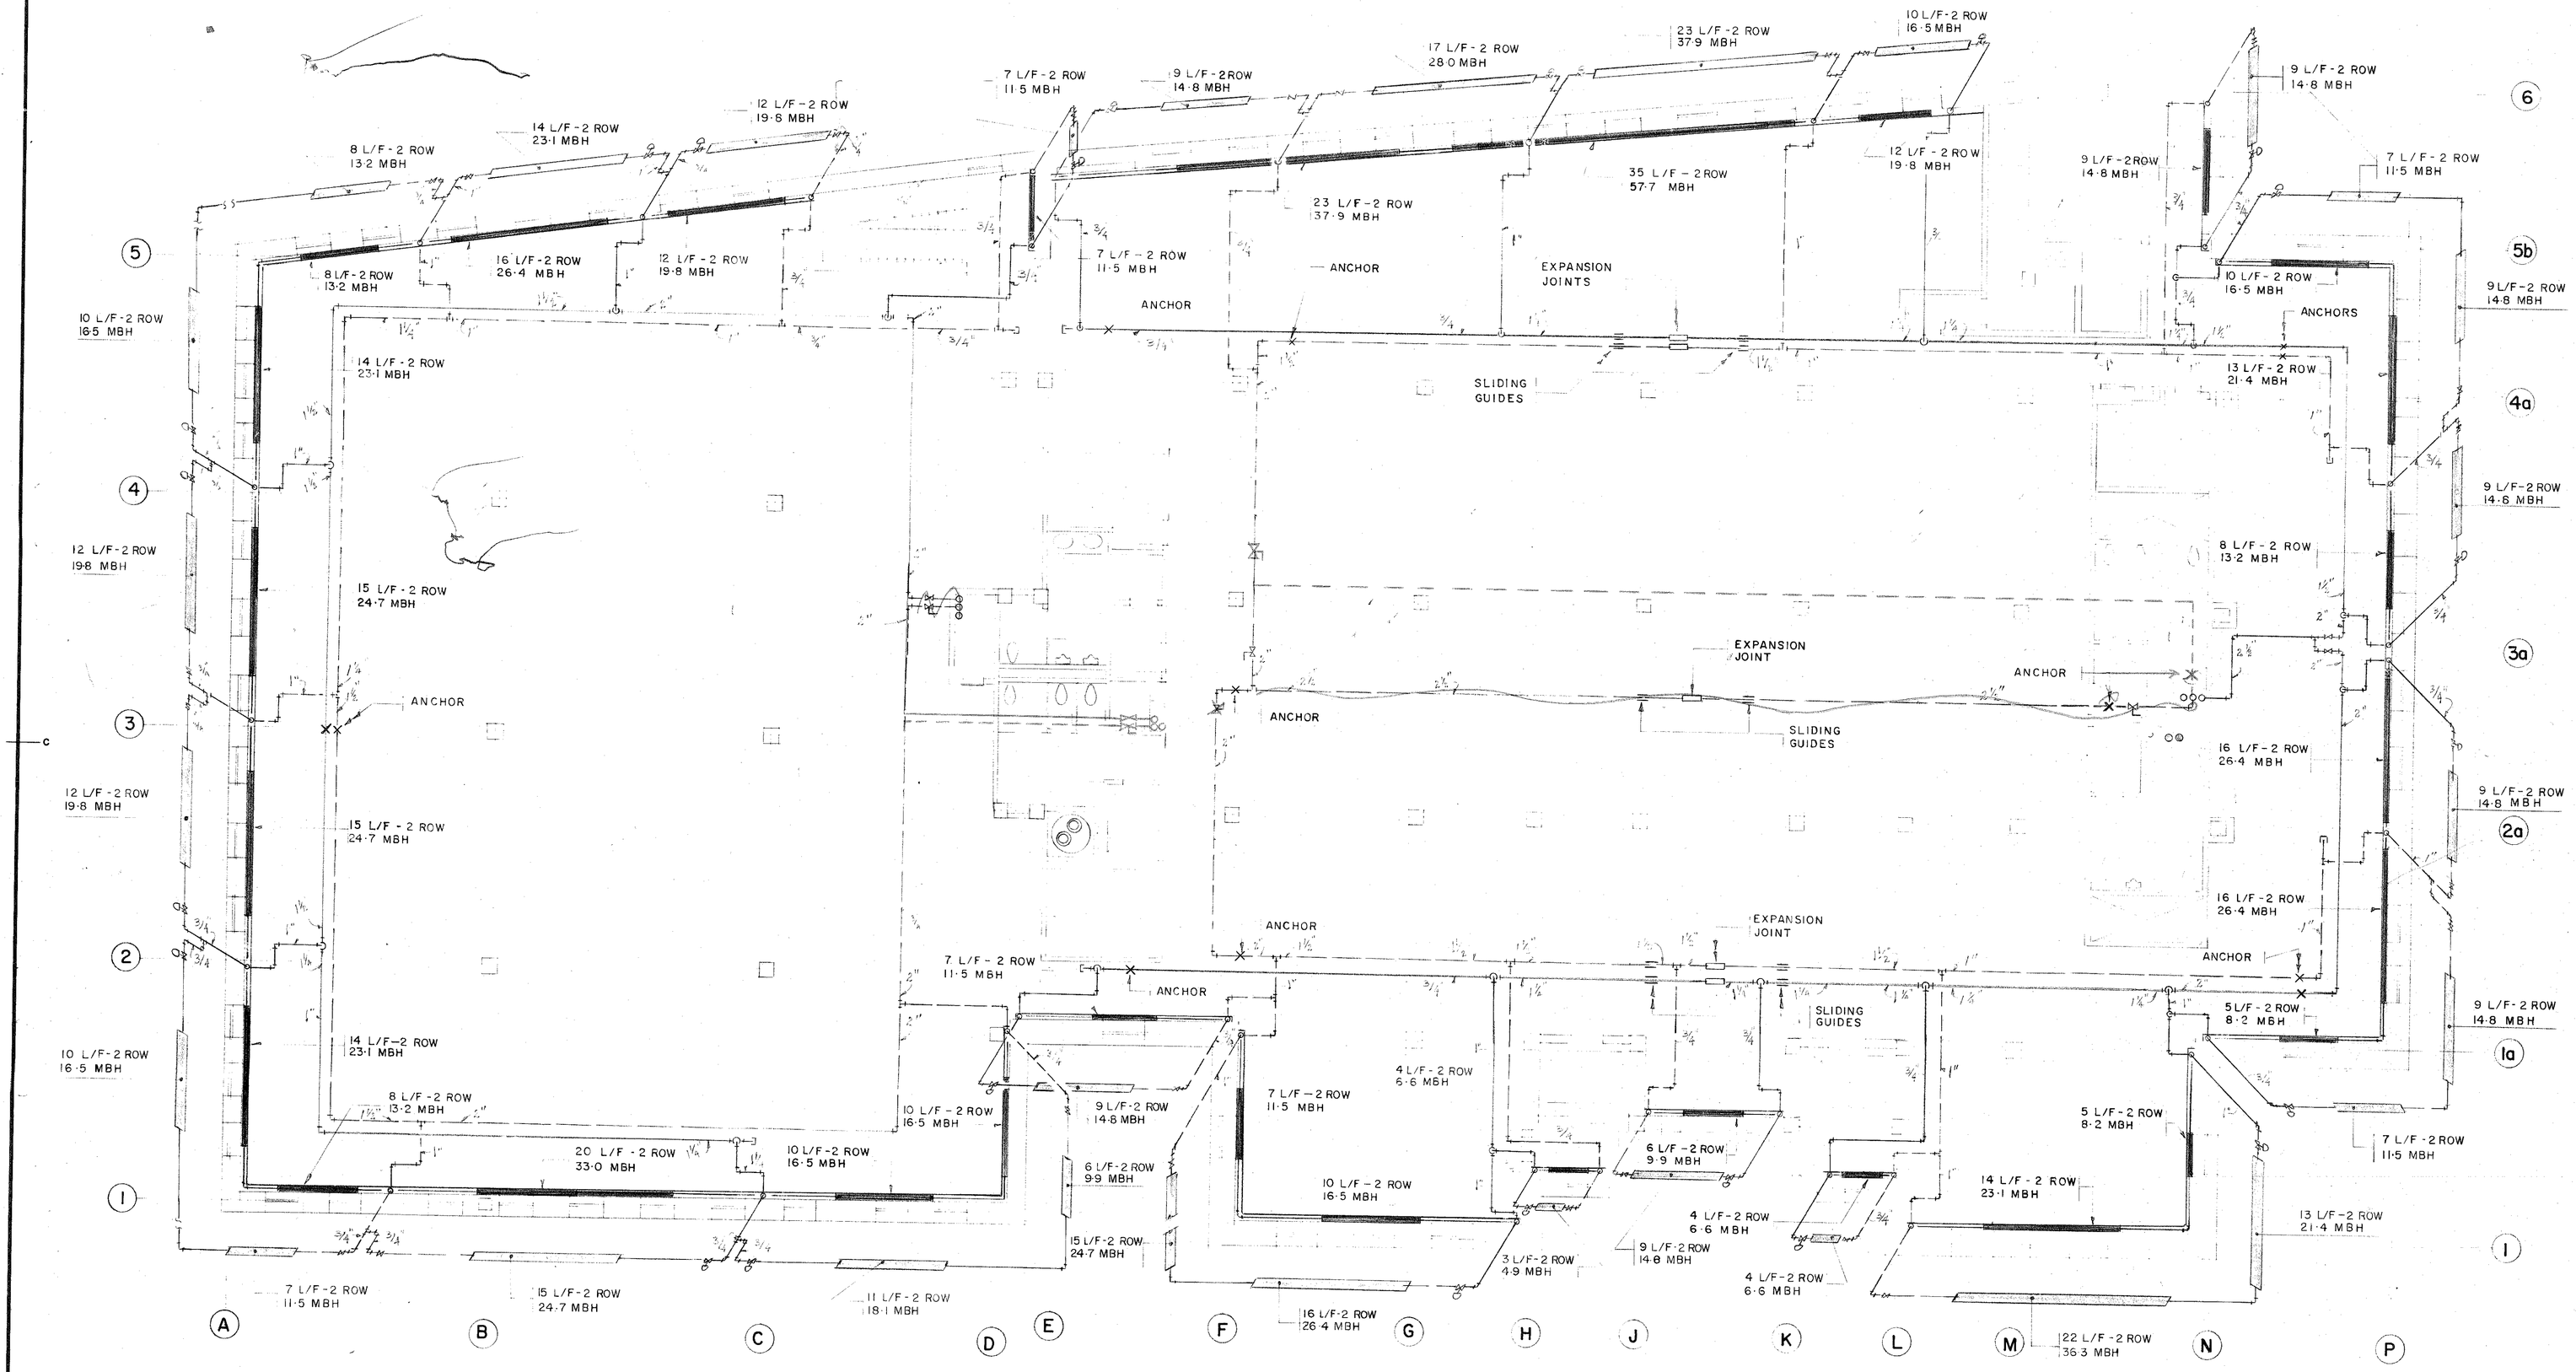

THIRD FLOOR PLAN

SCALE 1/8" = 1'-0"

WESTERN PLUMBING & HEATING LIMITED

92/03/4

AS BUILT DRAWING

Public Works Canada / Travaux publics Canada

revisions | date

A detail no. no. du détail
B location drawing no. sur dessin no.
C drawing no. dessin no.

project / projet
G.O.C.B.
BEDFORD ROW
HALIFAX, N.S.

drawing / dessin
THIRD FLOOR PLAN

HEATING

designed / conçu: P. DUMARESQ — date
drawn / dessiné: L. DEVEAU — date
reviewed / examiné — date 92/05/15
approved / approuvé — date
Tender / Soumission
PWC Project Manager / Administrateur de projets TPC
project number / no. du projet: 614362
drawing no. / no. du dessin: MH-5

PWC BI