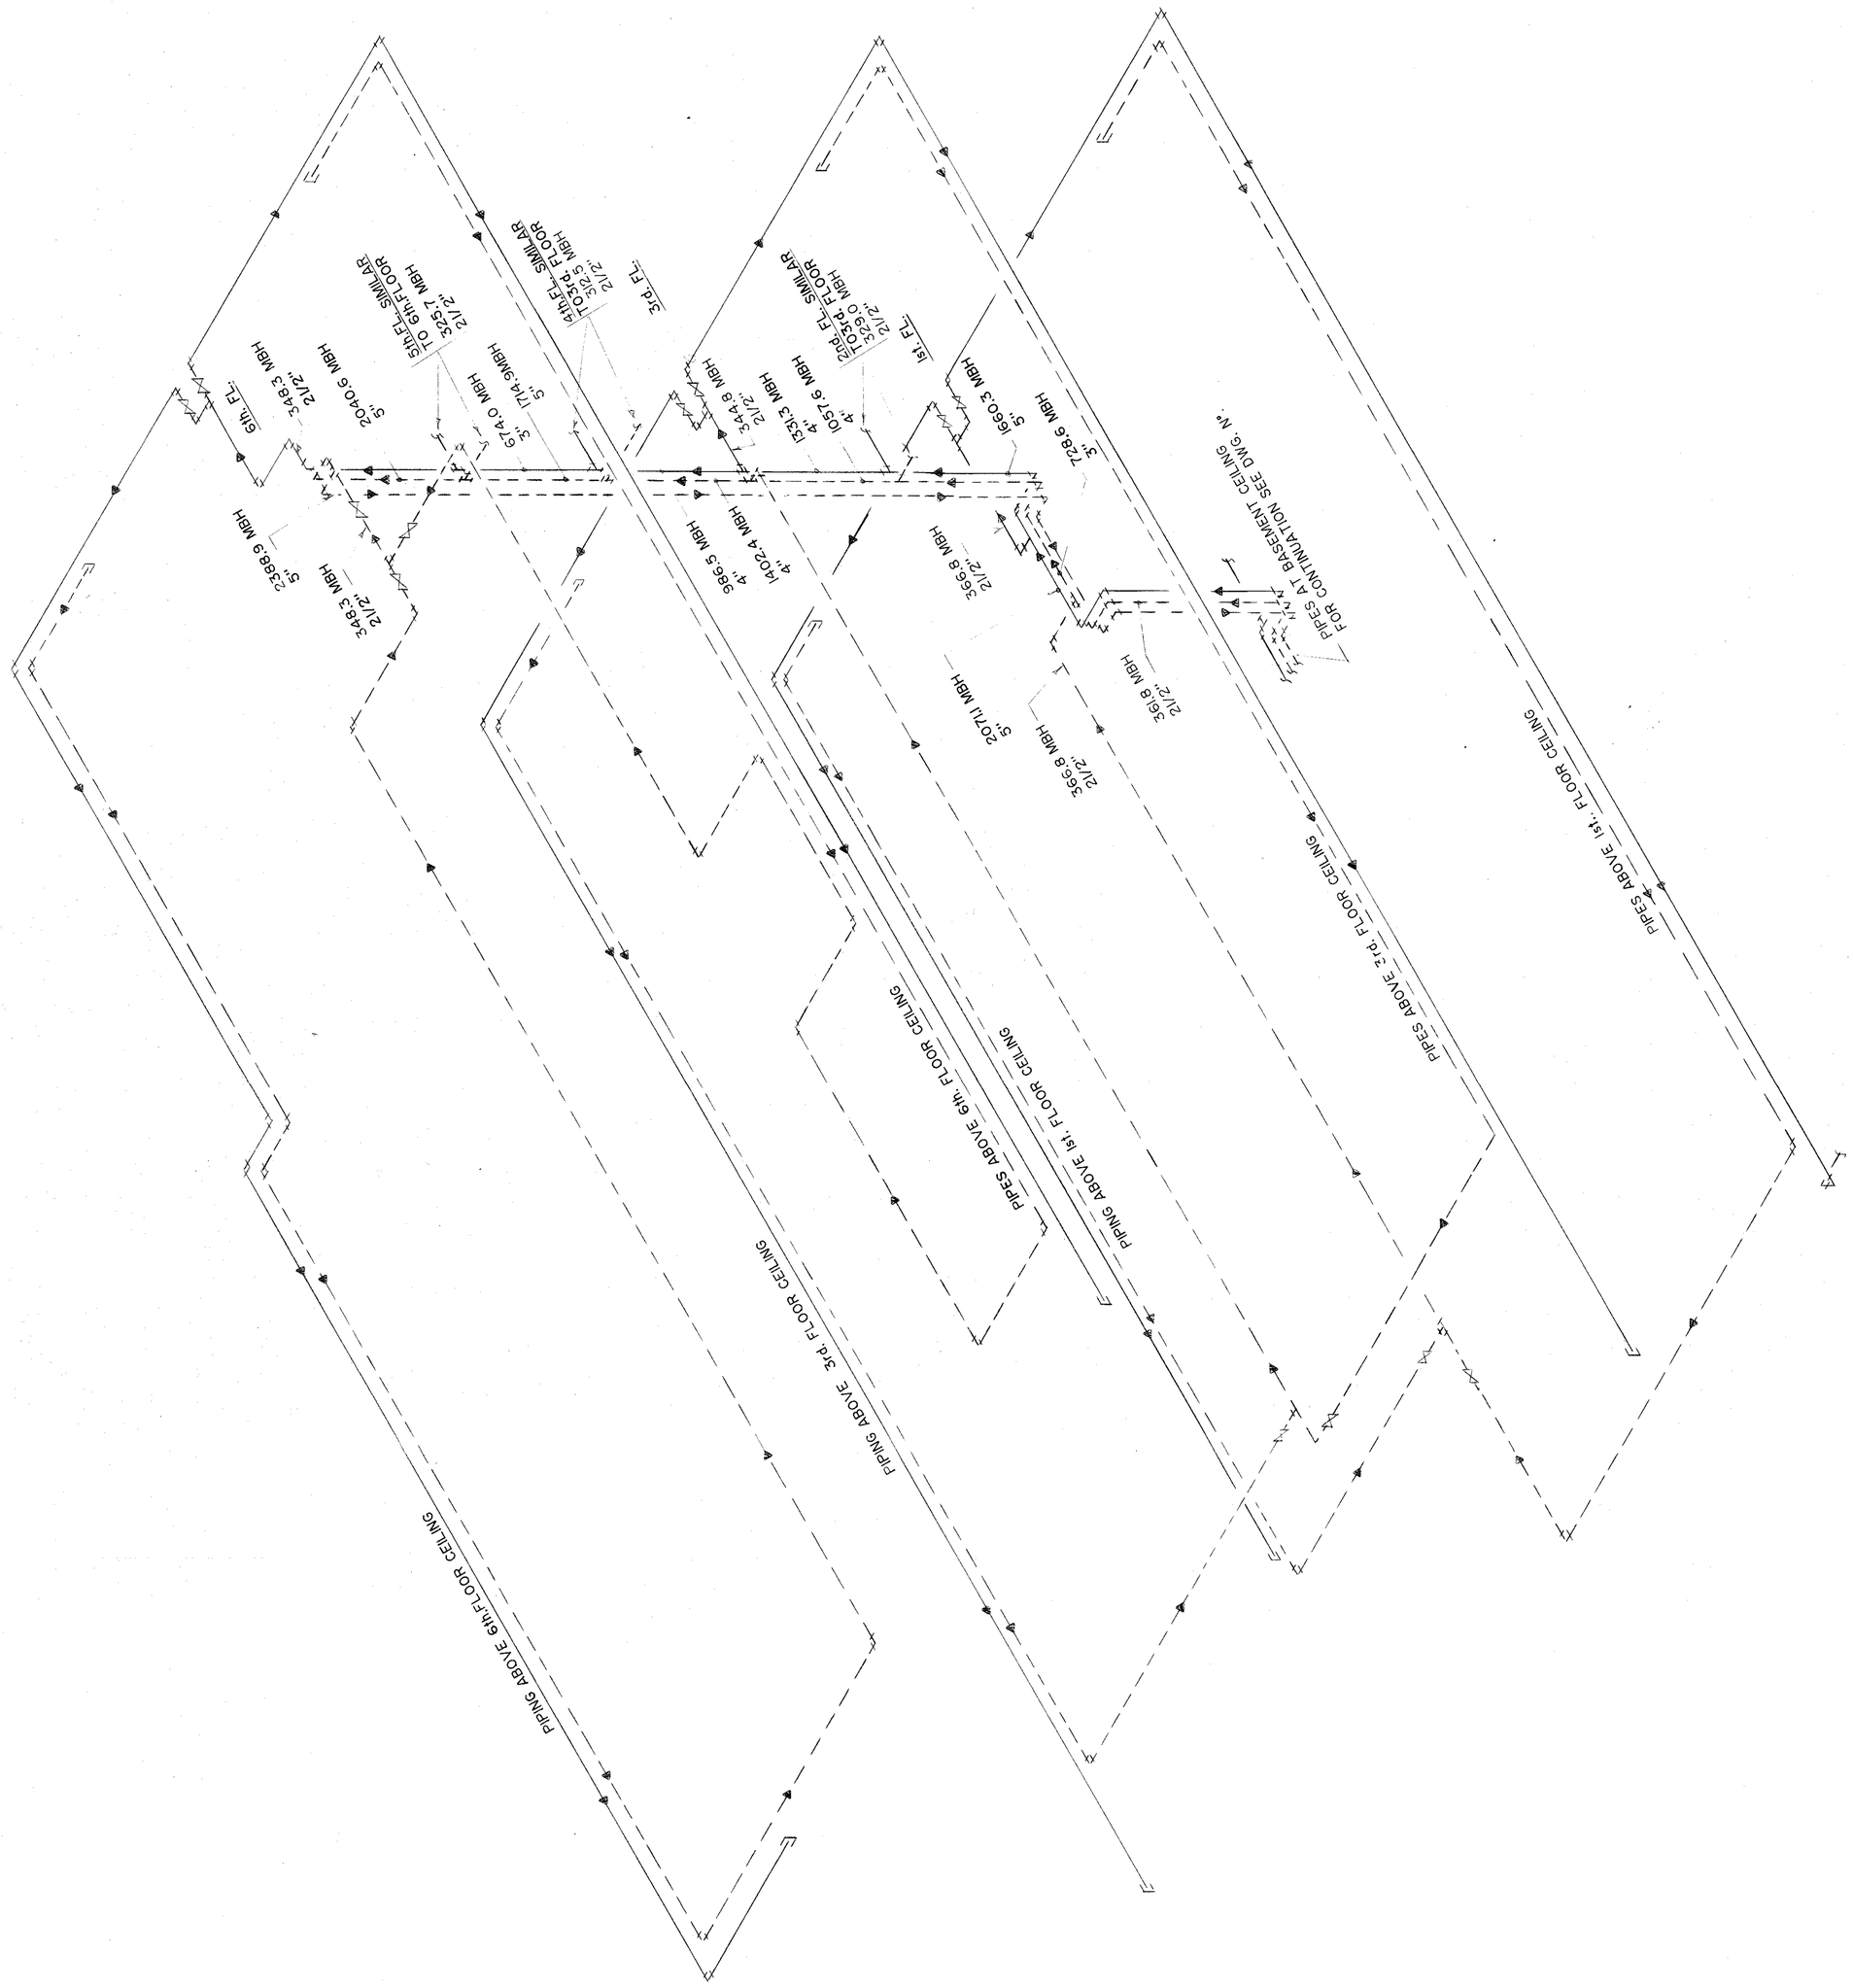

Public Works Canada / Travaux publics Canada

revisions		date

A detail no. / no. du détail
B location drawing no. / sur dessin no.
C drawing no. / dessin no.

project / projet
G.O.C.B.
BEDFORD ROW
HALIFAX, N.S.

drawing / dessin
TYPICAL DIAGRAMS FOR HEATING MAINS AND RISERS

designed / conçu: P. DUMARESQ
date
drawn / dessiné: T. CORBETT
date
reviewed / examiné: [illegible] 76/05/18
date
approved / approuvé
date
Tender / Soumission: [illegible]
PWC Project Manager / Administrateur de projets TPC
project number / no. du projet: 614362
drawing no. / no. du dessin: MH-18

PWC BI