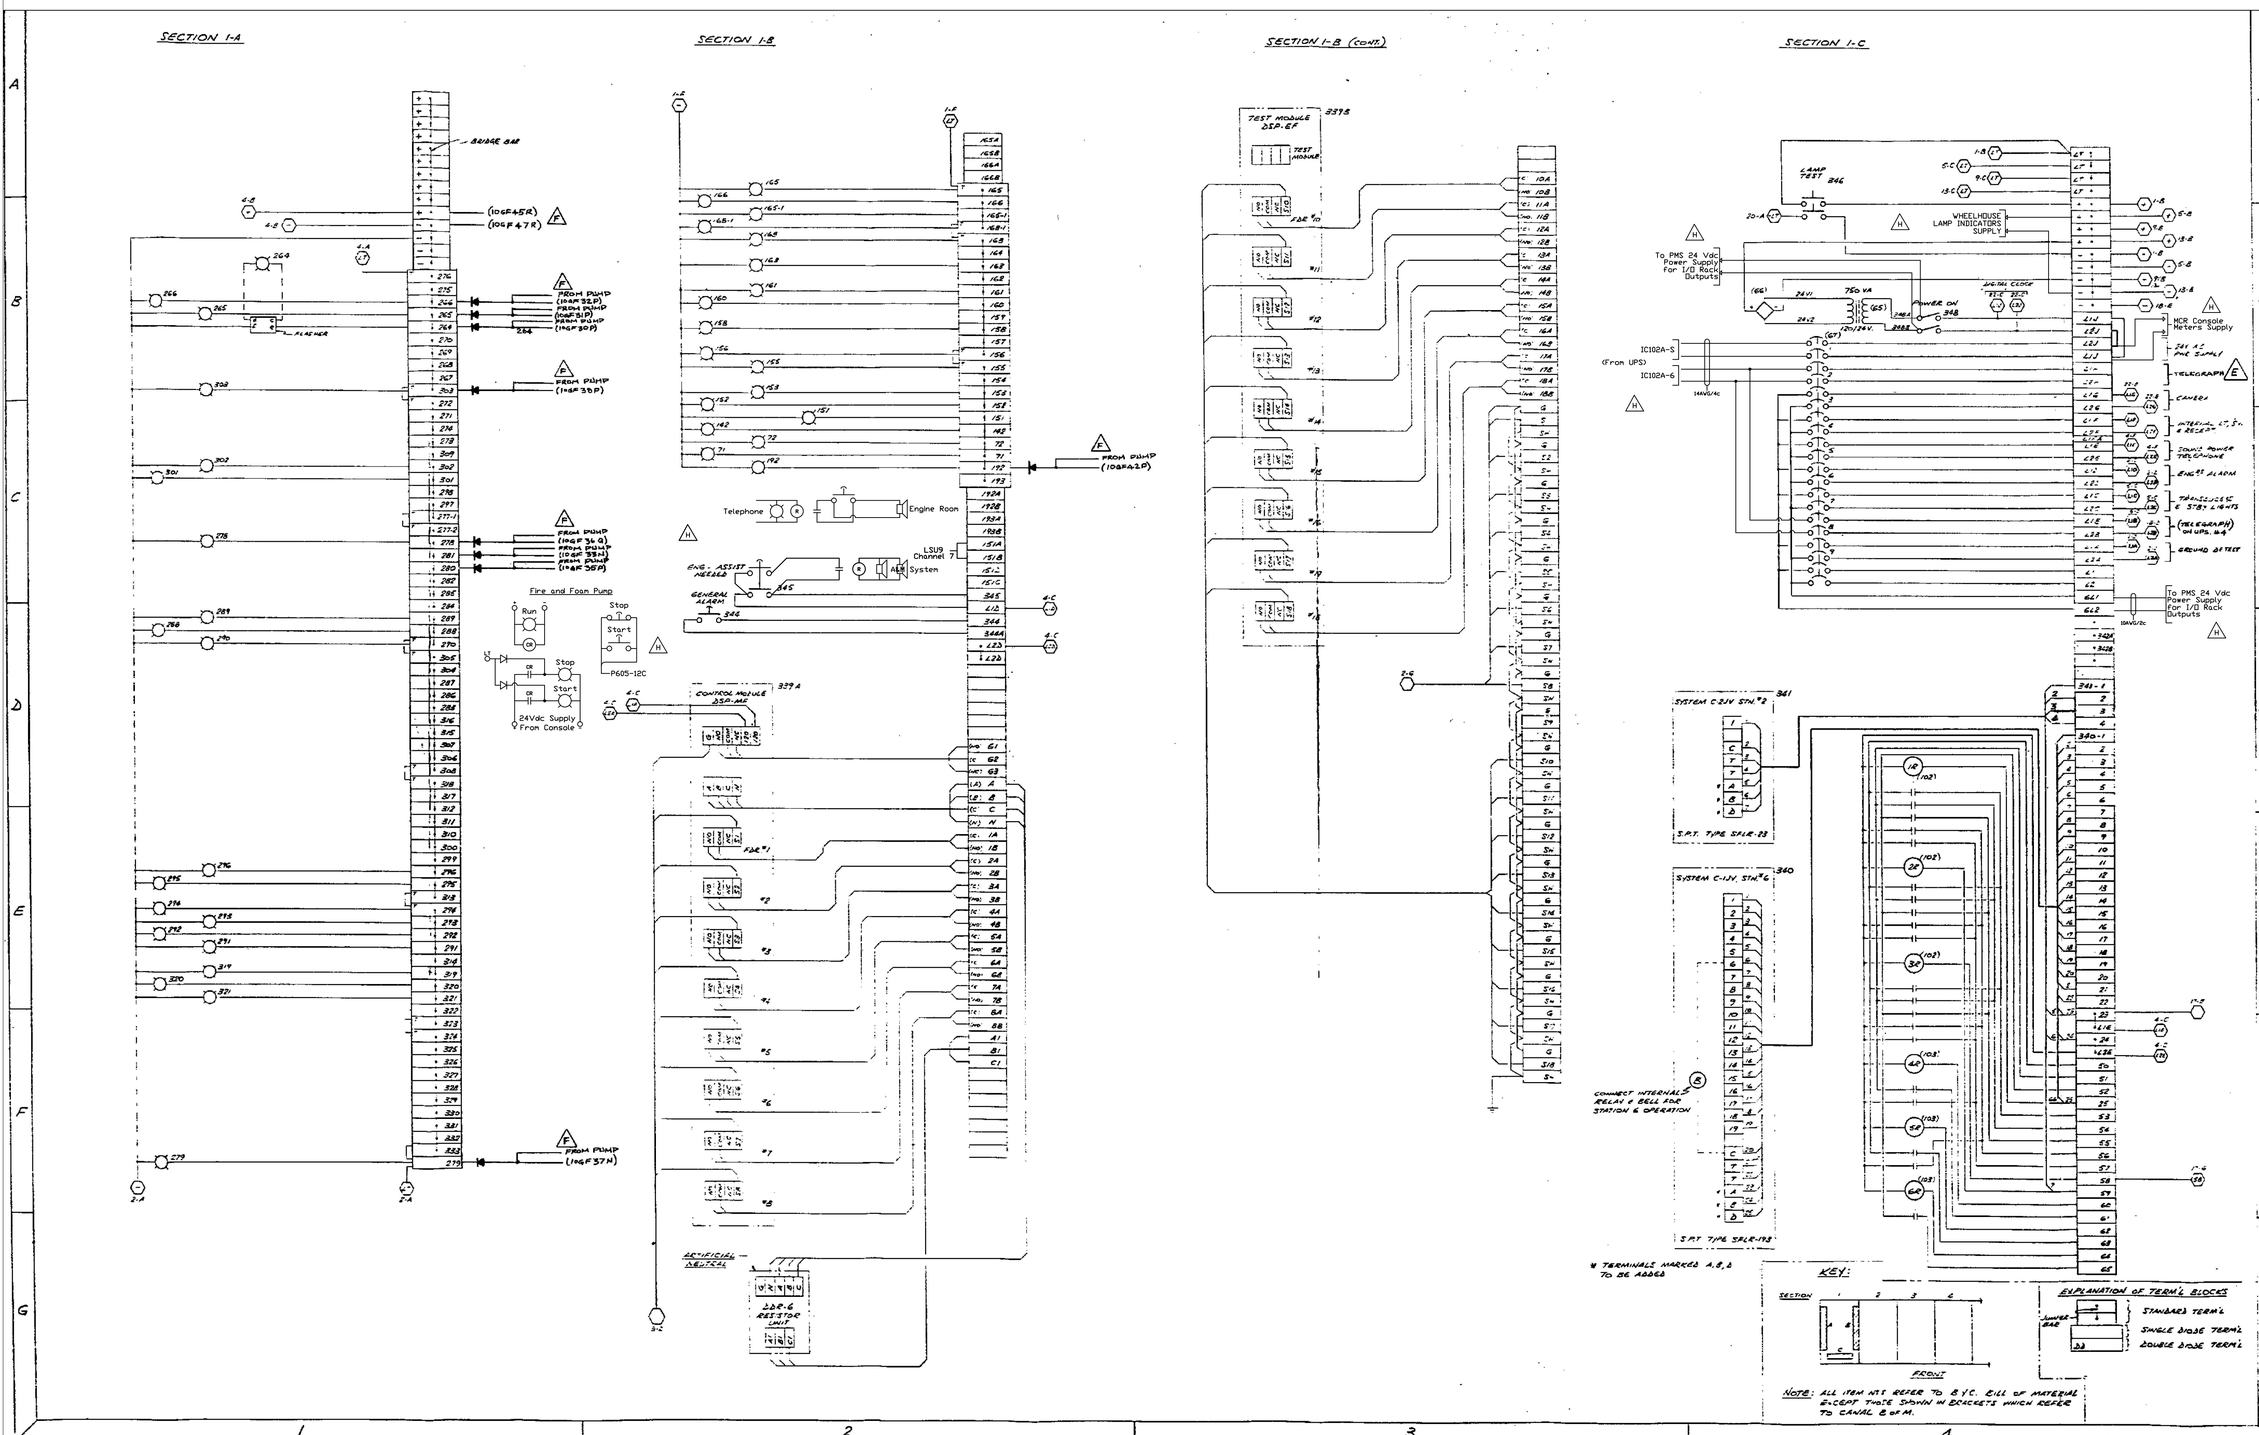

REFERENCES

No.	TITLE	DRG. No.

ALTERATIONS

REV	DESCRIPTION	DATE	APP
D	REVISED AS PER CUSTOMER TELEX DATED MAR 7 '85. ALTS 1 & 2	1985/03/28	JS
C	C.O.G. POWER MANAGEMENT SYSTEM REVISED C.O.G. POWER MANAGEMENT SYSTEM AS PER CUSTOMER LETTER DATED MAR. 15 '85	1985/04/15	JS
C	AS BUILT	1984/08/15	JS
2	CHANGED FROM PUSH-BUTTONS TO INDICATING LIGHTS. ITEMS 151, 152 & 153	1984/06/	JS
E	REVISED AS NOTED	79/11/06	H.R.
F	MODIFIED FOR DATA ACQUISITION SYST.	88/11/22	C.H.
G	TECHSOL MOSAIC MODIFICATION	08/03/25	H.B.
H	STARTUP NOTES UPDATE	08/07/04	H.B.

PRINT ISSUE

GROUP	REVISIONS D	A	A	S	C	2
CUSTOMER INSPECTION	6	3				
OFFICE	1					
SUPERINTENDENT						
FIELD	2					
TOTAL	9	3				
DATE OF ISSUE	85/02/28	85/04/26	85/05/15	85/06/17	85/07/18	85/08/16

APPROVALS

DRG. No. 54069-E-12 (SHT. 1 of 7) ALT. H

JOB: TYPE 1100 NAVAIGS TANKER/LIGHT ICEBREAKER

E.C.R. CONSOLE ELEMENTARY WIRING DIAGRAM (SECTION 1) PORT CONTROL ROOM

SCALE — JOB No. 54069

CUSTOMER: COLLINGWOOD SHIPYARDS

DRAWN BY: J. SCOBELLARO DATE: 5TH FEB 85

CHECKED BY: APPROVED BY:

canal

ELECTRICAL & MECHANICAL CONTRACTORS
A DIVISION OF UPPER LAKES SHIPPING LTD.
ST. CATHARINES, ONTARIO L2M 6T4
HAMILTON, ONTARIO L8E 3N9

DRG No. 54069-E-12 (SHT 1 of 7)

54069-E-12 (1 of 7)