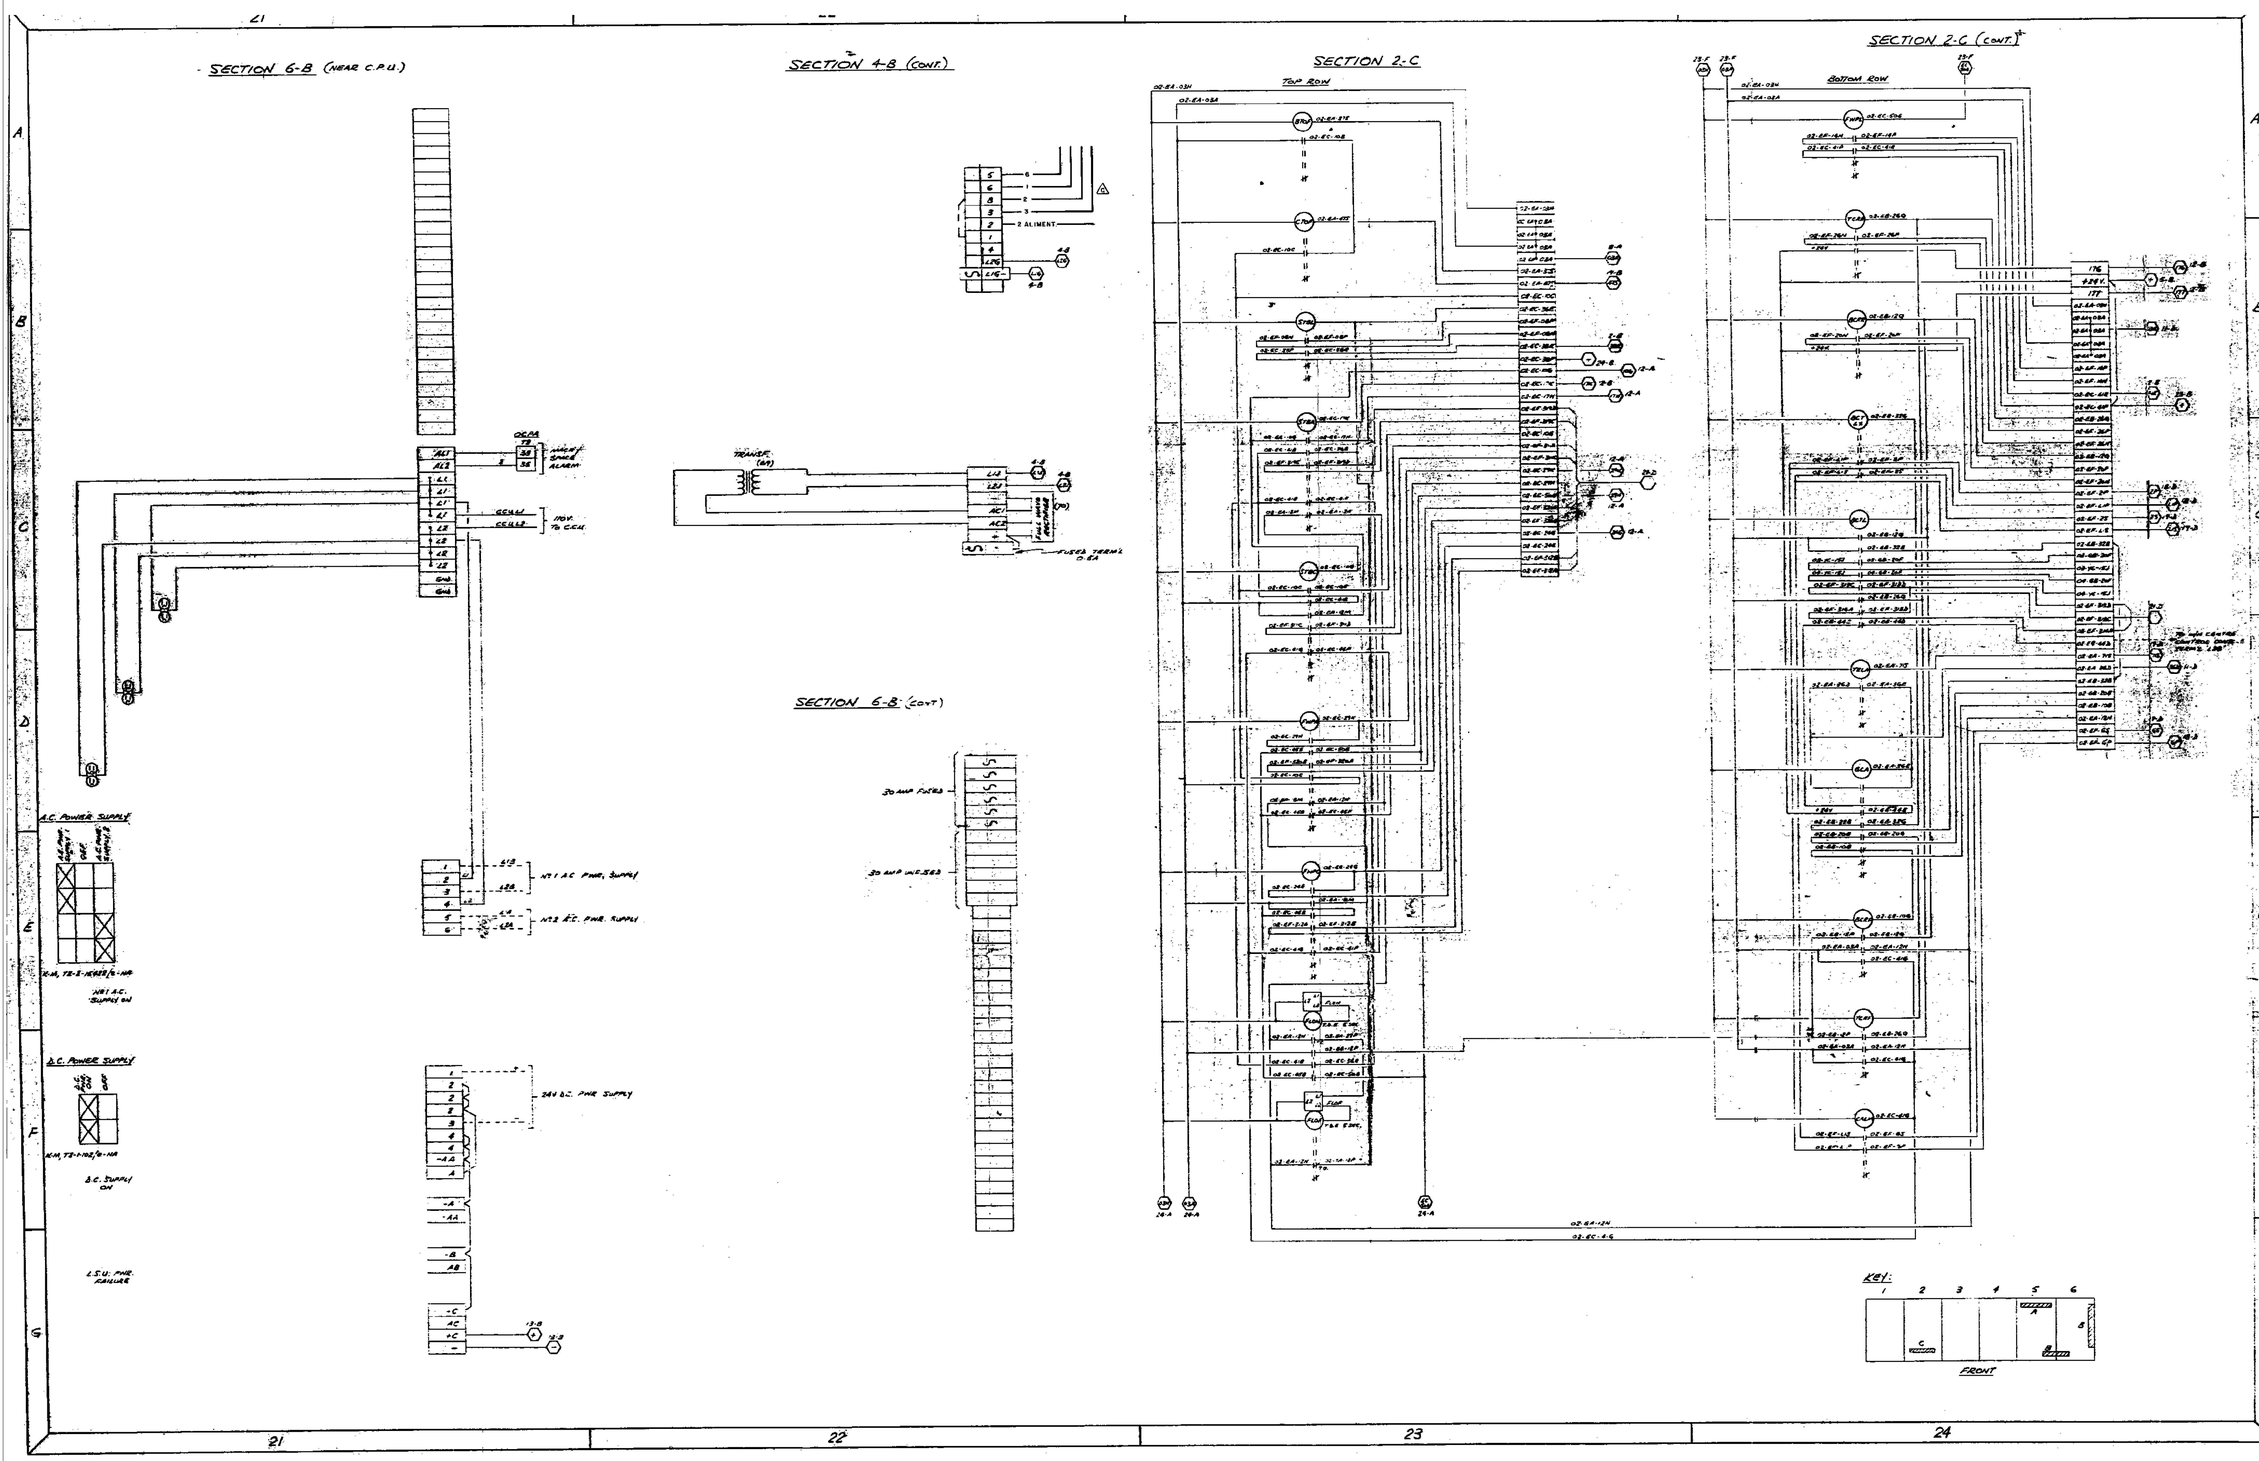

REFERENCES

No.	TITLE	DRG. No.

ALTERATIONS

REV.	DESCRIPTION	DATE	APP.
A	REVISE SOLID WIRING AND FLASH SECTION		
B	AS BUILT	87/8/26	JS
C	REVISED AS NOTED	90/5/11	W.R.
D	TECHSOL MOSAIC MODIFICATION	08/03/25	H.B.

PRINT ISSUE

GROUP	01	A	B	C
REVISIONS				
CUSTOMER INSPECTION				
OFFICE				
S.E. SUPERINTENDENT				
FIELD				
TOTAL				
DATE OF ISSUE				

APPROVALS

DRG. No. 54069-E-12 (SHT. 6 OF 7) ALT. D

JOB: PE 100 HARRIS TRUNDER/LIGHT CONSOLE

E.C.R. CONSOLE ELEMENTARY WIRING DIAGRAM (SECCA + 2C SECTIONS)

SCALE: → JOB No: 54069

CUSTOMER: COLLINGWOOD SHIPYARDS

DRAWN BY: J. STOBELLARO DATE: 15TH FEB 85

CHECKED BY: APPROVED BY: 6/7

canal

ELECTRICAL & MECHANICAL CONTRACTORS
A DIVISION OF UPPER LAKES SHIPPING LTD.
ST. CATHARINES, ONTARIO L2M 6T4
HAMILTON, ONTARIO L8E 3N9

54069-E-12 (6 of 7)

6/7