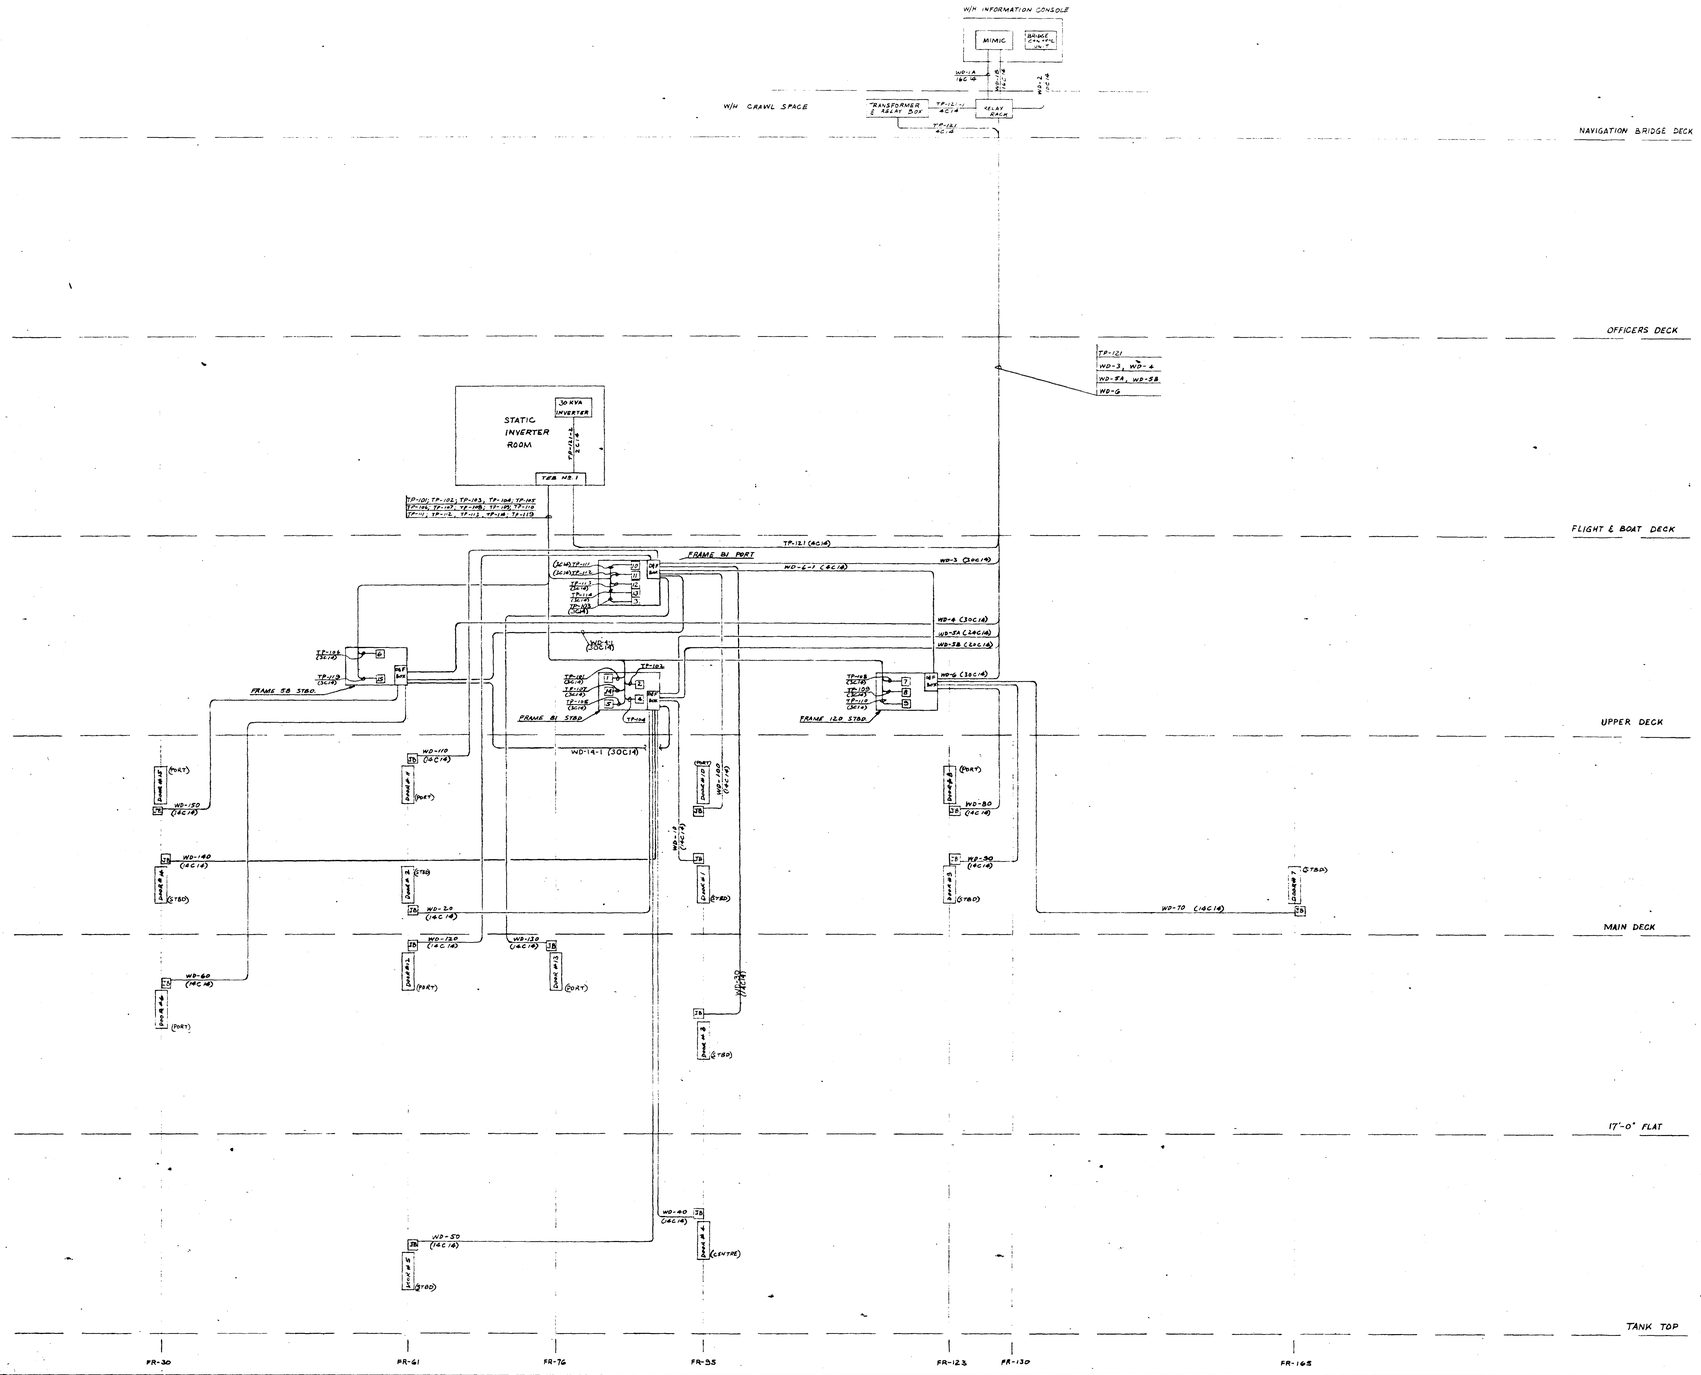

REFERENCES

No.	TITLE	DRG. No.
1	ELEC. PWR. SINGLE LINE DIA. EMER. SECT.	68-E-1 SHT 3
2	WT DOOR SYSTEM BLOCK & CONNECTION DIAGRAM	68-E-11 SHT 1
3	15 WT. DOORS, SERIES II UNIT SYSTEM CONTROLS ELEC. SCHEMATIC DIA.	CD27864 SHTS. 1 & 2
4	15 WT. DOORS, SERIES II UNIT SYSTEM CONTROLS ELEC. INTERCONNECTION DIA.	CD27865

ALTERATIONS

REV.	DESCRIPTION	DATE	APP.
A	REMOVED CABLES WD-13/23/33/43/53&B5. ADDED WD-75/85/95/105/125/135/145 & 155; ADDED CABLES WD-4, WD-5A, WD-5B & WD-6 ADDED SHEET 3	12/4/82	C.A.
B	RELOCATED HYDRAULIC UNIT NO 3 AND NO 4 RE-ROUTED WD-30 & WD-140, TP-107 AND TP-103 ADDED WD4-1	28/82	GW
C	AS BUILT	23/82	G.W.

PRINT ISSUE

GROUP	REVISIONS															
	0	0	0	0	A	B	B									
CUSTOMER			5	5												
INSPECTION																
OFFICE	1					1	1									
SUPERINTENDENT																
FIELD			2	3	3	1										
D.S.S.	3															
TOTAL	4	1	5	2	4	4	1									
DATE OF ISSUE	14/9/81	21/9/81	13/10/81	27/10/81	23/11/81	12/4/82										

APPROVALS

D.S.S.	M.O.T.				
14-9-81	10-11-81				

DRG. No. 68-E-11 SHEET 2 OF 3 ALT. B

JOB HULL "68 R" CLASS ICEBREAKER
WATERTIGHT DOOR SYSTEM
BLOCK DIAGRAM

SCALE: NONE JOB No: 2023

CUSTOMER
PORT WELLER DRY DOCKS

DRAWN BY: L. ABBOTT DATE: 4 SEPT 81

CHECKED BY: F. SUN APPROVED BY:

canal
ELECTRICAL & MECHANICAL CONTRACTORS
A DIVISION OF UPPER LAKES SHIPPING LTD.
ST. CATHARINES, ONTARIO L2M 6T4
HAMILTON, ONTARIO L8E 3N9

DRG No. 68-E-11 SHT 2 OF 3