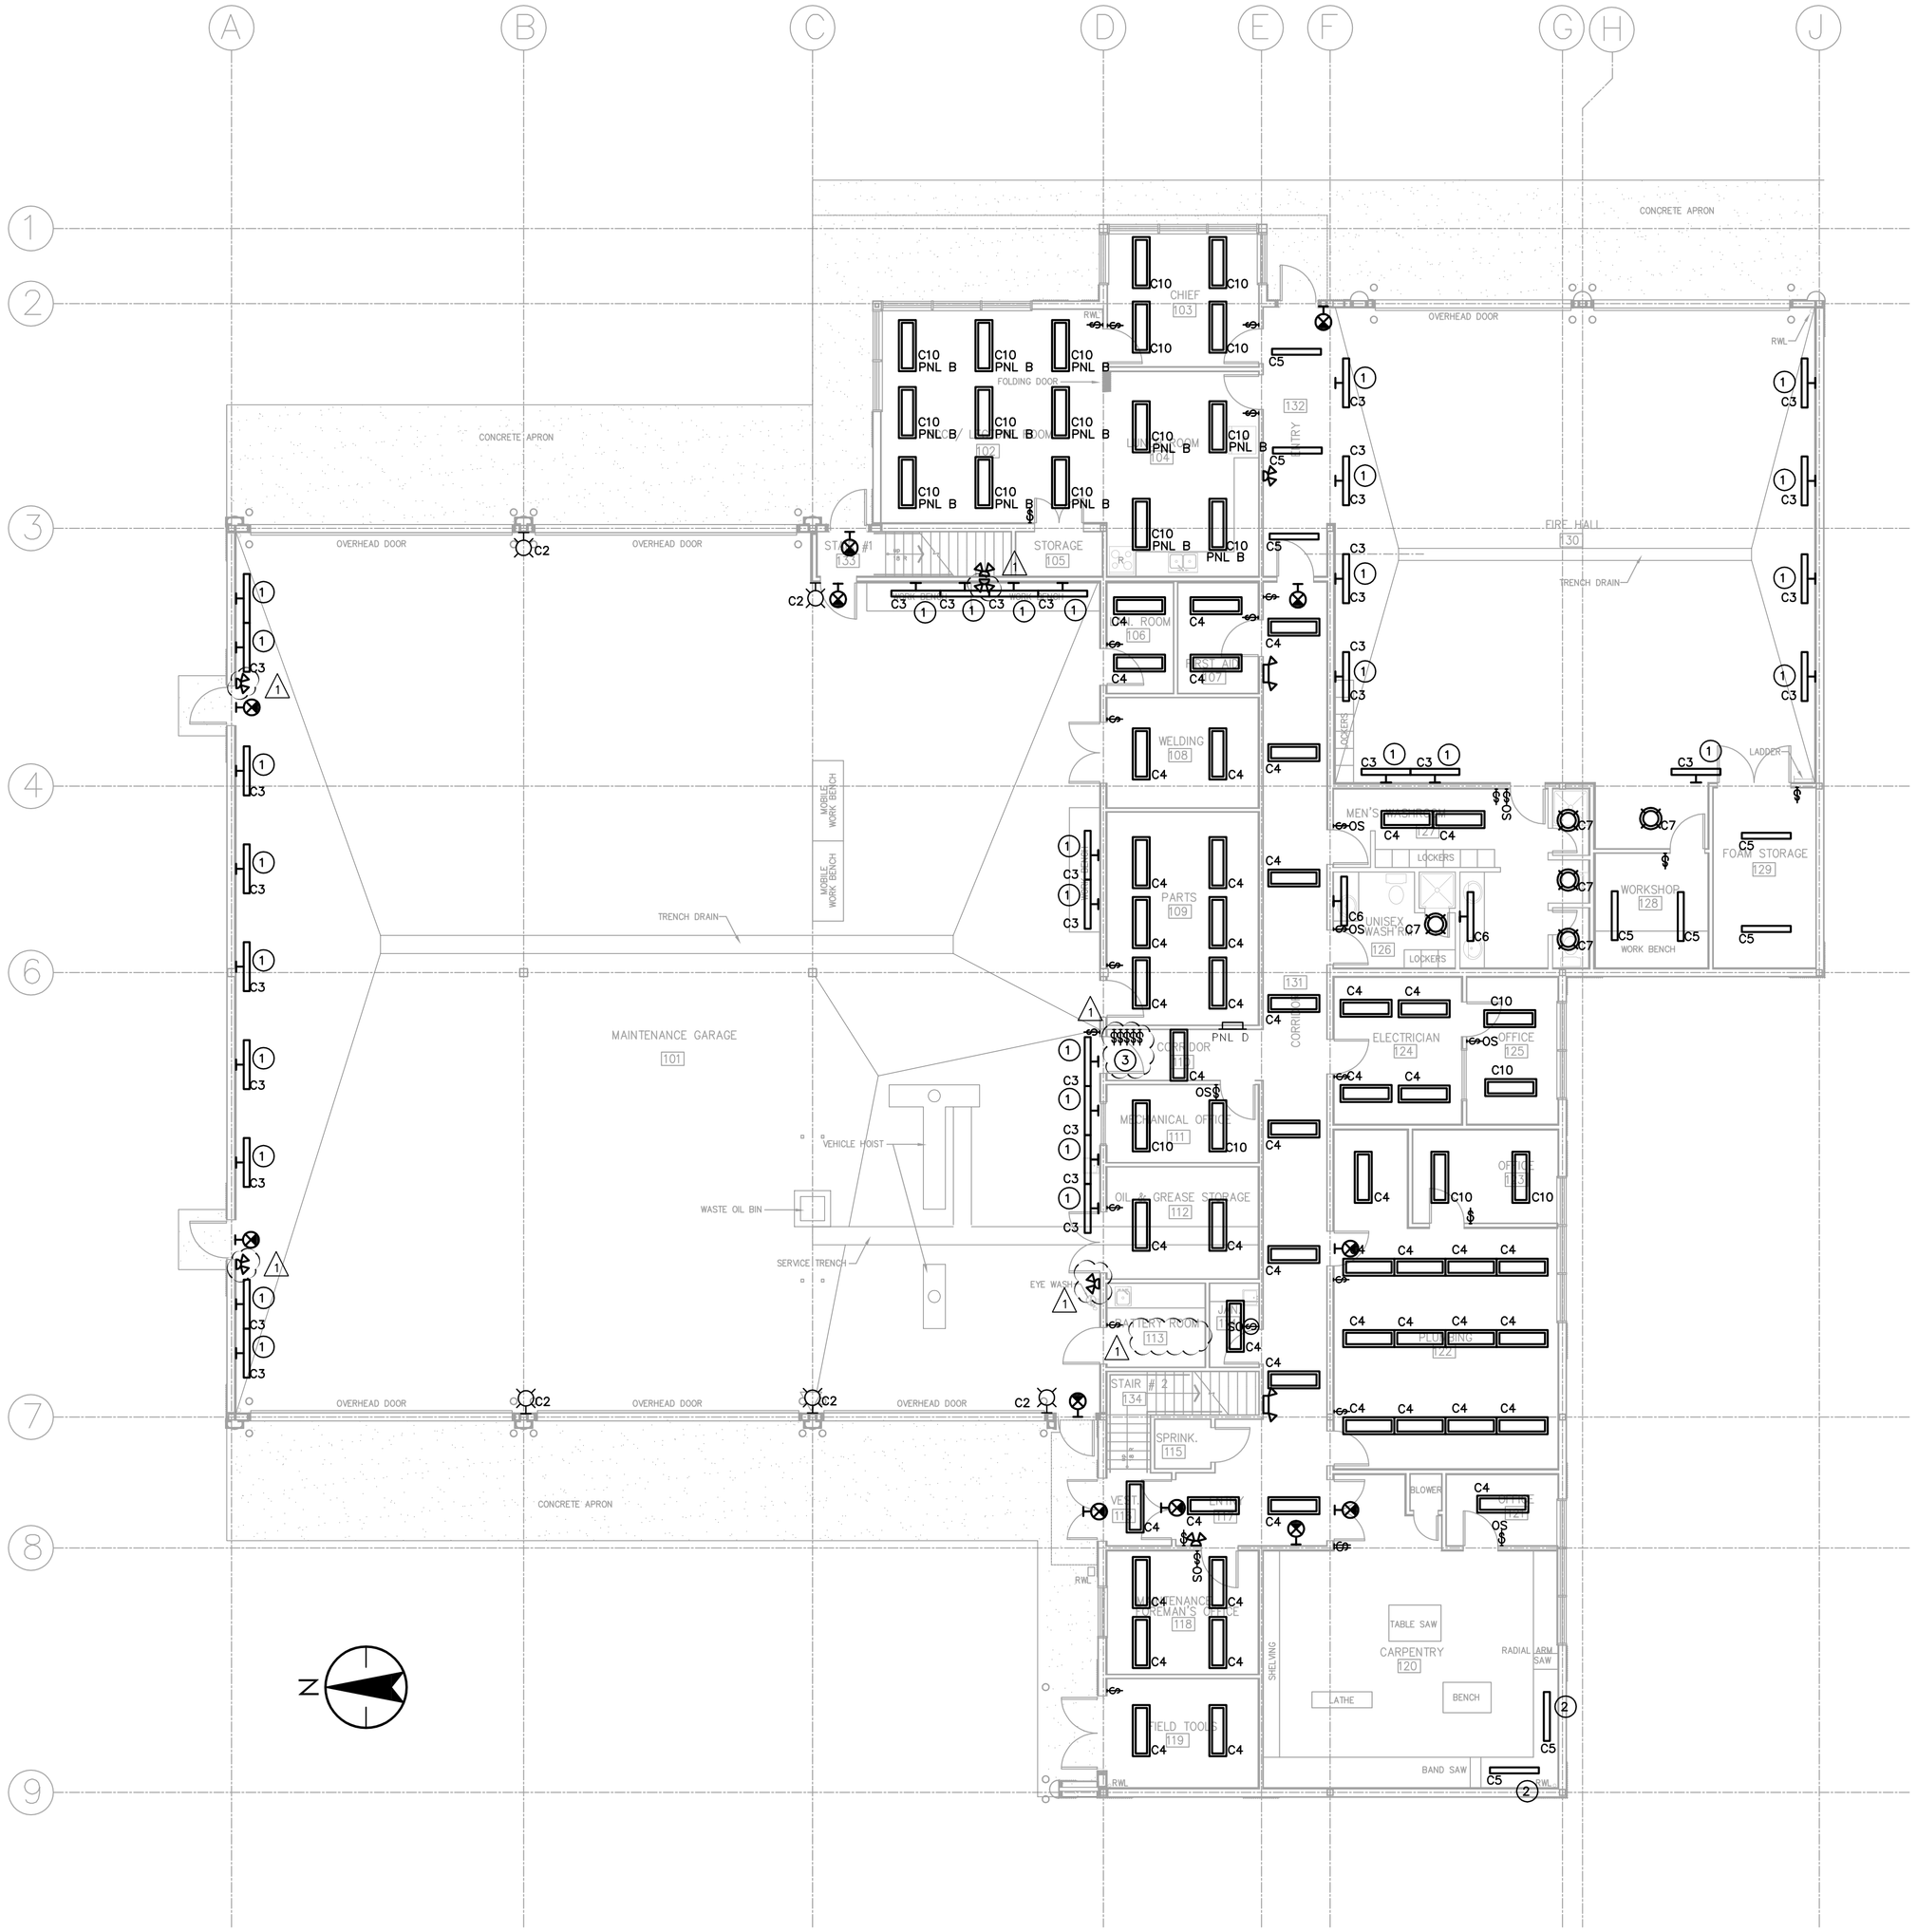

GENERAL NOTES – LIGHTING RENOVATION – CSB

1. UNLESS OTHERWISE NOTED, ALL LUMINAIRES SHOWN ARE TO BE REMOVED. EXISTING WIRING, BACK BOX, HARDWARE ETC. ARE TO BE RETAINED FOR RE-USE WITH NEW LUMINAIRES AS INDICATED ON RENOVATION PLAN.
2. ALL EXISTING EXTERIOR LED SOFFIT LIGHTING TO REMAIN.
3. EMERGENCY LIGHTING BATTERY PACKS – ELECTRICAL CONTRACTOR TO SUPPLY AND INSTALL NEW BATTERY PACK/DUAL HEAD EMERGENCY LIGHTING TO REPLACE EXISTING NON-FUNCTIONAL EQUIPMENT AS DISCOVERED DURING RENOVATION. ALLOW FOR 4, 320W, 24VDC STEEL BATTERY UNITS FOR THE CSB.
4. ALL EXISTING SWITCHES TO BE REPLACED WITH NEW DECORA STYLE SWITCHES AND PIR/ULTRASONIC DUAL TECHNOLOGY ON/OFF/AUTO OCCUPANCY SENSOR SWITCHES AS INDICATED. REFER TO PROJECT GENERAL NOTES ON DRAWING E000 FOR DETAIL ON SPARE SWITCHES.
5. ALL EXIT SIGNS TO BE REPLACED WITH NEW. PROVIDE PLASTIC PICTOGRAM EXIT SIGNS.
6. REFER TO PANEL SCHEDULES ON DRAWING E501 FOR EXISTING LIGHTING CIRCUITS. EXISTING LABELING DOES NOT INDICATE WHICH FIXTURES ARE ON WHICH CIRCUITS AND AS SUCH CIRCUITS ARE NOT SHOWN ON DRAWING. CONTRACTOR TO DETERMINE EXISTING CIRCUIT FOR ALL EXISTING LUMINAIRES BEING REPLACED, RE-USE CIRCUITS FOR NEW LUMINAIRES AND RECORD CIRCUIT NUMBERS ON AS-BUILT DRAWINGS. UPDATE PANEL SCHEDULE WITH DESCRIPTIVE LABELS INCLUDING ROOM NAME AND NUMBER.

KEY NOTES – LIGHTING DEMOLITION – CSB

1. NEW WALL MOUNTED LUMINAIRES IN EXISTING LOCATION. LUMINAIRES ARE TO BE DIRECTLY MOUNTED ON WALL WITH SPACING BRACKETS (APPROX 5") TO CLEAR EXISTING SERVICES MOUNTED ON WALL, AS REQUIRED.
2. NEW LED STRIP LIGHTS MOUNTED UNDER CABINETS.
3. ELECTRICAL CONTRACTOR TO CONFIRM OPTIMAL SWITCH ORDER WITH BUILDING USERS AND RECONFIGURE ARRANGEMENT AS REQUIRED, LABEL SWITCHES.

Public Works and Government Services Canada / Travaux publics et Services gouvernementaux Canada

REAL PROPERTY SERVICES
Pacific Region
SERVICES IMMOBILIERS
Région de Pacifique

Stantec

SEAL:

Revision/ Revision	Description/Description	Date/Date
1	ISSUED FOR ADDENDUM 1	2018/12/04
0	ISSUED FOR TENDER	2018/06/27

Client/client

TRANSPORT CANADA

Project title/Titre du projet

SANDSPIT, B.C.

TRANSPORT CANADA
SANDSPIT AIRPORT

LIGHTING UPGRADE

Consultant Signature Only

Designed by/Concept par
JD

Drawn by/Dessine par
JD

PWGSC Project Manager/Administrateur de Projets TPSGC
NEDA NADERI

Regional Manager, Architectural and Engineering Services
Gestionnaire régionale, Services d'architectural et de génie, TPSGC
MARK BURGER

Drawing title/Titre du dessin

COMBINED SERVICES BUILDING
MAIN FLOOR PLAN
LIGHTING RENOVATION

Project No./No. du projet	Sheet/Feuille	Revision no./ La Révision no.
R.089425.001	E302 10 OF 18	1