

(SEE SHEET 2 OF 14)
MATCHLINE



GLOSSARY

CSE	- CONFINED SPACE ENTRY
SAN	- SANITARY
STM	- STORM
INV	- INVERT
OBV	- OBVERT
BOC	- BOTTOM OF CHAMBER
EORI	- END OF RECORD INFORMATION
AATUR	- UTILITY ABANDONED ACCORDING TO UTILITY RECORDS
EOI	- END OF SURFACE GEOPHYSICAL INFORMATION
T/G	- TOP OF GRATE ELEVATION

NOTES

- This information is provided for design purposes only.
- All inverts shown on this plan by multiVIEW Locates Inc. are in meters and were measured from the top of the manhole and/or catch basin lids.
- Subsurface utility information shown on this drawing was obtained on a best effort, best practices basis, within the technical limitations of the instrumentation.
- Utilities shown on this map by multiVIEW Locates Inc. were located using ASCE 38-02 Quality Level 'B' methods unless otherwise noted. All other information hereon has been supplied by others and is not certified.
- Third party information provided on these drawings are for the convenience of use but do not constitute information obtained and delivered by multiVIEW Locates Inc. during the course of this project.
- Elevations represented for this study were obtained by multiVIEW Locates Inc. utilizing datum derived by differential GPS observations and referred to the CAN-NET Reference Network.

UTILITY CODES

- H - - - - - Hydro Cable
- - - - - Utility Depth

ALL UTILITIES ARE UNDERGROUND UNLESS OTHERWISE SPECIFIED

SHEET 1 of 14

Rev. No.	Drawn By	Checked By	Date	Revision

Data presented herein is subject to multiVIEW's terms and conditions as listed on the final page of the contract drawings.



Project No.:	Date:	Drawn/Checked By:	Appr:
40410	2018-07-23	RF/JH	-
For: PARKS CANADA INFRASTRUCTURE			

THE LOCATION OF UNDERGROUND SERVICES SHOULD BE VERIFIED PRIOR TO EXCAVATION. UTILITY LOCATES ARE REQUIRED PRIOR TO ANY EXCAVATION ACTIVITY.

SUBSURFACE UTILITY ENGINEERING
HYDRO EXCAVATION & CCTV
CONCRETE SCANNING
UTILITY LOCATES
NEAR-SURFACE GEOPHYSICS


Tel: 1-800-363-3116
Fax: 1-905-571-5946
www.multiVIEW.ca
325 Matheson Blvd East
Mississauga, ON, L4Z1X8

Site: CI/ASCE 38-02 LEVEL 'B' SUE INVESTIGATION
RIDEAU CANAL, OTTAWA, ON

Subsurface Utility Engineering CI/ASCE 38-02 Quality Levels

- QL'A: Visual verification of utility location and depth using excavation methods. i.e. Hydrovac.
- QL'B: Utility located using surface geophysical methods i.e. electronically applied or induced magnetic field using specific utility locate equipment or ground penetrating radar.
- QL'C: Utility plotted using record information in conjunction with a visual field survey of utility furniture.
- QL'D: Utility plotted using record information only. This can include oral recollection.

(SEE SHEET 3 OF 14)
MATCHLINE

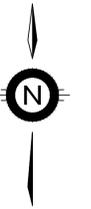

MATCHLINE
(SEE SHEET 1 OF 14)



GLOSSARY

CSE	-	CONFINED SPACE ENTRY
SAN	-	SANITARY
STM	-	STORM
INV	-	INVERT
OBV	-	OBVERT
BOC	-	BOTTOM OF CHAMBER
EORI	-	END OF RECORD INFORMATION
AATUR	-	UTILITY ABANDONED ACCORDING TO UTILITY RECORDS
EOI	-	END OF SURFACE GEOPHYSICAL INFORMATION
T/G	-	TOP OF GRATE ELEVATION

Data presented herein is subject to multiVIEW's terms and conditions as listed on the final page of the contract drawings.

SUBSURFACE UTILITY ENGINEERING
 HYDRO EXCAVATION & CCTV
 CONCRETE SCANNING
 UTILITY LOCATES
 NEAR-SURFACE GEOPHYSICS

Tel: 1-800-363-3116
 Fax: 1-906-571-5946
 www.multiVIEW.ca
 325 Matheson Blvd East
 Mississauga, ON, L4Z1X8

Project No.:	Date:	Drawn/Checked By:	Appr:
40410	2018-07-23	RF/JH	-
For: PARKS CANADA INFRASTRUCTURE			
Site: CI/ASCE 38-02 LEVEL 'B' SUE INVESTIGATION RIDEAU CANAL, OTTAWA, ON			

Subsurface Utility Engineering CI/ASCE 38-02 Quality Levels

QL'A: Visual verification of utility location and depth using excavation methods. i.e. Hydrovac.
 QL'B: Utility located using surface geophysical methods i.e. electronically applied or induced magnetic field using specific utility locate equipment or ground penetrating radar.
 QL'C: Utility plotted using record information in conjunction with a visual field survey of utility furniture.
 QL'D: Utility plotted using record information only. This can include oral recollection.

- NOTES**
- This information is provided for design purposes only.
 - All inverts shown on this plan by multiVIEW Locates Inc. are in meters and were measured from the top of the manhole and/or catch basin lids.
 - Subsurface utility information shown on this drawing was obtained on a best effort, best practices basis, within the technical limitations of the instrumentation.
 - Utilities shown on this map by multiVIEW Locates Inc. were located using ASCE 38-02 Quality Level 'B' methods unless otherwise noted. All other information hereon has been supplied by others and is not certified.
 - Third party information provided on these drawings are for the convenience of use but do not constitute information obtained and delivered by multiVIEW Locates Inc. during the course of this project.
 - Elevations represented for this study were obtained by multiVIEW Locates Inc. utilizing datum derived by differential GPS observations and referred to the CAN-NET Reference Network.

UTILITY CODES

- H - - - - - Hydro Cable
 - - - - - Utility Depth

ALL UTILITIES ARE UNDERGROUND UNLESS OTHERWISE SPECIFIED

SHEET 2 of 14

Rev. No.	Drawn By	Checked By	Date	Revision
-	-	-	-	-
-	-	-	-	-
-	-	-	-	-
-	-	-	-	-

(SEE SHEET 4 OF 14)
MATCHLINE



MATCHLINE
(SEE SHEET 2 OF 14)



GLOSSARY

CSE	-	CONFINED SPACE ENTRY
SAN	-	SANITARY
STM	-	STORM
INV	-	INVERT
OBV	-	OBVERT
BOC	-	BOTTOM OF CHAMBER
EORI	-	END OF RECORD INFORMATION
AATUR	-	UTILITY ABANDONED ACCORDING TO UTILITY RECORDS
EOI	-	END OF SURFACE GEOPHYSICAL INFORMATION
T/G	-	TOP OF GRATE ELEVATION

Data presented herein is subject to multiVIEW's terms and conditions as listed on the final page of the contract drawings.

THE LOCATION OF UNDERGROUND SERVICES SHOULD BE VERIFIED PRIOR TO EXCAVATION. UTILITY LOCATES ARE REQUIRED PRIOR TO ANY EXCAVATION ACTIVITY.

SUBSURFACE UTILITY ENGINEERING
HYDRO EXCAVATION & CCTV
CONCRETE SCANNING
UTILITY LOCATES
NEAR-SURFACE GEOPHYSICS

Tel: 1-800-363-3116
Fax: 1-905-571-5946
www.multiVIEW.ca
325 Matheson Blvd East
Mississauga, ON, L4Z1X8

Project No.: 40410	Date: 2018-07-23	Drawn/Checked By: RF/JH	Appr: -
For: PARKS CANADA INFRASTRUCTURE			
Site: CI/ASCE 38-02 LEVEL 'B' SUE INVESTIGATION RIDEAU CANAL, OTTAWA, ON			

Subsurface Utility Engineering CI/ASCE 38-02 Quality Levels

QL'A: Visual verification of utility location and depth using excavation methods. i.e. Hydrovac.
QL'B: Utility located using surface geophysical methods i.e. electronically applied or induced magnetic field using specific utility locate equipment or ground penetrating radar.
QL'C: Utility plotted using record information in conjunction with a visual field survey of utility furniture.
QL'D: Utility plotted using record information only. This can include oral recollection.

- NOTES**
- This information is provided for design purposes only.
 - All inverts shown on this plan by multiVIEW Locates Inc. are in meters and were measured from the top of the manhole and/or catch basin lids.
 - Subsurface utility information shown on this drawing was obtained on a best effort, best practices basis, within the technical limitations of the instrumentation.
 - Utilities shown on this map by multiVIEW Locates Inc. were located using ASCE 38-02 Quality Level 'B' methods unless otherwise noted. All other information hereon has been supplied by others and is not certified.
 - Third party information provided on these drawings are for the convenience of use but do not constitute information obtained and delivered by multiVIEW Locates Inc. during the course of this project.
 - Elevations represented for this study were obtained by multiVIEW Locates Inc. utilizing datum derived by differential GPS observations and referred to the CAN-NET Reference Network.

UTILITY CODES


- H - - - - - Hydro Cable
- - - - - Utility Depth

ALL UTILITIES ARE UNDERGROUND UNLESS OTHERWISE SPECIFIED

SHEET 3 of 14

Rev. No.	Drawn By	Checked By	Date	Revision

(SEE SHEET 5 OF 14)
MATCHLINE

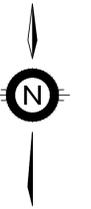

MATCHLINE
(SEE SHEET 3 OF 14)



GLOSSARY

CSE	-	CONFINED SPACE ENTRY
SAN	-	SANITARY
STM	-	STORM
INV	-	INVERT
OBV	-	OBVERT
BOC	-	BOTTOM OF CHAMBER
EORI	-	END OF RECORD INFORMATION
AATUR	-	UTILITY ABANDONED ACCORDING TO UTILITY RECORDS
EOI	-	END OF SURFACE GEOPHYSICAL INFORMATION
T/G	-	TOP OF GRATE ELEVATION

Data presented herein is subject to multiVIEW's terms and conditions as listed on the final page of the contract drawings.

THE LOCATION OF UNDERGROUND SERVICES SHOULD BE VERIFIED PRIOR TO EXCAVATION. UTILITY LOCATES ARE REQUIRED PRIOR TO ANY EXCAVATION ACTIVITY.

SUBSURFACE UTILITY ENGINEERING
HYDRO EXCAVATION & CCTV
CONCRETE SCANNING
UTILITY LOCATES
NEAR-SURFACE GEOPHYSICS

Tel: 1-800-363-3116
Fax: 1-906-571-5946
www.multiVIEW.ca
325 Matheson Blvd East
Mississauga, ON, L4Z1X8

Project No.: 40410	Date: 2018-07-23	Drawn/Checked By: RF/JH	Appr: -
For: PARKS CANADA INFRASTRUCTURE			
Site: CI/ASCE 38-02 LEVEL 'B' SUE INVESTIGATION RIDEAU CANAL, OTTAWA, ON			

Subsurface Utility Engineering CI/ASCE 38-02 Quality Levels

QL'A: Visual verification of utility location and depth using excavation methods. i.e. Hydrovac.
QL'B: Utility located using surface geophysical methods i.e. electronically applied or induced magnetic field using specific utility locate equipment or ground penetrating radar.
QL'C: Utility plotted using record information in conjunction with a visual field survey of utility furniture.
QL'D: Utility plotted using record information only. This can include oral recollection.

- NOTES**
- This information is provided for design purposes only.
 - All inverts shown on this plan by multiVIEW Locates Inc. are in meters and were measured from the top of the manhole and/or catch basin lids.
 - Subsurface utility information shown on this drawing was obtained on a best effort, best practices basis, within the technical limitations of the instrumentation.
 - Utilities shown on this map by multiVIEW Locates Inc. were located using ASCE 38-02 Quality Level 'B' methods unless otherwise noted. All other information hereon has been supplied by others and is not certified.
 - Third party information provided on these drawings are for the convenience of use but do not constitute information obtained and delivered by multiVIEW Locates Inc. during the course of this project.
 - Elevations represented for this study were obtained by multiVIEW Locates Inc. utilizing datum derived by differential GPS observations and referred to the CAN-NET Reference Network.

UTILITY CODES

--- H --- Hydro Cable
0.90m-H Utility Depth

ALL UTILITIES ARE UNDERGROUND UNLESS OTHERWISE SPECIFIED

SHEET 4 of 14

Rev. No.	Drawn By	Checked By	Date	Revision
-	-	-	-	-

(SEE SHEET 6 OF 14)
MATCHLINE



MATCHLINE
(SEE SHEET 4 OF 14)



GLOSSARY

CSE	-	CONFINED SPACE ENTRY
SAN	-	SANITARY
STM	-	STORM
INV	-	INVERT
OBV	-	OBVERT
BOC	-	BOTTOM OF CHAMBER
EORI	-	END OF RECORD INFORMATION
AATUR	-	UTILITY ABANDONED ACCORDING TO UTILITY RECORDS
EOI	-	END OF SURFACE GEOPHYSICAL INFORMATION
T/G	-	TOP OF GRATE ELEVATION

NOTES

- This information is provided for design purposes only.
- All inverts shown on this plan by multiVIEW Locates Inc. are in meters and were measured from the top of the manhole and/or catch basin lids.
- Subsurface utility information shown on this drawing was obtained on a best effort, best practices basis, within the technical limitations of the instrumentation.
- Utilities shown on this map by multiVIEW Locates Inc. were located using ASCE 38-02 Quality Level 'B' methods unless otherwise noted. All other information hereon has been supplied by others and is not certified.
- Third party information provided on these drawings are for the convenience of use but do not constitute information obtained and delivered by multiVIEW Locates Inc. during the course of this project.
- Elevations represented for this study were obtained by multiVIEW Locates Inc. utilizing datum derived by differential GPS observations and referred to the CAN-NET Reference Network.

UTILITY CODES

- H - - - - - Hydro Cable
- - - - - Utility Depth

ALL UTILITIES ARE UNDERGROUND UNLESS OTHERWISE SPECIFIED

SHEET 5 of 14

Rev. No.	Drawn By	Checked By	Date	Revision
-	-	-	-	-
-	-	-	-	-
-	-	-	-	-
-	-	-	-	-
-	-	-	-	-

Data presented herein is subject to multiVIEW's terms and conditions as listed on the final page of the contract drawings.






Project No.: 40410	Date: 2018-07-23	Drawn/Checked By: RF/JH	Appr: -
For: PARKS CANADA INFRASTRUCTURE			
Site: CI/ASCE 38-02 LEVEL 'B' SUE INVESTIGATION RIDEAU CANAL, OTTAWA, ON			

Subsurface Utility Engineering CI/ASCE 38-02 Quality Levels

- QL'A: Visual verification of utility location and depth using excavation methods. i.e. Hydrovac.
- QL'B: Utility located using surface geophysical methods i.e. electronically applied or induced magnetic field using specific utility locate equipment or ground penetrating radar.
- QL'C: Utility plotted using record information in conjunction with a visual field survey of utility furniture.
- QL'D: Utility plotted using record information only. This can include oral recollection.

SUBSURFACE UTILITY ENGINEERING
HYDRO EXCAVATION & CCTV
CONCRETE SCANNING
UTILITY LOCATES
NEAR-SURFACE GEOPHYSICS

Tel: 1-800-363-3116
Fax: 1-906-571-5946
www.multiVIEW.ca
325 Matheson Blvd East
Mississauga, ON, L4Z1X8

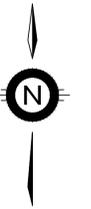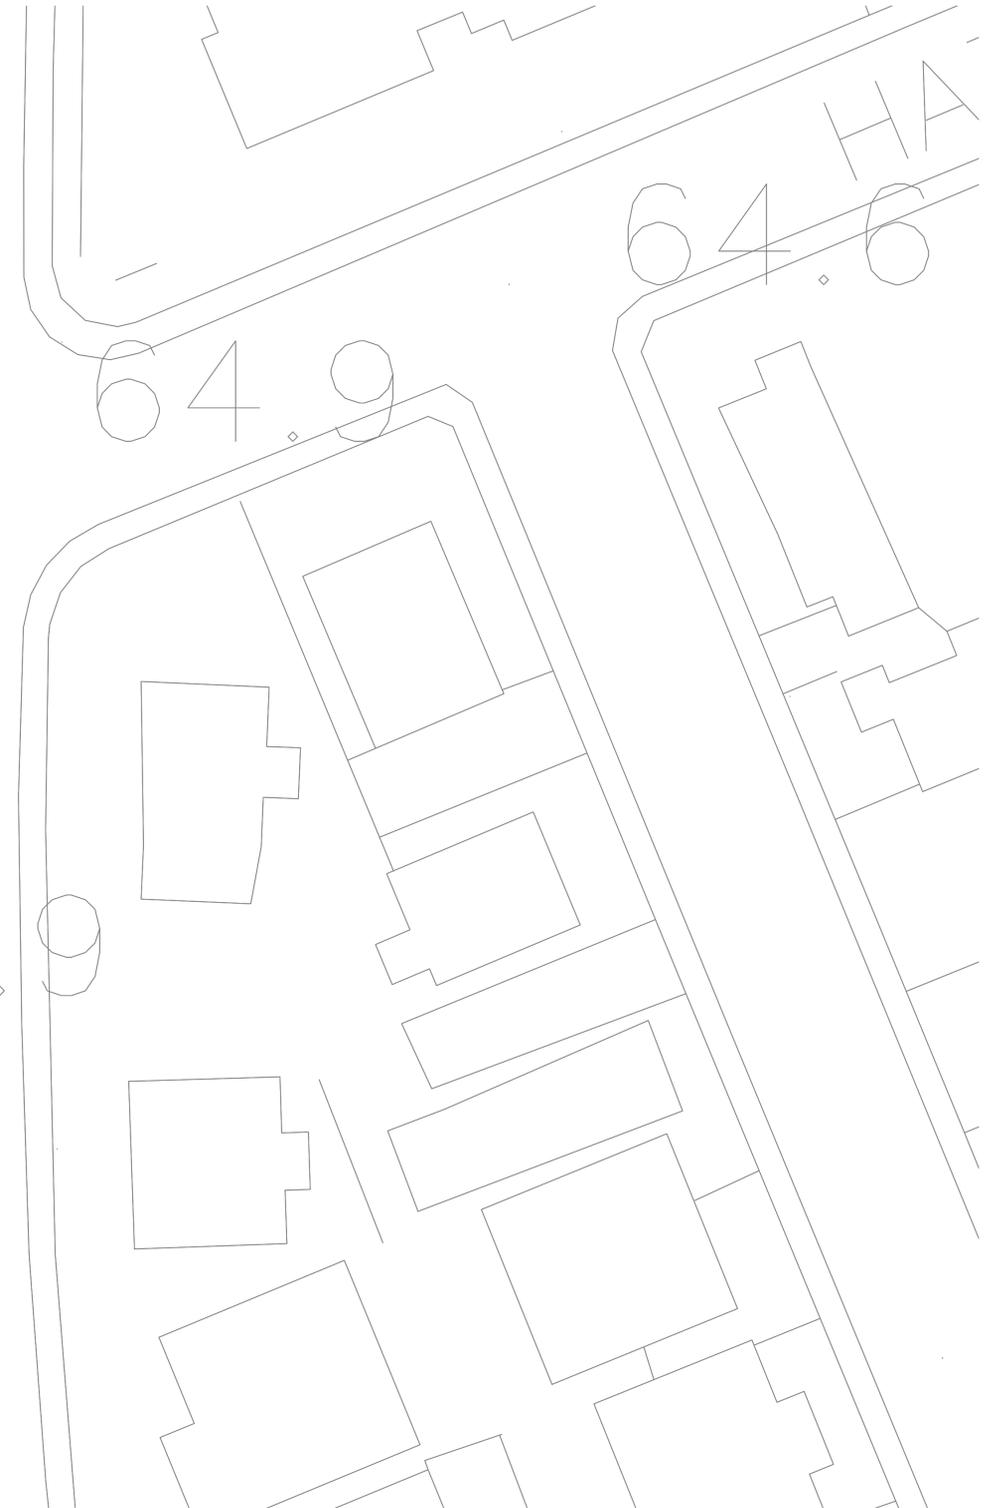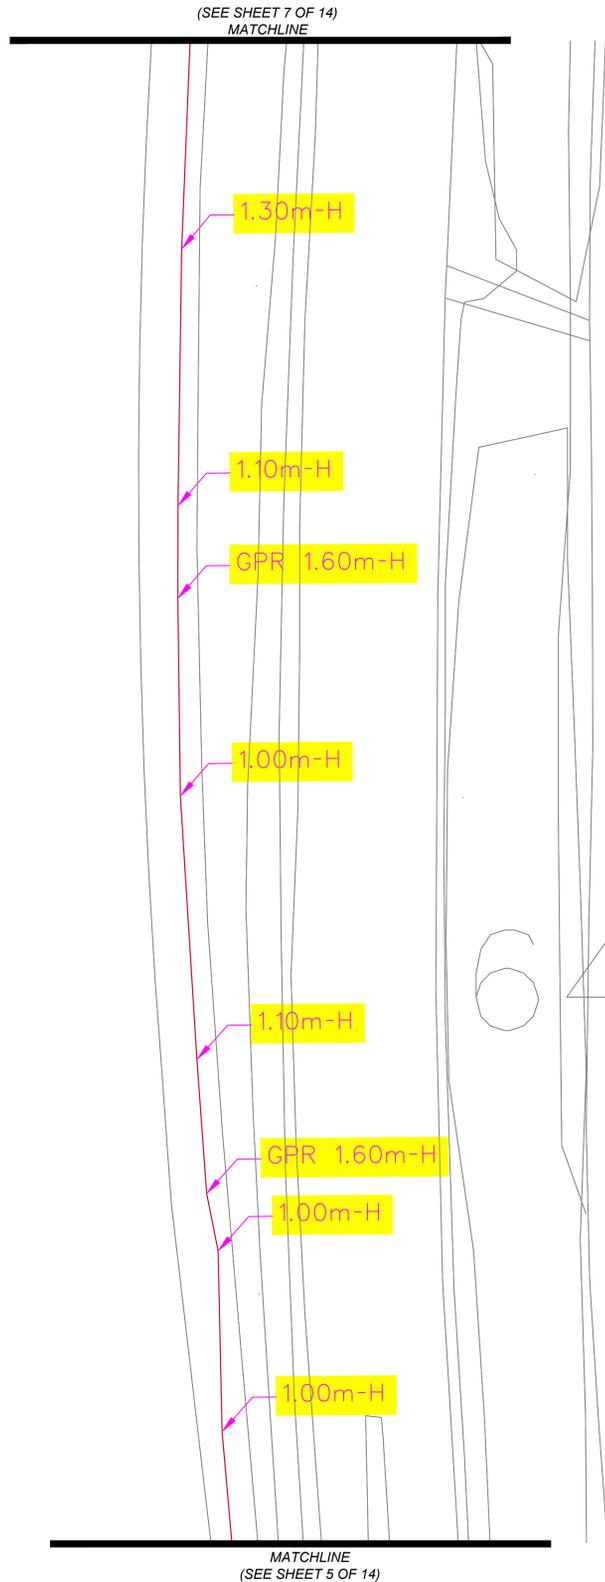

GLOSSARY

CSE	-	CONFINED SPACE ENTRY
SAN	-	SANITARY
STM	-	STORM
INV	-	INVERT
OBV	-	OBVERT
BOC	-	BOTTOM OF CHAMBER
EORI	-	END OF RECORD INFORMATION
AATUR	-	UTILITY ABANDONED ACCORDING TO UTILITY RECORDS
EOI	-	END OF SURFACE GEOPHYSICAL INFORMATION
T/G	-	TOP OF GRATE ELEVATION

Data presented herein is subject to multiVIEW's terms and conditions as listed on the final page of the contract drawings.

THE LOCATION OF UNDERGROUND SERVICES SHOULD BE VERIFIED PRIOR TO EXCAVATION. UTILITY LOCATES ARE REQUIRED PRIOR TO ANY EXCAVATION ACTIVITY.

SubSURFACE UTILITY ENGINEERING
HYDRO EXCAVATION & CCTV
CONCRETE SCANNING
UTILITY LOCATES
NEAR-SURFACE GEOPHYSICS

Tel: 1-800-363-3116
Fax: 1-800-571-5946
www.multiVIEW.ca
325 Matheson Blvd East
Mississauga, ON, L4Z1X8

Project No.: 40410	Date: 2018-07-23	Drawn/Checked By: RF/JH	Appr: -
For: PARKS CANADA INFRASTRUCTURE			
Site: CI/ASCE 38-02 LEVEL 'B' SUE INVESTIGATION RIDEAU CANAL, OTTAWA, ON			

Subsurface Utility Engineering CI/ASCE 38-02 Quality Levels

QL'A: Visual verification of utility location and depth using excavation methods. i.e. Hydrovac.
QL'B: Utility located using surface geophysical methods i.e. electronically applied or induced magnetic field using specific utility locate equipment or ground penetrating radar.
QL'C: Utility plotted using record information in conjunction with a visual field survey of utility furniture.
QL'D: Utility plotted using record information only. This can include oral recollection.

- NOTES**
- This information is provided for design purposes only.
 - All inverts shown on this plan by multiVIEW Locates Inc. are in meters and were measured from the top of the manhole and/or catch basin lids.
 - Subsurface utility information shown on this drawing was obtained on a best effort, best practices basis, within the technical limitations of the instrumentation.
 - Utilities shown on this map by multiVIEW Locates Inc. were located using ASCE 38-02 Quality Level 'B' methods unless otherwise noted. All other information hereon has been supplied by others and is not certified.
 - Third party information provided on these drawings are for the convenience of use but do not constitute information obtained and delivered by multiVIEW Locates Inc. during the course of this project.
 - Elevations represented for this study were obtained by multiVIEW Locates Inc. utilizing datum derived by differential GPS observations and referred to the CAN-NET Reference Network.

UTILITY CODES



--- H --- Hydro Cable
1.00m-H Utility Depth

ALL UTILITIES ARE UNDERGROUND UNLESS OTHERWISE SPECIFIED

SHEET 6 of 14

Rev. No.	Drawn By	Checked By	Date	Revision
-	-	-	-	-
-	-	-	-	-
-	-	-	-	-
-	-	-	-	-
-	-	-	-	-

(SEE SHEET 8 OF 14)
MATCHLINE

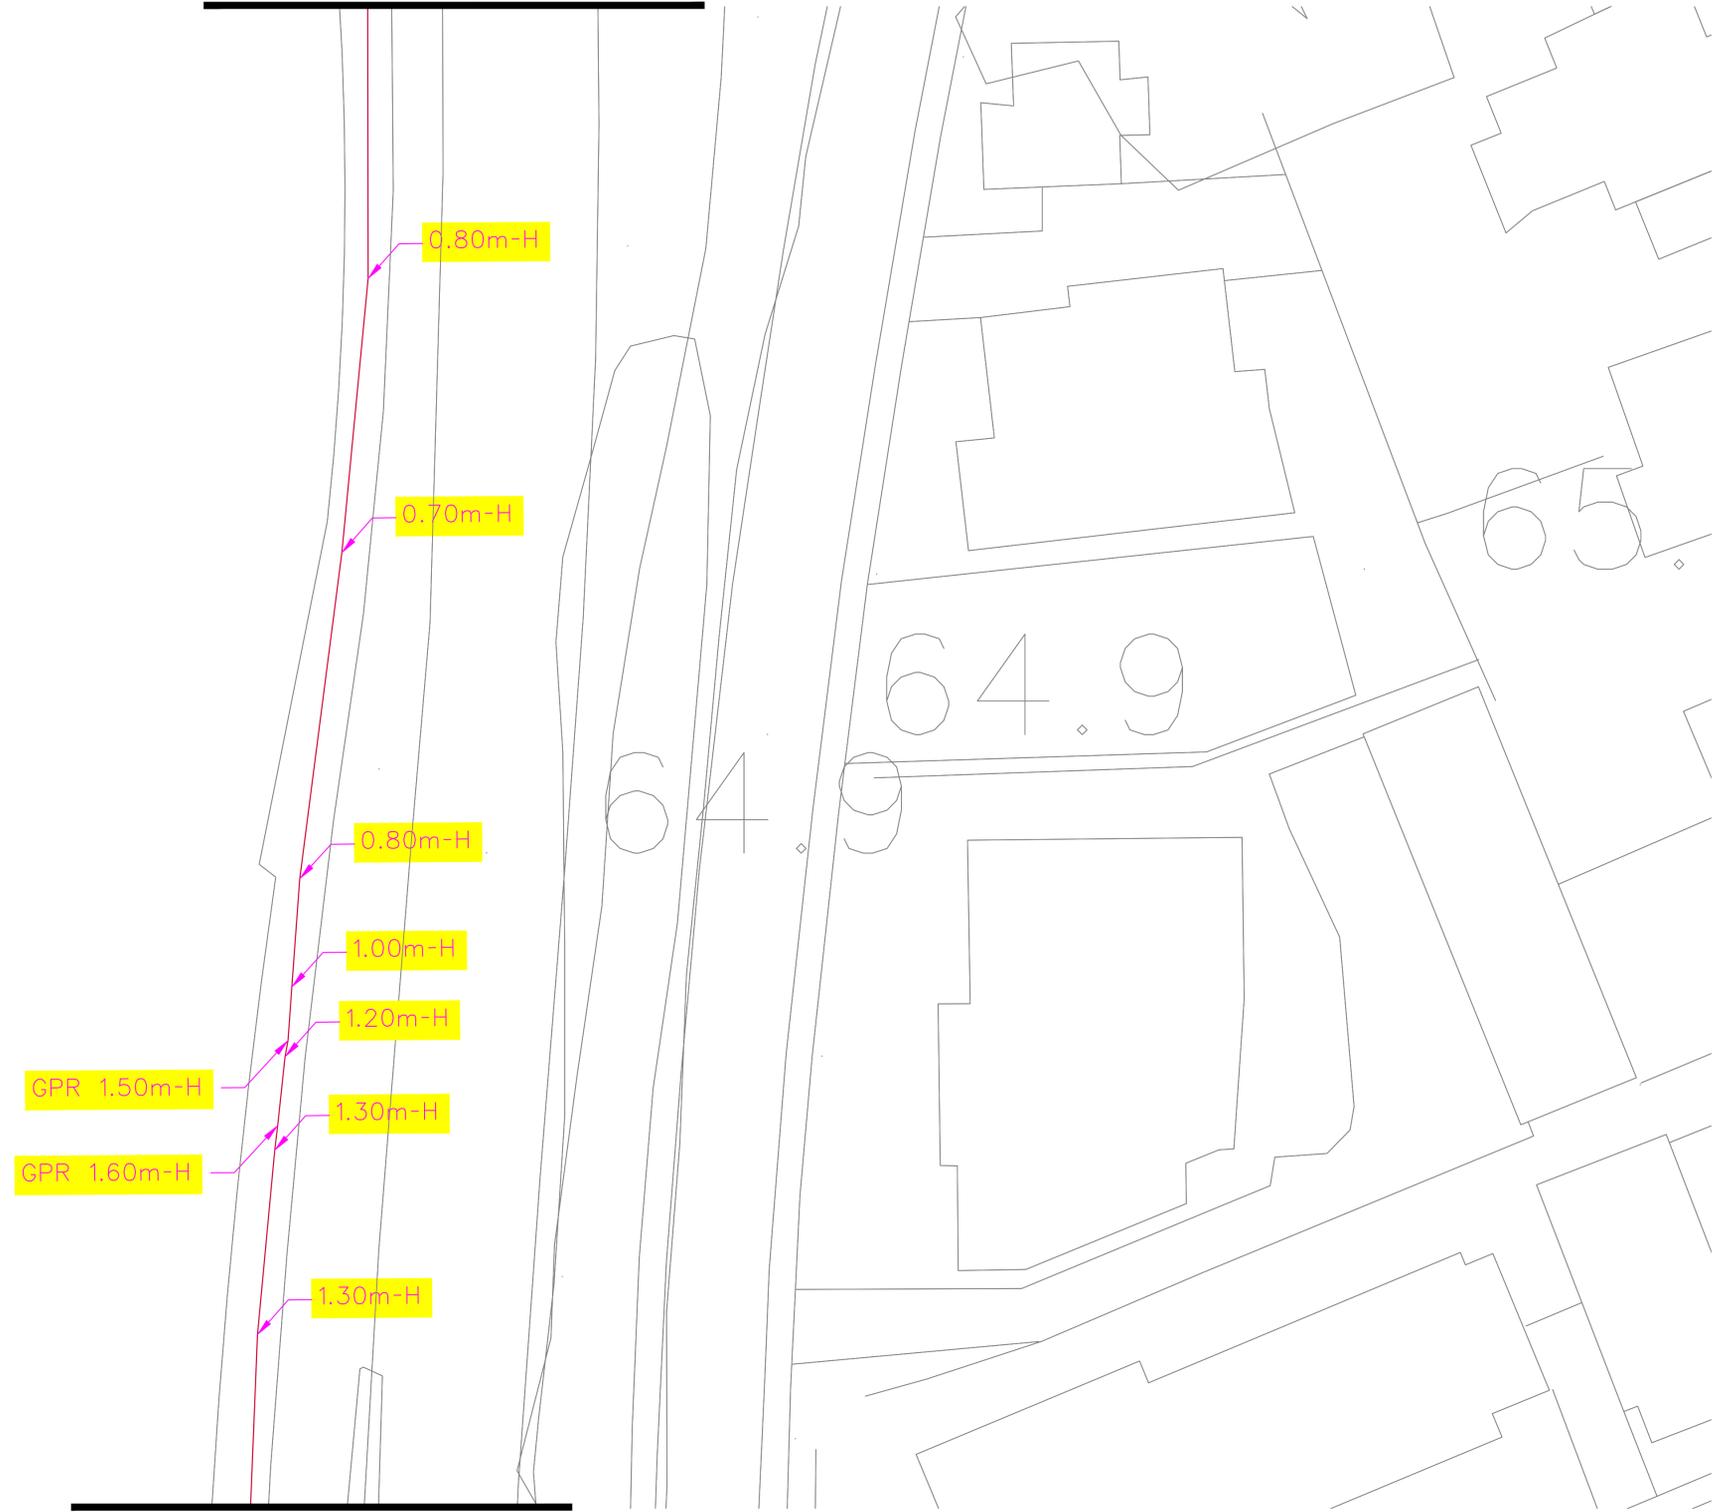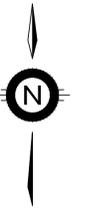

MATCHLINE
(SEE SHEET 6 OF 14)



GLOSSARY

CSE	-	CONFINED SPACE ENTRY
SAN	-	SANITARY
STM	-	STORM
INV	-	INVERT
OBV	-	OBVERT
BOC	-	BOTTOM OF CHAMBER
EORI	-	END OF RECORD INFORMATION
AATUR	-	UTILITY ABANDONED ACCORDING TO UTILITY RECORDS
EOI	-	END OF SURFACE GEOPHYSICAL INFORMATION
T/G	-	TOP OF GRATE ELEVATION

Data presented herein is subject to multiVIEW's terms and conditions as listed on the final page of the contract drawings.

THE LOCATION OF UNDERGROUND SERVICES SHOULD BE VERIFIED PRIOR TO EXCAVATION. UTILITY LOCATES ARE REQUIRED PRIOR TO ANY EXCAVATION ACTIVITY.

SubSURFACE UTILITY ENGINEERING
HYDRO EXCAVATION & CCTV
CONCRETE SCANNING
UTILITY LOCATES
NEAR-SURFACE GEOPHYSICS

Tel: 1-800-363-3116
Fax: 1-906-571-5946
www.multiVIEW.ca
325 Matheson Blvd East
Mississauga, ON, L4Z1X8

Project No.:	Date:	Drawn/Checked By:	Appr:
40410	2018-07-23	RF/JH	-
For: PARKS CANADA INFRASTRUCTURE			
Site: CI/ASCE 38-02 LEVEL 'B' SUE INVESTIGATION RIDEAU CANAL, OTTAWA, ON			

Subsurface Utility Engineering CI/ASCE 38-02 Quality Levels

QL'A: Visual verification of utility location and depth using excavation methods. i.e. Hydrovac.
QL'B: Utility located using surface geophysical methods i.e. electronically applied or induced magnetic field using specific utility locate equipment or ground penetrating radar.
QL'C: Utility plotted using record information in conjunction with a visual field survey of utility furniture.
QL'D: Utility plotted using record information only. This can include oral recollection.

- NOTES**
- This information is provided for design purposes only.
 - All inverts shown on this plan by multiVIEW Locates Inc. are in meters and were measured from the top of the manhole and/or catch basin lids.
 - Subsurface utility information shown on this drawing was obtained on a best effort, best practices basis, within the technical limitations of the instrumentation.
 - Utilities shown on this map by multiVIEW Locates Inc. were located using ASCE 38-02 Quality Level 'B' methods unless otherwise noted. All other information hereon has been supplied by others and is not certified.
 - Third party information provided on these drawings are for the convenience of use but do not constitute information obtained and delivered by multiVIEW Locates Inc. during the course of this project.
 - Elevations represented for this study were obtained by multiVIEW Locates Inc. utilizing datum derived by differential GPS observations and referred to the CAN-NET Reference Network.

UTILITY CODES


--- H --- Hydro Cable
--- Utility Depth

ALL UTILITIES ARE UNDERGROUND UNLESS OTHERWISE SPECIFIED

SHEET 8 of 14

Rev. No.	Drawn By	Checked By	Date	Revision
-	-	-	-	-
-	-	-	-	-
-	-	-	-	-
-	-	-	-	-

(SEE SHEET 9 OF 14)
MATCHLINE

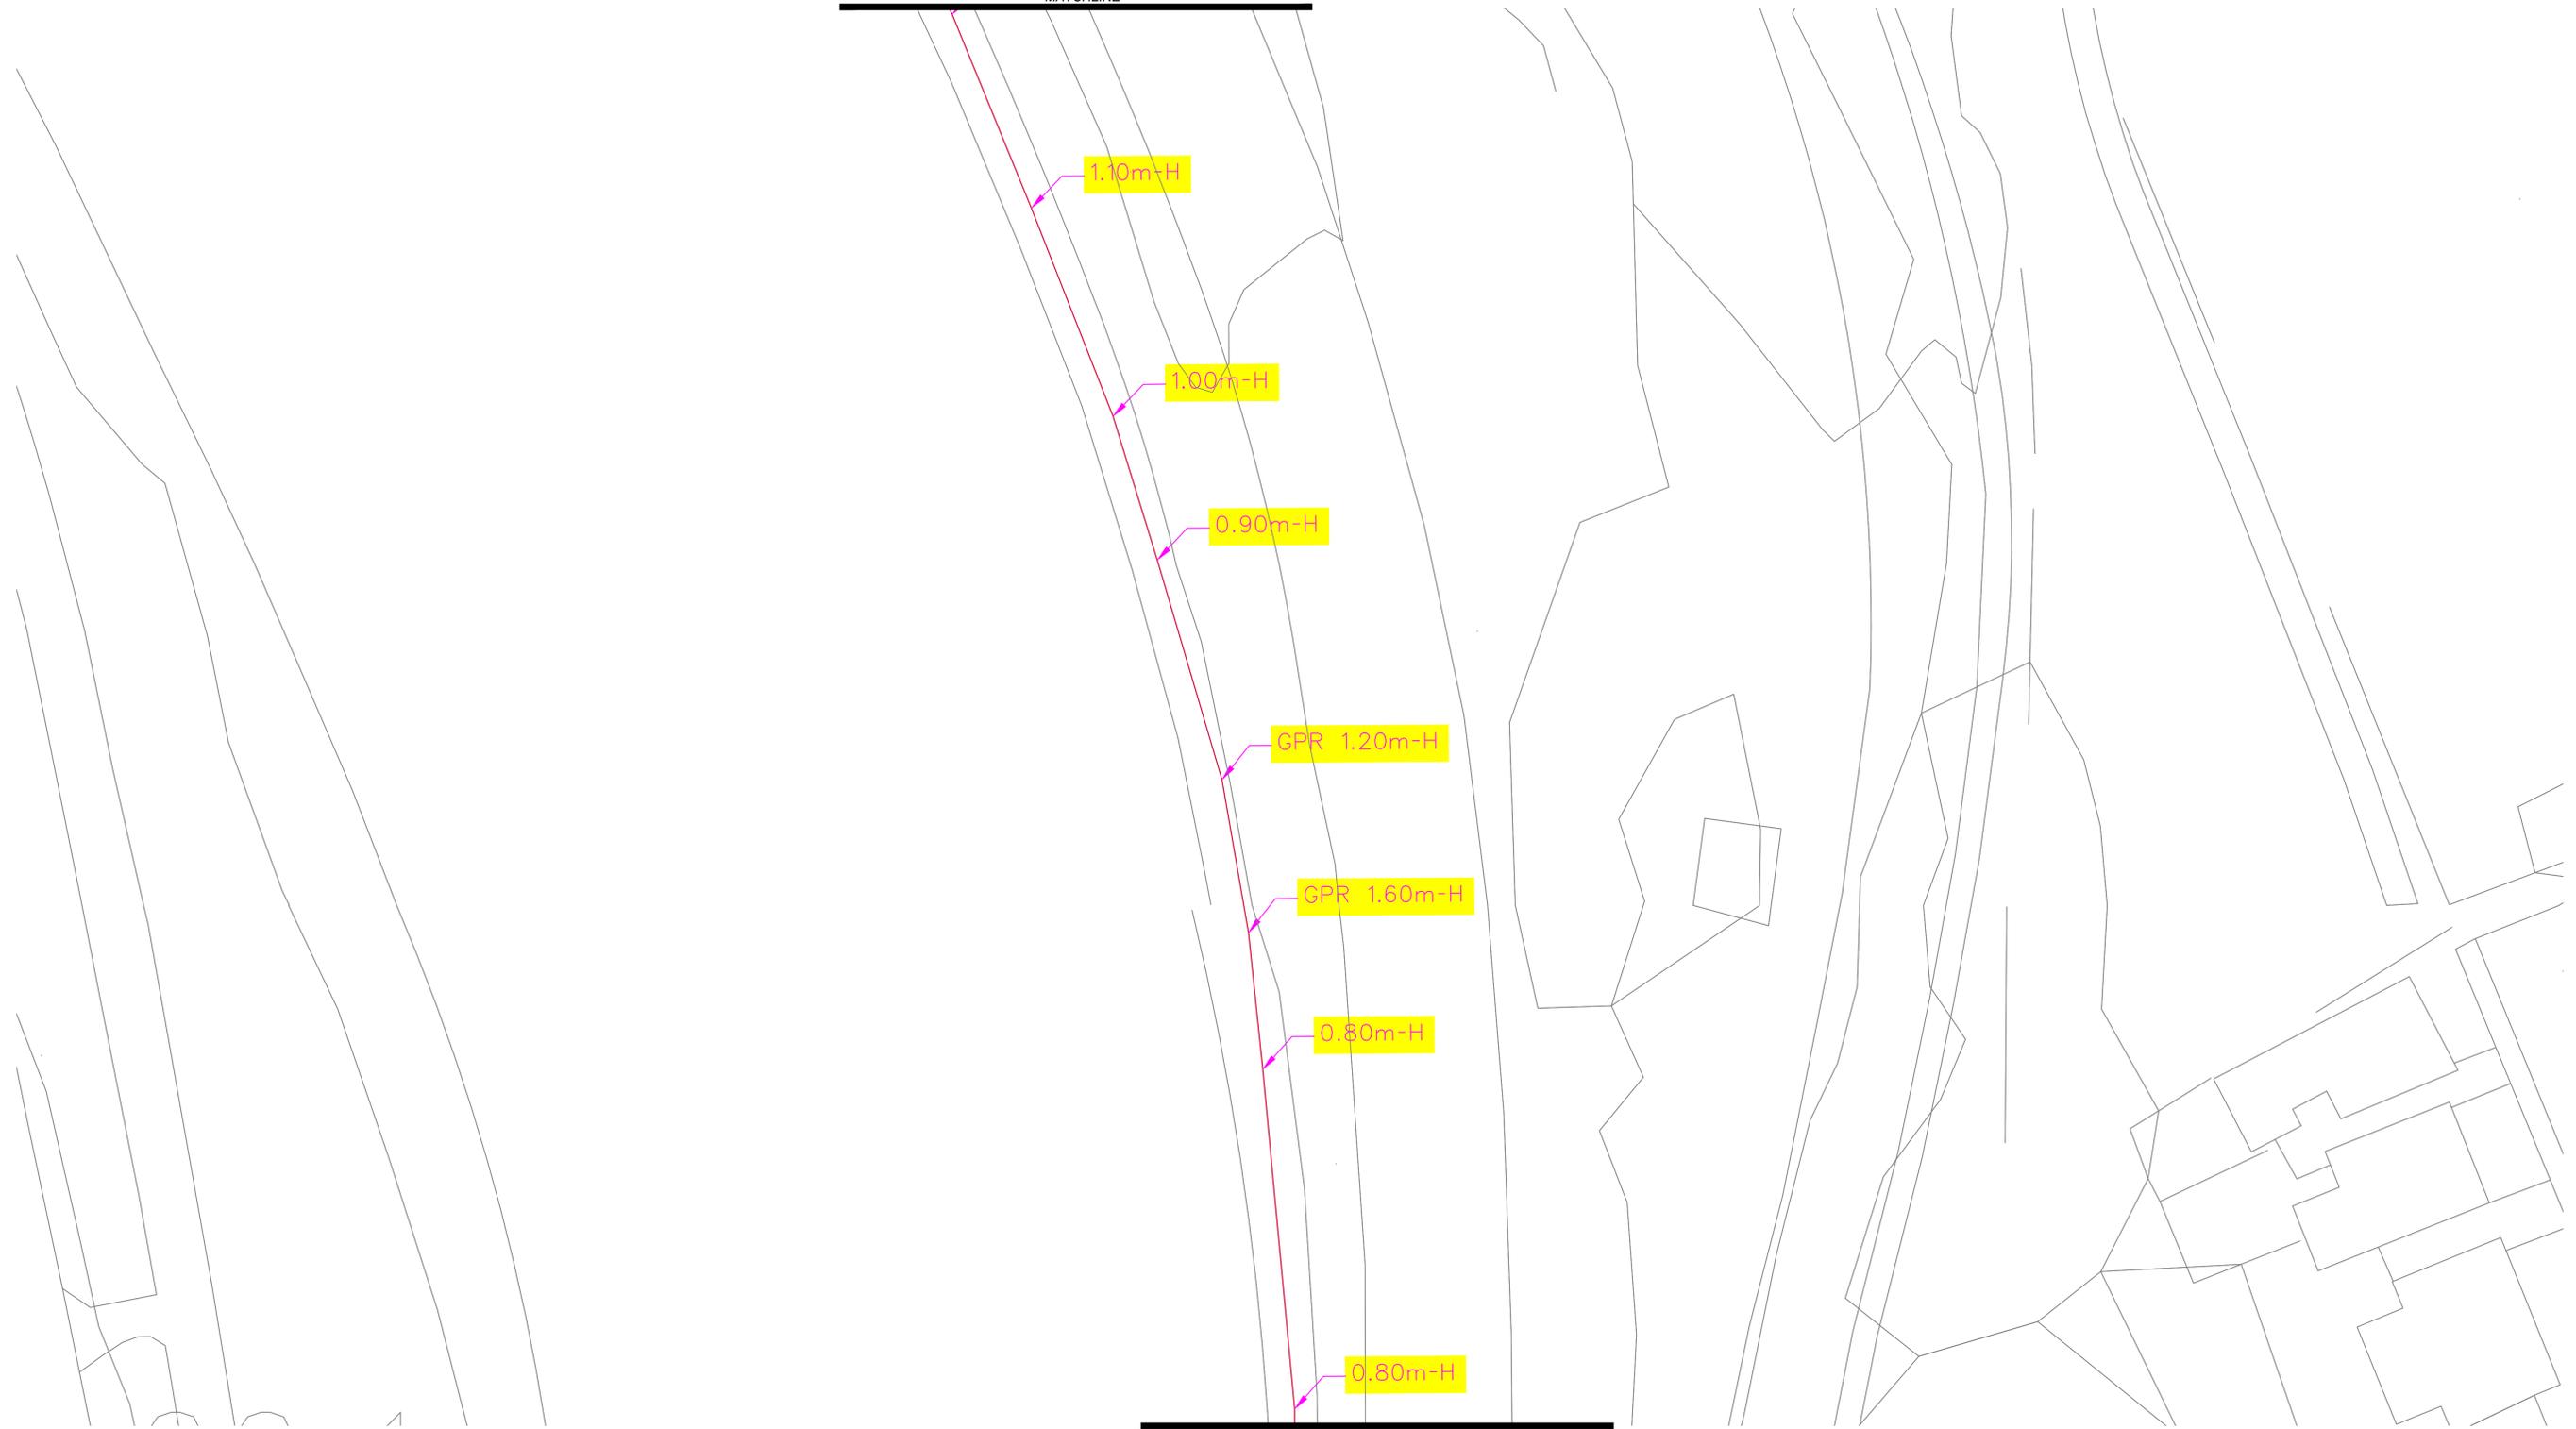

MATCHLINE
(SEE SHEET 7 OF 14)



GLOSSARY

CSE	-	CONFINED SPACE ENTRY
SAN	-	SANITARY
STM	-	STORM
INV	-	INVERT
OBV	-	OBVERT
BOC	-	BOTTOM OF CHAMBER
EORI	-	END OF RECORD INFORMATION
AATUR	-	UTILITY ABANDONED ACCORDING TO UTILITY RECORDS
EOI	-	END OF SURFACE GEOPHYSICAL INFORMATION
T/G	-	TOP OF GRATE ELEVATION

Data presented herein is subject to multiVIEW's terms and conditions as listed on the final page of the contract drawings.

THE LOCATION OF UNDERGROUND SERVICES SHOULD BE VERIFIED PRIOR TO EXCAVATION. UTILITY LOCATES ARE REQUIRED PRIOR TO ANY EXCAVATION ACTIVITY.

SUBSURFACE UTILITY ENGINEERING
HYDRO EXCAVATION & CCTV
CONCRETE SCANNING
UTILITY LOCATES
NEAR-SURFACE GEOPHYSICS

Tel: 1-800-363-3116
Fax: 1-906-571-5946
www.multiVIEW.ca
325 Matheson Blvd East
Mississauga, ON, L4Z1X8

Project No.: 40410	Date: 2018-07-23	Drawn/Checked By: RF/JH	Appr: -
For: PARKS CANADA INFRASTRUCTURE			
Site: CI/ASCE 38-02 LEVEL 'B' SUE INVESTIGATION RIDEAU CANAL, OTTAWA, ON			

Subsurface Utility Engineering CI/ASCE 38-02 Quality Levels

QL'A: Visual verification of utility location and depth using excavation methods. i.e. Hydrovac.
QL'B: Utility located using surface geophysical methods i.e. electronically applied or induced magnetic field using specific utility locate equipment or ground penetrating radar.
QL'C: Utility plotted using record information in conjunction with a visual field survey of utility furniture.
QL'D: Utility plotted using record information only. This can include oral recollection.

- NOTES**
- This information is provided for design purposes only.
 - All inverts shown on this plan by multiVIEW Locates Inc. are in meters and were measured from the top of the manhole and/or catch basin lids.
 - Subsurface utility information shown on this drawing was obtained on a best effort, best practices basis, within the technical limitations of the instrumentation.
 - Utilities shown on this map by multiVIEW Locates Inc. were located using ASCE 38-02 Quality Level 'B' methods unless otherwise noted. All other information hereon has been supplied by others and is not certified.
 - Third party information provided on these drawings are for the convenience of use but do not constitute information obtained and delivered by multiVIEW Locates Inc. during the course of this project.
 - Elevations represented for this study were obtained by multiVIEW Locates Inc. utilizing datum derived by differential GPS observations and referred to the CAN-NET Reference Network.

UTILITY CODES



--- H --- Hydro Cable
1.10m-H Utility Depth

ALL UTILITIES ARE UNDERGROUND UNLESS OTHERWISE SPECIFIED


SHEET 8 of 14

Rev. No.	Drawn By	Checked By	Date	Revision
-	-	-	-	-

(SEE SHEET 10 OF 14)
MATCHLINE

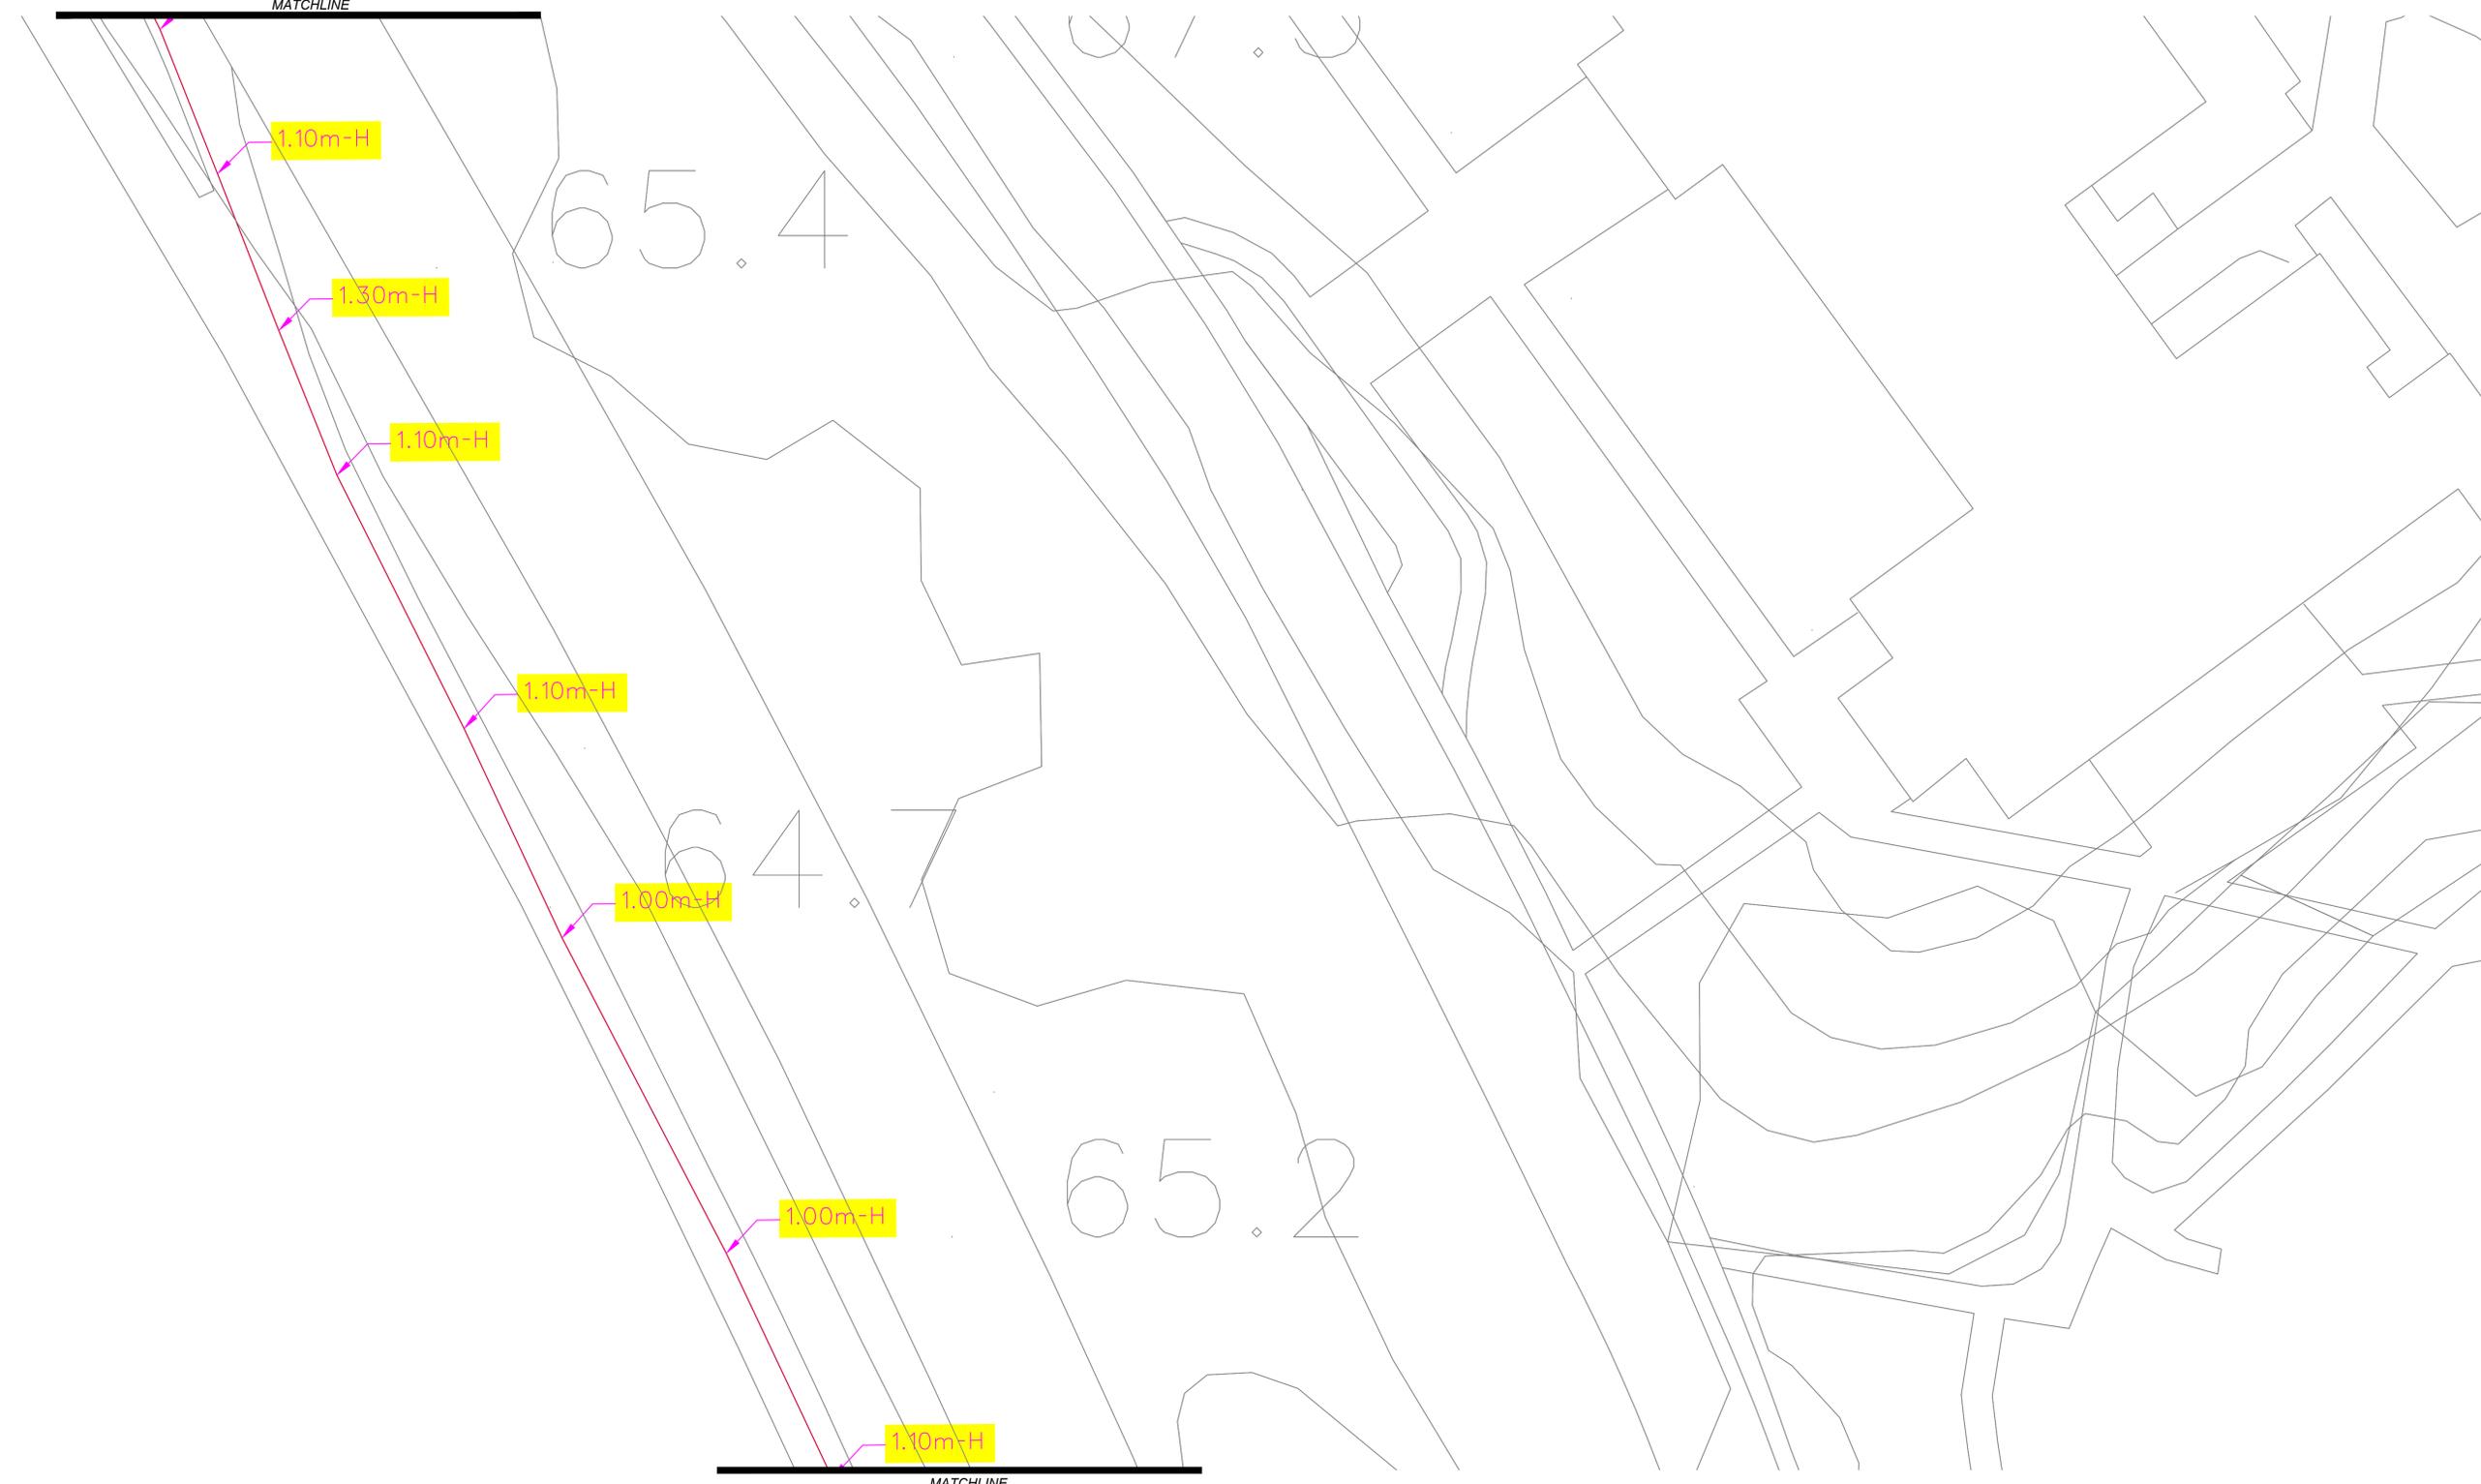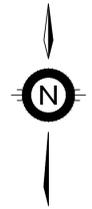

MATCHLINE
(SEE SHEET 8 OF 14)

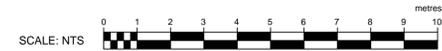

GLOSSARY

CSE	-	CONFINED SPACE ENTRY
SAN	-	SANITARY
STM	-	STORM
INV	-	INVERT
OBV	-	OBVERT
BOC	-	BOTTOM OF CHAMBER
EORI	-	END OF RECORD INFORMATION
AATUR	-	UTILITY ABANDONED ACCORDING TO UTILITY RECORDS
EOI	-	END OF SURFACE GEOPHYSICAL INFORMATION
T/G	-	TOP OF GRATE ELEVATION

Data presented herein is subject to multiVIEW's terms and conditions as listed on the final page of the contract drawings.

THE LOCATION OF UNDERGROUND SERVICES SHOULD BE VERIFIED PRIOR TO EXCAVATION. UTILITY LOCATES ARE REQUIRED PRIOR TO ANY EXCAVATION ACTIVITY.

SUBSURFACE UTILITY ENGINEERING
HYDRO EXCAVATION & CCTV
CONCRETE SCANNING
UTILITY LOCATES
NEAR-SURFACE GEOPHYSICS

Tel: 1-800-363-3116
Fax: 1-905-571-5946
www.multiVIEW.ca
325 Matheson Blvd East
Mississauga, ON, L4Z1X8

Project No.:	Date:	Drawn/Checked By:	Appr:
40410	2018-07-23	RF/JH	-
For: PARKS CANADA INFRASTRUCTURE			
Site: CI/ASCE 38-02 LEVEL 'B' SUE INVESTIGATION RIDEAU CANAL, OTTAWA, ON			

Subsurface Utility Engineering CI/ASCE 38-02 Quality Levels

QL'A: Visual verification of utility location and depth using excavation methods. i.e. Hydrovac.

QL'B: Utility located using surface geophysical methods i.e. electronically applied or induced magnetic field using specific utility locate equipment or ground penetrating radar.

QL'C: Utility plotted using record information in conjunction with a visual field survey of utility furniture.

QL'D: Utility plotted using record information only. This can include oral recollection.

- NOTES**
- This information is provided for design purposes only.
 - All inverts shown on this plan by multiVIEW Locates Inc. are in meters and were measured from the top of the manhole and/or catch basin lids.
 - Subsurface utility information shown on this drawing was obtained on a best effort, best practices basis, within the technical limitations of the instrumentation.
 - Utilities shown on this map by multiVIEW Locates Inc. were located using ASCE 38-02 Quality Level 'B' methods unless otherwise noted. All other information hereon has been supplied by others and is not certified.
 - Third party information provided on these drawings are for the convenience of use but do not constitute information obtained and delivered by multiVIEW Locates Inc. during the course of this project.
 - Elevations represented for this study were obtained by multiVIEW Locates Inc. utilizing datum derived by differential GPS observations and referred to the CAN-NET Reference Network.

UTILITY CODES

--- H --- Hydro Cable

--- Utility Depth

ALL UTILITIES ARE UNDERGROUND UNLESS OTHERWISE SPECIFIED

SHEET 9 of 14

Rev. No.	Drawn By	Checked By	Date	Revision
-	-	-	-	-
-	-	-	-	-
-	-	-	-	-
-	-	-	-	-

(SEE SHEET 11 OF 14)
MATCHLINE



MATCHLINE
(SEE SHEET 9 OF 14)



GLOSSARY

CSE	-	CONFINED SPACE ENTRY
SAN	-	SANITARY
STM	-	STORM
INV	-	INVERT
OBV	-	OBVERT
BOC	-	BOTTOM OF CHAMBER
EORI	-	END OF RECORD INFORMATION
AATUR	-	UTILITY ABANDONED ACCORDING TO UTILITY RECORDS
EOI	-	END OF SURFACE GEOPHYSICAL INFORMATION
T/G	-	TOP OF GRATE ELEVATION

Data presented herein is subject to multiVIEW's terms and conditions as listed on the final page of the contract drawings.

THE LOCATION OF UNDERGROUND SERVICES SHOULD BE VERIFIED PRIOR TO EXCAVATION. UTILITY LOCATES ARE REQUIRED PRIOR TO ANY EXCAVATION ACTIVITY.

SUBSURFACE UTILITY ENGINEERING
HYDRO EXCAVATION & CCTV
CONCRETE SCANNING
UTILITY LOCATES
NEAR-SURFACE GEOPHYSICS

Tel: 1-800-363-3116
Fax: 1-906-571-5946
www.multiVIEW.ca
325 Matheson Blvd East
Mississauga, ON, L4Z1X8

Project No.:	Date:	Drawn/Checked By:	Appr:
40410	2018-07-23	RF/JH	-
For: PARKS CANADA INFRASTRUCTURE			
Site: CI/ASCE 38-02 LEVEL 'B' SUE INVESTIGATION RIDEAU CANAL, OTTAWA, ON			

Subsurface Utility Engineering CI/ASCE 38-02 Quality Levels

QL'A: Visual verification of utility location and depth using excavation methods. i.e. Hydrovac.
QL'B: Utility located using surface geophysical methods i.e. electronically applied or induced magnetic field using specific utility locate equipment or ground penetrating radar.
QL'C: Utility plotted using record information in conjunction with a visual field survey of utility furniture.
QL'D: Utility plotted using record information only. This can include oral recollection.

NOTES

- This information is provided for design purposes only.
- All inverts shown on this plan by multiVIEW Locates Inc. are in meters and were measured from the top of the manhole and/or catch basin lids.
- Subsurface utility information shown on this drawing was obtained on a best effort, best practices basis, within the technical limitations of the instrumentation.
- Utilities shown on this map by multiVIEW Locates Inc. were located using ASCE 38-02 Quality Level 'B' methods unless otherwise noted. All other information hereon has been supplied by others and is not certified.
- Third party information provided on these drawings are for the convenience of use but do not constitute information obtained and delivered by multiVIEW Locates Inc. during the course of this project.
- Elevations represented for this study were obtained by multiVIEW Locates Inc. utilizing datum derived by differential GPS observations and referred to the CAN-NET Reference Network.

UTILITY CODES


--- H --- Hydro Cable
1.00m-H Utility Depth

ALL UTILITIES ARE UNDERGROUND UNLESS OTHERWISE SPECIFIED


SHEET 10 of 14

Rev. No.	Drawn By	Checked By	Date	Revision
-	-	-	-	-
-	-	-	-	-
-	-	-	-	-
-	-	-	-	-

(SEE SHEET 12 OF 14)
MATCHLINE

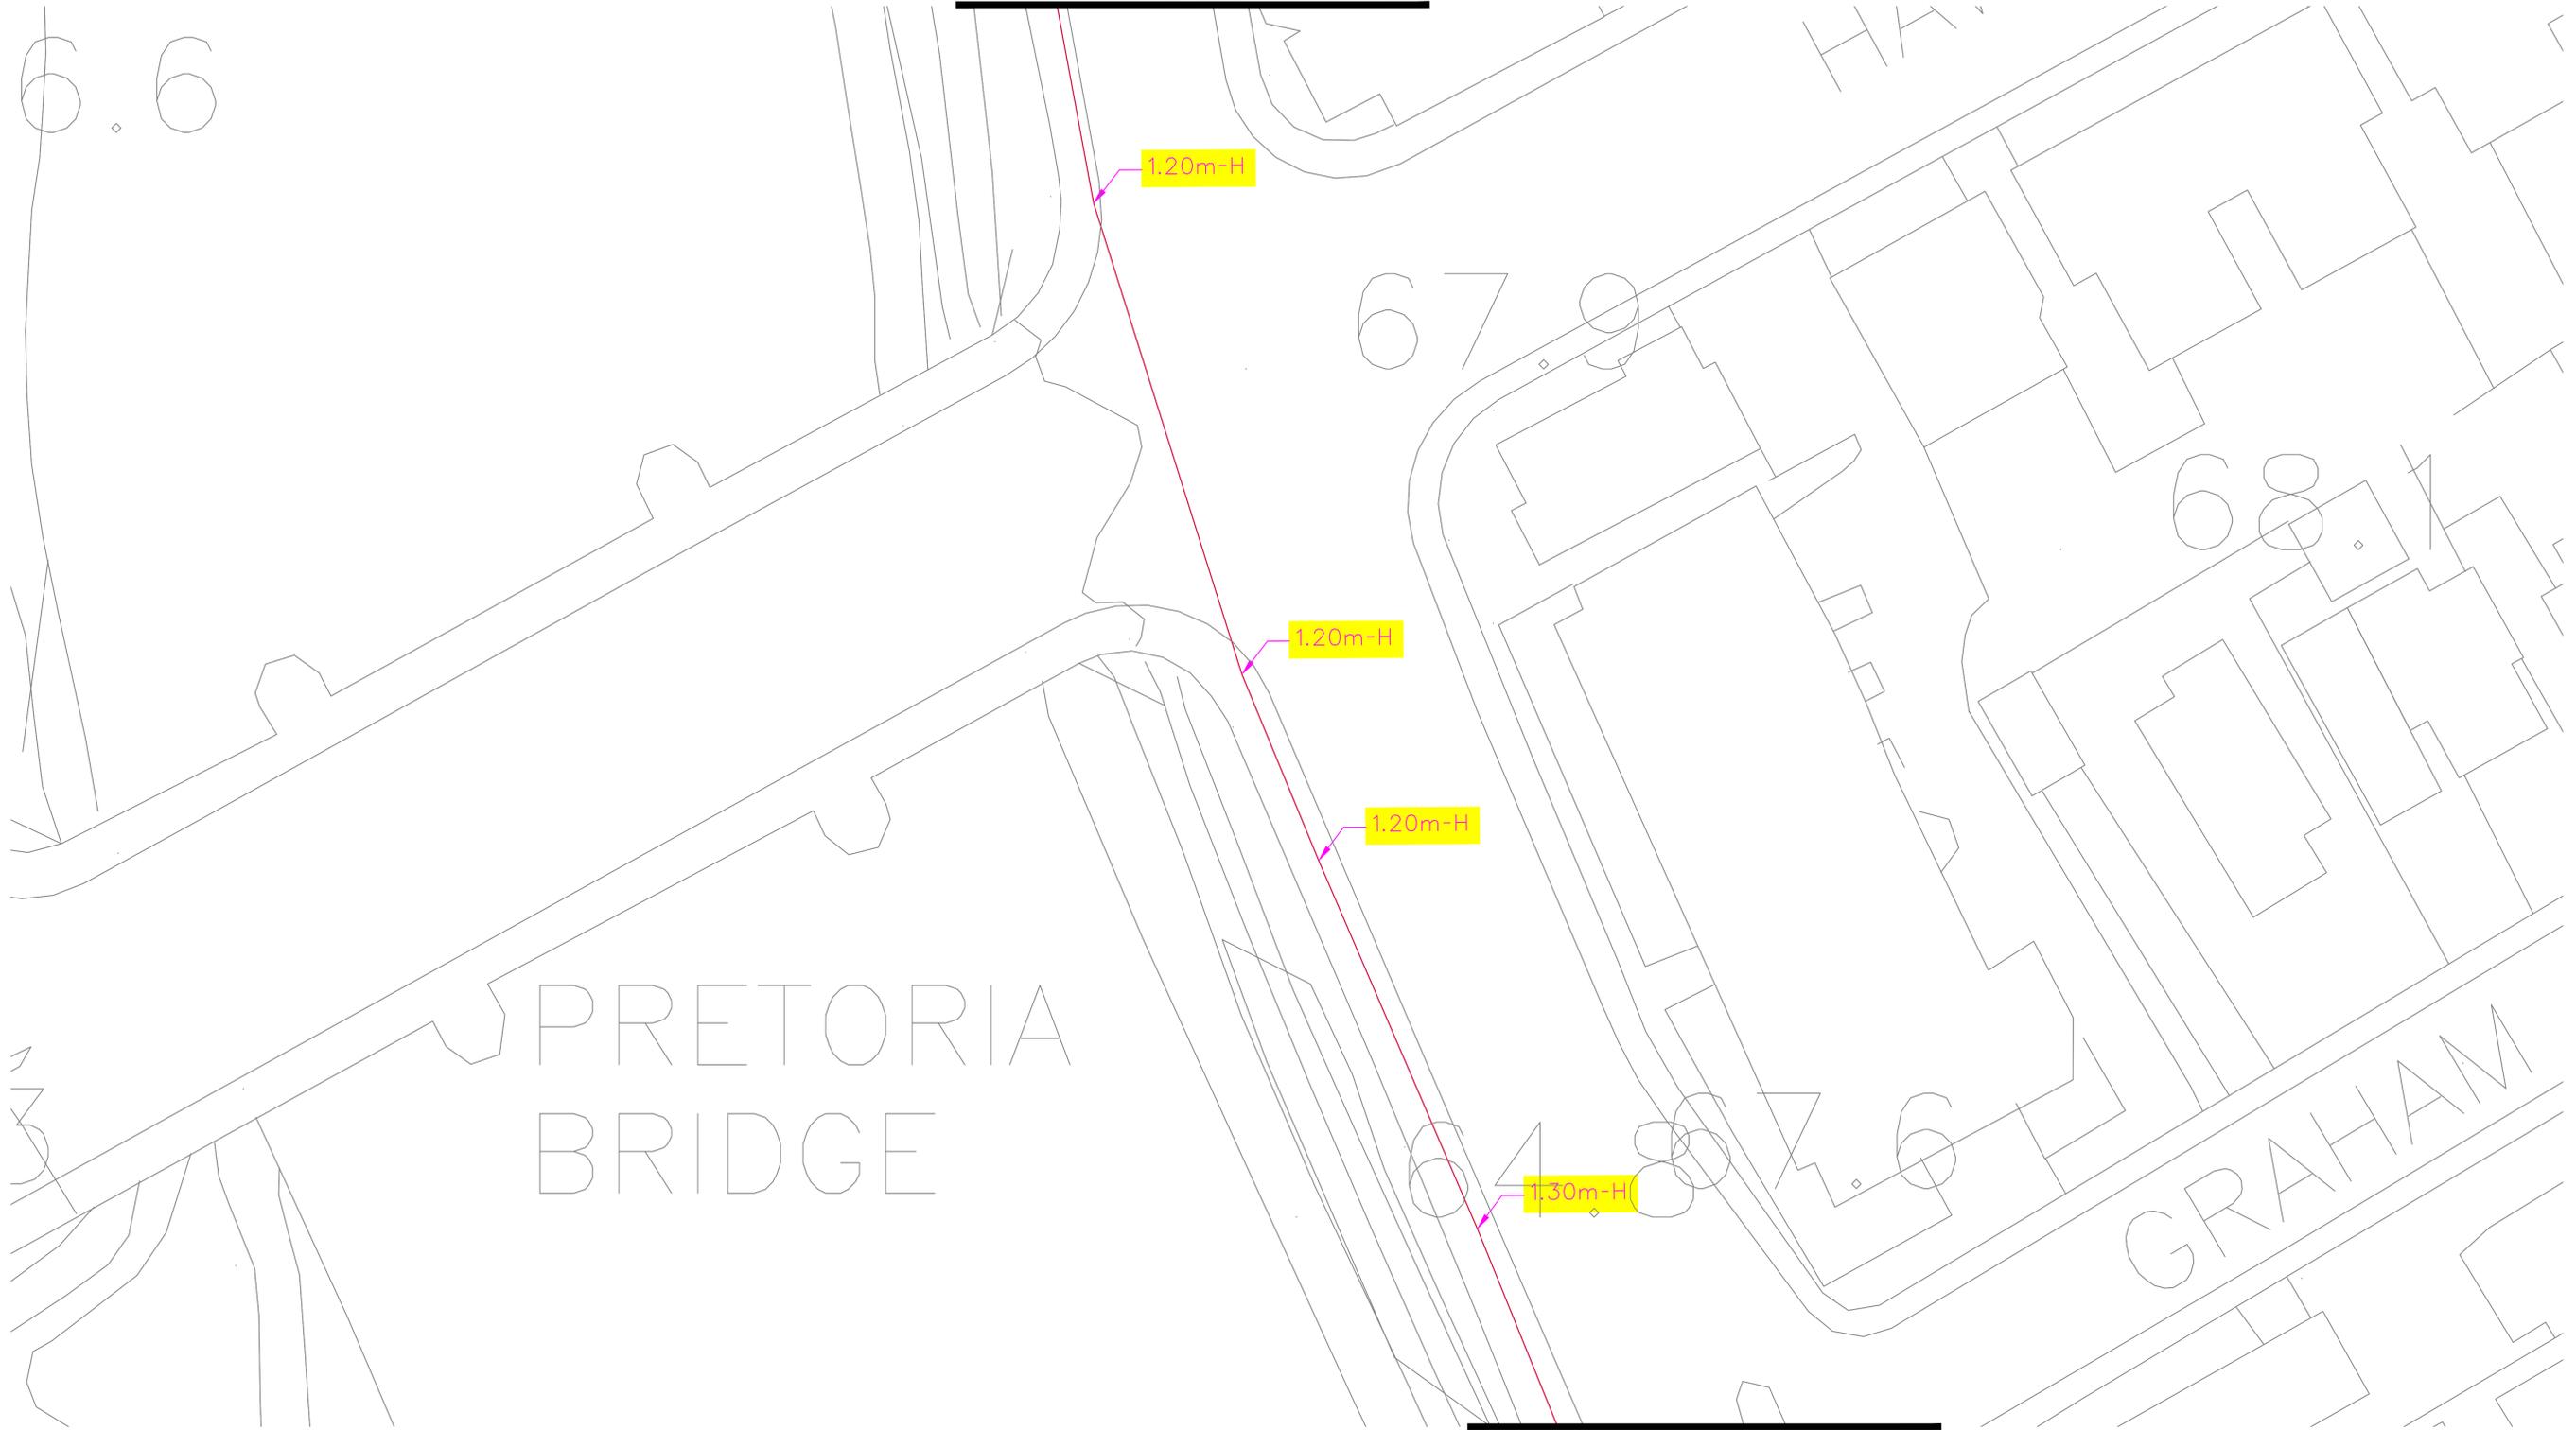

MATCHLINE
(SEE SHEET 10 OF 14)

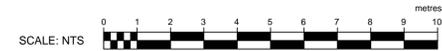

GLOSSARY

CSE	- CONFINED SPACE ENTRY
SAN	- SANITARY
STM	- STORM
INV	- INVERT
OBV	- OBVERT
BOC	- BOTTOM OF CHAMBER
EORI	- END OF RECORD INFORMATION
AATUR	- UTILITY ABANDONED ACCORDING TO UTILITY RECORDS
EOI	- END OF SURFACE GEOPHYSICAL INFORMATION
T/G	- TOP OF GRATE ELEVATION

Data presented herein is subject to multiVIEW's terms and conditions as listed on the final page of the contract drawings.

THE LOCATION OF UNDERGROUND SERVICES SHOULD BE VERIFIED PRIOR TO EXCAVATION. UTILITY LOCATES ARE REQUIRED PRIOR TO ANY EXCAVATION ACTIVITY.

SUBSURFACE UTILITY ENGINEERING
HYDRO EXCAVATION & CCTV
CONCRETE SCANNING
UTILITY LOCATES
NEAR-SURFACE GEOPHYSICS

Tel: 1-800-363-3116
Fax: 1-905-571-5946
www.multiVIEW.ca
325 Matheson Blvd East
Mississauga, ON, L4Z1X8

Project No.: 40410	Date: 2018-07-23	Drawn/Checked By: RF/JH	Appr: -
For: PARKS CANADA INFRASTRUCTURE			
Site: CI/ASCE 38-02 LEVEL 'B' SUE INVESTIGATION RIDEAU CANAL, OTTAWA, ON			

Subsurface Utility Engineering CI/ASCE 38-02 Quality Levels

QL'A: Visual verification of utility location and depth using excavation methods. i.e. Hydrovac.
QL'B: Utility located using surface geophysical methods i.e. electronically applied or induced magnetic field using specific utility locate equipment or ground penetrating radar.
QL'C: Utility plotted using record information in conjunction with a visual field survey of utility furniture.
QL'D: Utility plotted using record information only. This can include oral recollection.

- NOTES**
- This information is provided for design purposes only.
 - All inverts shown on this plan by multiVIEW Locates Inc. are in meters and were measured from the top of the manhole and/or catch basin lids.
 - Subsurface utility information shown on this drawing was obtained on a best effort, best practices basis, within the technical limitations of the instrumentation.
 - Utilities shown on this map by multiVIEW Locates Inc. were located using ASCE 38-02 Quality Level 'B' methods unless otherwise noted. All other information hereon has been supplied by others and is not certified.
 - Third party information provided on these drawings are for the convenience of use but do not constitute information obtained and delivered by multiVIEW Locates Inc. during the course of this project.
 - Elevations represented for this study were obtained by multiVIEW Locates Inc. utilizing datum derived by differential GPS observations and referred to the CAN-NET Reference Network.


UTILITY CODES

--- H --- Hydro Cable
1.20m-H Utility Depth

ALL UTILITIES ARE UNDERGROUND UNLESS OTHERWISE SPECIFIED

SHEET 11 of 14

Rev. No.	Drawn By	Checked By	Date	Revision
-	-	-	-	-
-	-	-	-	-
-	-	-	-	-
-	-	-	-	-

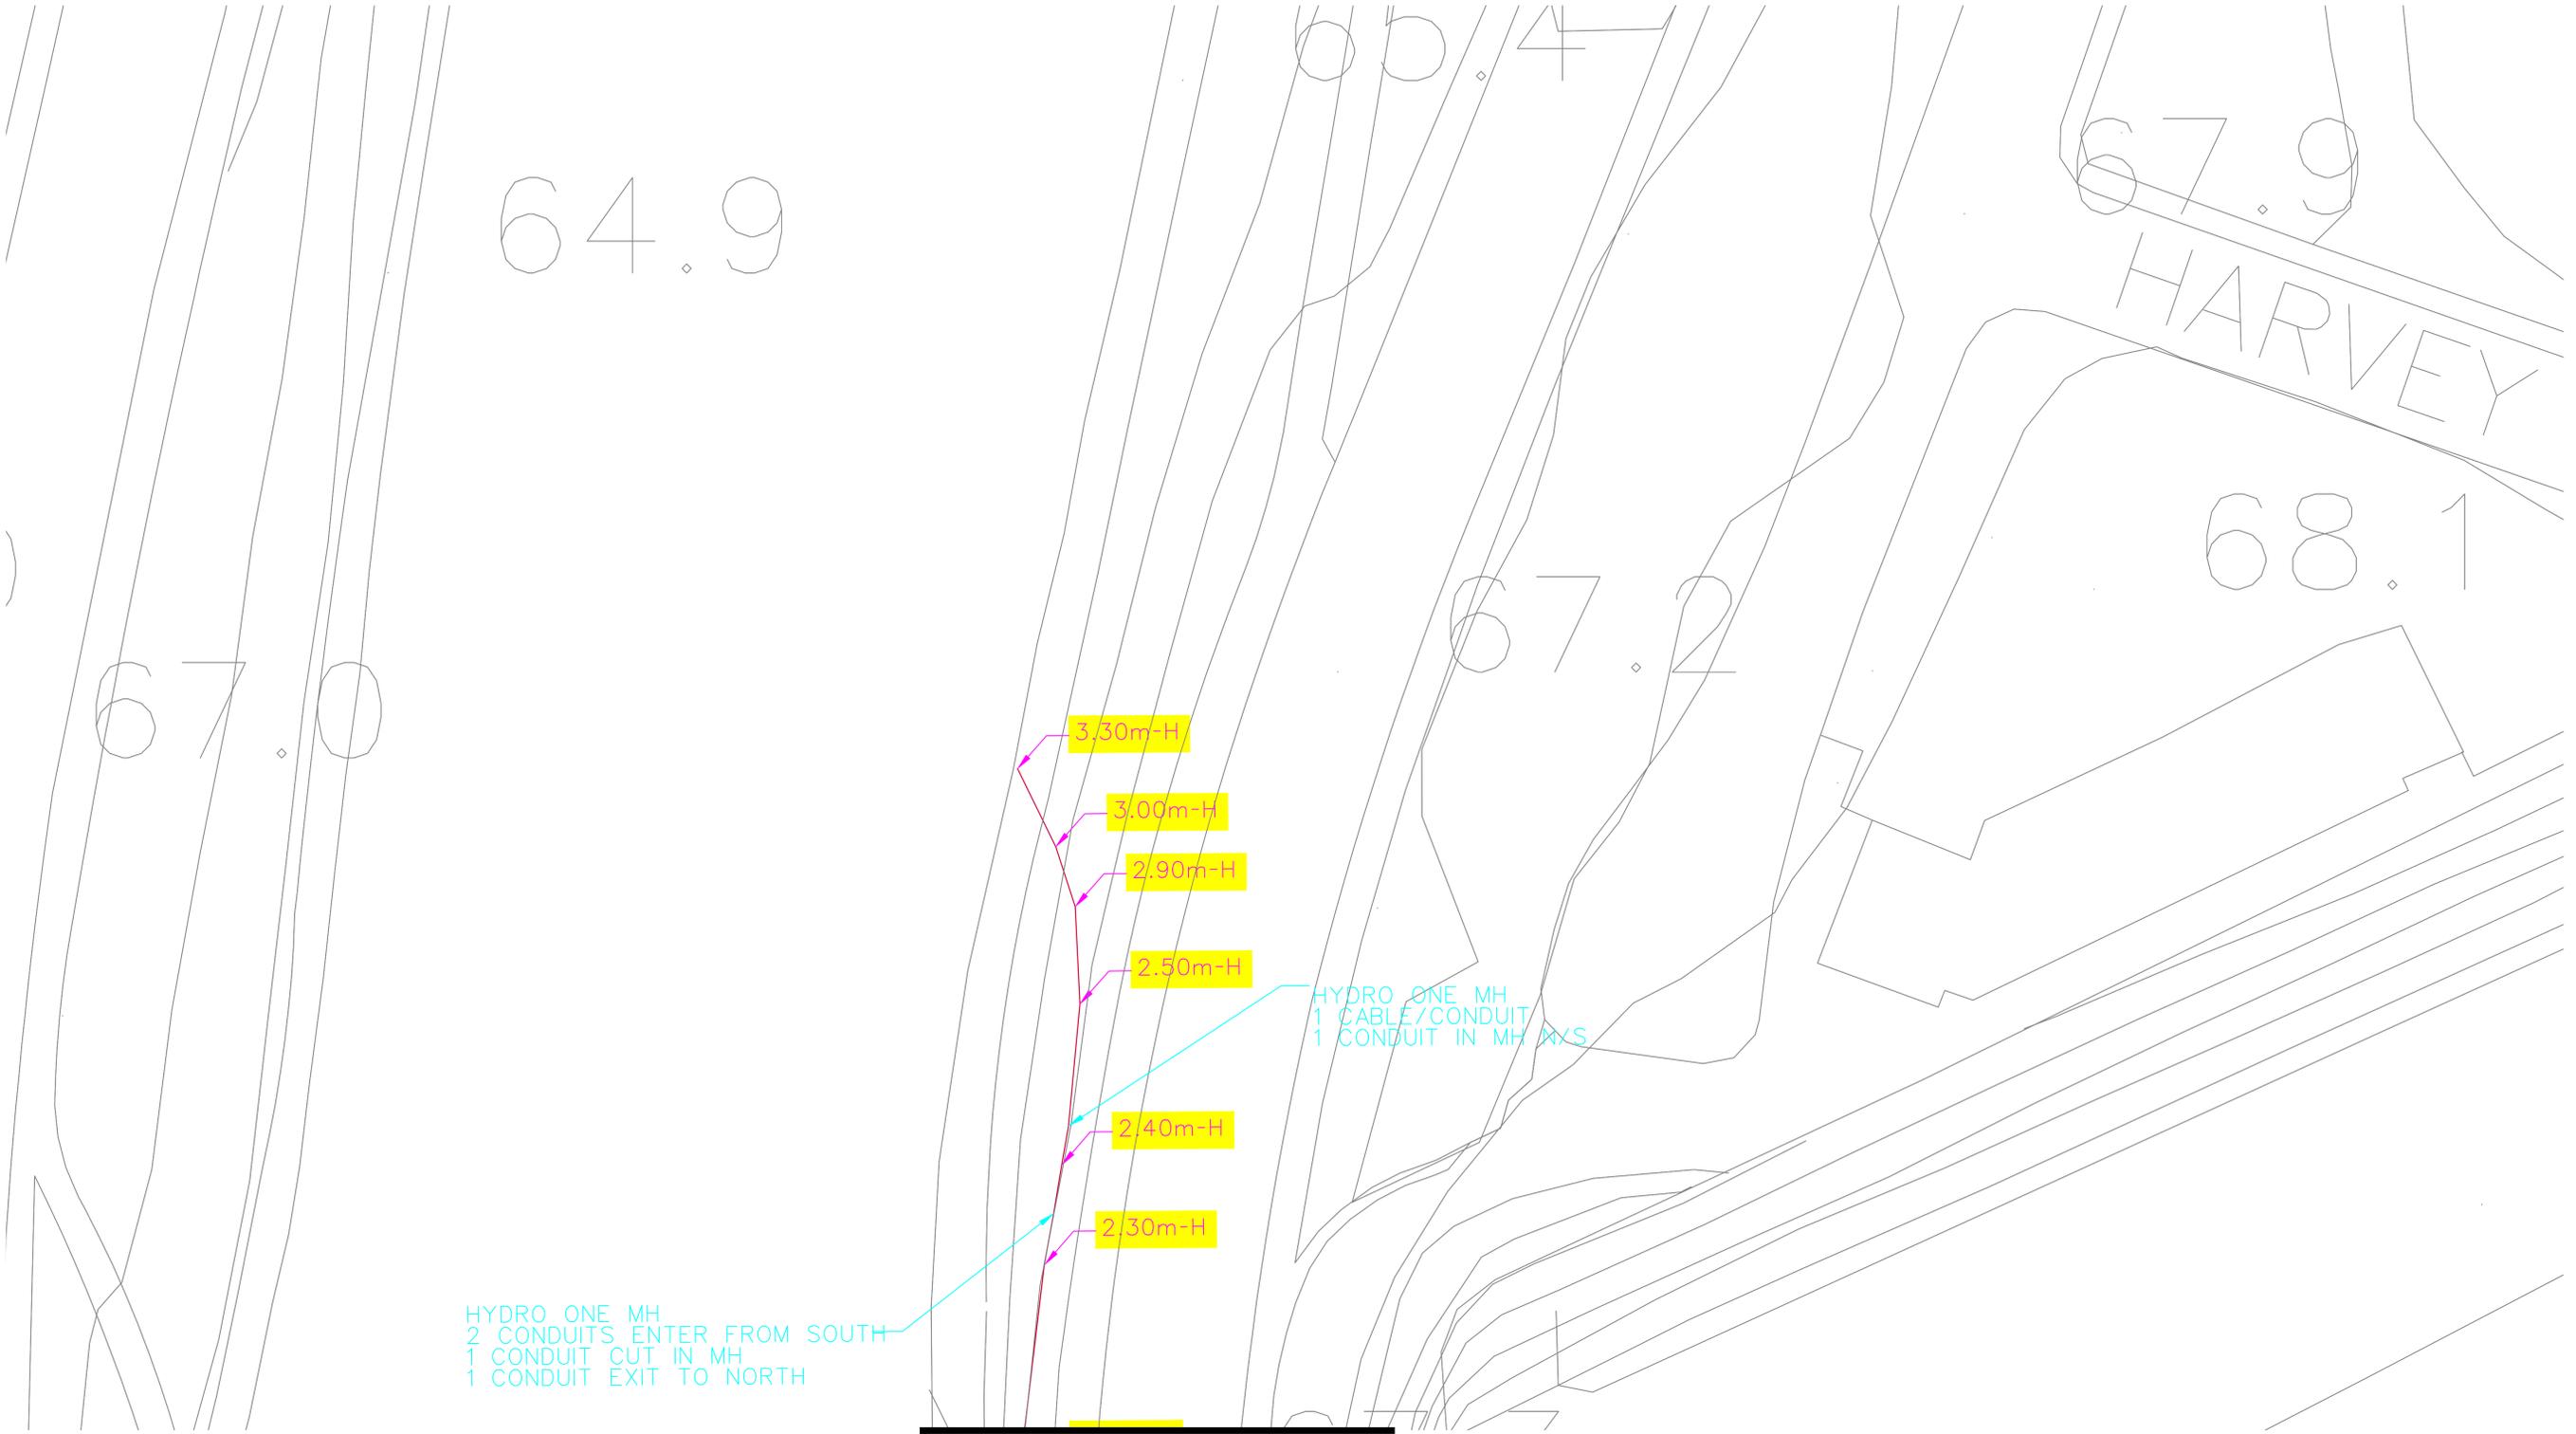

HYDRO ONE MH
 2 CONDUITS ENTER FROM SOUTH
 1 CONDUIT CUT IN MH
 1 CONDUIT EXIT TO NORTH

HYDRO ONE MH
 1 CABLE/CONDUIT
 1 CONDUIT IN MH XYS

MATCHLINE
 (SEE SHEET 12 OF 14)



GLOSSARY

CSE	- CONFINED SPACE ENTRY
SAN	- SANITARY
STM	- STORM
INV	- INVERT
OBV	- OBVERT
BOC	- BOTTOM OF CHAMBER
EORI	- END OF RECORD INFORMATION
AATUR	- UTILITY ABANDONED ACCORDING TO UTILITY RECORDS
EOI	- END OF SURFACE GEOPHYSICAL INFORMATION
T/G	- TOP OF GRATE ELEVATION

Data presented herein is subject to multiVIEW's terms and conditions as listed on the final page of the contract drawings.

THE LOCATION OF UNDERGROUND SERVICES SHOULD BE VERIFIED PRIOR TO EXCAVATION. UTILITY LOCATES ARE REQUIRED PRIOR TO ANY EXCAVATION ACTIVITY.

SUBSURFACE UTILITY ENGINEERING
 HYDRO EXCAVATION & CCTV
 CONCRETE SCANNING
 UTILITY LOCATES
 NEAR-SURFACE GEOPHYSICS

Tel: 1-800-363-3116
 Fax: 1-906-571-5946
 www.multiVIEW.ca
 325 Matheson Blvd East
 Mississauga, ON, L4Z1X8

Project No.: 40410	Date: 2018-07-23	Drawn/Checked By: RF/JH	Appr: -
For: PARKS CANADA INFRASTRUCTURE			
Site: CI/ASCE 38-02 LEVEL 'B' SUE INVESTIGATION RIDEAU CANAL, OTTAWA, ON			

Subsurface Utility Engineering CI/ASCE 38-02 Quality Levels

QL'A: Visual verification of utility location and depth using excavation methods. i.e. Hydrovac.
 QL'B: Utility located using surface geophysical methods i.e. electronically applied or induced magnetic field using specific utility locate equipment or ground penetrating radar.
 QL'C: Utility plotted using record information in conjunction with a visual field survey of utility furniture.
 QL'D: Utility plotted using record information only. This can include oral recollection.

NOTES

- This information is provided for design purposes only.
- All inverts shown on this plan by multiVIEW Locates Inc. are in meters and were measured from the top of the manhole and/or catch basin lids.
- Subsurface utility information shown on this drawing was obtained on a best effort, best practices basis, within the technical limitations of the instrumentation.
- Utilities shown on this map by multiVIEW Locates Inc. were located using ASCE 38-02 Quality Level 'B' methods unless otherwise noted. All other information hereon has been supplied by others and is not certified.
- Third party information provided on these drawings are for the convenience of use but do not constitute information obtained and delivered by multiVIEW Locates Inc. during the course of this project.
- Elevations represented for this study were obtained by multiVIEW Locates Inc. utilizing datum derived by differential GPS observations and referred to the CAN-NET Reference Network.

UTILITY CODES

--- H --- Hydro Cable
 [Yellow Box] Utility Depth

ALL UTILITIES ARE UNDERGROUND UNLESS OTHERWISE SPECIFIED

SHEET 13 of 14

Rev. No.	Drawn By	Checked By	Date	Revision
-	-	-	-	-
-	-	-	-	-
-	-	-	-	-
-	-	-	-	-

Technical Limitations

- Throughout this schedule, "multiVIEW" is the corporate entity multiVIEW Locates Inc.
- Pipe, cable, conduit, rebar, post-tension cables, anchors, containers, vaults, tanks and similar objects that are buried under the ground or embedded within a structure are referred to, in multiVIEW's terms and conditions, as Buried Assets.
- Subsurface conditions such as depth to bedrock, change in soil type, presence of karst, voids, contaminated soil or groundwater, residual construction or industrial debris or buried waste are referred to, in multiVIEW's terms and conditions, as Buried Liabilities.
- The Client acknowledges that the laws of fundamental physics apply, and as such, acknowledge that sensing instruments cannot detect all Buried Assets and Buried Liabilities. Buried Assets and Buried Liabilities which are detectable by properly deployed and operated instruments are termed Locatable Buried Assets and Locatable Buried Liabilities. Buried Assets and Buried Liabilities which are not clearly detectable due to the laws of fundamental physics are termed Unlocatable Buried Assets and Unlocatable Buried Liabilities. multiVIEW follows industry best-practice procedures but is not responsible for determining the presence and location of Unlocatable Buried Assets or Unlocatable Buried Liabilities.
- Instruments that are used to locate Buried Assets employ a variety of approaches to detect and infer the location of Buried Assets. Standard pipe and cable locating instruments detect the magnetic fields associated with the electrical current flowing in the Buried Asset. Ground Penetrating Radar (GPR) techniques depend on the transmission of radio waves into the host material and detection of waves reflected back from the Buried Assets. Sounding methods require the insertion of a source of magnetic field into the pipe or conduit and detection of the magnetic field created by source at the surface of the Work Area to locate the sonde position. For the purposes of this estimate, Locatable Buried Assets are normally characterized as:
 - metallic pipes, cables and conduits that are capable of carrying electrical current and can be physically accessed to allow an energizing current source to create an electrical current in the Buried Asset of sufficient magnitude as to be detectable by standard locating instruments;
 - metallic pipes, cables and conduits that actively carry an identifiable electric current that is sufficiently large and has suitable frequency as to be detectable by standard locating instruments;
 - metallic and non-metallic pipes, cables, conduits, rods, bars, wires, voids, and inclusions that represent a substantive electrical contrast to the host material and are embedded in a host material transparent to radio waves such that radio waves reflected from the features are detectable by a GPR instrument;
 - non-metallic pipes, cables and conduits (e.g., composed of plastic, concrete, asbestos, clay, etc.) which have continuous associated tracer wire capable of carrying an electrical current and can be physically accessed to allow an energizing current source to create an electrical current in the tracer wire of sufficient magnitude as to be detectable by standard cable locating instruments;
 - non-metallic pipes, cables and conduits which have continuous associated tracer wire capable of carrying an electrical current and that naturally carries an electrical current of sufficient magnitude and suitable frequency as to be detectable by standard cable locating instruments;
 - open pipe and conduits that can be accessed by a sonde and are sufficiently shallow to permit detectable magnetic fields to be sensed at the surface of the Work Area;

Examples of Unlocatable Buried Assets include, but are not limited to, the following:

 - pipes, cables and conduits whose depth of burial is too great and/or are overlain by or in proximity to metallic material which results in signal distortion thus preventing physically measurable signals at the surface or where burial material interferes with current generation and signal emissions;
 - normally Locatable Buried Assets situated in or emerging from, an area which is an Inaccessible Area.
 - normally Locatable Buried Assets with a break or breaks to the electrical continuity of any metallic pipe, cable or tracer wire (e.g., segmented lengths, corroded connections, section of plastic repair, etc.);
 - non-metallic pipe, cable and conduits which do not have a continuous and/or accessible associated tracer wire;
 - the host material is opaque to radio waves;
- Buried Assets that are normally characterized as Locatable become Unlocatable when either ambient interfering electromagnetic fields or the material surrounding and/or enclosing and/or above the Buried Asset disrupt the energizing current or the normal operation of the sensing instrument.

6. Instruments used to locate Buried Liabilities employ a variety of approaches to detect and infer the location of the Buried liability. Magnetometers detect the distortion in the local magnetic field induced by the presence of some types of Buried Liabilities. Ground Penetrating Radar (GPR) techniques depend on the transmission of radio waves into the host material and detection of waves reflected back from the Buried Liability. In some cases, the lack of reflected GPR signal can be a Buried Liability indicator. Electromagnetic induction methods use electromagnetic induction to induce current flow in the subsurface and detect the resulting magnetic fields that are associated with these induced currents to identify Buried Liabilities. Electrical resistivity measurements use direct connect to pass current through host material and map out distortions in the current flow to indicate changes in the subsurface that may indicate the presence of Buried Liabilities. For the purposes of this estimate, Locatable Buried liabilities are normally characterized as those features that will create a discernable change to the response of the measuring instrument and which differ in character from the background surrounding environment (that is, the features create an Anomalous Response) when industry best practices are followed.

7. The Client acknowledges that the laws of fundamental physics apply and that equipment is subject to measurement distortions that are site specific resulting in limited precision when determining positional coordinates. multiVIEW will use best-practice procedures but is not responsible for determining the location of Buried Assets or Buried Liabilities to an accuracy better than what is typical of normal locate instruments.

8. Determination of type, composition, depth or size of the Buried Assets or Buried Liabilities is not possible and does not constitute part of this service. Identification of type (e.g., gas, electric, communications, etc.) of a specific Buried Asset is not technically possible except by visual observation of surface appurtenance or excavation and visual exposure of the Buried Asset. Inferences drawn by correlating data with records and as-built drawings can be offered but such inferences are provide don a best effort basis with no guarantee of correctness.

9. Client acknowledges the critical nature of having access to energized Buried Assets to enable locating and assumes full responsibility for identifying and providing access to any and all points necessary for the energization of Buried Assets, (including the provision of licensed plumbing, electrical or confined space entry (CSE) personnel if required and which adhere to multiVIEW health and safety procedures). multiVIEW accepts no responsibility for locating any Buried Asset for which access and/or appropriate workplace safety measures are not provided.

10. Individual Locatable Buried Assets are deemed Unlocatable Buried Assets where there are numerous Buried Assets clustered together either vertically and/or horizontally ("Clustered Utilities") which renders the identification of individual elements physically impossible. multiVIEW is not responsible for identifying the individual Buried Assets in such situations.

11. Non-metallic pipe and cable (e.g., fiber-optic system, etc.) are Unlocatable Buried Assets for standard locating instruments unless either an unbroken tracer wire or continuous metallic sheathing surrounding such buried plant is easily accessible from the surface. The Client must provide direct and simple access to every traceable wire or continuous metallic sheathing. Otherwise, multiVIEW accepts neither liability nor responsibility for locating such features since they are deemed Unlocatable.

12. Non-metallic pipe and conduits (e.g., plastic, concrete, asbestos, clay, etc.) under pressure (e.g., water, gas, force main system, etc.) are Unlocatable Buried Assets for standard cable locating instruments unless an unbroken tracer wire is attached to the pipe and this tracer wire is easily accessible from the surface. The Client must provide direct and simple access to every traceable wire.

13. Non-pressurized, non-metallic (e.g., plastic, concrete, asbestos, clay, etc.) conduits or pipe (e.g., sewers, drains, empty ducts, etc.) are Unlocatable Buried Assets unless a transmitting sonde can be inserted throughout the full length of the pipe or conduit. It is the responsibility of the Client to identify and provide direct access to any and all access points for such lines, (including the provision of licensed plumbing, electrical or confined space entry (CSE) personnel if required). multiVIEW accepts no responsibility for locating such lines where the Client does not provide access and/or appropriate workplace safety measures.

14. Any Buried Asset incapable of generating a reflected radar wave detectable by a GPR instrument is an Unlocatable Buried Asset.

15. All or part of a Work Area is defined as an Inaccessible Area when it is inaccessible for surveying. Inaccessible Areas include the following: those covered by a structure or object (e.g., buildings, vehicles, debris, stockpiled snow, building materials, etc.); those covered by open water; those covered by woods, vegetation, or snow too thick to permit easy walking; those where the surface terrain slopes steeper than 1:2; those where the safety of the operator is jeopardized (e.g., unstable footing, environmental hazards, uncontrolled roads, etc.). The final decision for defining an area as an Inaccessible Area rests with the multiVIEW Health & Safety Officer.

Liability Limitations

- Locations and mapping services, marks, reports and results provided by multiVIEW cannot substitute as a legally defined Buried Assets location in a jurisdiction where government regulations dictate that the Buried Asset owner is solely responsible for identifying and locating their own Buried Assets. In cases where multiVIEW is legally authorized to act on behalf of the Buried Asset owner to locate the owner's Buried Assets, any results provided by multiVIEW will clearly identify that the Buried Asset location is legally authorized on all records, documents, and reports.
- multiVIEW markings of Buried Asset or Buried Liability locations are provided as information to be inputted into the Client's decision-making process. The provision of this information does not relieve the Client, or any other person, or corporation, from liability for damages related to personal injury including death, or for property damage or liability caused to or from any Buried Asset or Buried Liability, within the Work Area.
- Cables carrying DC voltages and/or small diameter cables (e.g., fire alarm or security system, remote signal cables, inaccessible tracer wire, perfectly balanced AC cables, etc.) can only be detected by methods which create electrical currents and signals in the cables. Where a sensitive or dangerous connection is involved, the Client must provide qualified personnel to isolate and enable direct access to these systems. The Client is responsible for defining the impact of locating signals or sensitive electronics. multiVIEW accepts no responsibility for any damage to plant, or any third party, caused by locating signals. Technical information about locating signals is available from multiVIEW upon request.
- multiVIEW is not liable for damages resulting from physical exposure of any Buried Assets or Buried Liabilities by the Client, its representatives, their sub-contractors or any other person or corporation.
- multiVIEW will not accept any liability regarding inaccurate estimates of utility depth secured solely by electronic means since multiVIEW recommends exposure by vacuum excavation if such depth information is critical to the design, engineering or construction of subsequent infrastructure.
- multiVIEW accepts no responsibility and is not liable for damages suffered by any third party as a result of decisions or actions based on the performance of the statement of work by multiVIEW.
- multiVIEW accepts no responsibility and is not liable for conduit blockage, or restoration of the site to pre-survey conditions, as a result of survey practices needed to fulfill the objectives of the Service provided.
- The completeness of the work carried out by multiVIEW is based on information provided by the Client at or prior to the issuance of this Estimate. If the scope of work or size and/or extent of the Work Area changes, a signed Change Order must be issued so that scope of work can be adjusted to address Client requirement changes. Documents and maps provided by multiVIEW are the definitive means of legally defining the extent of the Work Area investigated.
- multiVIEW accepts no responsibility for locating Buried Assets or Buried Liabilities outside the limit of the Work Area or in the Inaccessible Areas.
- Except as written in this contract, multiVIEW disclaims any and all promises, representations, warranties and covenants, express, implied, statutory or otherwise.
- multiVIEW shall not be liable for any amount in excess of the fees paid by the Client to multiVIEW for the work described in this estimate on account of any direct or indirect loss, injury, death, or damage to a person or property irrespective of the cause or origin of such loss, injury, death or damage. This includes, without limitation, loss, injury, death or damage attributable to the negligence of multiVIEW, its employees and agents in the performance or non-performance of the Service.

12. In any action, claim, loss or damage arising out of the work for which this estimate is provided, the Client agrees that multiVIEW Locates Inc.'s liability will be 'several' and not 'joint and several' and the Client may only claim payment from multiVIEW Locates Inc. in the amount of multiVIEW Locate Inc.'s proportionate share of the total liability based on degree of fault. Any action against multiVIEW Locates Inc. must be commenced on or before the date which is the earlier of: i) eighteen months from the date on which the work in this estimate is completed and, ii) the date by which an action must be commenced under any applicable legislation other than limitation legislation. In no event shall multiVIEW Locates Inc. be liable to the Client whether the claim be tort, contract or otherwise, for an amount in excess of the fees paid by the Company for the services work provided. In no event shall multiVIEW Locates Inc. be liable to the Client, whether a claim be tort, contract or otherwise for any consequential, indirect, lost profit or similar damages, or failure to realize expected savings. multiVIEW Locates Inc. will use all reasonable efforts to complete the performance of the services described herein within the agreed upon time frame. However, multiVIEW Locates Inc. shall not be liable for failures or delays in performance that arise from causes beyond its control, including the untimely performance or non-performance by the Client or its obligations.

	THE LOCATION OF UNDERGROUND SERVICES SHOULD BE VERIFIED PRIOR TO EXCAVATION. UTILITY LOCATES ARE REQUIRED PRIOR TO ANY EXCAVATION ACTIVITY.	Project No.:	Date:	Drawn/Checked By:	Appr:	SHEET 14 of 14					
		40410	2018-07-23	RF/JH	PA						
For:					PARKS CANADA INFRASTRUCTURE						
Site:					CI/ASCE 38-02 LEVEL 'X' SUE INVESTIGATION RIDEAU CANAL, OTTAWA, ON TERMS & CONDITIONS						
SUBSURFACE UTILITY ENGINEERING HYDRO EXCAVATION & CCTV CONCRETE SCANNING UTILITY LOCATES NEAR-SURFACE GEOPHYSICS							Tel: 1-800-363-3116 Fax: 1-906-571-5946 www.multiVIEW.ca 325 Matheson Blvd East Mississauga, ON, L4Z1X8				