



**RETURN BIDS TO:**

**RETOURNER LES SOUMISSIONS À:**

Bid Receiving Public Works and Government  
Services Canada/Réception des soumissions Travaux  
publics et Services gouvernementaux Canada  
Room 310,  
269 Main Street,  
Winnipeg  
Manitoba  
R3C 1B3  
Bid Fax: (204) 983-0338

**SOLICITATION AMENDMENT  
MODIFICATION DE L'INVITATION**

The referenced document is hereby revised; unless otherwise  
indicated, all other terms and conditions of the Solicitation  
remain the same.

Ce document est par la présente révisé; sauf indication contraire,  
les modalités de l'invitation demeurent les mêmes.

**Comments - Commentaires**

**Vendor/Firm Name and Address**  
Raison sociale et adresse du  
fournisseur/de l'entrepreneur

**Issuing Office - Bureau de distribution**  
Public Works and Government Services Canada -  
Western Region  
Room 310,  
269 Main Street,  
Winnipeg  
Manitoba  
R3C 1B3

<b>Title - Sujet</b> Furniture	
<b>Solicitation No. - N° de l'invitation</b> ET025-201146/A	<b>Amendment No. - N° modif.</b> 004
<b>Client Reference No. - N° de référence du client</b> ET025-201146	<b>Date</b> 2019-10-28
<b>GETS Reference No. - N° de référence de SEAG</b> PW-\$WPG-006-10882	
<b>File No. - N° de dossier</b> WPG-9-42078 (006)	<b>CCC No./N° CCC - FMS No./N° VME</b>
<b>Solicitation Closes - L'invitation prend fin</b> <b>at - à 02:00 PM</b> <b>on - le 2019-11-12</b>	<b>Time Zone</b> Fuseau horaire Central Daylight Saving Time CDT
<b>F.O.B. - F.A.B.</b> <b>Plant-Usine:</b> <input type="checkbox"/> <b>Destination:</b> <input checked="" type="checkbox"/> <b>Other-Autre:</b> <input type="checkbox"/>	
<b>Address Enquiries to: - Adresser toutes questions à:</b> Graham, Danielle	<b>Buyer Id - Id de l'acheteur</b> wpg006
<b>Telephone No. - N° de téléphone</b> (204) 292-2872 ( )	<b>FAX No. - N° de FAX</b> (204) 983-7796
<b>Destination - of Goods, Services, and Construction:</b> <b>Destination - des biens, services et construction:</b>	

**Instructions: See Herein**

**Instructions: Voir aux présentes**

<b>Delivery Required - Livraison exigée</b>	<b>Delivery Offered - Livraison proposée</b>
<b>Vendor/Firm Name and Address</b> Raison sociale et adresse du fournisseur/de l'entrepreneur	
<b>Telephone No. - N° de téléphone</b> <b>Facsimile No. - N° de télécopieur</b>	
<b>Name and title of person authorized to sign on behalf of Vendor/Firm</b> <b>(type or print)</b> <b>Nom et titre de la personne autorisée à signer au nom du fournisseur/</b> <b>de l'entrepreneur (taper ou écrire en caractères d'imprimerie)</b>	
<b>Signature</b>	<b>Date</b>

This **amendment # 004** is raised to modify **solicitation # ET025-201146/A** as follows:

**REVISED CLOSING DATE OF:  
02:00 PM on 2019-11-12**

---

1. Items LSHB, LSC1, LSC2, LSB1, LSB2, LSB2A to have low VOC vinyl seats and Crypton or Nanotex finished fabric backs. Item LC1A to have Crypton or Nanotex finished upholstery for the seat and back. Crypton or Nanotex finished fabrics to be five (5) grades above standard fabric range, with small scale geometric pattern, minimum three (3) colours in pattern.
2. Upgraded design requirements (such as Crypton or Nanotex finished fabric, knife edge details, etc.) as described in the Spec Information column of the furniture schedules are to be included in the bid pricing.
3. Use an off-white high pressure laminate. Colour to be chosen from the manufacturer's standard range.
4. Laminate surfaces to be high pressure laminate.
5. **DELETE:** All tables in their entirety  
**INSERT:** The following tables,

## Product Category 6 - TABLES

**Table 1a – Products - TABLES**

**PHASE 1**

Section A - IU REQUIREMENT				Section B – SUPPLIER'S BID		
#	GoCUID	Description of Product <i>(Additional product details may be inserted, if required as per 6B. 4.1 of the SA)</i>	Qty	Supplier Part Number	Firm Unit Price** \$	Extended Total [Qty x Price] \$
1.	6CCTVAROLL36XXXJNXX (line 137)	Collaborative Tables	11		\$	\$
2.	6CLTVARZXLW7<36ONXX (line 484)	Collaborative Tables	48		\$	\$
3.	6CLTVARZXLW7<36ONXX (line 484)	Collaborative Tables	13		\$	\$
4.	6CCTVAROPL30XXXJNXX (line 146)	Collaborative Tables	2		\$	\$
5.	6ZFHLXX24L42HSDSDKX (line 103)	Credenzas	8		\$	\$
6.	6MMTSMROPL30XXXWN NX (line 1)	Mtg-Training Rm Tables	7		\$	\$
7.	6MTRFTRECL30L60WYYY (line 1373)	Mtg-Training Rm Tables <b>the modesty panel can be laminate.</b>	52		\$	\$

8.	6MMTMDREOL42L96WY NX (line 61)	Mtg-Training Rm Tables	1		\$	\$
9.	6MMTMDREOL42120WY NX (line 65)	Mtg-Training Rm Tables	6		\$	\$
10.	6MMTSMSQPL30L30WN NXX (line 7)	Mtg-Training Rm Tables	15		\$	\$
<i>Add more rows if necessary.</i>					Product Total	\$
<b>NSA products</b> <i>(must not exceed 30% of the firm quantity by category)</i> The Supplier signs, and certifies that all the NSA products offered will conform to all specifications and meet the testing requirements detailed at Annex D.						
Section A - IU REQUIREMENT				Section B – SUPPLIER'S BID		
#	NSA Product(s) Description	Qty	Supplier Part Number	Firm Unit Price** \$	Extended Total [Qty x Price] \$	
1	Mtg-Training Rm Tables (T2436) Technical specifications to be used from GOCUID 6MMTSMREPL24L42WNNX but in size: Table at High Back Privacy Booths 24"x36"x29"h w/18" diam. disc base. Final table size: 24"x36"	12		\$	\$	
<i>Add more rows if necessary.</i>					Product Total	\$

**Table 1b – Products - TABLES  
PHASE 2**

Section A - IU REQUIREMENT				Section B – SUPPLIER'S BID		
#	GoCUID	Description of Product <i>(Additional product details may be inserted, if required as per 6B. 4.1 of the SA)</i>	Qty	Supplier Part Number	Firm Unit Price** \$	Extended Total [Qty x Price] \$
1.	6CCTVAROLL36XXXJNXX (line 137)	Collaborative Tables	12		\$	\$
2.	6CLTVARZXLW7<36ONXX (line 484)	Collaborative Tables	54		\$	\$
3.	6CLTVARZXLW7<36ONXX (line 484)	Collaborative Tables	13		\$	\$
4.	6ZFHLXX24L42HSDSDKX (line 103)	Credenzas	7		\$	\$
5.	6MMTSMROPL30XXXWN NX (line 1)	Mtg-Training Rm Tables	13		\$	\$

6.	6MTRFTRECL30L60WYYY (line 1373)	Mtg-Training Rm Tables <b>the modesty panel can be laminate.</b>	65		\$	\$
7.	6MMTMDREOL42120WY NX (line 65)	Mtg-Training Rm Tables	4		\$	\$
8.	6MMTSMSQPL30L30WN NXX (line 7)	Mtg-Training Rm Tables	9		\$	\$
<i>Add more rows if necessary.</i>					Product Total	\$
<b>NSA products (must not exceed 30% of the firm quantity by category)</b>						
The Supplier signs, and certifies that all the NSA products offered will conform to all specifications and meet the testing requirements detailed at Annex D.						
Section A - IU REQUIREMENT			Section B – SUPPLIER'S BID			
#	NSA Product(s) Description	Qty	Supplier Part Number	Firm Unit Price** \$	Extended Total [Qty x Price] \$	
	Mtg-Training Rm Tables (T2436) Technical specifications to be used from GOCUID 6MMTSMREPL24L42WNNX but in size: Table at High Back Privacy Booths 24"x36"x29"h w/18" diam. disc base. Final table size: 24"x36"	15		\$	\$	
<i>Add more rows if necessary.</i>				Product Total	\$	

**Table 2 – Delivery - TABLES**

Section A - IU REQUIREMENT				Section B – SUPPLIER'S BID	
Product tables	Location	Desired Date** (Y/M/D)	Desired Time: Normal Business Hours Or Outside Normal Business Hours *	Supplier will supply and deliver as per below**	Firm Lot Price \$
Table 1a PHASE 1	<i>360 Main Street, Winnipeg, MB  Floor 3, 4, 5, 9, 13</i>	<i>Between January 3 to February 20 2020</i>	<i>[Outside]</i>	<i>_____ : weeks  Standard Lead time is between 6-10 weeks for furniture delivery and installation.</i>	\$
Table 1b PHASE 2	<i>360 Main Street, Winnipeg, MB  Floor 6,7,8,10</i>	<i>Between September 17 to November 4 2020</i>	<i>[Outside]</i>	<i>_____ : weeks  Standard Lead time is between 6-10 weeks</i>	\$

				<i>for furniture delivery and installation.</i>	
<p>*Normal Business Hours 8:00 – 17:00, as per SA, Annex A, article 5</p> <p>**The Project Authority (PA) will provide the supplier the authority to proceed prior to the finalized delivery date taking into consideration the delivery time provided by the supplier. Canada will not be responsible if the supplier chooses to proceed without the PA authorization.</p> <p><i>Add more rows if necessary.</i></p>				Delivery Total:	\$

**Table 3 – Installation - TABLES**

Section A - IU REQUIREMENT				Section B – SUPPLIER'S BID	
Product tables	Location	Desired Date** (Y/M/D)	Desired Time: Normal Business Hours Or Outside Normal Business Hours *	Supplier will install as per below**	Firm Lot Price \$
Table 1a PHASE 1	<i>360 Main Street, Winnipeg, MB</i>  <i>Floor 3, 4, 5, 9, 13</i>	<i>Between January 3 to February 20 2020</i>	<i>[Normal]</i>	_____ : weeks from date of supply and delivery  <i>Standard Lead time is between 6-10 weeks for furniture delivery and installation.</i>	\$
Table 1b PHASE 2	<i>360 Main Street, Winnipeg, MB</i>  <i>Floor 6,7,8,10</i>	<i>Between September 17 to November 4 2020</i>	<i>[Normal]</i>	_____ : weeks from date of supply and delivery  <i>Standard Lead time is between 6-10 weeks for furniture delivery and installation.</i>	\$
<p>*Normal Business Hours 8:00 – 17:00, as per SA, Annex A, article 5</p> <p>**The Project Authority (PA) will provide the supplier the authority to proceed prior to the finalized installation date taking into consideration the installation time provided by the supplier. Canada will not be responsible if the supplier chooses to proceed without the PA authorization.</p> <p><i>Add more rows if necessary.</i></p>				Installation Total:	\$

**Table 4 – Optional Product**       Not Applicable  
*If applicable, copy/paste/modify from table 1.*

**Table 5 – Optional Delivery**       Not Applicable

If applicable, copy/paste/modify from table 2.

**Table 6 – Optional Installation**  Not Applicable

If applicable, copy/paste/modify from table 3.

**Table 7 – Standard Finishes and Canada’s Facilities to Accommodate the Delivery and Certifications**

<b>1.</b>	<b>Standard Finishes</b>	
1.1	<p>IU is to consult the Supplier’s Website identified in Part 6A of the SA to view the available finishes.</p> <p>Within ten business days of the contract award, the Project Authority will provide the Contractor with a written notice of Canada’s finish choices for each of the product(s) in Annex A.</p> <p>The Contractor will deliver the products corresponding to Canada’s choice of specific finishes(s). No additional charge will be applied to Canada.</p>	
<b>2.</b>	<b>Canada’s Facilities to Accommodate the Delivery</b>	
	<p><i>The Supplier’s employees and subcontractors requiring access to the site must adhere to the health and safety plans established for the site, in addition to any laws in effect in the jurisdiction where the work is being performed.</i></p> <p><i>During the period of the contract, a representative of Canada or a service provider(s) under contract with the Government of Canada may request the list of employees and subcontractors requiring access to the site to perform the work and their security statuses. Information must be provided in the timeframe prescribed in order to ensure that the supply, delivery and installation of the furniture aligns with the master schedule.</i></p>	
2.1	Loading Dock/Location	
A	Location	<i>360 Main</i>
B	Dock	<i>8 dock level truck bays</i>
C	Lift	<i>No dock lift, dock plate available to roll off pallets.</i>
D	Door	<i>Standard interior door height but double wide.</i>
E	Freight Elevator	<i>Yes, concourse level under 360 Main tower.</i>
F	Other (specify, if any)	<i>Loading dock located away from tower and deliveries need to be transported through mall. No pallets on pallet jacks allowed in mall. Carts available in dock to transport to freight elevator.</i>
<b>3.</b>	<b>Continuance of Certifications</b>	
	<p>The Bidder certifies that by submitting a bid in response to the RFB, the Bidder, and any of the Bidder’s members if the Bidder is a Joint Venture, continues to comply with all of the following certifications listed in Parts 6A and 6B of the Bidder’s SA for Work Spaces.</p> <p>Canada may request copies of environmental certification(s) prior to contract award within a time period specified by the Identified User.</p>	
3.1	Integrity Provisions	
3.2	Federal Contractor’s Program for Employment Equity	
3.4	Product Conformance	
3.5	Price Certification (In accordance with the SA, Part 6B)	

**Table 8 - Bid Evaluation and Contract Total (Canada may complete if not completed by the Bidder) - TABLES**

1a	<b>Firm</b> Product Total (Table 1a, total)	\$
1b	<b>Firm</b> Product Total (Table 1b, total)	\$
2a	<b>Firm</b> Delivery Total (Table 2, row a)	\$
2b	<b>Firm</b> Delivery Total (Table 2, row b)	\$
3a	<b>Firm</b> Installation Total (Table 3, row a)	\$
3b	<b>Firm</b> Installation Total (Table 3, row b)	\$
4	<b>Optional</b> Product Total (Table 4) <i>(Applicable if Option is exercised)</i>	
5	<b>Optional</b> Delivery Total (Table 5) <i>(Applicable if Option is exercised)</i>	

6	<b>Optional</b> Installation Total (Table 6) <i>(Applicable if Option is exercised)</i>	
7	Hardware Total as per article 1.5 of Annex A-1 of SA <i>(if Applicable)</i>	\$
8	<b>Total Evaluated (Bid) Price*</b> (1 + 2 + 3 + 4 + 5 + 6+ 7) <i>[to be removed at contract award]</i>	\$
9	<b>Contract Price(1+2+3+7):</b> <i>[applicable at contract award only]</i>	\$
10	<b>Applicable Tax(es):</b> <i>[applicable at contract award only]</i>	\$
11	<b>Total Estimated Cost (9+10):</b> <i>[applicable at contract award only]</i>	\$

\* Applicable taxes extra.

**Table 9 – Bidder’s Authorized Representative**

1.	Bidder’s Authorized Representative for the Bid and the Contract	
	Name:	Telephone:
		E-Mail:
		Other:

## CATEGORY 6 - SEATING

**Table 1a – Products - SEATING  
PHASE 1**

Section A - IU REQUIREMENT				Section B – SUPPLIER'S BID		
#	GoCUID	Description of Product <i>(Additional product details may be inserted, if required as per 6B. 4.1 of the SA)</i>	Qty	Supplier Part Number	Firm Unit Price** \$	Extended Total [Qty x Price] \$
1.	6SLCWAXXWUXXXXMXX X (line 98)	Soft Seating	29		\$	\$
2.	6SMOCBXXLU37G19LYNN (line 127)	Soft Seating	30		\$	\$
3.	6SMOCBXXLU37G19LYNN (line 127)	Soft Seating	14		\$	\$
4.	6SBATWXXLUW3G19LMN N (line 56)	Soft Seating	26		\$	\$
5.	6SBAINXXLUW1G19LMN N (line 24)	Soft Seating	1		\$	\$
6.	6SUOMRXXLUXXXXXLNN N (line 113)	Soft Seating	3		\$	\$
<i>Add more rows if necessary.</i>				Product Total		\$
<p><b>NSA products <i>(must not exceed 30% of the firm quantity by category)</i></b></p> <p>The Supplier signs, and certifies that all the NSA products offered will conform to all specifications and meet the testing requirements detailed at Annex D.</p>						
Section A - IU REQUIREMENT				Section B – SUPPLIER'S BID		
#	NSA Product(s) Description		Qty	Supplier Part Number	Firm Unit Price** \$	Extended Total [Qty x Price] \$
1	LSHB - Refer to drawing RAF.1 for additional information.		16		\$	\$
2	LSB2A double seat bench, 1220mm (48")+- 50mm (2") long x 710mm (28")+- 50mm (2") wide x 457mm (18") seat height. Bench to be upholstered in a low VOC vinyl fabric. Bench to match LSB1, LSB2 & LSB2A.		6		\$	\$
<i>Add more rows if necessary.</i>				Product Total		\$

**Table 1b – Products - SEATING**  
**PHASE 2**

Section A - IU REQUIREMENT				Section B – SUPPLIER'S BID		
#	GoCUID	Description of Product <i>(Additional product details may be inserted, if required as per 6B. 4.1 of the SA)</i>	Qty	Supplier Part Number	Firm Unit Price** \$	Extended Total [Qty x Price] \$
1.	6SMOCBXXLU37G19LYNN (line 127)	Soft Seating	33		\$	\$
2.	6SMOCBXXLU37G19LYNN (line 127)	Soft Seating	10		\$	\$
3.	6SBATWXXLUW3G19LMN N (line 56)	Soft Seating	34		\$	\$
4.	6SBAINXXLUW1G19LMN N (line 24)	Soft Seating	5		\$	\$
<i>Add more rows if necessary.</i>				Product Total		\$
<p><b>NSA products</b> <i>(must not exceed 30% of the firm quantity by category)</i></p> <p>The Supplier signs, and certifies that all the NSA products offered will conform to all specifications and meet the testing requirements detailed at Annex D.</p>						
Section A - IU REQUIREMENT				Section B – SUPPLIER'S BID		
#	NSA Product(s) Description		Qty	Supplier Part Number	Firm Unit Price** \$	Extended Total [Qty x Price] \$
	LSHB Refer to drawing RAF.1 for additional information.		9		\$	\$
	LSB2A double seat bench, 1220mm (48")+- 50mm (2") long x 710mm (28")+- 50mm (2") wide x 457mm (18") seat height. Bench to be upholstered in a low VOC vinyl fabric. Bench to match LSB1, LSB2 & LSB2A.		8		\$	\$
<i>Add more rows if necessary.</i>				Product Total		\$

**Table 2 – Delivery - SEATING**

Section A - IU REQUIREMENT				Section B – SUPPLIER'S BID	
Product tables	Location	Desired Date** (Y/M/D)	Desired Time: Normal Business Hours Or Outside Normal Business Hours *	Supplier will supply and deliver as per below**	Firm Lot Price \$
Table 1a PHASE 1	<i>360 Main Street, Winnipeg, MB</i>  <i>Floor 3, 4, 5, 9, 13</i>	Between January 3 to February 20 2020	[Outside]	_____ : weeks  <i>Standard Lead time is between 6-10 weeks for furniture delivery and installation.</i>	\$
Table 1b PHASE 2	<i>360 Main Street, Winnipeg, MB</i>  <i>Floor 6,7,8,10</i>	Between September 17 to November 4 2020	[Outside]	_____ : weeks  <i>Standard Lead time is between 6-10 weeks for furniture delivery and installation.</i>	\$
<p>*Normal Business Hours 8:00 – 17:00, as per SA, Annex A, article 5</p> <p>**The Project Authority (PA) will provide the supplier the authority to proceed prior to the finalized delivery date taking into consideration the delivery time provided by the supplier. Canada will not be responsible if the supplier chooses to proceed without the PA authorization.</p> <p><i>Add more rows if necessary.</i></p>				Delivery Total:	\$

**Table 3 – Installation - SEATING**

Section A - IU REQUIREMENT				Section B – SUPPLIER'S BID	
Product tables	Location	Desired Date** (Y/M/D)	Desired Time: Normal Business Hours Or Outside Normal Business Hours *	Supplier will install as per below**	Firm Lot Price \$
Table 1a PHASE 1	<i>360 Main Street, Winnipeg, MB</i>  <i>Floor 3, 4, 5, 9, 13</i>	Between January 3 to February 20 2020	[Normal]	_____ : weeks from date of supply and delivery  <i>Standard Lead time is between 6-10 weeks for furniture delivery and installation.</i>	\$

Table 1b PHASE 2	<b>360 Main Street, Winnipeg, MB</b>  <i>Floor 6,7,8,10</i>	Between September 17 to November 4 2020	[Normal]	_____ : weeks from date of supply and delivery  <i>Standard Lead time is between 6-10 weeks for furniture delivery and installation.</i>	\$
<p>*Normal Business Hours 8:00 – 17:00, as per SA, Annex A, article 5</p> <p>**The Project Authority (PA) will provide the supplier the authority to proceed prior to the finalized installation date taking into consideration the installation time provided by the supplier. Canada will not be responsible if the supplier chooses to proceed without the PA authorization.</p> <p><i>Add more rows if necessary.</i></p>				Installation Total:	\$

**Table 4 – Optional Product**  Not Applicable  
*If applicable, copy/paste/modify from table 1.*

**Table 5 – Optional Delivery**  Not Applicable  
*If applicable, copy/paste/modify from table 2.*

**Table 6 – Optional Installation**  Not Applicable  
*If applicable, copy/paste/modify from table 3.*

**Table 7 – Standard Finishes and Canada’s Facilities to Accommodate the Delivery and Certifications**

<b>1.</b>	<b>Standard Finishes</b>	
1.1	<p>IU is to consult the Supplier’s Website identified in Part 6A of the SA to view the available finishes.</p> <p>Within ten business days of the contract award, the Project Authority will provide the Contractor with a written notice of Canada’s finish choices for each of the product(s) in Annex A.</p> <p>The Contractor will deliver the products corresponding to Canada’s choice of specific finishes(s). No additional charge will be applied to Canada.</p>	
<b>2.</b>	<b>Canada’s Facilities to Accommodate the Delivery</b>	
	<p><i>The Supplier’s employees and subcontractors requiring access to the site must adhere to the health and safety plans established for the site, in addition to any laws in effect in the jurisdiction where the work is being performed.</i></p> <p><i>During the period of the contract, a representative of Canada or a service provider(s) under contract with the Government of Canada may request the list of employees and subcontractors requiring access to the site to perform the work and their security statuses. Information must be provided in the timeframe prescribed in order to ensure that the supply, delivery and installation of the furniture aligns with the master schedule.</i></p>	
2.1	Loading Dock/Location	
A	Location	<i>360 Main</i>
B	Dock	<i>8 dock level truck bays</i>
C	Lift	<i>No dock lift, dock plate available to roll off pallets.</i>
D	Door	<i>Standard interior door height but double wide.</i>
E	Freight Elevator	<i>Yes, concourse level under 360 Main tower.</i>
F	Other (specify, if any)	<i>Loading dock located away from tower and deliveries need to be transported through mall. No pallets on pallet jacks allowed in mall. Carts available in dock to transport to freight elevator.</i>
<b>3.</b>	<b>Continuance of Certifications</b>	

	The Bidder certifies that by submitting a bid in response to the RFB, the Bidder, and any of the Bidder's members if the Bidder is a Joint Venture, continues to comply with all of the following certifications listed in Parts 6A and 6B of the Bidder's SA for Work Spaces.  Canada may request copies of environmental certification(s) prior to contract award within a time period specified by the Identified User.
3.1	Integrity Provisions
3.2	Federal Contractor's Program for Employment Equity
3.4	Product Conformance
3.5	Price Certification (In accordance with the SA, Part 6B)

**Table 8 - Bid Evaluation and Contract Total (Canada may complete if not completed by the Bidder) - SEATING**

1a	<b>Firm</b> Product Total (Table 1a, total)	\$
1b	<b>Firm</b> Product Total (Table 1b, total)	\$
2a	<b>Firm</b> Delivery Total (Table 2, row a)	\$
2b	<b>Firm</b> Delivery Total (Table 2, row b)	\$
3a	<b>Firm</b> Installation Total (Table 3, row a)	\$
3b	<b>Firm</b> Installation Total (Table 3, row b)	\$
4	<b>Optional</b> Product Total (Table 4) <i>(Applicable if Option is exercised)</i>	
5	<b>Optional</b> Delivery Total (Table 5) <i>(Applicable if Option is exercised)</i>	
6	<b>Optional</b> Installation Total (Table 6) <i>(Applicable if Option is exercised)</i>	
7	Hardware Total as per article 1.5 of Annex A-1 of SA <i>(if Applicable)</i>	\$
8	<b>Total Evaluated (Bid) Price* (1 + 2 + 3 + 4 + 5 + 6+ 7)</b> <i>[to be removed at contract award]</i>	\$
9	<b>Contract Price(1+2+3+7):</b> <i>[applicable at contract award only]</i>	\$
10	<b>Applicable Tax(es):</b> <i>[applicable at contract award only]</i>	\$
11	<b>Total Estimated Cost (9+10):</b> <i>[applicable at contract award only]</i>	\$

\* Applicable taxes extra.

**Table 9 – Bidder's Authorized Representative**

1.	Bidder's Authorized Representative for the Bid and the Contract	
	Name:	Telephone:
		E-Mail:
		Other:

**ANNEX D**  
**Additional Specifications, Certifications**

This Annex includes the additional Specifications, Certifications associated with NSA product. *(if applicable)* forming part of the requirement.

**1. Specifications**

*IU to include, if applicable, additional information above the generic specifications at Annex A such as testing and performance requirements, finishes...*

**2. Certifications**

**.1 NSA Product Conformance**

**2.1 NSA Product Conformance** *(Required precedent to Issuance of a contract)*

The Supplier certifies that all the NSA products offered will conform to all specifications indicated in Annex A and D of the RFB, and meet the testing and performance requirements found at ANNEX A-1 and A-2 of the Supply Arrangement, as applicable.


\_\_\_\_\_  
Supplier's Signature

\_\_\_\_\_  
Date


**NSA Product Conformance Certification** *(applies after contract award)*

The Supplier warrants that the NSA Product Conformance Certification submitted by the Supplier with its bid is accurate and complete. The Supplier must keep proper records and documentation relating to the NSA product conformance and the testing requirements in this Annex, as applicable. The Supplier must not, without obtaining the prior written consent of the SAA, dispose of any such records or documentation until the expiration of the Contract or the expiry date of the Warranty, whichever is later. All such records and documentation must at all times during the retention period be open to audit, inspection and examination by the representatives of Canada, who may make copies and take extracts.


In addition, the Supplier must provide representatives of the SAA access to all locations where any part of the Work is being performed at any time during working hours. Representatives of the SAA may examine and test the Work as they see fit. The Supplier must provide all assistance and access to facilities, test pieces, samples and documentation that the representatives of the SAA may reasonably require for the carrying out of the inspection, which may also include the submission of test reporting documentation as listed in Annex A and D. The Supplier must forward such test pieces, samples and/or documentation that may also include letters of certification from the laboratories to such person or location as the representatives of the SAA specifies.

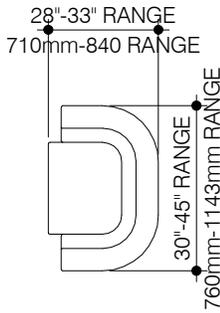

**1 PLAN - LOUNGE CHAIR**  
 SCALE 1 : 50

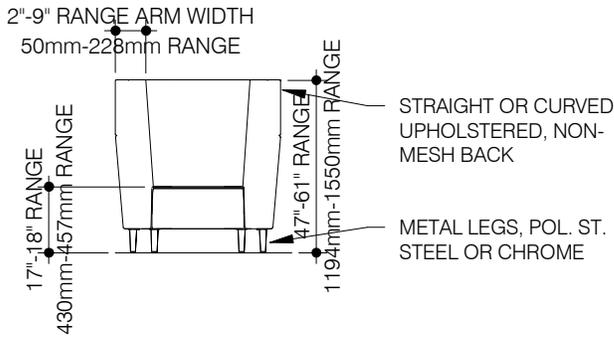

**2 ELEVATION - LOUNGE CHAIR FRONT**  
 SCALE 1 : 50

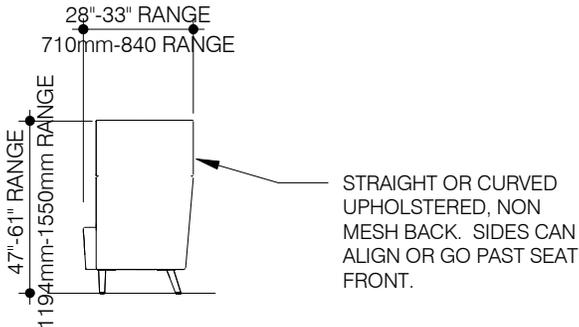

**3 ELEVATION - LOUNGE CHAIR SIDE**  
 SCALE 1 : 50

project CRA REPLACEMENT SPACE  
 360 MAIN STREET WINNIPEG, MB  
 sheet title LSHB DRAWINGS

scale: 1 : 50  
 drawn by: HH  
 checked by: MC  
 date: OCT 4, 2019

project no. 2017025  
 sheet no. **RAF.1**

number **TEN** number  
 architectural group **10**

Winnipeg Office 204 942.0981  
 Victoria Office 250 360.2106

architecture ■ interior design ■ planning













NUMBER TEN architectural group  





**9TH FLR FURNISHING SCHEDULE**


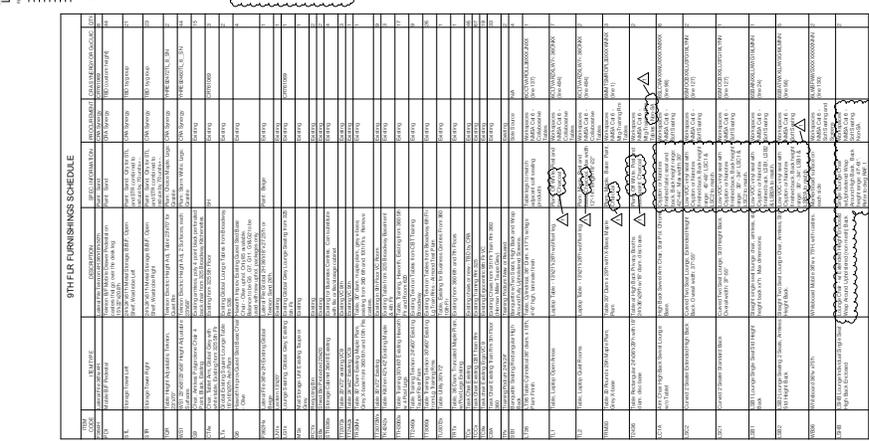

**SUMMARY:**  
 USEABLE AREA: 977m<sup>2</sup>  
 302m<sup>2</sup> (67m<sup>2</sup>)  
 OPEN OFFICE: 0 (in fixed worker stations)  
 TEAM LEADERS: 43  
 FIXED WORKERS: 0  
 FLEX WORKERS: 0  
 FREE WORKERS: 0  
 ENCLOSED OFFICE: 0  
 LEADERSHIP: 0m<sup>2</sup>  
 TOTAL FTE: 43  
 SPACE FIXED: 1  
 TOTAL WORKSPACES: 44

**SHARED SPACES:**  
 SMALL MEETING ROOM: 1  
 MEDIUM MEETING ROOM: 1 (VC ROOM)  
 LARGE MEETING ROOM: 1 (VC ROOM)  
 KITCHENETTE: 1, 40m<sup>2</sup> (FOR TRAINING)  
 BUSINESS CENTERS: 1  
 SFS - CERT TRAINING: 1, 60m<sup>2</sup>  
 SFS - CERT TRAINING: 1, @ 88m<sup>2</sup>  
 SFS - TRAINING: 1, 360 - 80m<sup>2</sup> (K)  
 COLLABORATION SPACE: 31, 0m<sup>2</sup> (4.72%)

**number TEN**  
 architectural group  

 NINTH FLOOR FURNITURE PLAN - PHASE 1

scale: 1:100  
 drawn by: JH  
 checked by: MC  
 project no.: 2011025  
 sheet no.: A3.7AR1












**10TH FLOOR FURNISHING SCHEDULE**














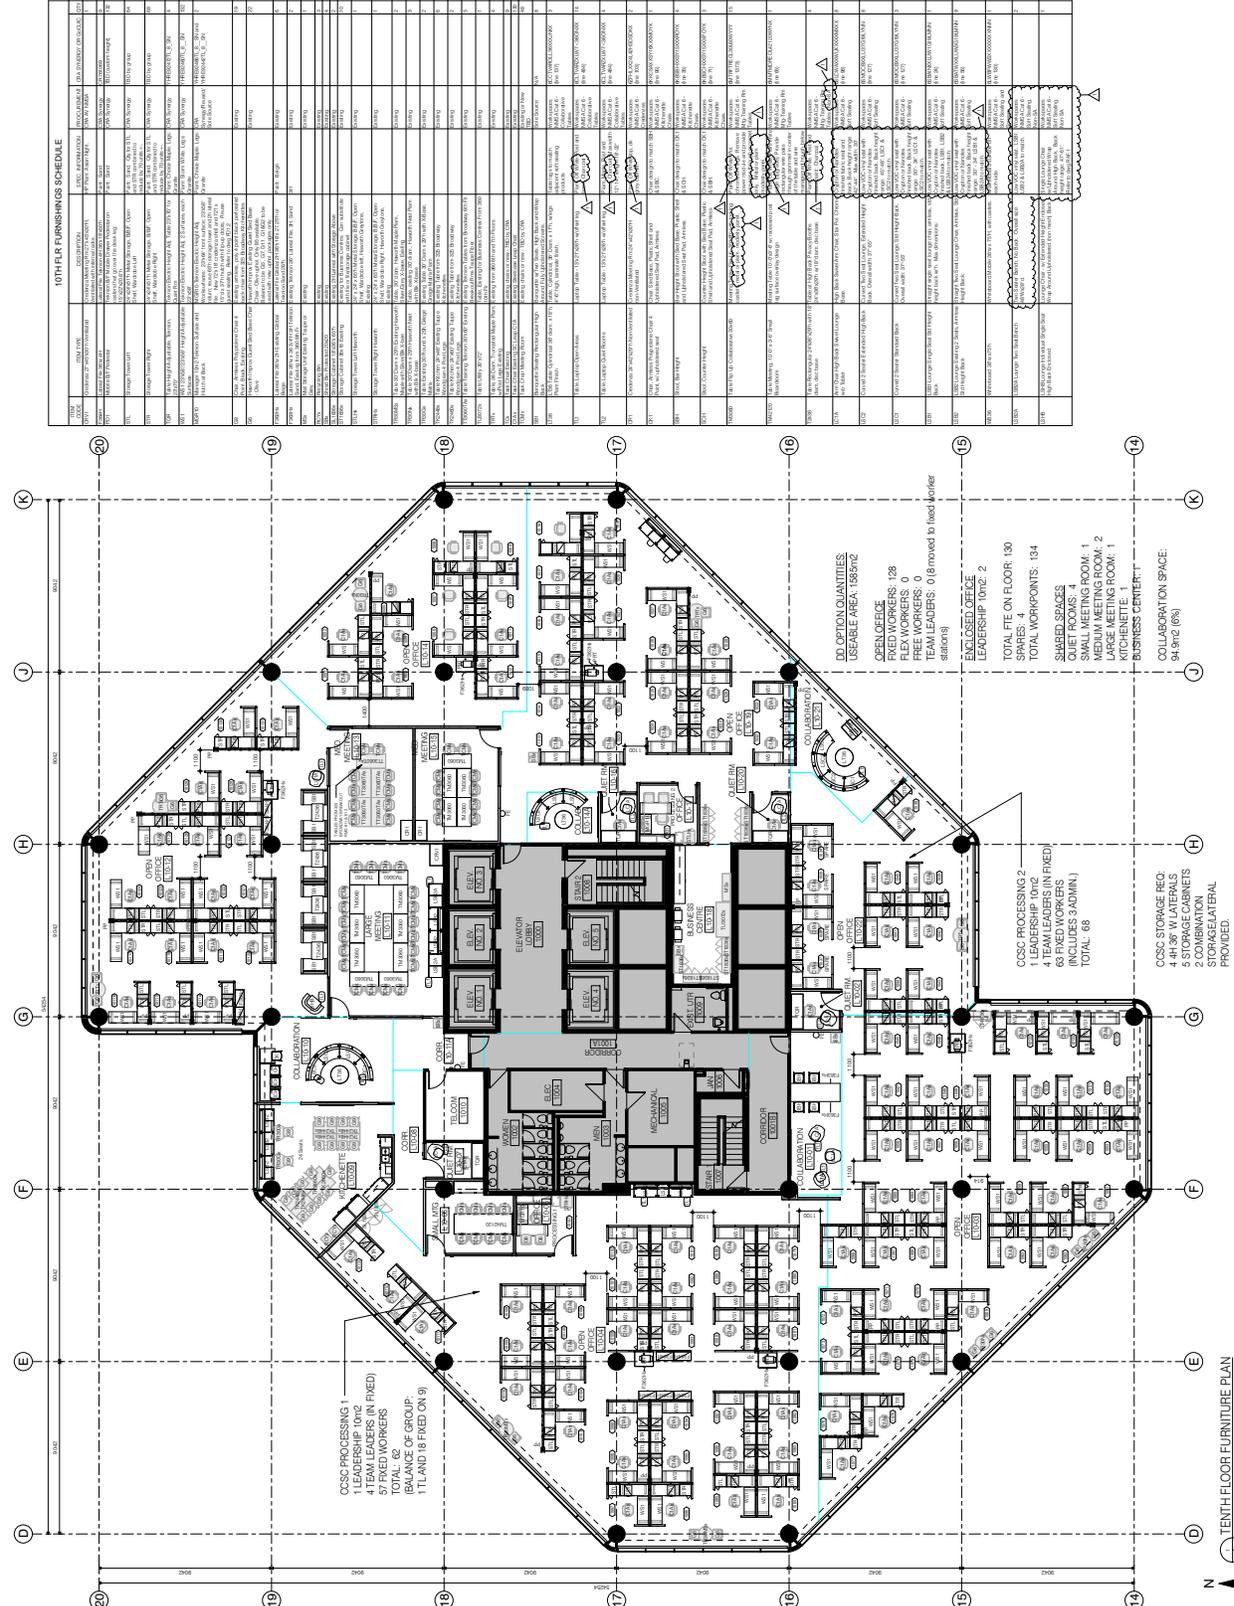

**10TH FLOOR FURNITURE PLAN**
















13TH FLOOR FURNISHINGS SCHEDULE


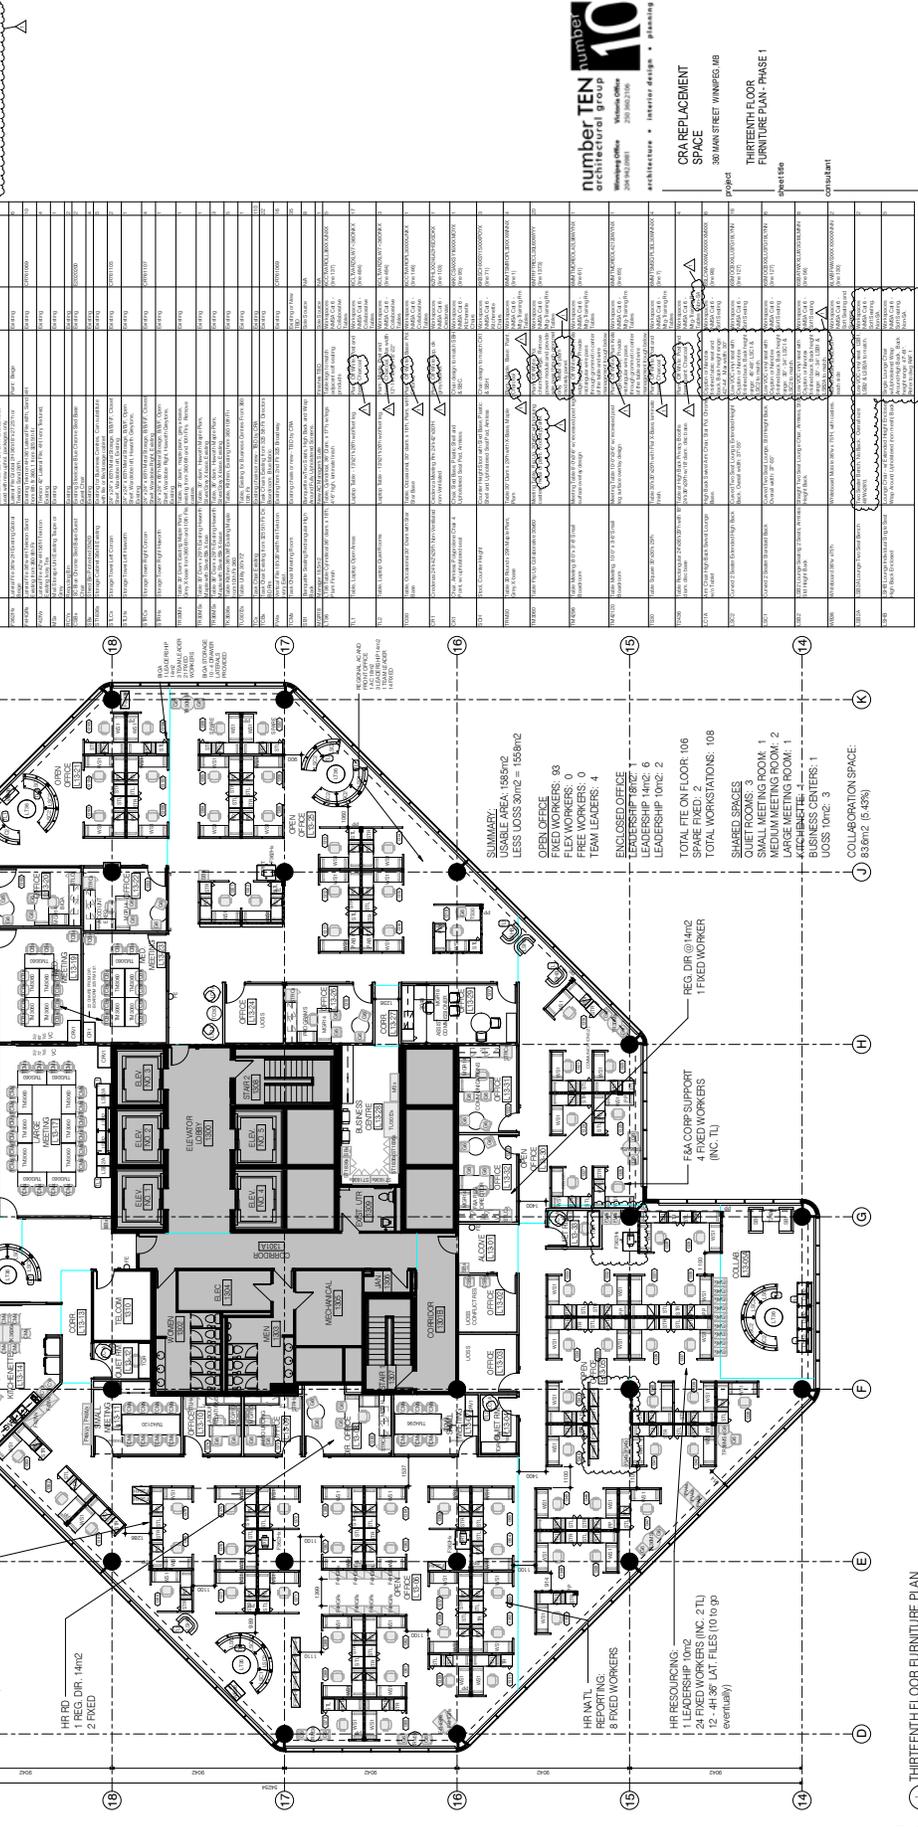

THIRTEENTH FLOOR FURNITURE PLAN - PHASE 1










