THIS DRAWING FURNISHED FOR ENGINEERING INFORMATION AND REFERENCE ONLY AND DOES NOT CONVEY ANY REPRODUCTION OR MANUFACTURING RIGHTS

NOTE: 1. DO NOT SCALE THIS PRINT
2. BREAK SHARP CORNERS
3. TOLERANCE ON DIMENSIONS NOT OTHERWISE SPECIFIED
DECIMAL
FRACTIONAL ± 1/32
ANGULAR

CERTIFIED
correct for dimensions
DEC 12 1978
Viceroy Fluid Power Ltd.
By

NOTE:- CHEVRON PISTON PACKING

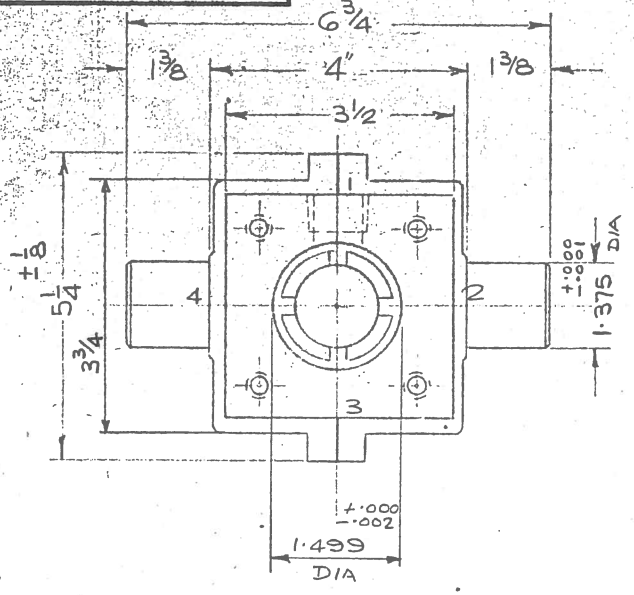

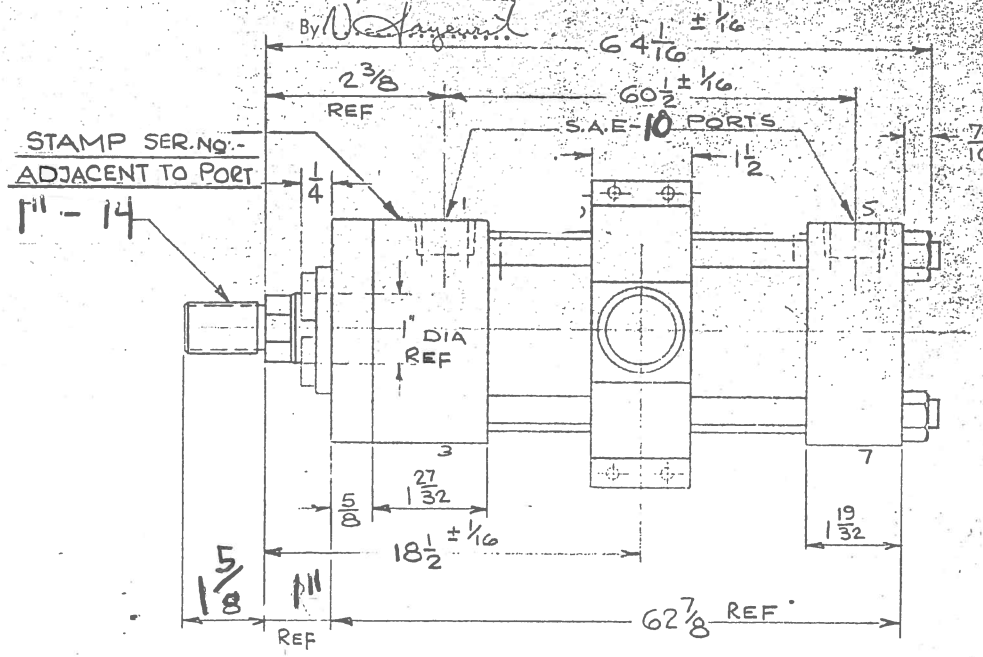

DEC 12 1978

CUSTOMER :- _____ V.F.P.L. NO:- 26575 CUST NO:- 4915-9-G1729

MODEL NO:- 2½ 2TH E 57½ CC AKY BORE:- 2½ STROKE:- 57½ ± 1/16 ROD 1.375"

PRESSURE:- 2500 PSI TEMP 200°F MAXm MEDIUM HYD-OIL

PORTS :- 1 & 5 ADJUSTING SCR 3&7 BALL CHECK 3&7.

ROD:- STAINLESS STL CHROME-PLATED

"DOUBLE SLING"

ISSUE	DATE	DESCRIPTION	NAME
2	7APR78	AS BUILT	
⚠	July 7/77	CERTIFIED FOR MANUFACTURE	A.G.

VICEROY CYLINDER
2TH SERIES
2½ - BORE
DR. BY A.G. CH'D BY

VICEROY FLUID POWER LIMITED
REXDALE • ONTARIO • CANADA

DATE 3 MAY 77 DWG. NO. S- 4410
SCALE N.T.S.

250-17 BRUNING 40-167