THIS DRAWING FURNISHED FOR ENGINEERING INFORMATION AND REFERENCE ONLY AND DOES NOT CONVEY ANY REPRODUCTION OR MANUFACTURING RIGHTS

TE: 1. DO NOT SCALE THIS PRINT
2. BREAK SHARP CORNERS
3. TOLERANCE ON DIMENSIONS NOT OTHERWISE SPECIFIED
DECIMAL
FRACTIONAL ± 1/32
ANGULAR

NOTE:-

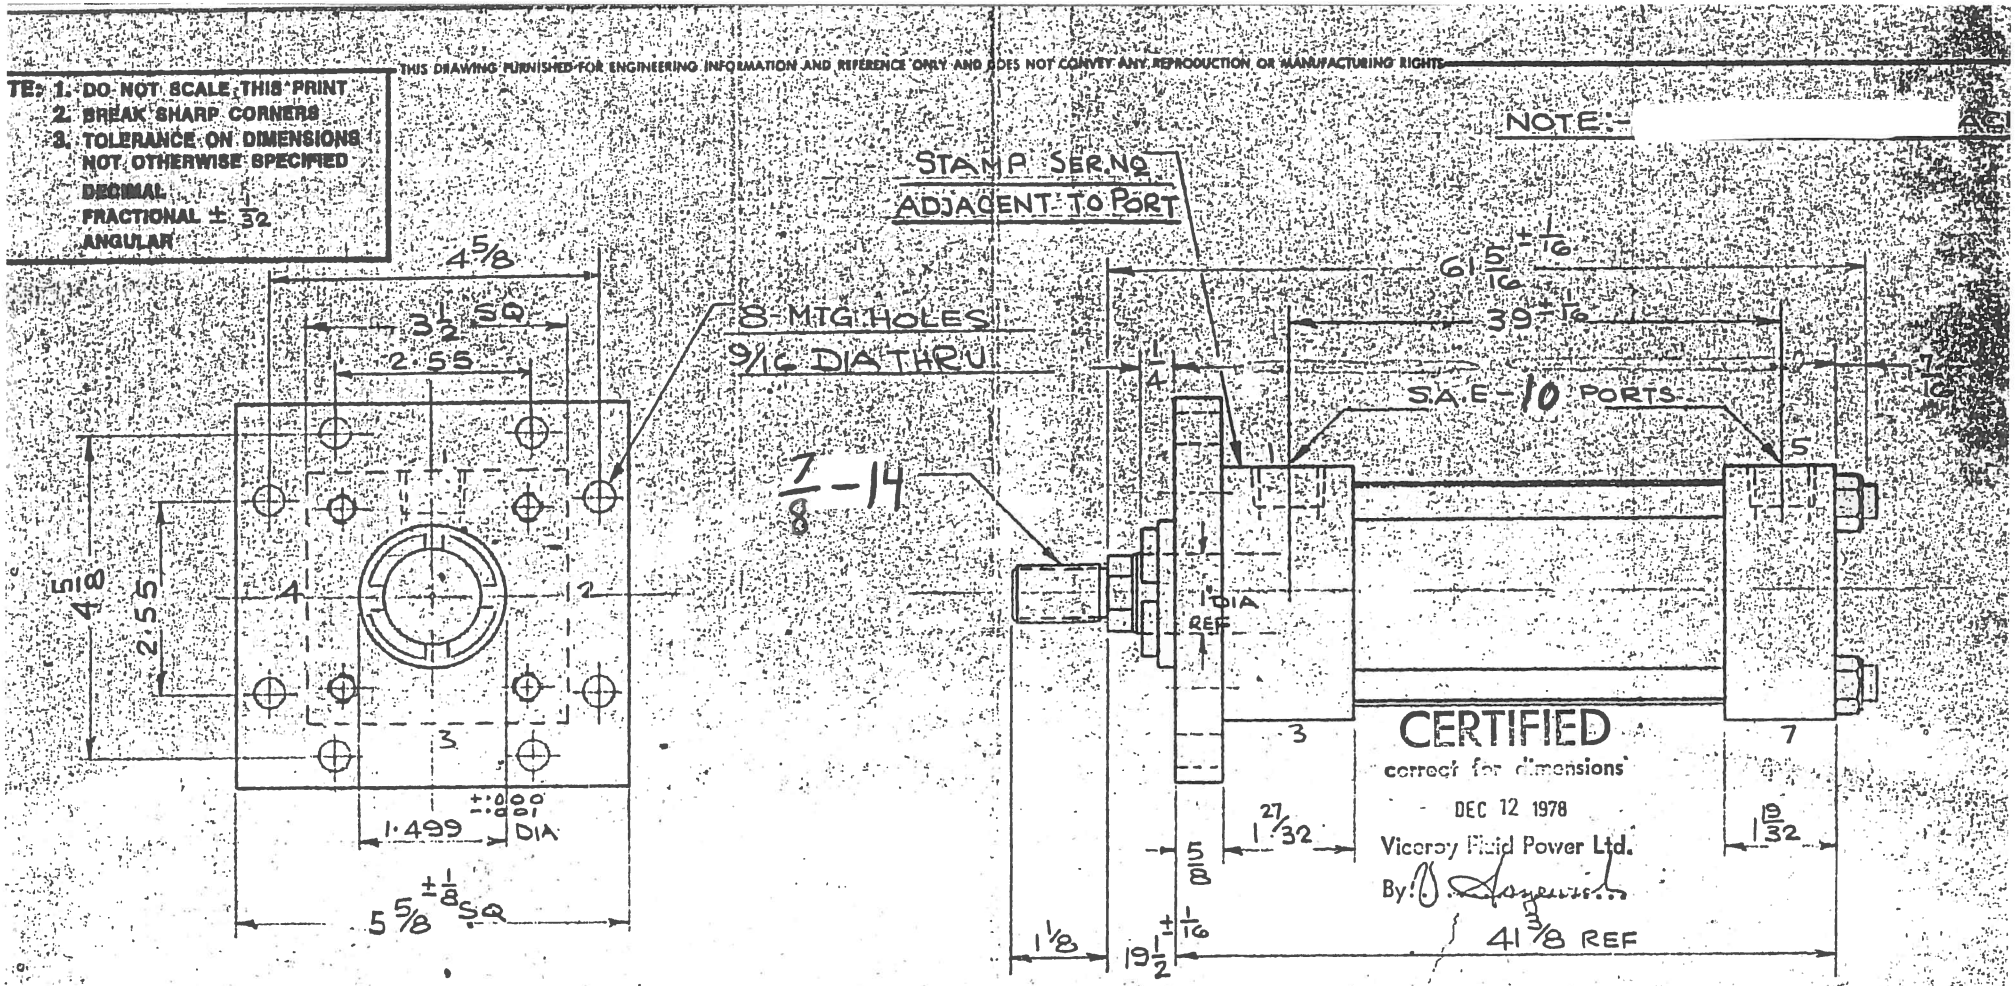

CUSTOMER:-

(4915-9-G1729) V.F.P.L. NO 26575

DEC 12 1978

MODEL NO:-2½-2TH BB 36CC AKY BORE:- 2½ STROKE:- 36 ± 1/16 ROD:- 1" DIA

PRESSURE:-2500 PSI TEMP. 200°F MAXM MEDIUM:-HYD-OIL

PORTS:- 1&5 ADJUSTING SCR 2&6 BALL CHECK 4&8

STAINLESS STL CHROME RATED ROD AND 18 3/4 EXTENSION

"TRIPLE SLING"

VICEROY CYLINDE

2TH SERIES

2½ BORE

DR. BY A.G. | CH'D BY

ISSUE	DATE	DESCRIPTION	NAME
2	7 APR 78	AS BUILT	
1	July 7/77	CERTIFIED FOR MANUFACTURE	A.G.

VICEROY FLUID POWER LIMITE
REXDALE • ONTARIO • CANADA

DATE 3 MAY 77 | DWG. NO. S-4409

SCALE N.T.S