Public Works and Government Services Canada | Travaux publics et Services gouvernementaux Canada

RETURN BIDS TO:
RETOURNER LES SOUMISSIONS À:

PWGSC/TPSGC Acquisitions Bid Receiving Box/Boite de Réception des Soumissions Bid Receiving Box/Boite de Récepti
1st Floor/1ière étage, Suite 1212
100-1045 Main Street
Moncton
New Brunswick
E1C 1H1
Bid Fax: (506) 851-6759

SOLICITATION AMENDMENT
MODIFICATION DE L'INVITATION

The referenced document is hereby revised; unless otherwise indicated, all other terms and conditions of the Solicitation remain the same.

Ce document est par la présente révisé; sauf indication contraire, les modalités de l'invitation demeurent les mêmes.

Comments - Commentaires

Vendor/Firm Name and Address
Raison sociale et adresse du fournisseur/de l'entrepreneur

Issuing Office - Bureau de distribution

Acquisitions NB/PEI (Moncton Office) – Bureau d'acquisitions N.-B./Î.-P.-É. (Moncton)
1045 Main Street / 1045, rue Main
Moncton
New Bruns
E1C 1H1

Title - Sujet Office Furniture, Panel Walls Office Furniture, Panel Walls	
Solicitation No. - N° de l'invitation EC096-220150/A	**Amendment No. - N° modif.** 002
Client Reference No. - N° de référence du client EC096-220150	**Date** 2021-05-18
GETS Reference No. - N° de référence de SEAG PW-$MCT-045-6002	
File No. - N° de dossier MCT-1-44014 (045)	**CCC No./N° CCC - FMS No./N° VME**
Solicitation Closes - L'invitation prend fin **at - à** 02:00 PM Atlantic Daylight Saving Time ADT **on - le** 2021-05-27 Heure Avancée de l'Atlantique HAA	
F.O.B. - F.A.B. **Plant-Usine:** ☐ **Destination:** ☑ **Other-Autre:** ☐	
Address Enquiries to: - Adresser toutes questions à: MacFarlane (MCT), Andrew	**Buyer Id - Id de l'acheteur** mct045
Telephone No. - N° de téléphone (782) 377-4248 ( )	**FAX No. - N° de FAX** (902) 566-7514
Destination - of Goods, Services, and Construction: **Destination - des biens, services et construction:**	

Instructions: See Herein

Instructions: Voir aux présentes

Delivery Required - Livraison exigée	**Delivery Offered - Livraison proposée**
Vendor/Firm Name and Address **Raison sociale et adresse du fournisseur/de l'entrepreneur** **Telephone No. - N° de téléphone** **Facsimile No. - N° de télécopieur**	
Name and title of person authorized to sign on behalf of Vendor/Firm (type or print) **Nom et titre de la personne autorisée à signer au nom du fournisseur/ de l'entrepreneur (taper ou écrire en caractères d'imprimerie)** **Signature** **Date**	

Canada

Solicitation Amendment No. 002

Title: Office Furniture, Panel Walls

This amendment is raised to correct incorrect answers to questions in the French version of Amendment 001 only.

(1) This solicitation is hereby amended to provide the following questions and answers:

Q1: Can you please advise if you would like blade glass for the add ons? If yes could you please provide the Cat. 1b GoGuid#.
A1: To be Frameless frosted glass add-ons. See amended annex C.

Q2: Are framed glass add ons what is required on this tender, if so this should show on the panel matrix.
A2: To be Frameless frosted glass add-ons. See amended annex C.

(2) Reference: Annex "C" – Floor Plan(s)

DELETE the current Annex C – Floor Plan(s), 1. Floor Plan(s); and

INSERT the Annex C – Floor Plan(s), 1. Floor Plan(s) (Revised 18 May 2021) attached herein.

If your bid has already been forwarded and you wish to revise same, this revision should be sent either in a sealed envelope and mailed to the above address or by facsimile (506) 851-6759 and reach the undersigned before the appropriate closing date. The solicitation number and the closing date are to be shown on the outside of the sealed envelope or on the facsimile transmission.

All other terms and conditions of the solicitation document remain unchanged remain unchanged.

All enquiries concerning this amendment are to be forwarded to:
Name: Andrew MacFarlane
161 St. Peters Road,
2nd Floor Suite 204
Charlottetown, PE
C1A 5P7

Telephone No: (782) 377-4248
Facsimile No: (506) 851-6759
Email: andrew.macfarlane@pwgsc-tpsgc.gc.ca

Annex "C" – Floor Plan(s)

REVISED 28 MAY 2021

(1) Floor Plan(s)

- See Attached

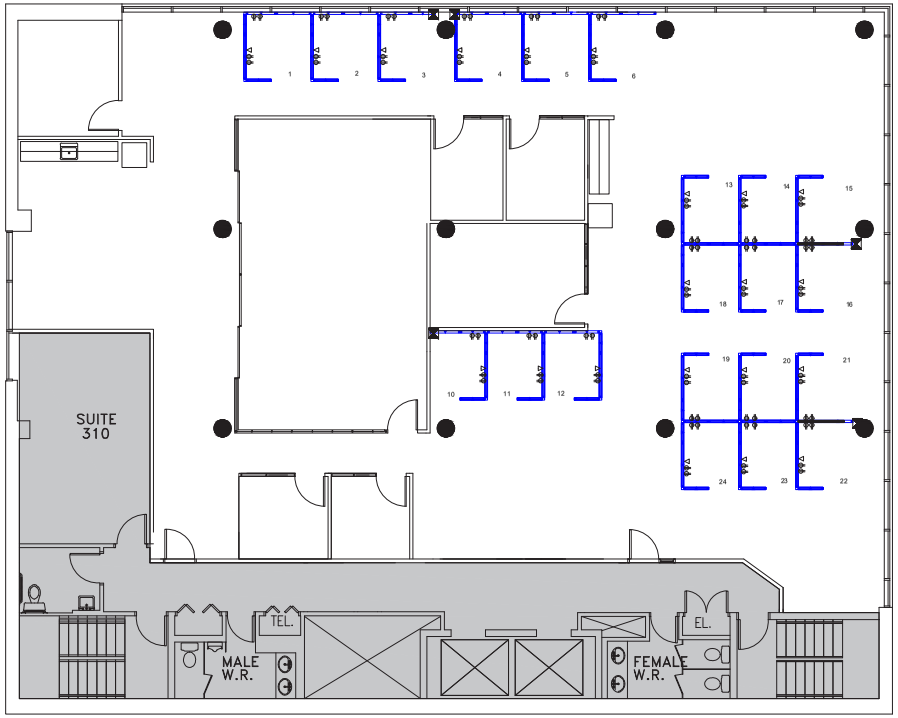

WORKSTATION TYPICAL:

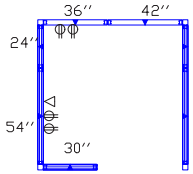

LEGEND:

PANEL WITH UPPER FROSTED GLASS ADD-ON

LOW PANEL

NOTES:

- SEE PLAN FOR PACPOLES LOCATION
- ALL PANELS AGAINS WINDOW OR WALL MUST BE A BASE PANEL ONLY
- GLASS ADD-ON MUST BE FROSTED
- GLASS ADD-ON SIZES TO BE 30'' FOR THE WING PANELS AND 78'' FOR FRONT AND SIDE PANELS
- GoCUID FOR FROSTED GLASS ADD-ON IS AS FOLLOW, PLEASE SEE PLAN FOR APPROPRIATE SIZES:
- 1bCPSXXNXXL24XFRNNN
- 1bCPSXXNXXL30XFRNNN
- 1bCPSXXNXXL36XFRNNN
- 1bCPSXXNXXL42XFRNNN
- 1bCPSXXNXXL48XFRNNN
- 1bCPSXXNXXL54XFRNNN

ANNEX C

TRANSLATION BUREAU

PROJECT TITLE: 777 MAIN STREET	
DRAWING TITLE: THIRD FLOOR PLAN SUITE 300 EXISTING WALLS	
USABLE AREA: 416.97m²	RENTABLE AREA: 485.72m²
DRAWN BY: J.S	DATE: 2021-04-20
SCALE: N.T.S.	SHEET: 777-101