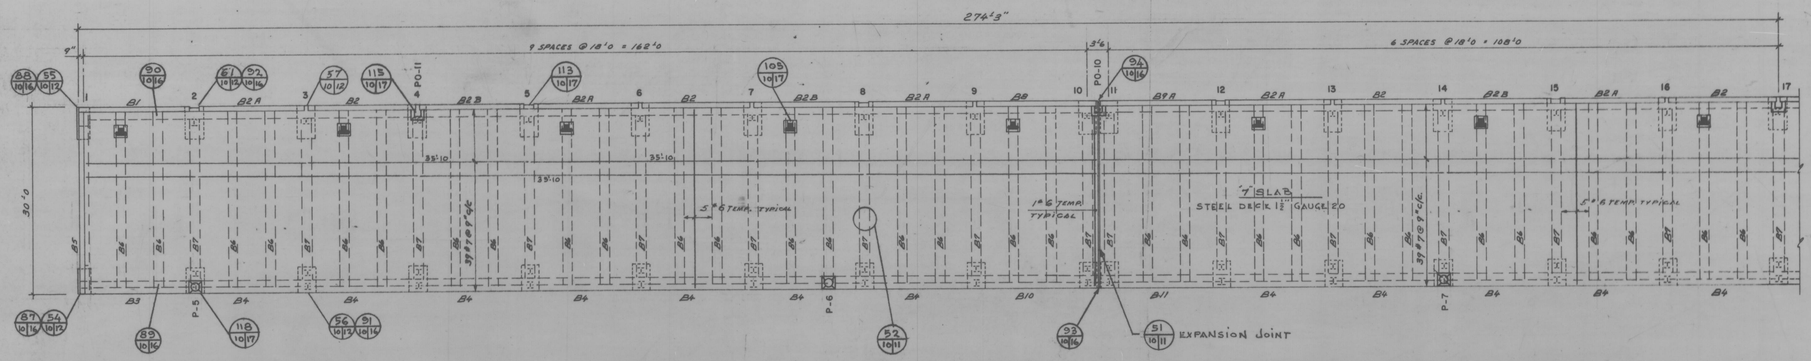

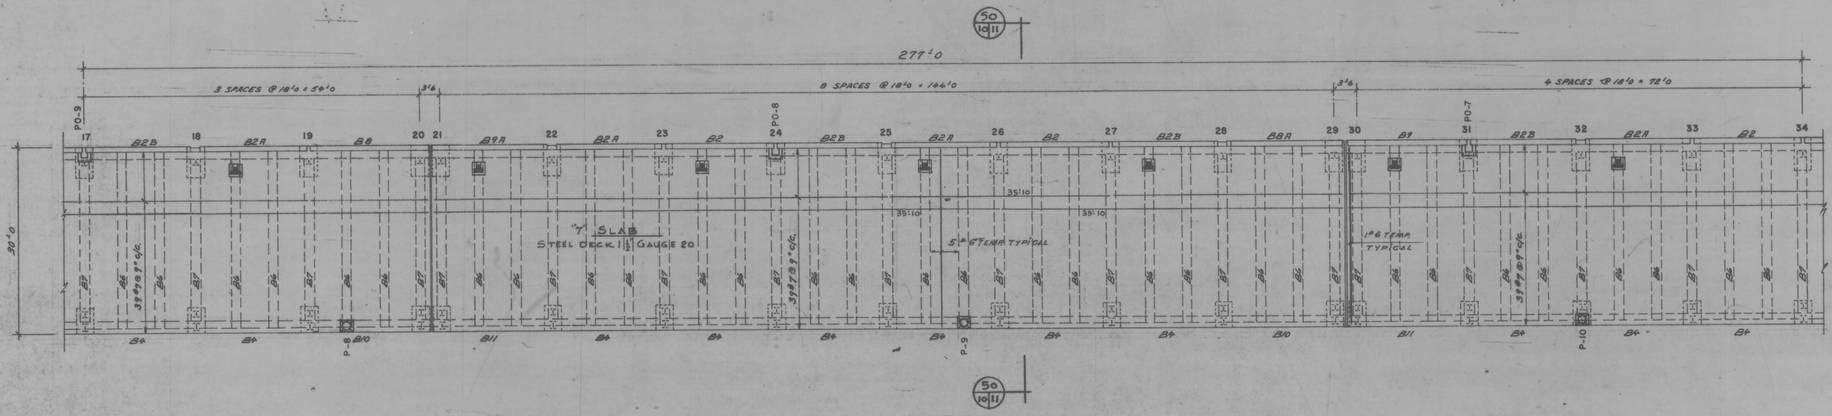

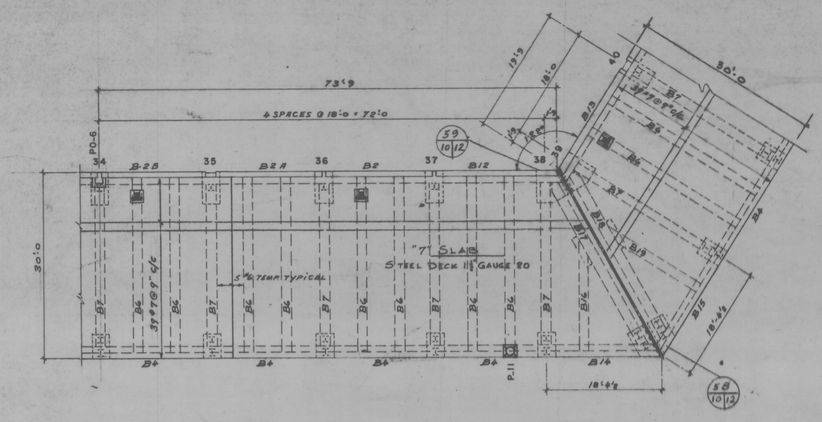

PLAN (47/10/10)

SCALE: 1" = 10'

DESIGN LIVE LOAD: 500#/S.Q F.T.
TRUCK LOAD: (H20-S16)

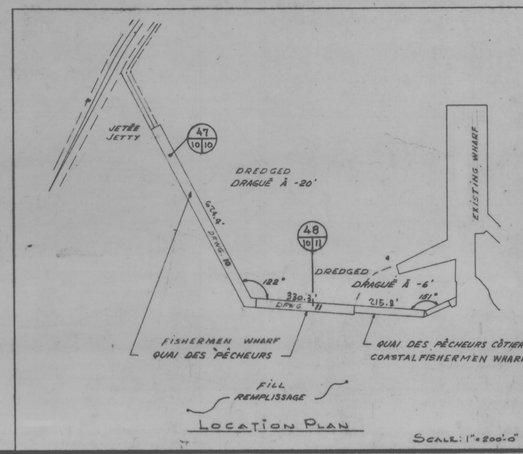

LOCATION PLAN

SCALE: 1" = 200'-0"

Department of Public Works
Ministère des Travaux publics

MARQUIS, VANDRY & ASS.
CONSULTING ENGINEERS

RIMOUSKI: 471 CATHEDRAL AVE.
QUEBEC : 880 STE-FOY ROAD.

A detail no. / détail no.
B location drawing no. / no dessin loc.
C drawing no. / dessin no.
revisions / date

project title / titre du projet
HARBOUR DEVELOPMENT
AMÉNAGEMENT PORTUAIRE
"AS BUILT"

Cap-aux-Meules P. Que.

drawing title / titre du dessin
SLABS — DALLES
FISHERMEN WHARF
QUAI DES PÊCHEURS

designed by / conçu par
date
drawn by / dessiné par
date
reviewed by / examiné par
date
approved by / approuvé par
date
Tender / Soumission
D.P.W. Project Manager / Administrateur de projets M.T.P.
project number / no. du projet
C-34-17
drawing no. / dessin no.
10/24

M.T.P. 121-45-190R

DPW 700 F

M 46937-D