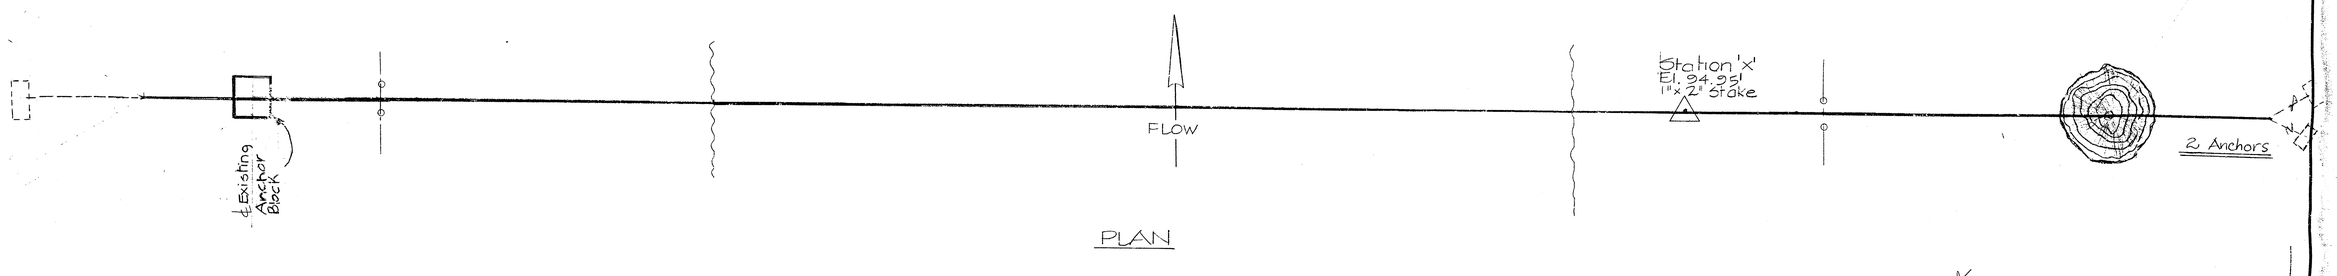

PLAN

1. Length of Span = 205ft
2. Mean elevation = 121.8ft
3. Three aircraft warning markers.

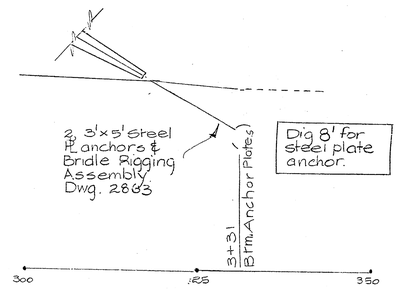

HOMESIDE

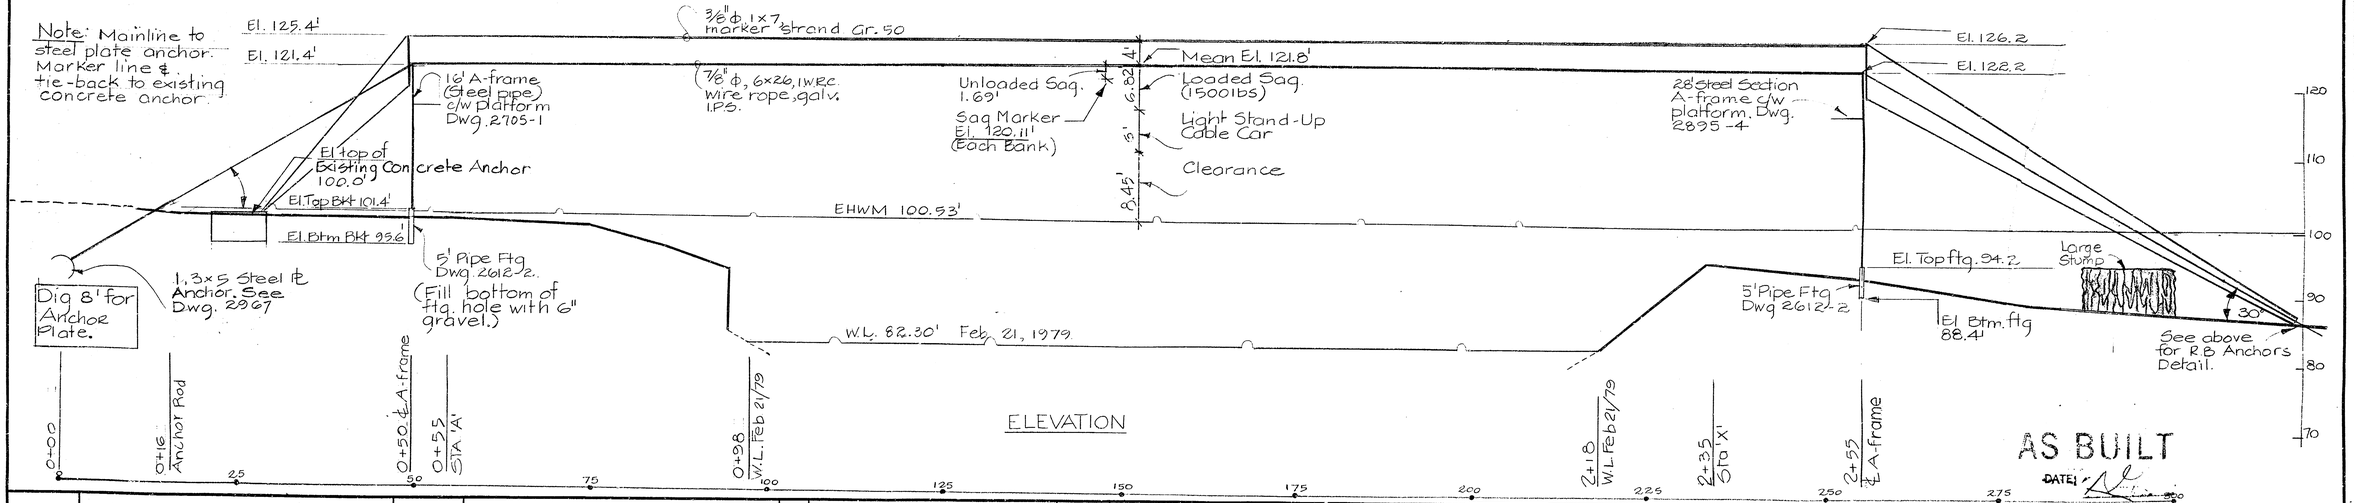

ELEVATION

AS BUILT
DATE:

Dwg. No.	Title	Dwg. No.	Title

REFERENCE

No.	Remarks	By	Date	Chk'd.	App.

REVISIONS

	By	Date	Checked	Date	Approved	Date
Survey	W.M.	Feb 21/79				
Design						
Drawing	V.J.L.	Apr. 27/82				
Tracing						

DEPT. OF THE ENVIRONMENT
WATER SURVEY OF CANADA, VANCOUVER, B.C.

YAKOUN RIVER
near PORT CLEMENTS
cableway

FIELD BOOK 79-C-1 P.20
Scale 1" = 10.0'
Sheet 1 of 2
Station No.
Dwg. No. 3094-1

Destroy all prints bearing previous number

D 1 2 C C 2 1 D