



PP-21

PP-22

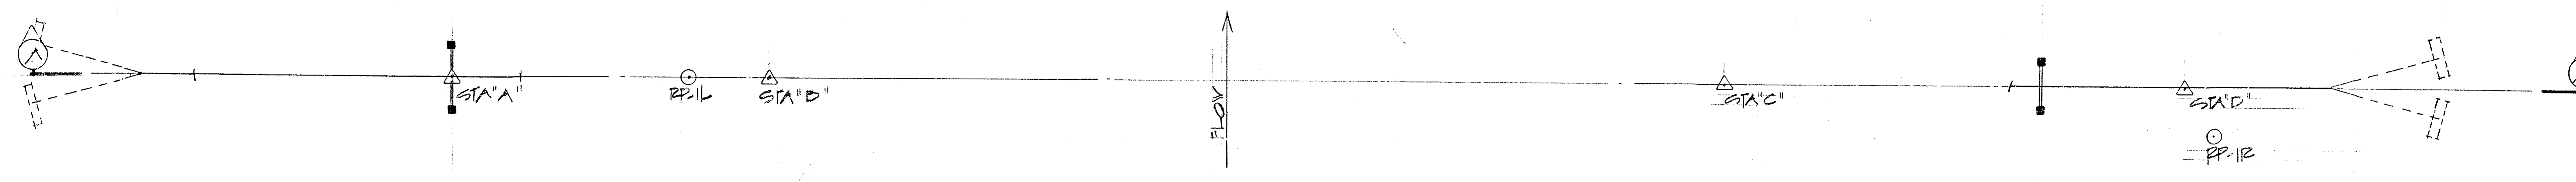

PLAN

GENERAL NOTES:  
 1. PLACE GAG MASTERS ON BOTH A-FRAMES AT EL. 117.7

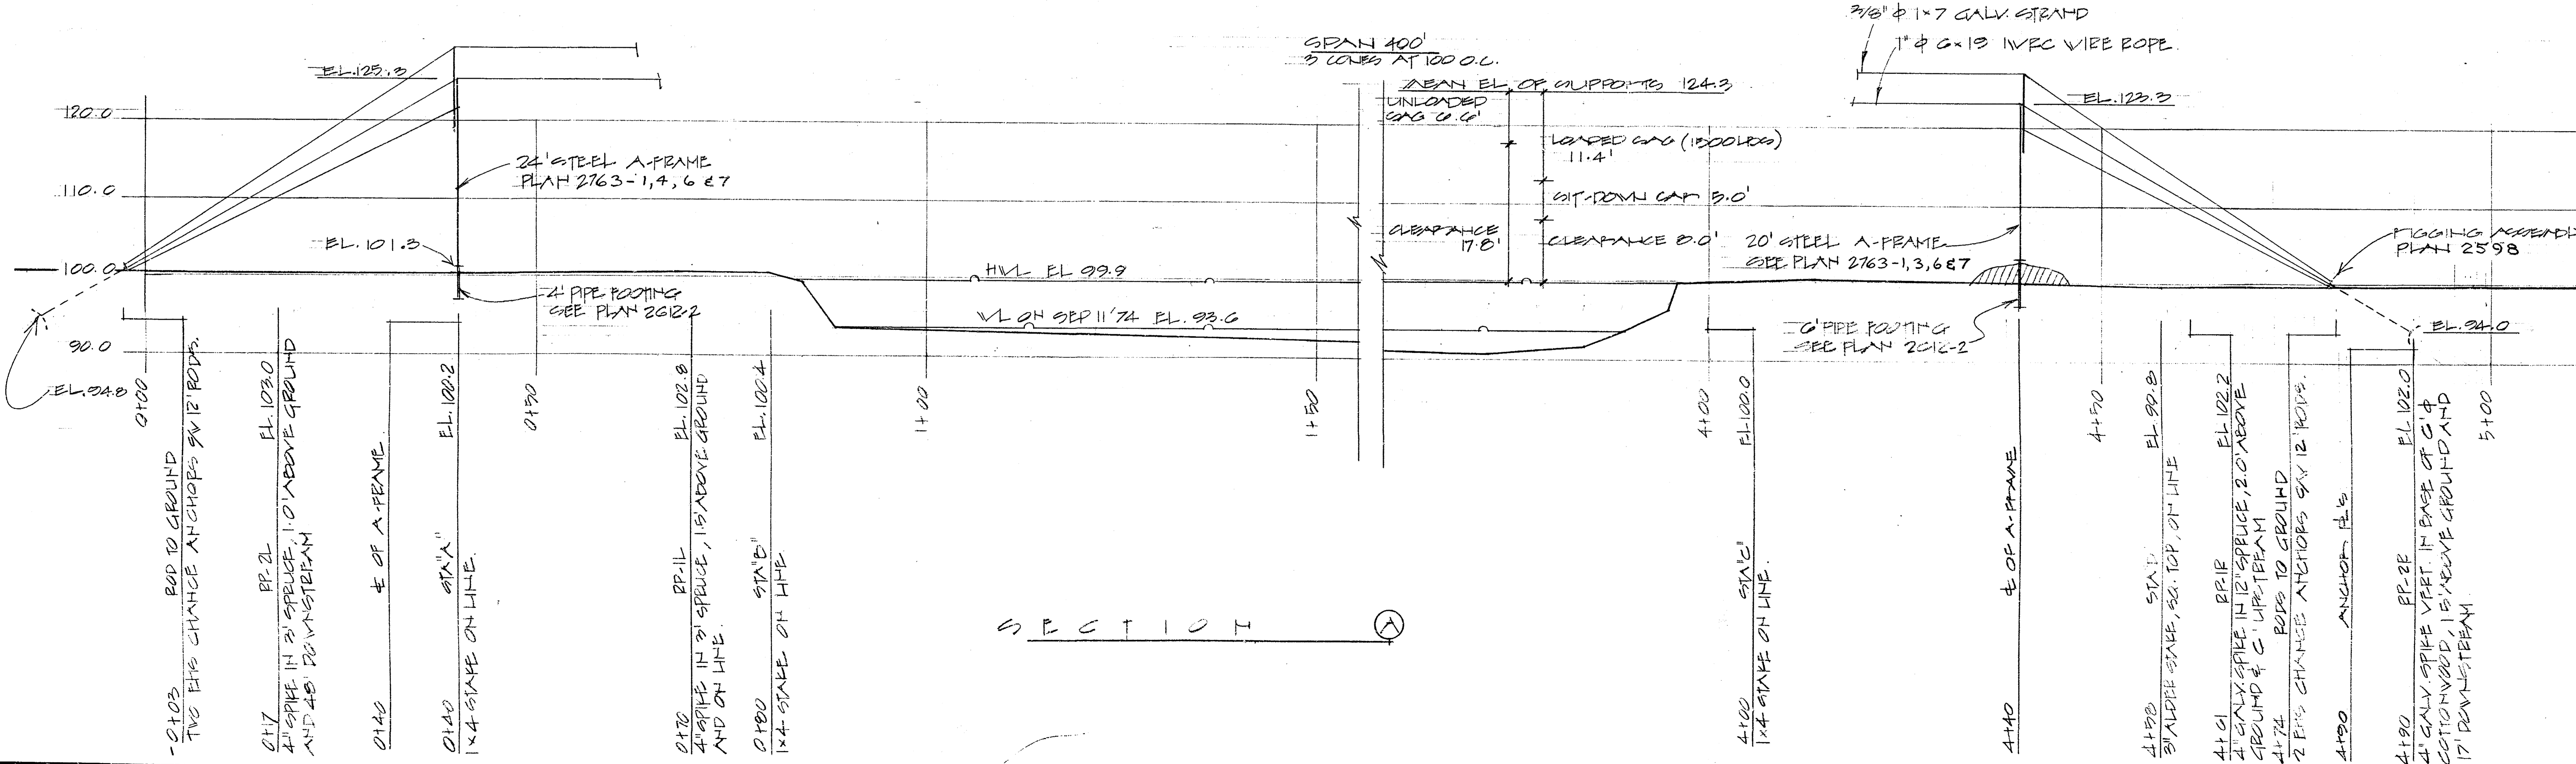

SECTION

Dwg. No.	Title	Dwg. No.	Title	No.	Remarks	By	Date	Chk'd.	App.	Drawing	Tracing
2709-1	STEEL A-FRAMES										
2712-2	PIPE FOOTINGS										
2712-3	FOOTING MODIFICATION										

By	Date	Checked	Date	Approved	Date
MBP	SEP 11 74	NSP	FEB 13 75		
MBP	FEB 13 75	NSP	FEB 13 75		
MBP	FEB 13 75	NSP	FEB 13 75		

DEPT. OF THE ENVIRONMENT  
 WATER SURVEY OF CANADA, VANCOUVER, B.C.  
 HYDROMETER STATION  
 CABLEWAY.

FIELD BOOK 74-C7  
 Scale 1"=100.0'  
 Sheet 1 of 2  
 Station No.  
 Dwg. No. 2795-1